

ENCROACHMENT PERMIT
(to be completed by applicant)

PACIFIC BELL MOBILE SERVICES, a California corporation, "Permittee," hereby requests permission to construct and maintain wireless communications facilities and conduct soil borings for preliminary geotechnical foundation investigations at **one location** encroaching in the public right-of-way as shown on the attached drawings. Upon issuance of this permit, Permittee agrees to comply with the attached terms and conditions.

Dated 8/27/96

PACIFIC BELL MOBILE SERVICES, a California corporation

By [Signature]

Title Network Deployment Manager

ENCROACHMENT PERMIT APPROVAL
(to be completed by City)

This permit shall become effective upon the approval of the Departments listed below. Issuance of this permit shall not be construed as a waiver of any other applicable permit or requirement, but is only revocable permission to use the land for the purposes above described.

- Public Utilities Water B. Simpson 8/23/96
 - Public Utilities Electric B. Marnon 8.27.96
 - Park and Recreation Denny Ruge 8/28/96
 - Planning Craig Aaron 8-27-96 cu-54-956
- Property Services
[Signature]
8/28/96

Upon obtaining the above signatures, return this permit to the Public Works Department for final approval.

Dated 8/28/96

[Signature]
Public Works Director

Attachments: Terms and Conditions
Pacific Bell Mobile Services Drawings (as described above)

Encroachment Permit No. E-1369

TERMS AND CONDITIONS

The following terms and conditions apply to encroachment permit number 1369

1. Permittee acknowledges that the areas of encroachment ("the areas") are owned or controlled by the City of Riverside.
2. Permittee acknowledges that the areas could at any time be needed for a proposed or planned public improvement and the City may require Permittee to relocate Permittee's facilities at Permittee's expense. City shall provide written notice of relocation to Permittee pursuant to the terms and conditions of the Master Communications Site License Agreement approved by the City Council of the City of Riverside on March 26, 1996, per City Council Minutes Vol. 81 Page 320. Permittee shall within the time prescribed by the City, remove and relocate all improvements necessary for the planned public improvement. If Permittee fails to abide by the relocation request of the City, the City shall have the right to remove Permittee's facilities without reimbursement to Permittee. The cost of such removal shall constitute a debt owed to the City and shall be paid by Permittee to the City.

Whenever the City causes the grading, widening, or other City improvement of the areas occupied by Permittee, and such grading, widening, or other City improvement requires the relocation of Permittee's then-existing facilities within the areas, the City shall:

Provide Permittee, within a reasonable time prior to the commencement of such grading or widening, written notice requesting such relocation; and

Provide Permittee with copies of any available plans and specifications for such grading or widening.

After receipt of such notice, plans and specifications, and pursuant to said terms and conditions contained in said Master Communications Site License Agreement, Permittee shall relocate such facilities which are in conflict with City construction and such relocation shall be at no cost to the City.

3. Permittee waives the right of claim, loss, damage or action against the City resulting from revocation, termination, removal of improvements or any action of the City, its officers, agents or employees taken in accordance with the terms herein.
4. If the City Council of the City of Riverside finds that Permittee is in default of the terms of this permit, that finding shall be cause for revocation.
5. Permittee shall hold the City of Riverside harmless from and against all claims demands, costs, losses, damages, injuries, actions for damages and/or injuries, and liability in connection with the construction, encroachment, and/or maintenance to be done by Permittee within the areas. Permittee also waives and releases any and all claims against the City of Riverside and its officers and employees for future losses, expenses, lost revenues and incidental and consequential damages suffered by

Permittee as a result of the City's negligently damaging Permittee's installation, except for the reasonable cost of repair.

6. Before commencing any construction on City controlled property, Permittee shall obtain a Construction Permit or Street Opening Permit from the City Public Works Department. The Permittee's contractor shall conduct construction activities in the areas as directed by the City's Construction Inspector. Particular attention shall be made to restoration of surfaces with similar materials where construction and/or investigations result in damage to public improvements. Restoration of the parkway to previously existing conditions must also be adhered to.

7. Permittee shall insure that construction of Permittee's improvements will not interfere in any way with existing City or utility facilities. The existing City facilities will require future maintenance, reconstruction and revisions and facilities may be added, any of which may result in removal or alteration of Permittee's improvements without reimbursement to the Permittee.

8. Prior to construction, Permittee shall contact Underground Service Alert to field locate existing utility lines. Any conflicts discovered will suspend the further work at the affected site until acceptable revisions are made.

9. At the end of construction, Permittee shall furnish a complete set of as-built plans that, in addition to showing usual construction details, shall also adequately show the horizontal and vertical location of Permittee's installations and appurtenances.

11. Permittee agrees to maintain a minimum of 4.00' clearance on existing sidewalks at each location to permit unobstructed pedestrian traffic.

12. This encroachment permit is further subject to the terms and conditions of the said Master Communications Site License Agreement approved by the City Council on March 26, 1996.

Dated 8/26/96

PACIFIC BELL MOBILE SERVICES, a
California corporation


By Charles S. Mander

Title Network Deployment Mgr

GENERAL NOTES

- DRAWINGS ARE NOT TO BE SCALED. WRITTEN DIMENSIONS TAKE PRECEDENCE, AND THIS SET OF PLANS IS INTENDED TO BE USED FOR DIAGNOSTIC PURPOSES ONLY, UNLESS NOTED OTHERWISE. THE GENERAL CONTRACTOR'S SCOPE OF WORK SHALL INCLUDE FURNISHING ALL MATERIALS, EQUIPMENT, LABOR, AND FITTING AS NECESSARY TO COMPLETE INSTALLATIONS AS DESCRIBED HEREIN.
- PRIOR TO THE SUBMISSION OF BIDS, THE CONTRACTORS INVOLVED SHALL VISIT THE JOB SITE AND FAMILIARIZE THEMSELVES WITH THE CONSTRUCTION AND CONTRACT DOCUMENTS, FIELD CONDITIONS AND CONFIRM THAT THE PROJECT MAY BE ACCOMPLISHED AS SHOWN PRIOR TO PROCEEDING WITH CONSTRUCTION. ANY ERRORS, OMISSIONS, OR DISCREPANCIES ARE TO BE BROUGHT TO THE ATTENTION OF THE ARCHITECT/ENGINEER.
- THE CONTRACTOR SHALL RECEIVE WRITTEN AUTHORIZATION TO PROCEED WITH CONSTRUCTION PRIOR TO STARTING WORK ON ANY ITEM NOT CLEARLY DEFINED BY THE CONSTRUCTION DRAWINGS/CONTRACT DOCUMENTS.
- THE CONTRACTOR SHALL SUPERVISE AND DIRECT THE PROJECT DESCRIBED HEREIN. THE CONTRACTOR SHALL BE SOLELY RESPONSIBLE FOR ALL CONSTRUCTION MEANS, METHODS, TECHNIQUES, SEQUENCES AND PROCEDURES AND FOR COORDINATING ALL PORTIONS OF THE WORK UNDER THE CONTRACT.
- THE CONTRACTOR SHALL INSTALL ALL EQUIPMENT AND MATERIALS ACCORDING TO MANUFACTURER'S/VENDOR'S SPECIFICATIONS UNLESS NOTED OTHERWISE OR WHERE LOCAL CODES OR ORDINANCES TAKE PRECEDENCE.
- ALL WORK PERFORMED ON PROJECT AND MATERIALS INSTALLED SHALL BE IN STRICT ACCORDANCE WITH ALL APPLICABLE CODES, REGULATIONS, AND ORDINANCES. CONTRACTOR SHALL GIVE ALL NOTICES AND COMPLY WITH ALL LAWS, ORDINANCES, RULES, REGULATIONS, AND LAWFUL ORDERS OF ANY PUBLIC AUTHORITY, MUNICIPAL AND UTILITY COMPANY SPECIFICATIONS, AND LOCAL AND STATE JURISDICTIONAL CODES BEARING ON THE PERFORMANCE OF THE WORK.
- CONTRACTOR SHALL PROVIDE AT THE PROJECT SITE A FULL SET OF CONSTRUCTION DOCUMENTS UPDATED WITH THE LATEST REVISIONS AND ADDENDA OR CLARIFICATIONS FOR USE BY ALL PERSONNEL INVOLVED WITH THE PROJECT.
- THE STRUCTURAL COMPONENTS OF THIS PROJECT SITE/FACILITY ARE NOT TO BE ALTERED BY THIS CONSTRUCTION PROJECT UNLESS NOTED OTHERWISE.
- DETAILS INCLUDED HEREIN ARE INTENDED TO SHOW THE END RESULT OF DESIGN. MINOR MODIFICATIONS MAY BE REQUIRED TO SUIT JOB CONDITIONS OR SITUATIONS, AND SUCH MODIFICATIONS SHALL BE INCLUDED AS PART OF THE SCOPE OF WORK.
- SEAL PENETRATIONS THROUGH FIRE-RATED AREAS WITH UL LISTED OR FIRE MARSHAL APPROVED MATERIALS IF APPLICABLE TO THIS FACILITY AND OF PROJECT SITE.
- PROVIDE A PORTABLE FIRE EXTINGUISHER WITH A RATING OF NOT LESS THAN 2-A OR 2-A10BC WITH IN 75 FEET TRAVEL DISTANCE TO ALL PORTIONS OF THE PROJECT AREA DURING CONSTRUCTION.
- THE CONTRACTOR SHALL MAKE NECESSARY PROVISIONS TO PROTECT EXISTING IMPROVEMENTS, EASEMENTS, PAVING, CURBING, ETC DURING CONSTRUCTION. UPON COMPLETION OF WORK, CONTRACTOR SHALL REPAIR ANY DAMAGE THAT MAY HAVE OCCURRED DUE TO CONSTRUCTION ON OR ABOUT THE PROPERTY.
- CONTRACTOR SHALL SEE TO IT THAT GENERAL WORK AREA IS KEPT CLEAN AND HAZARD FREE DURING CONSTRUCTION. DISPOSE OF ALL DIRT, DEBRIS, AND RUBBISH, AND REMOVE EQUIPMENT NOT SPECIFIED AS REMAINING ON THE PROPERTY. PREMISES SHALL BE LEFT IN CLEAN CONDITION AND FREE FROM PAINT SPOTS, DUST, OR SHUDDGES OF ANY NATURE.
- THE ARCHITECTS/ENGINEERS HAVE MADE EVERY EFFORT TO SET FORTH IN THE CONSTRUCTION AND CONTRACT DOCUMENTS THE COMPLETE SCOPE OF WORK. CONTRACTORS BIDDING THE JOB ARE NEVERTHELESS CAUTIONED THAT MINOR OMISSIONS OR ERRORS IN THE DRAWINGS AND OR SPECIFICATIONS SHALL NOT EXCUSE THE CONTRACTOR FROM COMPLETING THE PROJECT AND IMPROVEMENTS IN ACCORDANCE WITH THE INTENT OF THESE DOCUMENTS. THE BIDDER SHALL BEAR THE BURDEN OF THE CONTRACTOR'S PROPOSAL IN THE EVENT OF DISCREPANCIES THE CONTRACTOR SHALL PRICE THE MORE COSTLY OR EXTENSIVE WORK, UNLESS DIRECTED OTHERWISE.
- CONTRACTOR MUST PERFORM WORK DURING OWNER'S PREFERRED HOURS TO AVOID DISTURBING NORMAL BUSINESS.
- IT SHALL BE THE RESPONSIBILITY OF THE CONTRACTOR TO LOCATE ALL EXISTING UTILITIES, WHETHER SHOWN HEREON OR NOT AND TO PROTECT THEM FROM DAMAGE. THE CONTRACTOR SHALL BEAR ALL RISK OF REPAIR OR REPLACEMENT IN CONNECTION WITH THE EXECUTION OF THIS WORK.
- THE CONTRACTOR SHALL VERIFY THE NUMBER AND LOCATION OF ALL EQUIPMENT ANCHORS WITH THE EQUIPMENT MANUFACTURERS.

SYMBOLS

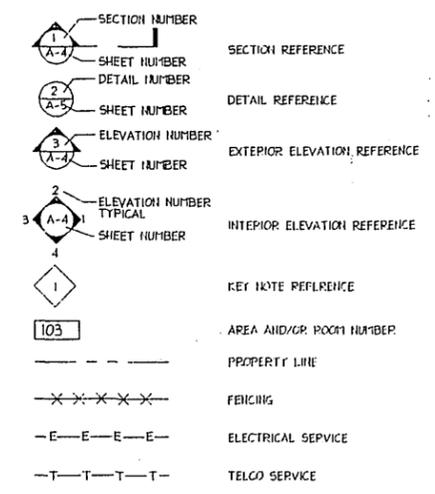

SHEET INDEX

- T-1 TITLE SHEET
- A-1 CONSTRUCTION PLAN
- A-2 NORTH ELEVATION 4 SECTION
- A-3 EAST ELEVATION 4 SECTION AT POLE
- A-4 TRENCHING DETAILS

UTILITY PURVEYORS

- WATER - N/A (NOT USED)
- SEWER - N/A (NOT USED)
- GAS - N/A (NOT USED)
- TELEPHONE - GTE
- ELECTRICAL - SCE

CONSULTANT TEAM

- ARCHITECT:**
JACK ANDERSON
SBA, Inc.
2955 REDHILL AVENUE
SUITE 100
COSTA MESA, CA 92626
PHONE: (714) 825-8051
FAX: (714) 825-8050
- ELECTRICAL ENGINEER:**
OMB ELECTRICAL
23-112 MOULTON PARKWAY
SUITE: 230
LAGUNA HILLS, CA 92653
PHONE: (714) 830-1952
FAX: (714) 830-8921
CONTACT: ROY LOPEZ
- ASSOCIATE ARCHITECT:**
BAT
2600 E. COAST HWY.
SUITE: D
CORONA DEL MAR, CA 92625
PHONE: (714) 644-9321
FAX: (714) 668-8651
CONTACT: JASON HEEKS
- STRUCTURAL ENGINEER:**
PEYTON-TOMITA & ASSOCIATES
14730 BEACH BLVD
SUITE: 202
LA MIRADA, CA 90638
PHONE: (714) 670-6614
FAX: (714) 670-0931
CONTACT: MIKIO TOMITA
- LAND SURVEYOR:**
AGUILAR ENGINEERING INCORP.
937 SOUTH VIA LATA
SUITE: 500
COLTON, CA 92324
PHONE: (909) 783-0101
FAX: (909) 783-0108
CONTACT: PAUL COOK



**CM-154-08 MARKET
LIGHT POLE ANTENNA INSTALLATION
PUBLIC WORKS SET**

LEGAL DESCRIPTION

PROJECT SUMMARY

- OWNER:**
CITY OF RIVERSIDE
3900 MAIN STREET
RIVERSIDE CA 92522
(909) 369-0548
- APPLICANT:**
PACIFIC BELL MOBILE SERVICES
2955 REDHILL AVENUE
SUITE 100
COSTA MESA, CA 92626
TELEPHONE: (714) 825-8017
- ZONING:**
PUBLIC RIGHT-OF-WAY
- OCCUPANCY:**
1991 UBC, P-2, 1994 CBC, U-2
CONSTRUCTION TYPE: V-11

PROJECT DESCRIPTION:

THE PROPOSED PROJECT ENTAILS:
INSTALLATION OF A BASE TRANSMITTER STATION (BTS) MOUNTED ON A CONCRETE PAD.
INSTALLATION OF A 60'-0" FOOT HIGH STREET LIGHT TOWER POLE WITH TOP MOUNTED UNICELL ANTENNAS.
COAX CABLE RUNS WITH IN MICROPOLE FROM BTS TO ANTENNAS;
A NEW TELEPHONE SERVICE RUN TO BTS AS SHOWN;
A NEW 100A ELECTRICAL SERVICE TO BTS AS SHOWN;
THE SITE MAY REQUIRE A SMALL AMOUNT OF CIVIL WORK TO FACILITATE A LEVEL SITE.

PLANCHECK #:


APPROVALS

THE FOLLOWING PARTIES HEREBY APPROVE AND ACCEPT THESE DOCUMENTS AND AUTHORIZE THE CONTRACTOR TO PROCEED WITH THE CONSTRUCTION DESCRIBED HEREIN. ALL CONSTRUCTION DOCUMENTS ARE SUBJECT TO REVIEW BY THE LOCAL BUILDING DEPARTMENT AND ANY CHANGES AND MODIFICATIONS THEY MAY IMPOSE.

	PRINT NAME	SIGNATURE	DATE
LANDLORD			
PBMS MANAGER			
RF MANAGER			
SITE ACQUISITION			
AEC			

**NOT FOR CONSTRUCTION
PUBLIC WORKS PARTIAL SET
SEE CONSTRUCTION DRAWINGS
FOR DETAILS AND ADDITIONAL
INFORMATION**

VICINITY MAP

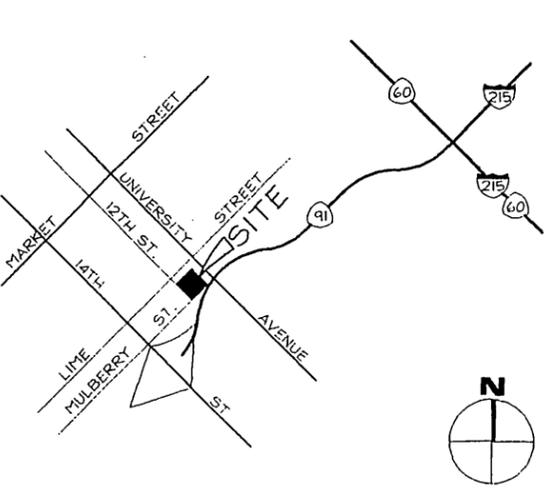

PROPRIETARY INFORMATION
THE INFORMATION CONTAINED IN THIS SET OF CONSTRUCTION DOCUMENTS IS PROPRIETARY BY NATURE. ANY USE OR DISCLOSURE OTHER THAN THAT WHICH RELATES TO PACIFIC BELL MOBILE SERVICES IS STRICTLY PROHIBITED.

DATE: 7/5/96
ARCHITECT: BAT
DRAWN BY: KR
CHECKED BY: JW

REVISIONS

REV	DATE	DESCRIPTION	BY
△			
△			
△			
△			

PACIFIC BELL
Mobile Services
4420 ROSEWOOD DR. BLDG. 2, 4TH FLOOR
PLEASANTON, CALIFORNIA 94588

SBA Consulting Services, Inc.
Project Office:
2955 Redhill Avenue
Costa Mesa, CA 92626
(714) 825-8052

Bell Communications
Architecture & Planning
2000 E. Coast Hwy, Suite D
Corona Del Mar, CA 92625
Phone: (714) 644-3551
Fax: (714) 644-3551

SITE NUMBER:
CM-154-08 PA1-BS3
SITE TYPE:
**LIGHT POLE
ANTENNA INSTALLATION**
LOCATION:
**MARKET
3325 TWELFTH STREET
RIVERSIDE, CA 92504**

TITLE:
TITLE SHEET
SHEET NUMBER:
T-1

E-1309

LAST UPDATED: 08/08/96 - 17:37
LAST PLOTTED: 08/08/96 - 17:37

CONSTRUCTION PLAN KEYED NOTES

- 1 LEASE AREA PROPERTY LINE/CITY RIGHT OF WAY
- 2 EXISTING CONCRETE DRIVEWAY & SIDEWALK
- 3 EXISTING GRASS PARKWAY: SITE WITHIN LEASE LINE TO REPLACE OR RELOCATE EXISTING SOIL, SPRINKLERS & LANDSCAPING AS REQUIRED.
- 4 METER BOX SEE DRAWING I/E-2 PAINT UNIT SINCLAIR "FOREST GREEN" (OR EQUAL)
- 5 BASE TRANSCIEVER STATION (BTS) ON STEEL CHANNEL SUB BASE FRAME SEE 2/A-2 PAINT SINCLAIR "FOREST GREEN" (OR EQUAL)
- 6 CONCRETE PAD SEE DETAIL 1/A-2 FOR PAD DIMENSIONS & CONDUIT PENETRATIONS.
- 7 CONCRETE STREET LIGHT MONOPOLE PER MANUFACTURERS SPECIFICATIONS
- 8 CONCRETE STREET LIGHT MONOPOLE FOUNDATION, SEE 12/A-2
- 9 (4) 4" CONDUIT STUB-UP 12" ABOVE CONCRETE FOUNDATION INSIDE MONOPOLE
- 10 UNDERGROUND 3'-0" X 2'-0" CONCRETE PULL-BOX FOR COAX CABLE TRANSITION OF CABLE TO JUMPERS, SEAL WITH AIR AND WATERTIGHT LID.
- 11 PROPOSED UNDERGROUND COAX LINES (4) UNDERGROUND 4" CONDUITS FROM MONOPOLE TO PULLBOX. SEE 1/E-1.
- 12 (3) UNDERGROUND 4" CONDUITS FROM PULL-BOX TO LHA CABINET & TO BTS
- 13 EXISTING CONCRETE CURB & GUTTER (TYP)
- 14 NEW CONCRETE STREET LIGHT POLE WITH TOP MOUNTED ANTENNAS SEE NOTE 6.
- 15 EXISTING 2'-0" H. CONC BLOCK WALL (TYP)
- 16 NEW ABOVE GROUND LHA PEDESTAL SEE DRAWING 3/A-2 PAINT PEDESTAL SINCLAIR "FOREST GREEN" (OR EQUAL)
- 17 EXISTING "EMPLOYEE ONLY" SIGN TO BE RELOCATED PER OWNER
- 18 PROPOSED UNDERGROUND UTILITY LINES SEE DETAIL 6/E-1.
- 19 EXISTING EDGE OF CONC
- 20 REWORK EXIST UNDERGROUND STREET LIGHT ELECTRICAL LINE @ LOCATION OF NEW CONC STREET LIGHT MONOPOLE FOOTING
- 21 REMOVE & REPLACE PORTIONS OF CURB DRIVEWAY & GUTTER AS REQUIRED PER CITY REQUIREMENTS
- 22 REMOVE EXISTING LIGHT POLE & FOUNDATION
- 23 EXISTING SIGN TO REMAIN
- 24 NEW ABOVE GROUND TELE PEDESTAL SEE DRAWING 3/E-1. PAINT PEDESTAL SINCLAIR "FOREST GREEN" (OR EQUAL)
- 25 12" X 8" X 24" D. SPLICE BOX W/ DRY SLUMP BELOW AS RECOMMENDED BY CIVIL ENGINEER.
- 26 PROPOSED SOIL ENCROACHMENT: SOIL BORING FOR FOUNDATION DESIGN. IN DIRT ONLY. EXISTING TREES WILL NOT BE IMPACTED. (SEE NOTE BELOW)


IMPORTANT NOTICE
 Section 4216/4217 of the Government Code requires a DigAlert Identification Number be issued before a "Permit to Excavate" will be valid. For your DigAlert I.D. Number Call Underground Service Alert TOLL FREE 1-800-422-4133 Two working days before you dig

NOTE:
 ALL EQUIPMENT BOXES WITHIN LEASE AREA SHALL BE PAINTED WITH SINCLAIR "FOREST GREEN" (OR EQUAL) AND TREATED WITH AN ANTIGRAFFI COATING

PROPOSED ENCROACHMENT

NOT FOR CONSTRUCTION
 PUBLIC WORKS PARTIAL SET
 SEE CONSTRUCTION DRAWINGS
 FOR DETAILS AND ADDITIONAL
 INFORMATION

PROPOSED SOIL BORING LOCATION

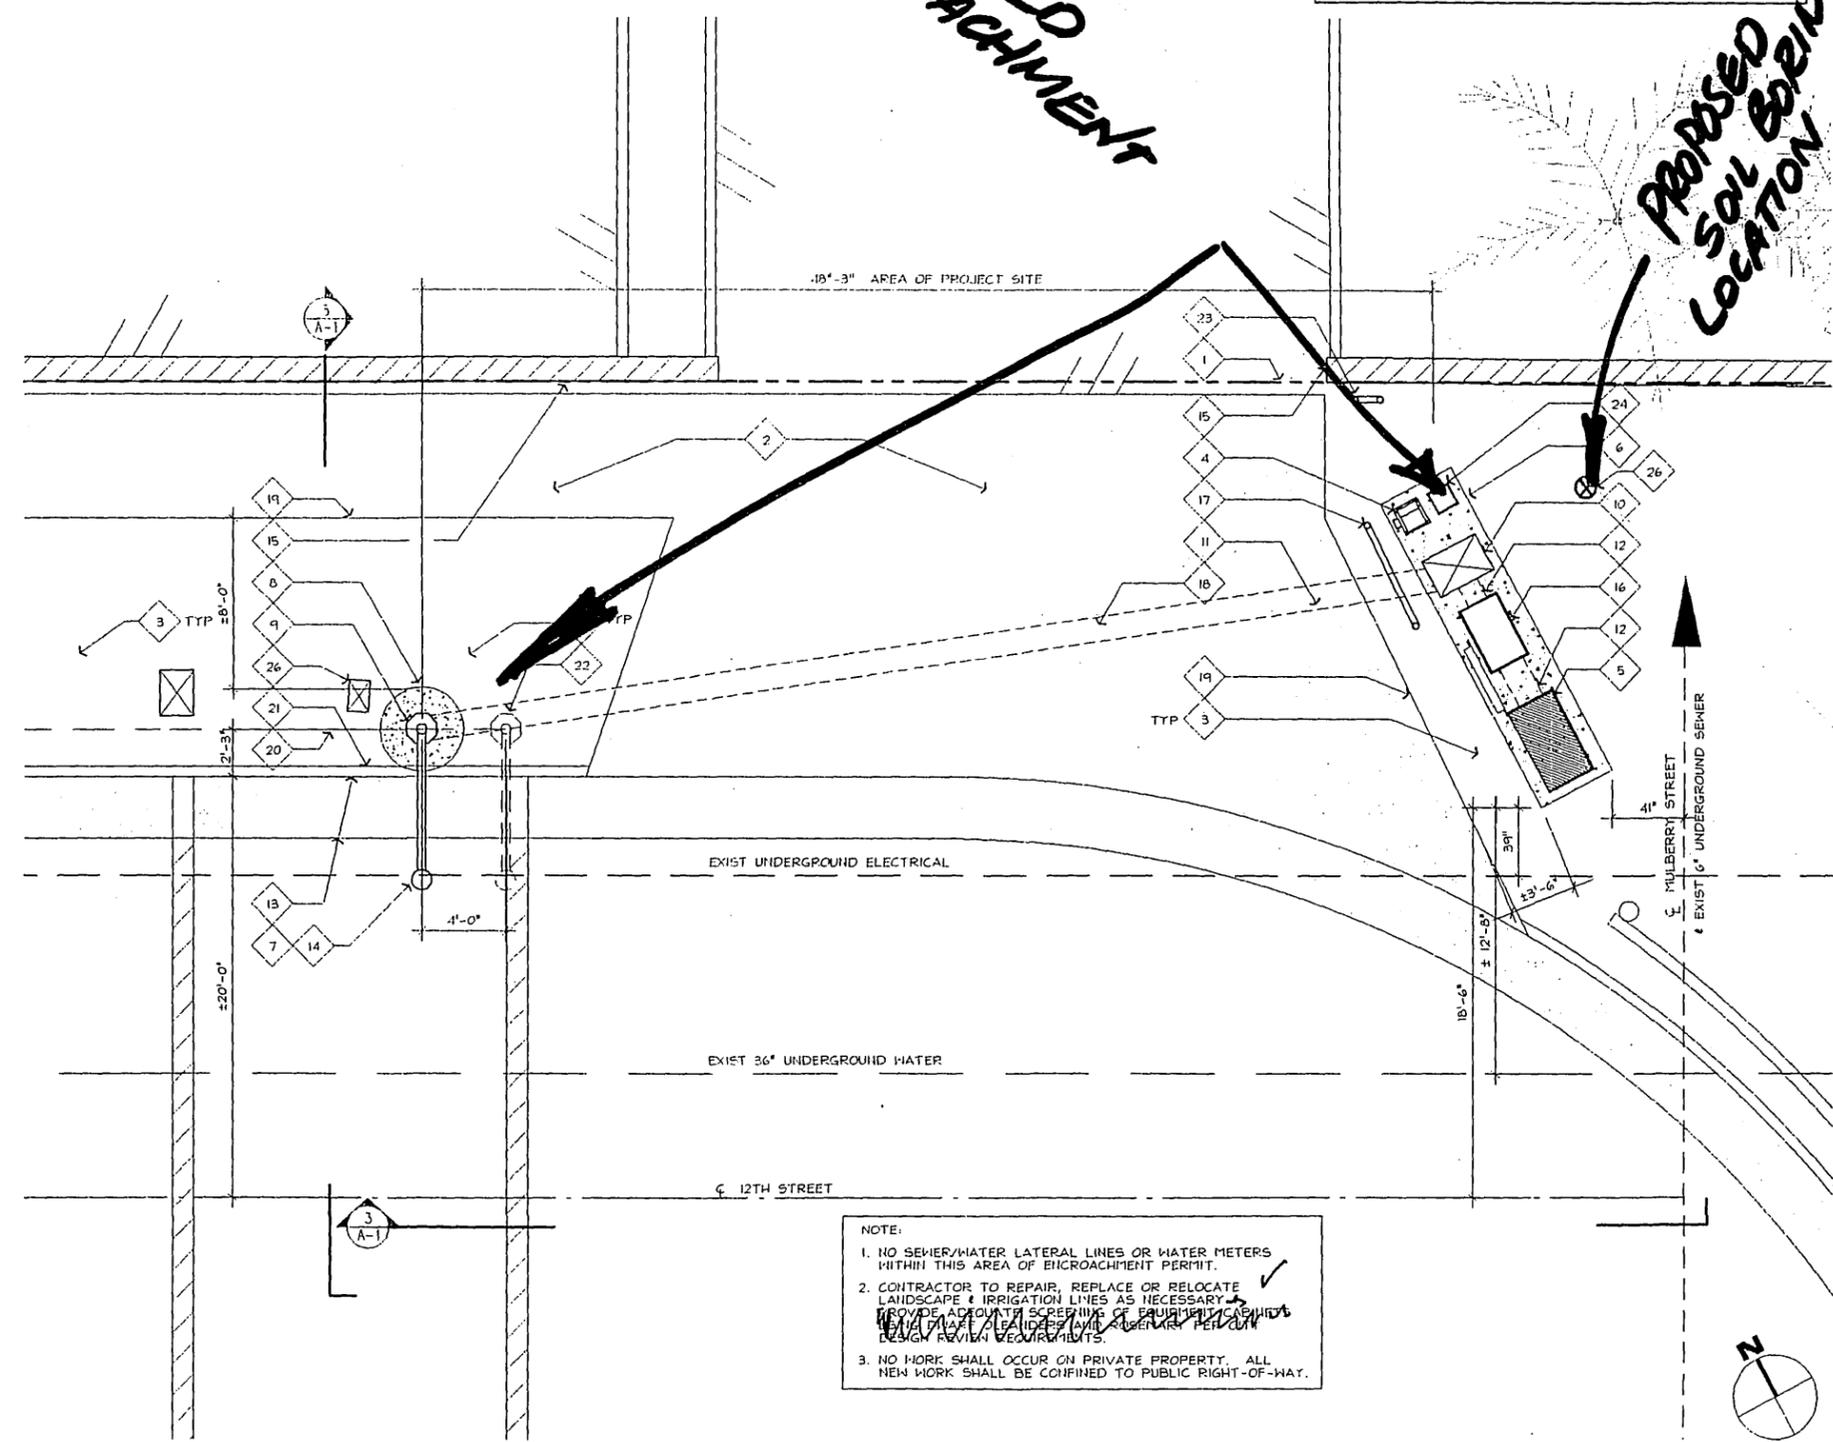

NOTE:
 1. NO SEWER/WATER LATERAL LINES OR WATER METERS WITHIN THIS AREA OF ENCROACHMENT PERMIT.
 2. CONTRACTOR TO REPAIR, REPLACE OR RELOCATE LANDSCAPE & IRRIGATION LINES AS NECESSARY. PROVIDE ADEQUATE SCREENING OF EQUIPMENT CABINETS AND MOUNTING DEVICES FROM ADJACENT PROPERTY DESIGN REVIEW REQUIREMENTS.
 3. NO WORK SHALL OCCUR ON PRIVATE PROPERTY. ALL NEW WORK SHALL BE CONFINED TO PUBLIC RIGHT-OF-WAY.

PROPRIETARY INFORMATION
 THE INFORMATION CONTAINED IN THIS SET OF CONSTRUCTION DOCUMENTS IS PROPRIETARY BY NATURE. ANY USE OR DISCLOSURE OTHER THAN THAT WHICH RELATES TO PACIFIC BELL MOBILE SERVICES IS STRICTLY PROHIBITED.

DATE: 7/5/96
 ARCHITECT: BAT
 DRAWN BY: KR
 CHECKED BY: JW

REVISIONS

REV	DATE	DESCRIPTION	BY

PACIFIC BELL
Mobile Services
 4420 ROSEWOOD DR. BLDG. 2, 4TH FLOOR
 PLEASANTON, CALIFORNIA 94588

SBA
 SBA Consulting Services, Inc.
 Project Office:
 2925 Redhill Avenue
 Costa Mesa, CA 92626
 (714) 825-8051
 (714) 825-8052

BAT
 BATtelecommunications
 Architecture & Planning
 2600 E. Coast Hwy, Suite D
 Corona Del Mar, CA 92625
 Phone: (714) 644-5221
 Fax: (714) 644-8551

SITE NUMBER:
CM-154-08 PA1-BS3

SITE TYPE:
**LIGHT POLE
 ANTENNA INSTALLATION**

LOCATION:
**MARKET
 3325 TWELFTH STREET
 RIVERSIDE, CA 92504**

TITLE:
CONSTRUCTION PLAN

SHEET NUMBER:
A-1

CONSTRUCTION PLAN

SCALE:
 1/4" = 1'-0" **1**


A-1

LAST UPDATED: 08/08/96 - 17:24
 LAST PLOTTED: 08/08/96 - 17:24

E-1309

NOT FOR CONSTRUCTION
PUBLIC WORKS PARTIAL SET
SEE CONSTRUCTION DRAWINGS
FOR DETAILS AND ADDITIONAL
INFORMATION

NOTE:
ALL EQUIPMENT BOXES WITHIN LEASE
AREA SHALL BE PAINTED WITH SINCLAIR
"FOREST GREEN" (OR EQUAL) AND
TREATED WITH AN ANTIGRAFFI COATING

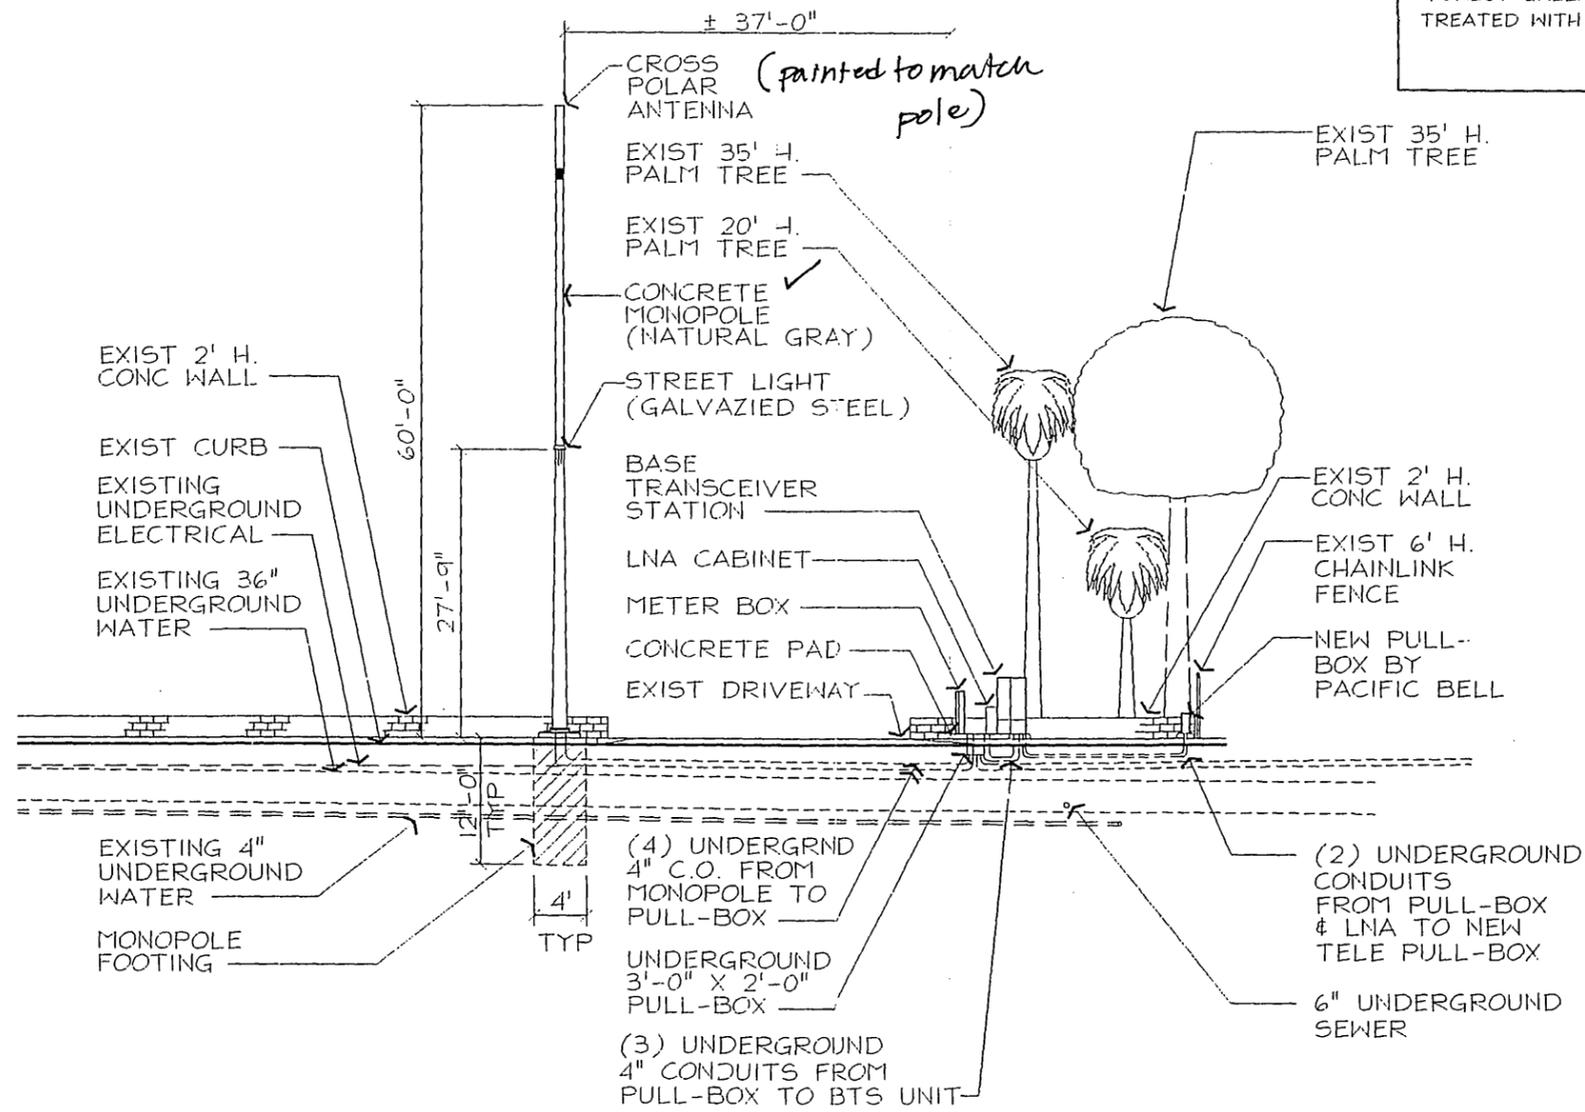

PROPRIETARY INFORMATION
THE INFORMATION CONTAINED IN THIS
SET OF CONSTRUCTION DOCUMENTS IS
PROPRIETARY BY NATURE. ANY USE
OR DISCLOSURE OTHER THAN THAT
WHICH RELATES TO PACIFIC BELL
MOBILE SERVICES IS STRICTLY PROHIBITED.

DATE: 7/5/96
ARCHITECT: BAT
DRAWN BY: KR
CHECKED BY: JW

REVISIONS			
REV	DATE	DESCRIPTION	BY
△			
△			
△			
△			

PACIFIC BELL
Mobile Services
4420 ROSEWOOD DR. BLDG. 2, 4TH FLOOR
PLEASANTON, CALIFORNIA 94588

SBA Consulting Services, Inc.
Project Office:
2955 Redhill Avenue
Costa Mesa, CA 92626
(714) 825-8052
(714) 825-8052

B&P Communications
Architecture & Planning
2600 E. Coast Hwy, Suite D
Cerrito Del Mar, CA 92525
Phone: (714) 644-8851
Fax: (714) 644-8851

SITE NUMBER:
CM-154-08 PA1-BS3

SITE TYPE:
LIGHT POLE
ANTENNA INSTALLATION

LOCATION:
MARKET
3325 TWELFTH STREET
RIVERSIDE, CA 92504

TITLE:
NORTH ELEVATION
& SECTION

SHEET NUMBER:
A-2

NORTHEAST ELEVATION & SECTION

SCALE:
1/16"=1'-0"

1


A-2

3 of 5

LAST UPDATED: 05/08/96 - 17:27
LAST PLOTTED: 05/08/96 - 17:27

NOT FOR CONSTRUCTION
PUBLIC WORKS PARTIAL SET
SEE CONSTRUCTION DRAWINGS
FOR DETAILS AND ADDITIONAL
INFORMATION

NOTE:
ALL EQUIPMENT BOXES WITHIN LEASE
AREA SHALL BE PAINTED WITH SINCLAIR
"FOREST GREEN" (OR EQUAL) AND
TREATED WITH AN ANTIGRAFFI COATING

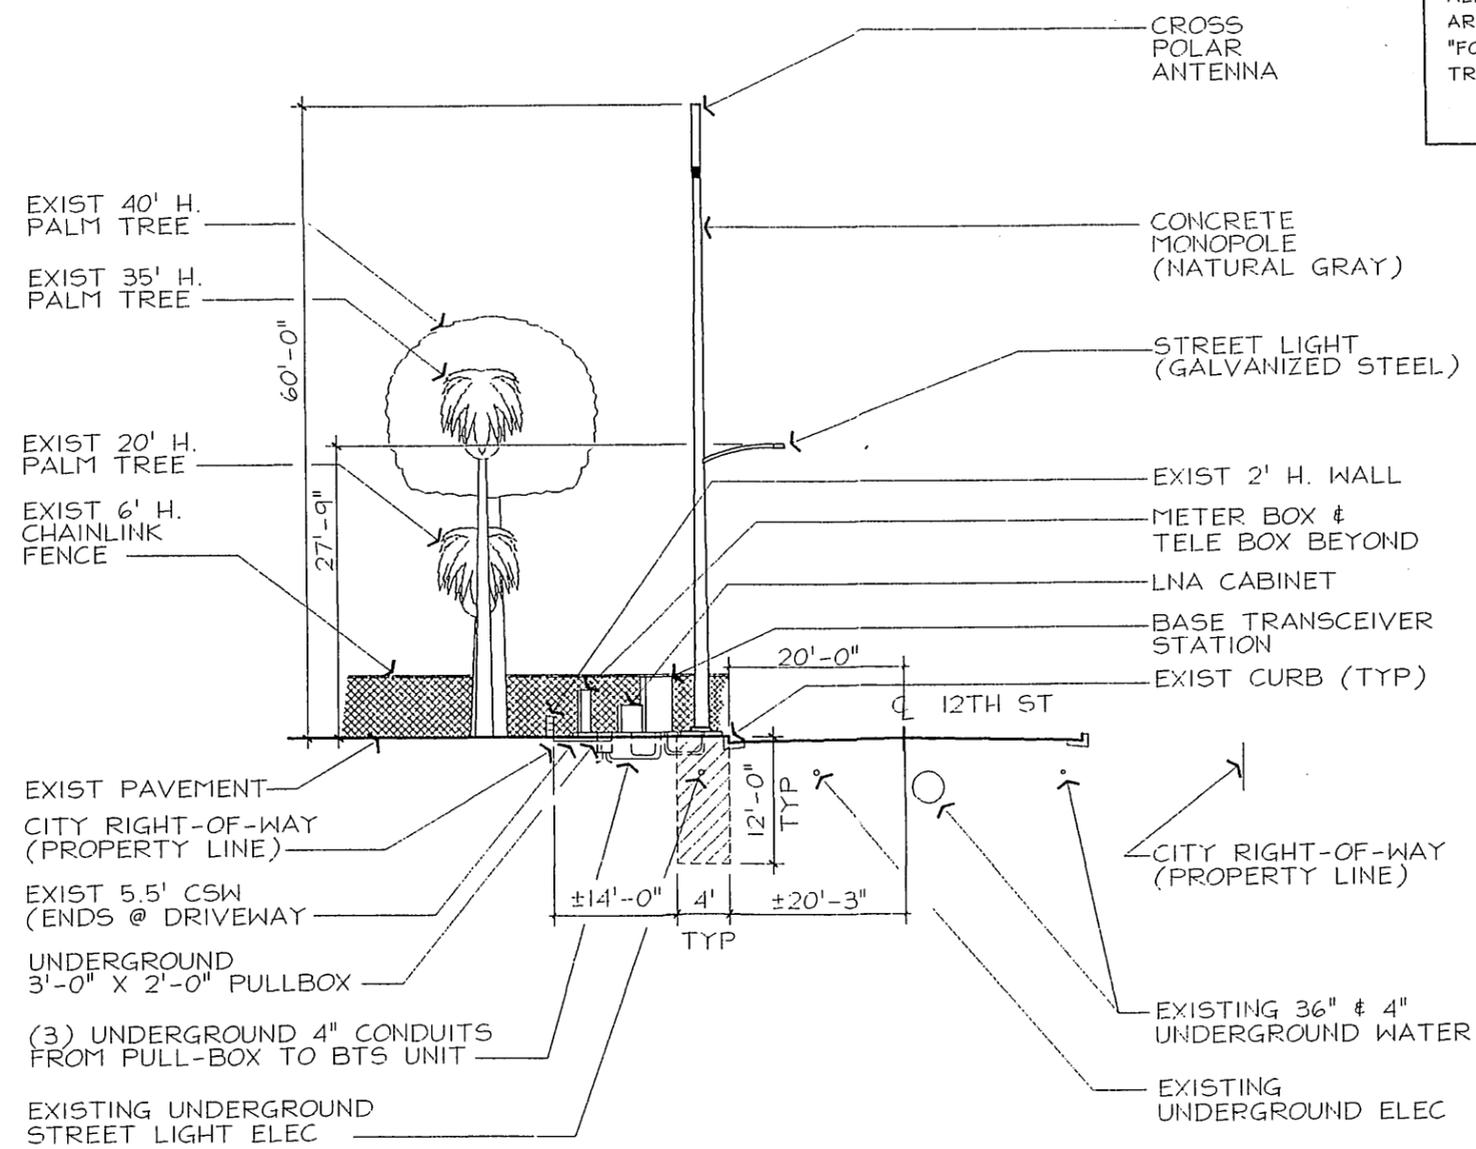

PROPRIETARY INFORMATION
THE INFORMATION CONTAINED IN THIS
SET OF CONSTRUCTION DOCUMENTS IS
PROPRIETARY BY NATURE. ANY USE
OR DISCLOSURE OTHER THAN THAT
WHICH RELATES TO PACIFIC BELL
MOBILE SERVICES IS STRICTLY PROHIBITED.

DATE: 7/5/96
ARCHITECT: BAT
DRAWN BY: KR
CHECKED BY: JW

REVISIONS			
REV	DATE	DESCRIPTION	BY
△			
△			
△			
△			

PACIFIC BELL®
Mobile Services
4420 ROSEWOOD DR. BLDG. 2, 4TH FLOOR
PLEASANTON, CALIFORNIA 94588

SBA
SBA Consulting Services, Inc.
Project Office:
2955 Redhill Avenue
Costa Mesa, CA 92626
Phone: (714) 825-8852

RA telecommunications
Architecture & Planning
2580 E. Coast Hwy, Suite D
Costa Mesa, CA 92626
Phone: (714) 844-8851

SITE NUMBER:
CM-154-08 PA1-BS3

SITE TYPE:
LIGHT POLE
ANTENNA INSTALLATION

LOCATION:
MARKET
3325 TWELFTH STREET
RIVERSIDE, CA 92504

TITLE:
EAST ELEVATION &
SECTION AT POLE

SHEET NUMBER:
A-3

SOUTHEAST ELEVATION & SECTION AT POLE

SCALE:
1/16"=1'-0" **1**

4 of 5



E-1369

LAST UPDATED: 08/08/96 - 17:29
LAST PLOTTED: 08/08/96 - 17:29

GENERAL NOTES FOR DUCT BANK REQMTS UGS-100 FOR DIRECT BURIED CABLES:

1. THE CITY WILL PROVIDE THE CABLE THE DEVELOPER WILL PROVIDE AND INSTALL THE "DB" CONDUIT.
2. THE TRANSITION INTO THE PEDESTAL WILL BE A CITY APPROVED SWEEP UP TO "PEDESTAL CONTACT INSPECTION" AT (909) 782-5429 FOR APPROVAL.
3. NO CABLE IN CONDUIT IS TO BE USED FOR ELECTRICAL SYSTEM (NO C.I.C.)
4. ONLY USE SELECT BACKFILL.
5. SIZE OF CONDUIT SHALL BE AS SPECIFIED ON CITY OF RIVERSIDE UTILITY DRAWING.
6. FOR MORE INFORMATION PLEASE CALL DAVE BRIDE AT CITY OF RIVERSIDE PUBLIC UTILITIES DEPT (909) 782-5471.

NOT FOR CONSTRUCTION
PUBLIC WORKS PARTIAL SET
SEE CONSTRUCTION DRAWINGS
FOR DETAILS AND ADDITIONAL
INFORMATION

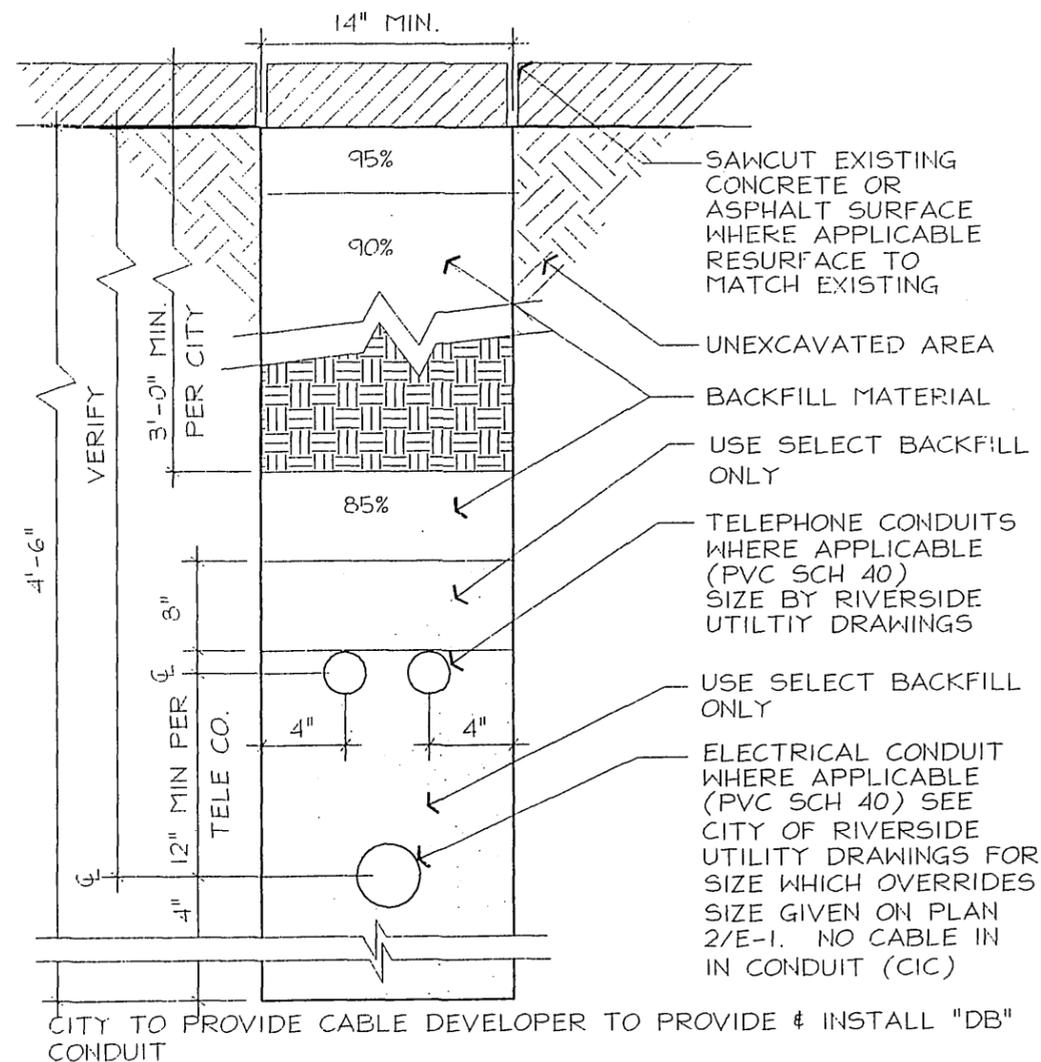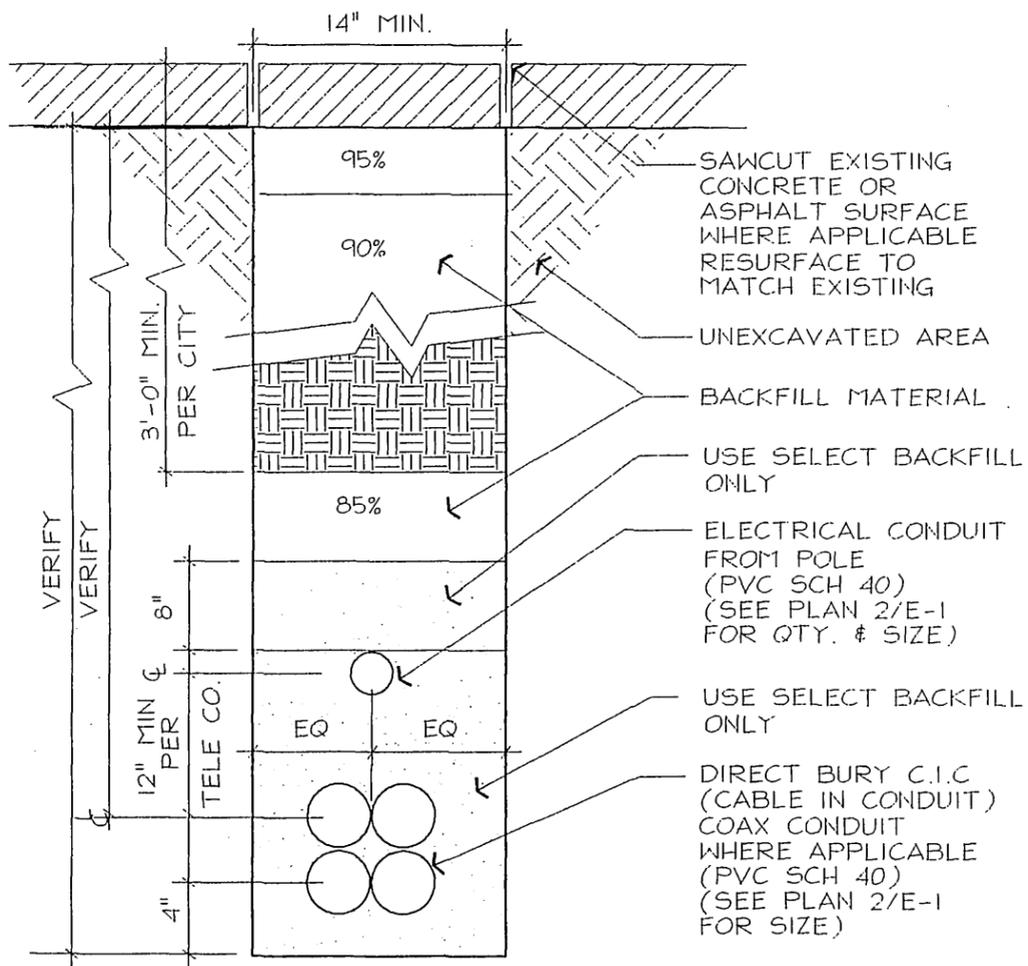

PROPRIETARY INFORMATION
THE INFORMATION CONTAINED IN THIS SET OF CONSTRUCTION DOCUMENTS IS PROPRIETARY BY NATURE. ANY USE OR DISCLOSURE OTHER THAN THAT WHICH RELATES TO PACIFIC BELL MOBILE SERVICES IS STRICTLY PROHIBITED.

DATE: 7-5-96
ARCHITECT: BAT
DRAWN BY: KR
CHECKED BY: JW

REVISIONS			
REV	DATE	DESCRIPTION	BY

PACIFIC BELL
Mobile Services
4420 ROSEWOOD DR. BLDG. 2, 4TH FLOOR
PLEASANTON, CALIFORNIA 94588

SBA Consulting Services, Inc.
Project Office:
2955 Redhill Avenue
Costa Mesa, CA 92626
(714) 825-8051
(714) 825-8052

Btelecommunications
Architecture & Planning
2500 E. Coast Hwy, Suite 0
Corona Del Mar, CA 92625
Phone: (714) 641-9321
Fax: (714) 641-9511

SITE NUMBER:
CM-154-08 PA1-BS3

SITE TYPE:
LIGHT POLE
ANTENNA INSTALLATION

LOCATION:
MARKET
3325 TWELFTH STREET
RIVERSIDE, CA 92504

TITLE:
TRENCHING
DETAILS

SHEET NUMBER:

A-4

COAX CONDUIT TRENCH

SCALE:
1 1/2"=1'-0"

6

ELEC/TELCO TRENCH

SCALE:
1 1/2"=1'-0"

3

LAST UPDATED: 08/08/96 - 15:08
LAST PLOTTED: 08/08/96

E-1369