
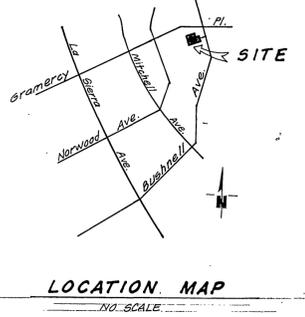


NOTE: ALL EXISTING ELEVATIONS & LOCATIONS MUST BE VERIFIED BEFORE TIME OF CONSTRUCTION.

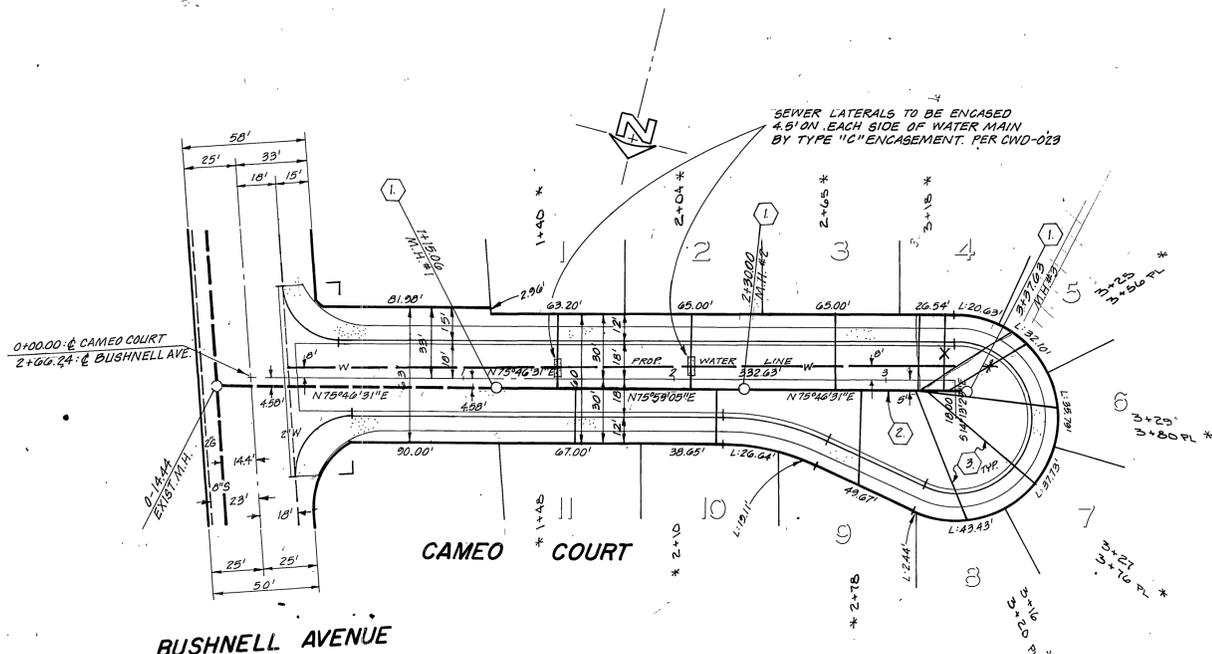

GENERAL NOTES

- IT SHALL BE THE RESPONSIBILITY OF THE CONTRACTOR TO CLEAR THE RIGHT OF WAY IN ACCORDANCE WITH THE PROVISIONS OF LAW AS IT AFFECTS EACH UTILITY INCLUDING IRRIGATION LINES AND APPURTENANCES AND AT NO COST TO THE CITY.
- CONSTRUCTION SHALL BE IN ACCORDANCE WITH THE CITY OF RIVERSIDE, DEPT. OF PUBLIC WORKS, STANDARD DRAWINGS, AND THE STANDARD SPECIFICATIONS FOR PUBLIC WORKS CONSTRUCTION, 1976 EDITION.
- LOCATION OF LATERALS TO BE DETERMINED IN THE FIELD AT THE DIRECTION OF THE OWNER. AVOID CONFLICT WITH PROPOSED AND/OR EXISTING FACILITIES.
- CONTRACTOR IS TO VERIFY EXISTING SEWER ELEVATION PRIOR TO CONSTRUCTION.
- THE SEWER CONTRACTOR SHALL ADJUST MANHOLES TO FINAL GRADE AFTER PAVING IS COMPLETED.
- A PLUG SHALL BE INSTALLED AND WILL REMAIN IN PLACE WHERE THE NEW SEWER CONNECTS WITH THE EXISTING SEWER UNTIL THE NEW SEWER IS ACCEPTED BY THE CITY.
- THE PRIVATE ENGINEER SIGNING THESE PLANS IS RESPONSIBLE FOR THE ACCURACY AND ACCEPTABILITY OF THE WORK HEREON. IN THE EVENT OF DISCREPANCIES ARISING DURING CONSTRUCTION, THE PRIVATE ENGINEER SIGNING THE PLANS SHALL BE RESPONSIBLE FOR DETERMINING AN ACCEPTABLE SOLUTION AND REVISING THE PLANS FOR APPROVAL BY THE CITY.

CONSTRUCTION NOTES:

- CONSTRUCT MANHOLE PER STD. PLAN #500.
- CONSTRUCT 8" V.C.P. SEWER MAIN.
- CONSTRUCT 4" V.C.P. HOUSE LATERAL.

Contractor agrees that he shall assume sole and complete responsibility for job site conditions during the course of construction of this Project, including safety of all persons and property; that this requirement shall apply continuously and not be limited to normal working hours; and that the Contractor shall defend, indemnify and hold the Owner and the Engineer harmless from any and all liability, real or alleged, in connection with the performance of work on this Project, excepting for liability arising from the sole negligence of the Owner or the Engineer.



BENCH MARK
P.K. & C.R. TAG IN MOST W/LY. CURB RETURN
NEAR DROUKEN P.K. @ F2-C CORNER OF GRAMERCY
& LA SIERRA. SET PER. @-19 ELEV. CALC. PER @-19
REF @-19 GRAMERCY RESET PER. C.R.F.D. 905/97
ELEV. 740.706

| | | | |
|--|--|--|--|
| CITY OF RIVERSIDE, CALIF. DOMESTIC SYSTEM BY <i>Marky Miller</i> 4-18-77 CHIEF UTILITIES ENGINEER, WATER DATE | J. F. DAVIDSON ASSOCIATES CIVIL ENGINEERS - SURVEYORS - PLANNERS RIVERSIDE, CALIFORNIA APPROVED BY <i>John W. Curtis</i> DATE 2/12/77 R.E. No. 17550 | CITY OF RIVERSIDE, CALIFORNIA DEPARTMENT OF PUBLIC WORKS APPROVED BY <i>William D. Hansen</i> DIRECTOR OF PUBLIC WORKS DATE 10/13/77 | INDEXED P.R. PROJECT NO. |
| | | | SEWER PLAN AND PROFILE TRACT 8586 CAMEO COURT SHEET 1 OF 1 FILE NO. 5525 |
| W.O. 5077 FOR MAYCO DEV. CO. F.B. 1104 | DESIGNED BY <i>D.S.</i> DRAWN BY <i>D.S.</i> CHECKED BY | HORIZ. SCALE: 1" = 6' VERT. SCALE: 1" = 6' | AS BUILT 7/15/78 TBK |