


PROFILE
SCALE: HORIZ. 1"=40'
VERT. 1"=4'

PLAN
SCALE: 1"=40'

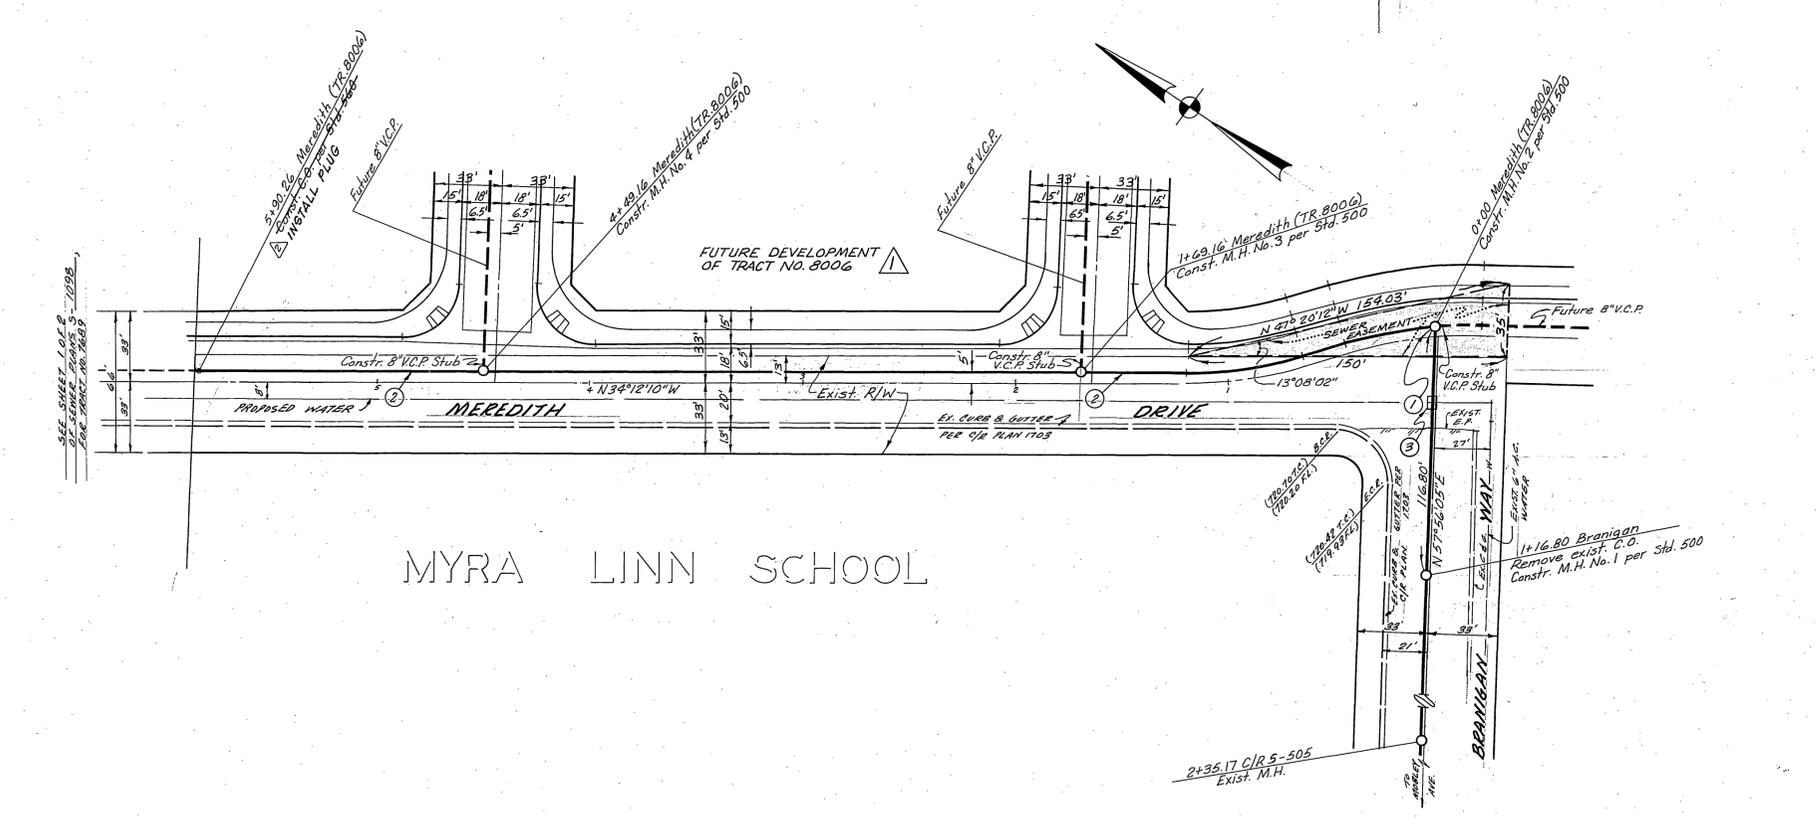

MYRA LINN SCHOOL

CONSTRUCTION NOTES

- ① - CONSTRUCT SEWER MANHOLE PER CITY OF RIVERSIDE STD. DWG. NO. 500.
- ② - CONSTRUCT 8" V.C.P. SEWER MAIN.
- ③ - ENCASE SEWER MAIN 4.5' EACH SIDE OF WATER MAIN CROSSING WITH TYPE "C" CONCRETE ENCASUREMENT AS PER PUBLIC UTILITY DWG. CWD-023.

SEWER NOTES

1. CONSTRUCTION SHALL BE IN ACCORDANCE WITH THE CITY OF RIVERSIDE, DEPT. OF PUBLIC WORKS, STANDARD DRAWINGS, AND THE STANDARD SPECIFICATIONS FOR PUBLIC WORKS CONSTRUCTION, 1976 EDITION.
2. CONTRACTOR IS TO VERIFY EXISTING SEWER ELEVATION PRIOR TO CONSTRUCTION.
3. A PLUG SHALL BE INSTALLED AND WILL REMAIN IN PLACE WHERE THE NEW SEWER CONNECTS WITH THE EXISTING SEWER UNTIL THE NEW SEWER IS ACCEPTED BY THE CITY.

THE PRIVATE ENGINEER SIGNING THESE PLANS IS RESPONSIBLE FOR ASSURING THE ACCURACY AND ACCEPTABILITY OF THE WORK HEREON. IN THE EVENT OF DISCREPANCIES ARISING DURING CONSTRUCTION AS A RESULT OF ERRORS OR OMISSIONS, THE PRIVATE ENGINEER SHALL BE RESPONSIBLE FOR DETERMINING AN ACCEPTABLE SOLUTION AND REVISING THE PLANS FOR APPROVAL BY THE CITY.

CITY OF RIVERSIDE DOMESTIC WATER SYSTEM		BENCH MARK F.D. BESS DISC. STAMPED P.S.A. CAPED @ INTERSECTION OF WELLS AVE. & TYLER ST. P.S. 785/12 P.S.A. ELEV. 749.491		C.E.L.S. CORPORATION 4570 CAMPUS DRIVE, SUITE 3 NEWPORT BEACH, CALIF. 92660 TEL. (714) 556-7781		CITY OF RIVERSIDE, CALIFORNIA PUBLIC WORKS DEPARTMENT		SEWER EXTENSION SEWER PLAN MEREDITH DRIVE & BRANIGAN WAY FOR TRACT 7689		ACCOUNT NO. DRAWING NUMBER 5-1099
APPROVED BY: <i>Wesley Hyatt</i> 5-2-77 CHIEF UTILITIES ENGINEER, DATE WATER		APPROVED BY: <i>[Signature]</i> DATE 11/18/70 R.E. No. 21366		DELETED C.O. 491 Redesign for Tr. 8006 REVISIONS: [Signature] DATE 11/18/70		APPROVED BY: PRINCIPAL ENGINEER PARK DEPARTMENT TRAFFIC DIVISION CHIEF PUB. WKS. ENGR.		APPROVED BY: <i>[Signature]</i> DIRECTOR OF PUBLIC WORKS DATE 8/2/77		SHEET 1 OF 1

* AS BUILT 8-78 RPT INDEXED P.B.