

Quantity
 10" PVC (Sched 40) 85 LF ±
 90° Elbow Fittings 4 Ea
 Connector Fittings 2 Ea
 10" Plug (End) 1 Ea


SECTION A-A
 @ Sta. 14+75.00
 10" PVC Private Irrigation Line (ENCROACHMENT PERMIT NO. E-831)
 1" = 125' Horiz
 1" = 2' Vert

CONSTRUCTION NOTES:

- ① CONSTRUCT MANHOLE PER CITY OF RIVERSIDE STD. NO. 500.
- ② CONSTRUCT 8" V.C.P. SEWER.


CURVE DATA

NO	R	Δ	L	T
①	305.00	17°44'48"	94.47'	47.62'
②	300.00	21°40'11"	113.46'	57.42'

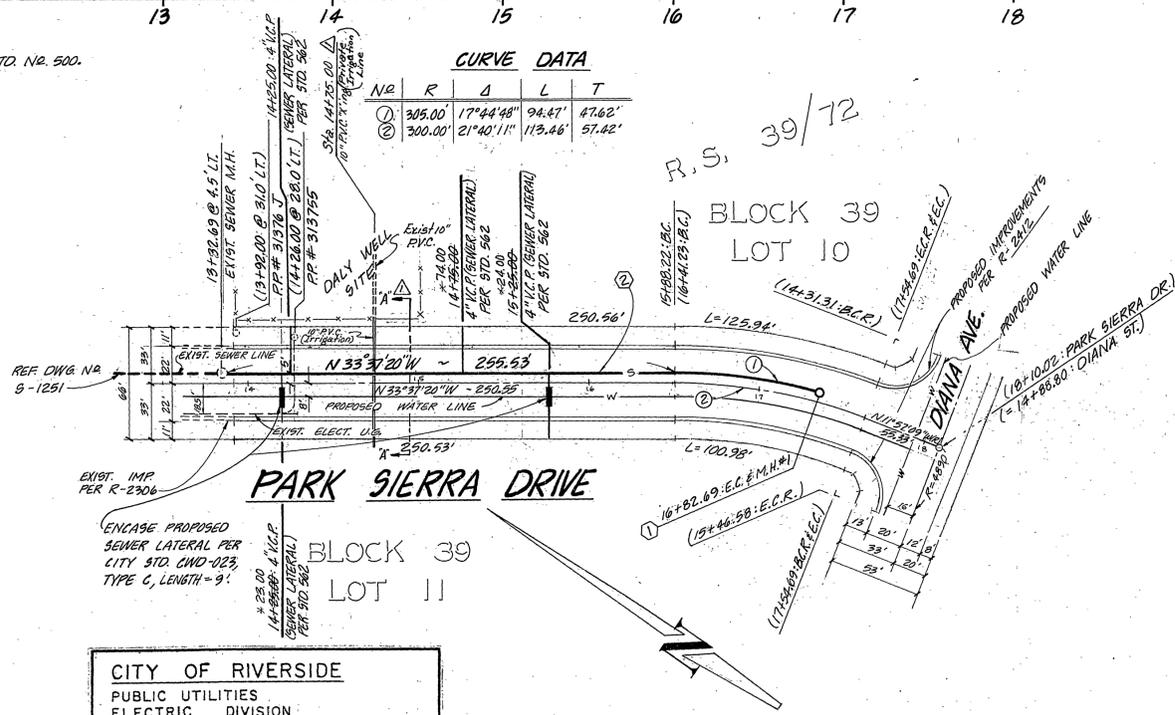

GENERAL NOTES:

1. IT SHALL BE THE RESPONSIBILITY OF THE CONTRACTOR TO CLEAR THE R/W IN ACCORDANCE WITH THE PROVISIONS OF LAW AS IT AFFECTS EACH UTILITY INCLUDING IRRIGATION LINES AND APPURTENANCES AND AT NO COST TO THE CITY.
2. CONSTRUCTION SHALL BE IN ACCORDANCE WITH THE CITY OF RIV. DEPT. PUBLIC WORKS, STD. DWGS, & THE STD. SPEC. FOR PUBLIC WORKS CONSTRUCTION, 1979 EDITION.
3. LOCATION OF LATERALS TO BE DETERMINED IN THE FIELD AT THE DIRECTION OF THE OWNER. AVOID CONFLICT WITH PROPOSED AND/OR EXISTING FACILITIES.
4. CONTRACTOR IS TO VERIFY EXISTING SEWER ELEVATION PRIOR TO CONSTRUCTION.
5. THE SEWER CONTRACTOR SHALL ADJUST MANHOLES TO FINAL GRADE AFTER PAVING IS COMPLETED.
6. A PLUG SHALL BE INSTALLED AND WILL REMAIN IN PLACE WHERE THE NEW SEWER CONNECTS WITH THE EXISTING SEWER UNTIL THE NEW SEWER IS ACCEPTED BY THE CITY.
7. THE PRIVATE ENGINEER SIGNING THESE PLANS IS RESPONSIBLE FOR THE ACCURACY & ACCEPTABILITY OF THE WORK HEREON. IN THE EVENT OF DISCREPANCIES ARISING DURING CONSTRUCTION THE PRIVATE ENGINEER SIGNING THE PLANS SHALL BE RESPONSIBLE FOR DETERMINING AN ACCEPTABLE SOLUTION AND REVISING THE PLANS FOR APPROVAL BY THE CITY.
8. THE EXISTENCE AND LOCATION OF ANY UNDERGROUND UTILITY LINES OR STRUCTURES SHOWN ON THESE PLANS WERE OBTAINED BY A SEARCH OF THE AVAILABLE RECORDS. TO THE BEST OF OUR KNOWLEDGE THERE ARE NO EXISTING UTILITIES EXCEPT AS SHOWN ON THESE PLANS. THE CONTRACTOR IS REQUIRED TO TAKE DUE PRECAUTIONARY MEASURES TO PROTECT THE UTILITIES SHOWN AND ANY OTHERS NOT SHOWN OR NOT OF RECORD.
9. SEE "STREET LIGHTING PLAN" FOR QUANTITY AND LOCATION OF PROPOSED STREET LIGHTS AND ELECTRICAL UNDERGROUND INSTALLATION REQUIREMENTS.
- ⑩ QUANTITIES ARE FOR INFORMATION ONLY & THE CITY OF RIVERSIDE IS NOT RESPONSIBLE FOR THEIR ACCURACY.

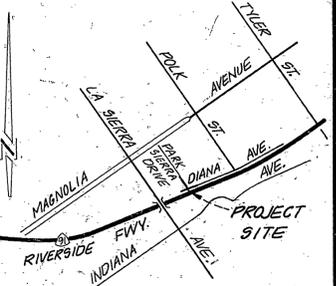

VICINITY MAP
 NO SCALE

NOTE:

1. STATIONINGS WITHIN PARENTHESES REFER TO STREET & STATIONING.
2. ELEVATIONS WITHIN PARENTHESES REFER TO EXISTING ELEVATIONS.

Underground Service Alert
 Call: TOLL FREE
1-800-422-4133
 48 Hours Before You Dig

CITY OF RIVERSIDE
 PUBLIC UTILITIES
 ELECTRIC DIVISION
 [Signature] 10-5-81
 DATE

CITY OF RIVERSIDE
 DOMESTIC SYSTEM
 [Signature] 4/23/11
 DATE

J. F. DAVIDSON ASSOCIATES
 CIVIL ENGINEERS - SURVEYORS - PLANNERS
 RIVERSIDE, CALIFORNIA
 APPROVED BY [Signature] DATE 4/13/10
 R.E. No. 17550

CITY OF RIVERSIDE, CALIFORNIA
 DEPARTMENT OF PUBLIC WORKS
 APPROVED BY [Signature]
 DIRECTOR OF PUBLIC WORKS
 DATE 12-29-81

SEWER PLANS
PARK SIERRA DR.
 STA. 13+90.67 TO STA. 18+19.70
 HORIZ. SCALE: 1" = 50'
 VERT. SCALE: 1" = 5'

PROJECT NO. S-1285
 SHEET 1 OF 1
 FILE NO. 80-7055 (N)

Bench Mark
 CIV. OF HWY. BRASS
 DISC. IN CONC. STAMPED
 601-7-68 FLUSH W/ BRD.
 86' SW FROM & POLK ST
 & 9' SE OF & MAGNOLIA
 AVENUE.
 ELEV. = 787.161'

DATUM NOTE: REFER
 TO ALBERT A. WEBB 1990C.
 PLANS BY CITY OF RIVERSIDE
 DRAWING NO. R-2306

P.C. 1095