


PROFILE SCALES  
 HORIZ. 1"=20'  
 VERT. 1"=20'

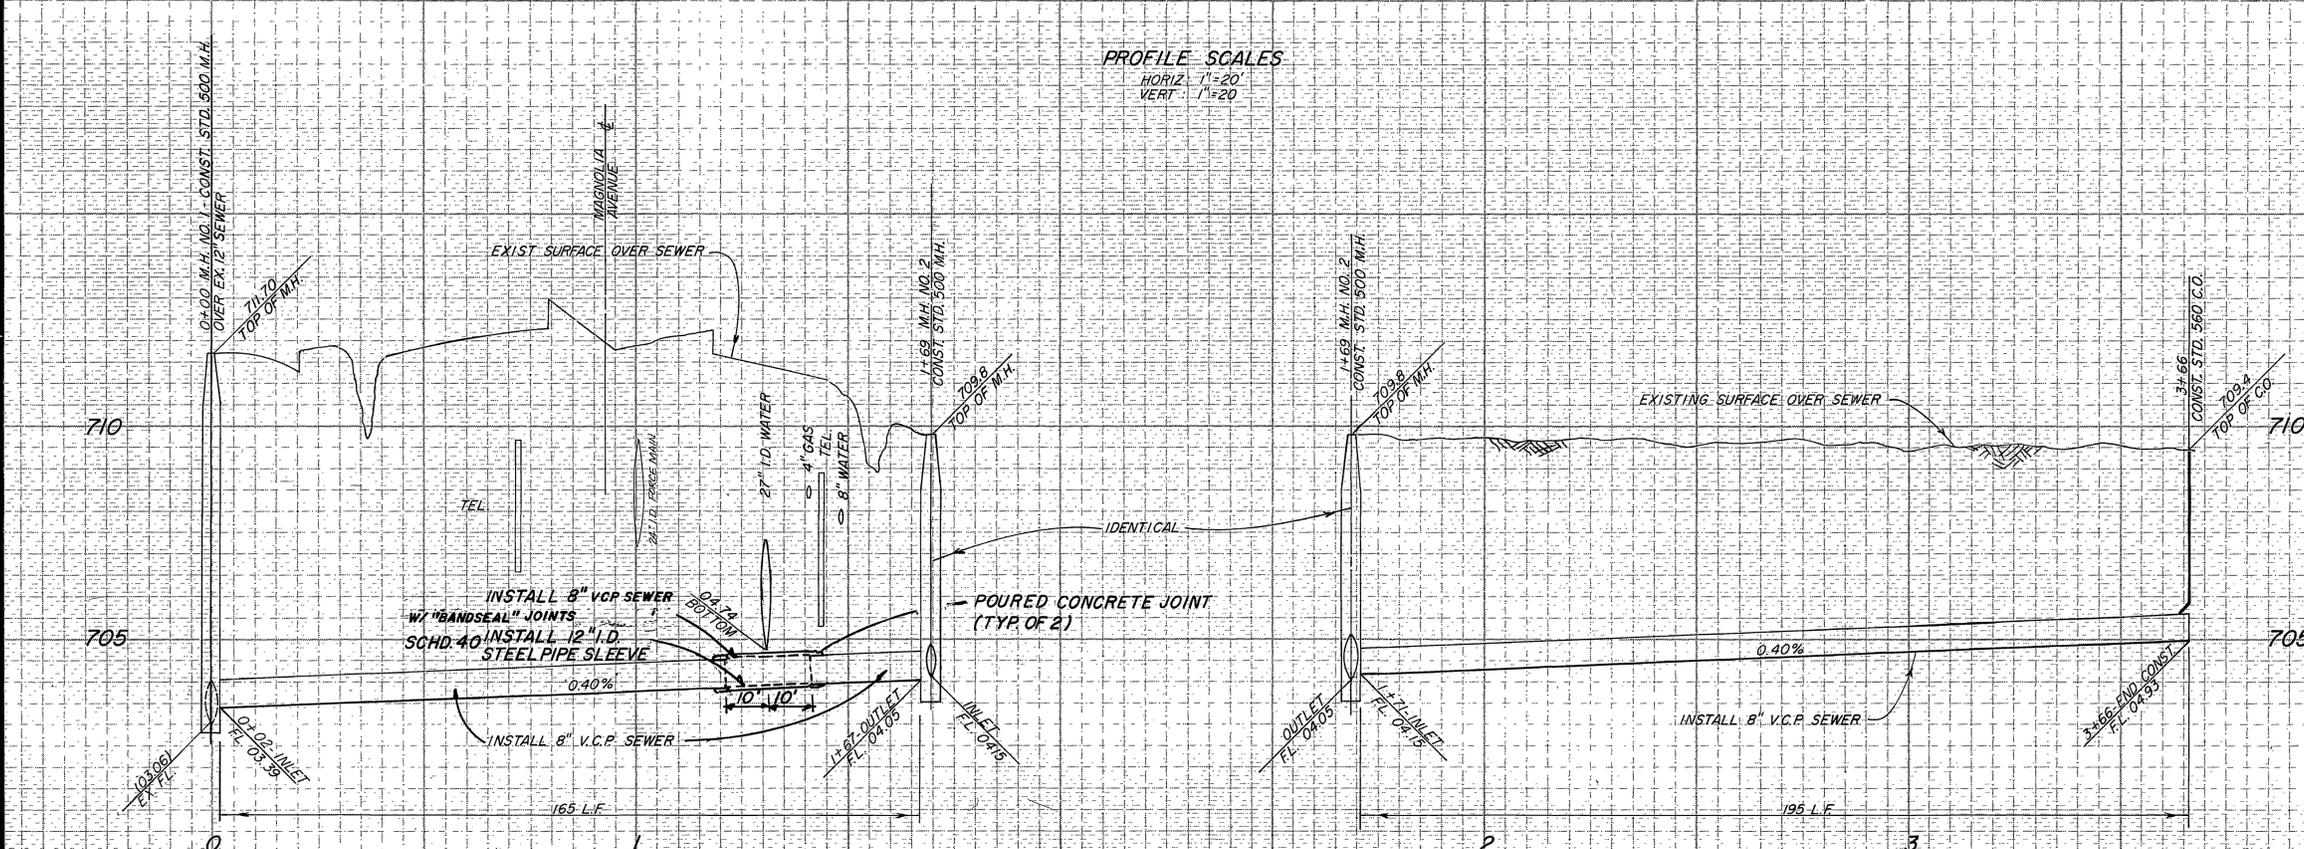


- QUANTITY ESTIMATE**
- 340 L.F. 8" V.C.P. SEWER
  - 2 EA. MANHOLES
  - 1 EA. 8" CLEANOUTS
  - 80 LIN. FT. PAVEMENT REMOVAL AND RESURFACING
  - LUMP SUM - EXCAVATION & BACKFILLING
  - 20 L.F. 12" STEEL PIPE

**BENCH MARK**  
 U.S.G.S. BRASS DISC SET ON TOP OF  
 HEADWALL AT W. SIDE OF FILLMORE  
 ST. AND 15' N.Y. OF A.T. & P. RAILROAD  
 TRACKS - STAMPED K-38, 1924  
 ELEV. = 722.01

**GENERAL NOTES**

- IT SHALL BE THE RESPONSIBILITY OF THE CONTRACTOR TO CLEAR THE RIGHT OF WAY IN ACCORDANCE WITH THE PROVISIONS OF LAW AS IT AFFECTS EACH UTILITY INCLUDING IRRIGATION LINES AND APPURTENANCES AND AT NO COST TO THE CITY.
- CONSTRUCTION SHALL BE IN ACCORDANCE WITH THE CITY OF RIVERSIDE DEPARTMENT OF PUBLIC WORKS STANDARD DRAWINGS, AND THE STANDARD SPECIFICATIONS FOR PUBLIC WORKS CONSTRUCTION, 1982 EDITION.
- LOCATION OF LATERALS TO BE DETERMINED IN THE FIELD AT THE DIRECTION OF THE OWNER. AVOID CONFLICT WITH PROPOSED AND/OR EXISTING FACILITIES.
- CONTRACTOR IS TO VERIFY EXISTING SEWER ELEVATION PRIOR TO CONSTRUCTION.
- QUANTITIES SHOWN ARE FOR INFORMATION ONLY AND THE CITY OF RIVERSIDE IS NOT RESPONSIBLE FOR THEIR ACCURACY.
- ANY TRAFFIC CONTROL STRIPING OBLITERATED DURING CONSTRUCTION SHALL BE RESTORED BY THE CONTRACTOR WITHIN FIVE DAYS AFTER NOTIFICATION FROM THE CITY INSPECTORS.
- THE SEWER CONTRACTOR SHALL ADJUST MANHOLES TO FINAL GRADE AFTER PAVING IS COMPLETED.
- A PLUG SHALL BE INSTALLED AND WILL REMAIN IN PLACE WHERE THE NEW SEWER CONNECTS WITH THE EXISTING SEWER UNTIL THE NEW SEWER IS ACCEPTED BY THE CITY.
- THE PRIVATE ENGINEER SIGNING THESE PLANS IS RESPONSIBLE FOR ASSURING THE ACCURACY AND ACCEPTABILITY OF THE WORK HEREON. IN THE EVENT OF DISCREPANCIES ARISING DURING CONSTRUCTION AS A RESULT OF ERRORS OR OMISSIONS, THE PRIVATE ENGINEER SHALL BE RESPONSIBLE FOR DETERMINING AN ACCEPTABLE SOLUTION AND REVISING THE PLANS FOR APPROVAL BY THE CITY.
- NO FINISHED FLOOR ELEVATION SHALL BE LESS THAN 4' ABOVE THE SEWER FLOWLINE AT THE POINT OF CONNECTION WITHOUT HAVING AN APPROVED BACKWATER VALVE INSTALLED IN THE LATERAL.

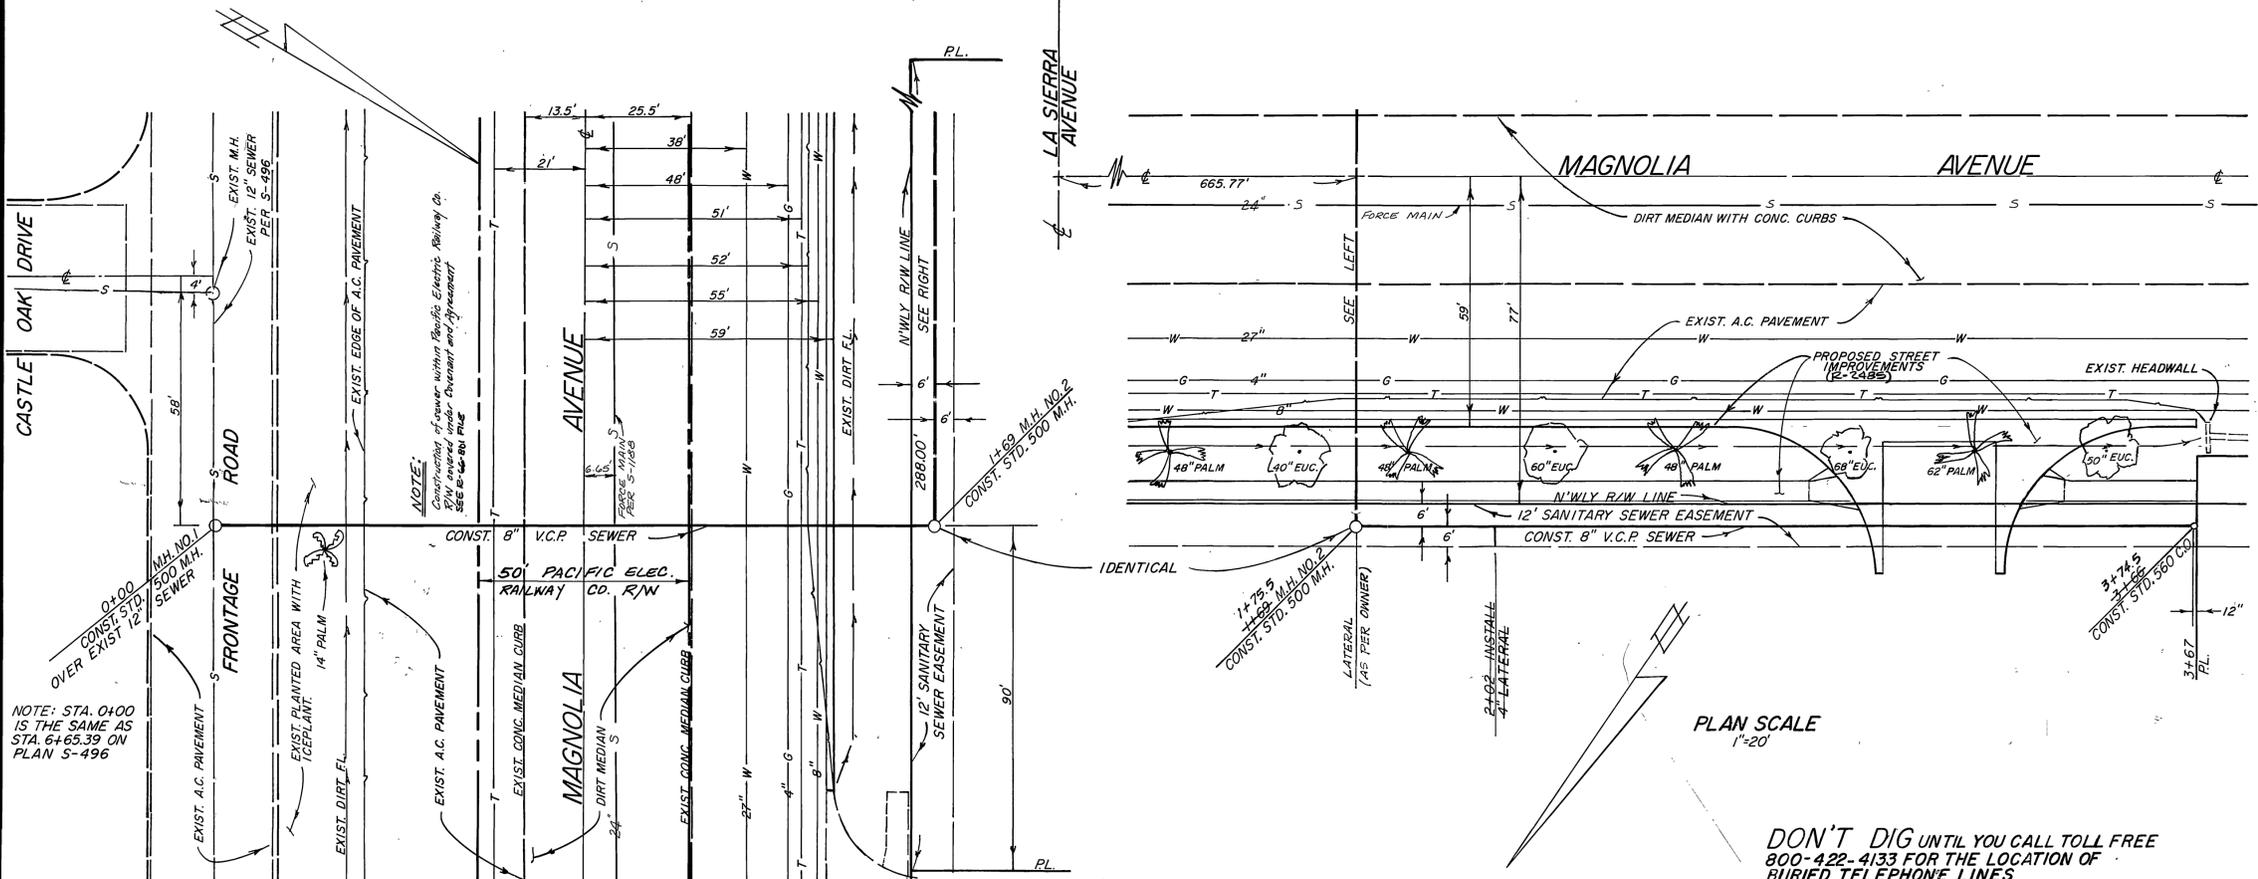

**DON'T DIG UNTIL YOU CALL TOLL FREE**  
 800-422-4133 FOR THE LOCATION OF  
 BURIED TELEPHONE LINES

PACIFIC TELEPHONE SO. CALIF. GAS CO.		CITY OF RIVERSIDE OVERHEAD & UNDERGROUND DATE: 9/16/82	CITY OF RIVERSIDE DOMESTIC SYSTEMS DATE: 8-30-82	BYRON B. JOHNSON JR. AND PHIL K. MOSLEY CIVIL ENGINEERING & SURVEYING 1033 E. ROSEWOOD CT., ONTARIO, CA. 91764 R.C.E. NO. 12492 DATE: 8/30/82	CITY OF RIVERSIDE, CALIFORNIA PUBLIC WORKS DEPARTMENT APPROVED BY: [Signature] DATE: 9/17/82 TRAFFIC DIVISION CHIEF PUB. WKS. ENGR. [Signature] DATE: 9/17/82	ACCOUNT No. DRAWING NUMBER <b>S-1304</b> SHEET 1 OF 1
DATE: 9/16/82		DATE: 9-16-82	DATE: 8-30-82	DATE: 8/30/82	DATE: 9/17/82	SCALE: HORIZ: 1"=20' VERT: 1"=2'