


- SEWER GENERAL NOTES**
- Construction shall be in accordance with Standard Specifications for Public Works Construction, Current Edition, and the City of Riverside Standard Drawing No. 10.
 - It shall be the responsibility of the contractor to clear the right of way in accordance with the provisions of the law as it affects each utility including irrigation lines and appurtenances and at no cost to the City.
 - Manhole frames and covers to be set to proposed pavement grades.
 - Prior to construction of sewer, contractor is to expose existing sewer and contact engineer for verification of existing elevation.
 - The sewer contractor shall adjust manholes to final grade after paving is completed.
 - A plug shall be installed and will remain in place where the new sewer connects with the existing sewer until the new sewer is accepted by the City.
 - All flagged elevations shall be staked in the field by the private engineer.
 - Laterals are 4" & 6" V.C.P. and extend to the property line per City of Riverside Standard No. 562.
 - Location of laterals to be determined in the field at the direction of the owner. Avoid conflict with proposed and / or existing facilities.
 - No finished floor elevation shall be less than 4' above the sewer flow line at point of connection without having a proper backwater valve installed in the lateral.
 - The private engineer signing these plans is responsible for assuring the accuracy and acceptability of the work hereon. In the event of discrepancies arising during construction, the private engineer shall be responsible for determining an acceptable solution and revising the plans for approval by the City.
 - The contractor shall call in a location request to Underground Service Alert (USA), Phone No. 1-800-422-4133, two working days before digging. No construction permit will be issued by the Public Works Department involving excavation for underground facilities unless the applicant has been provided an inquiry identification number by U.S.A.
 - The developer shall be responsible for preserving or re-establishing and referencing survey monuments destroyed, disturbed or buried as a result of construction shown hereon.
 - Any traffic control striping obliterated and/or badly worn during construction shall be restored by the contractor within five days after notification from the City Inspectors.



- UNDERGROUND UTILITY NOTES:**
- Locations of substructures as shown on plans are shown from the best available information, however, such locations as shown or failure to show existing substructures shall not relieve the contractors from the responsibility of verifying the location and protecting all substructures.
 - It shall be the responsibility of the contractor to contact and make necessary arrangements with the appropriate utility companies prior to the beginning of construction.
 - Contractor shall notify Underground Service Alert at least two days prior to construction. Phone: 800-422-4133.
- * As built 4-19-88 TE
- INDEXED BY C.S.

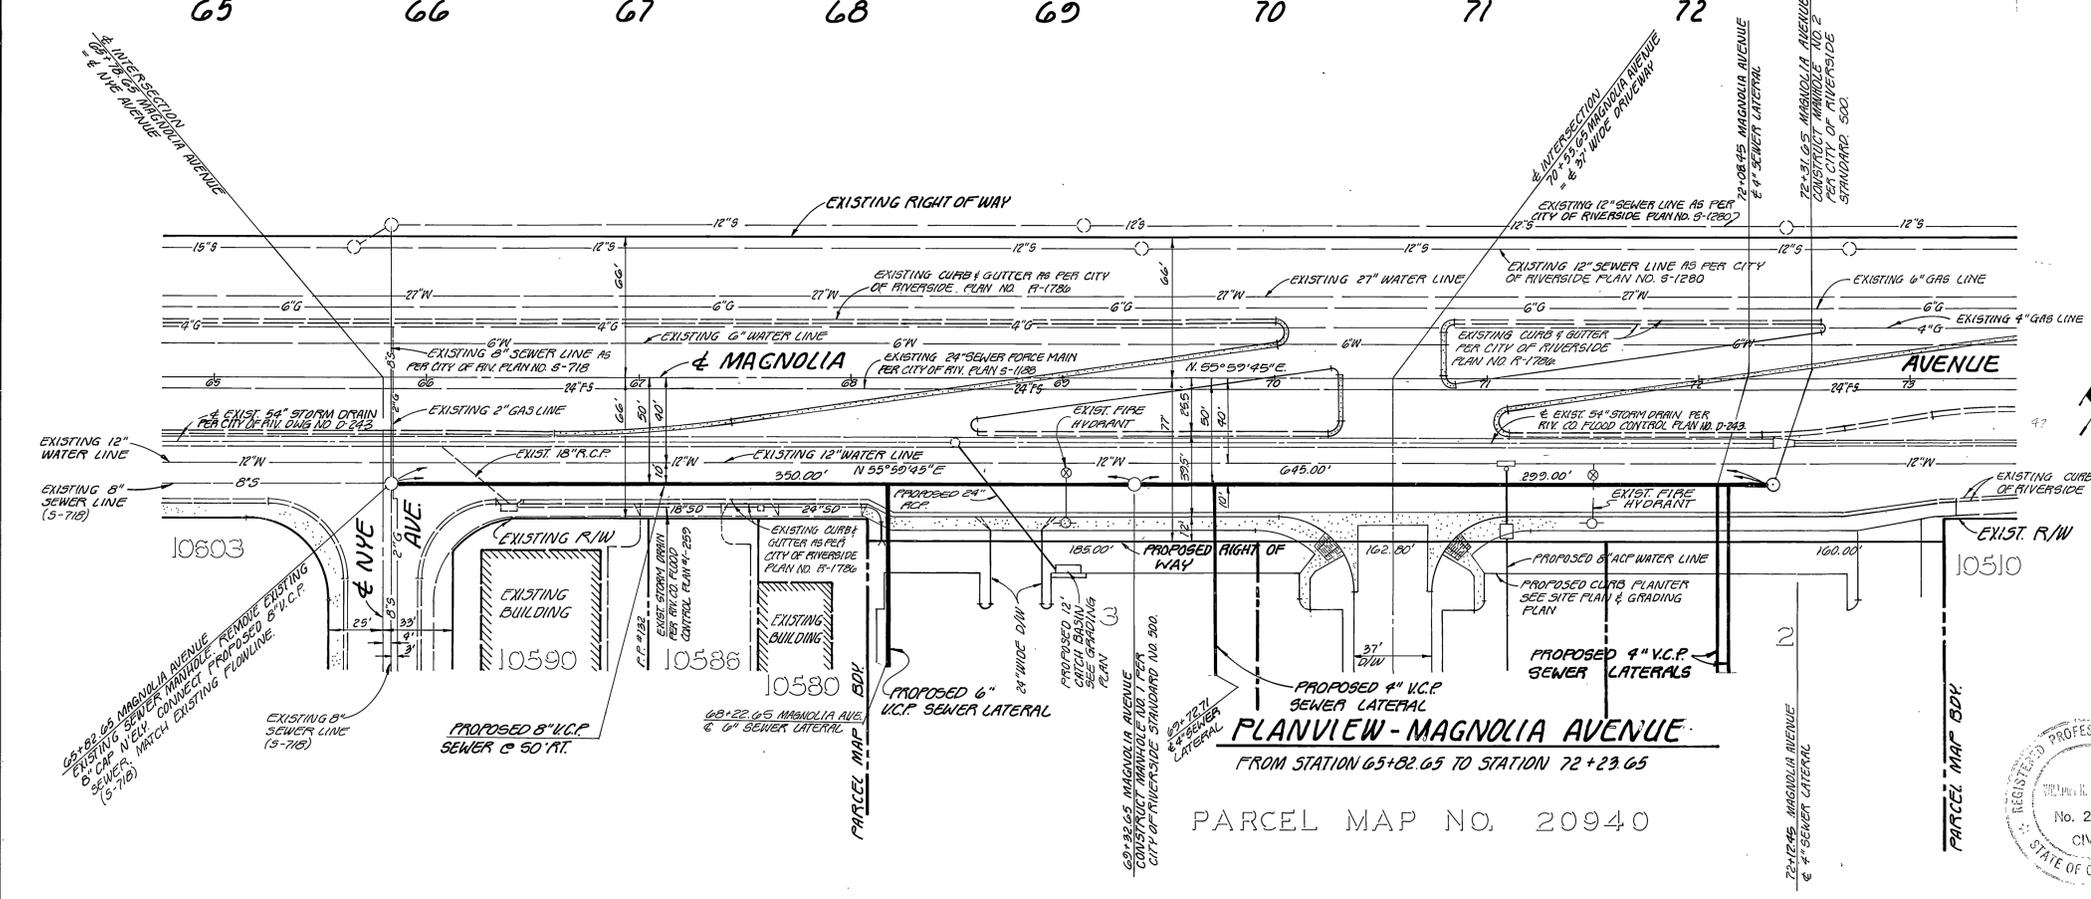

APPROVED BY 50. CAL. GAS CO. APPROVED BY	APPROVED FOR J.F. DAVIDSON ASSOCIATES William H. Hilling WILLIAM H. HILLING, REC 26008 DATE 10-24-85	J. F. DAVIDSON ASSOCIATES CIVIL ENGINEERS SURVEYORS PLANNERS 3426 TENTH STREET RIVERSIDE, CAL. 92504 11200 S. MT. VERNON AVE. COLTON, CAL.	CITY OF RIVERSIDE WATER SYSTEM DATE OCTOBER 1985	SCALE: HORIZ: 1" = 40' VERT: 1" = 4' DATE OCTOBER 1985	BENCH MARK: F.M. 14. PM. 1141 AND CITY ENGINEER TAG IN CENTER OF MOST N.W. CORN. RETURN OF COLLETT AVE AT 1024 ST. ELEV. 709.042	CITY OF RIVERSIDE, CALIFORNIA DEPARTMENT OF PUBLIC WORKS APPROVED BY PRINCIPAL ENGINEER PARK DEPARTMENT TRAFFIC DIVISION CHIEF P. W. ENGR.	SEWER PLAN AND PROFILE MAGNOLIA AVENUE PM 20940 FROM STA. 65+02.65 TO STA. 72+23.65 PARCEL MAP NO. 20940	PROJECT NO. S-1425 SHEET 1 OF 1 FILE NO. 5795 (M)
--	--	---	--	---	---	--	--	---