
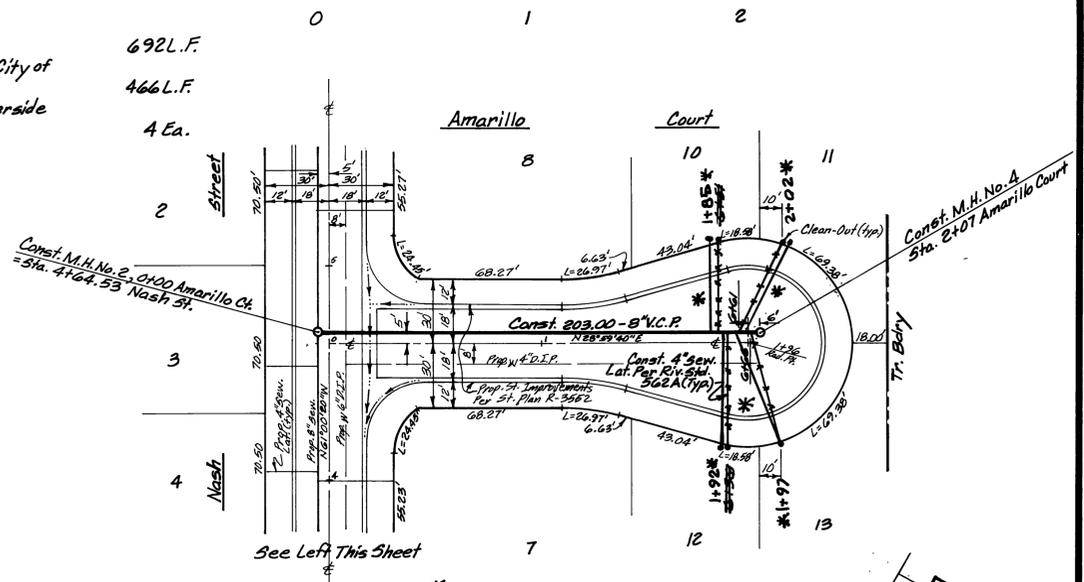


Profile Scale  
 Horiz.: 1" = 40'  
 Vert.: 1" = 4'

Estimate of Quantities  
 1. Construct 8" V.C.P. Sewer Main 692 L.F.  
 2. Construct 4" V.C.P. Sewer Lateral per City of Riverside Std. No. 562A 466 L.F.  
 3. Construct Sewer Manhole per City of Riverside Std. No. 500 4 Ea.

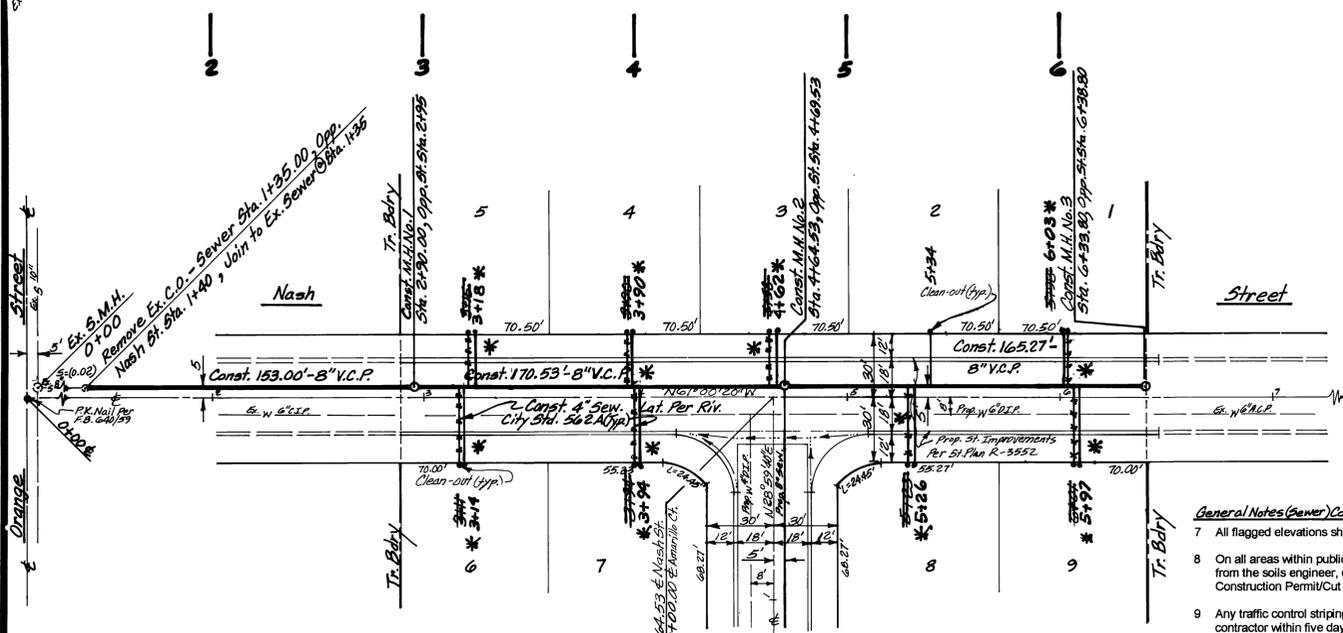

- General Notes (Sewer) Continued**
- All flagged elevations shall be staked in the field by the private engineer.
  - On all areas within public right of way where the fill is one (1) foot or greater, a letter will be required from the soils engineer, certifying the compaction of the fill below subgrade, prior to issuance of the Construction Permit/Cut Sheets.
  - Any traffic control striping obliterated and/or badly worn during construction shall be restored by the contractor within five days after notification from the City Inspectors.
  - The contractor shall call in a location request to Underground Service Alert (USA), Phone #1-800-227-2800, two working days before digging. No construction permit will be issued by the Public Works Department involving excavation for underground facilities unless the applicant has been provided an inquiry identification number by U.S.A.
  - Contractor is to verify existing sewer elevation prior to construction.
  - Location of laterals to be determined in the field at the direction of the owner. Avoid conflict with proposed and/or existing facilities.
  - No finished floor elevation shall be less than 6" above the upper manhole rim elevation of the sewer line segment being connected to, without having a proper backwater valve installed in the lateral.
  - A plug shall be installed and will remain in place where the new sewer connects with the existing sewer until the new sewer is accepted by the City.
  - The sewer contractor shall adjust manholes to final grade after paving is completed.
  - The contractor shall coordinate trenching for cable television with other trenching within the subdivision.

- GENERAL NOTES (SEWER)**
- No person shall perform any construction activity or install any objects within the public rights-of-way or easements of the City of Riverside without a valid Construction Permit or a Street Opening Permit or an Encroachment Permit issued by the City's Public Works Department.
  - It shall be the responsibility of the contractor to clear the right of way in accordance with the provisions of law as it affects each utility including irrigation lines and appurtenances and at no cost to the City.
  - Construction shall be in accordance with the City of Riverside Department of Public Works, Standard Drawings, its Supplemental Notes and the Standard Specifications for Public Works Construction, current edition.
  - The private engineer signing these plans is responsible for assuring the accuracy and acceptability of the work hereon. In the event of discrepancies arising during construction, the private engineer shall be responsible for determining an acceptable solution and revising the plans for approval by the City (This note required on all plans).
  - Quantities shown are for information only and the City of Riverside is not responsible for their accuracy.
  - The developer shall be responsible for preserving or re-establishing and referencing survey monuments destroyed, disturbed or buried as a result of construction shown hereon.

**Underground Service Alert**  
 Call: TOLL FREE  
**1-800-227-2800**  
 TWO WORKING DAYS BEFORE YOU DIG

Bench Mark: J7-F2  
 P.K. Nail in curb return at the S.W. Corner of Columbia Ave. and Orange St. Per City F.B. 717/48  
 E.I. 827.25



City of Riverside Business Tax Certificate # 75184 Exp. Date 4/12/00

City of Riverside Water System  
 Approved By: *[Signature]* Date: 12/3/99

LINVILLE CIVIL ENGINEERS  
 LAND SURVEYORS INC.  
 Cucamonga Business Park,  
 9587 Arrow Route Suite H  
 RANCHO CUCAMONGA, CA 91730  
 (909) 989-3922  
 File No. TR 01098-2

DESIGNED BY: K.N.L. DRAWN BY: G.A.C. CHECKED BY: J.C.P.

**CITY OF RIVERSIDE PUBLIC WORKS DEPARTMENT**

APPROVED BY	DATE	BY
PRINCIPAL ENGINEER	1/14/00	R. McSwain
PARK DEPARTMENT		
TRAFFIC DIVISION		
P.W. ENGINEER MANAGER	1/24/00	T.H.S.

DATE: 1-14-2000

\* AS-BUILT 5-19-03 LHM

Sewer Plan and Profile  
 Tract 29239  
 Nash St. & Amarillo Ct.

ACCOUNT NO. **5-1722**

SHEET 1 OF 1

HORIZ. SCALE: 1" = 40' VERT. SCALE: 1" = 4'

INDEXED 5-2-2000 LHM