


ALL UTILITY POLES, LINES, METERS ETC. TO BE REMOVED OR RELOCATED BY UTILITY COMPANIES PRIOR TO CONSTRUCTION.
 ALL TREES TO BE REMOVED BY CITY PRIOR TO CONSTRUCTION.
 PAVEMENT REPLACEMENT BY CITY.

SCALES: HORIZONTAL 1" = 50'
 VERTICAL 1" = 5'

FB 576-69
 593-29

B.M. 756.98 S & L IN SW CURB RET GARFIELD & SHERMAN

PROFILE	STARTED	BY	DATE
NOTE BOOK	PLOTTED		
NO.	ALIGNMENT CHECKED		
	INT. OF WAY CHECKED		
	STRUCTURE NOTATIONS CHECKED		

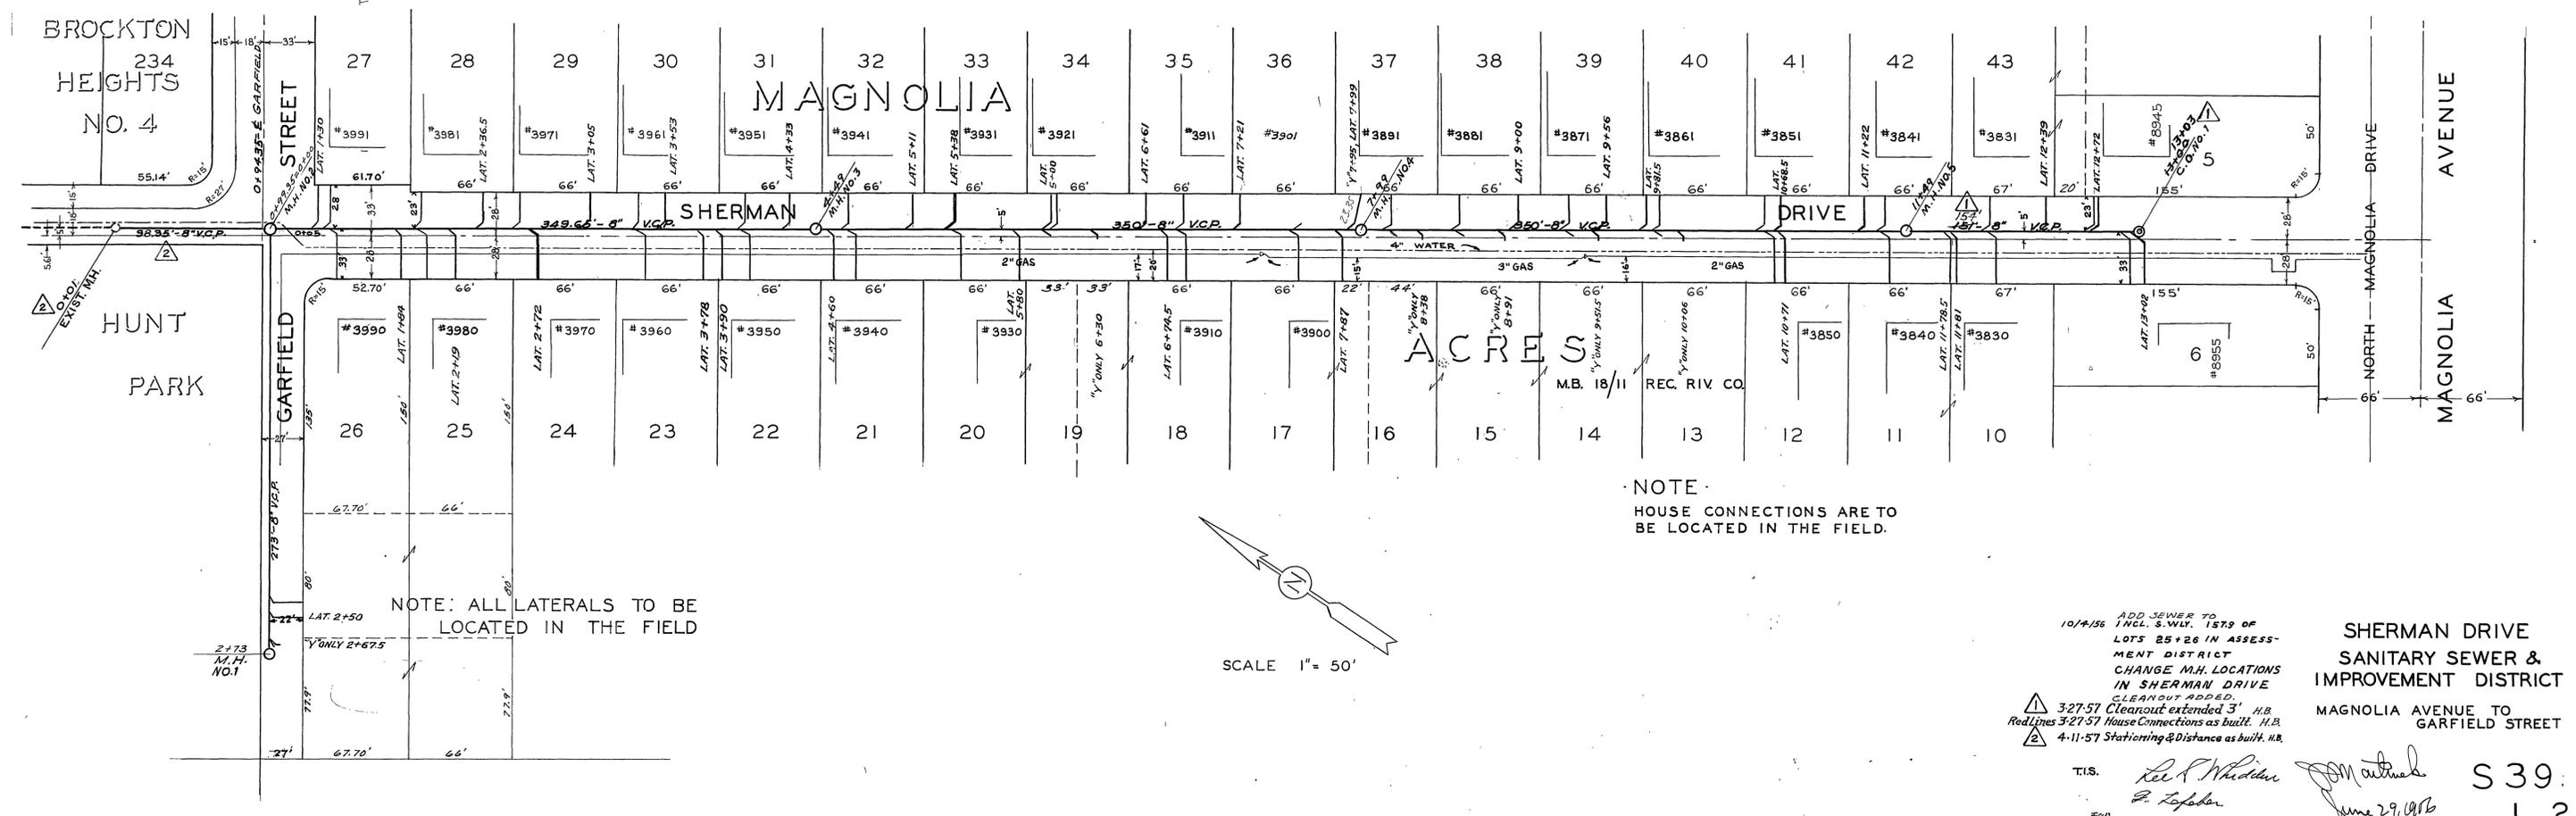

NOTE: HOUSE CONNECTIONS ARE TO BE LOCATED IN THE FIELD.

SCALE 1" = 50'

ADD SEWER TO INCL. S.W.VLY. 157.9 OF LOTS 25+26 IN ASSESSMENT DISTRICT CHANGE M.H. LOCATIONS IN SHERMAN DRIVE CLEANOUT ADDED.
 3-27-57 Cleanout extended 3' H.B. Redlines 3-27-57 House Connections as built. H.B.
 4-11-57 Stationing & Distance as built. H.B.

SHERMAN DRIVE
 SANITARY SEWER & IMPROVEMENT DISTRICT
 MAGNOLIA AVENUE TO GARFIELD STREET

T.S. Lee L. Whidden
 R. Lopez
 June 29, 1956
 S 39
 1 2

PLAN	STARTED	BY	DATE
NOTE BOOK	PLOTTED		
NO.	ALIGNMENT CHECKED		
	INT. OF WAY CHECKED		

DIAGRAM

EXHIBITING

IN THE CITY OF RIVERSIDE ON WHICH WORK HAS BEEN DONE UNDER THE OFFICIAL CONTRACT OF THE SUPERINTENDENT OF STREETS OF SAID CITY WITH DATED

FOR THE CONSTRUCTION OF

AS IS MORE PARTICULARLY DESCRIBED IN SAID CONTRACT TO WHICH REFERENCE IS HEREBY MADE FOR FURTHER PARTICULARS; SAID DIAGRAM ALSO SHOWS THE RELATIVE LOCATION OF EACH LOT PORTION OF LOT PIECE OR PARCEL OF LAND ASSESSED FOR THE WORK DONE NUMBERED IN TO CORRESPOND TO THE RED INK NUMBERS IN THE ASSESSMENT

HEREIN FIGURES NEXT TO PROPERTY LINES SHOW LENGTH OF SAID LINES IN FEET. THE MARK (') MEANS FEET. PROPERTY LINES THAT DIFFER FROM THE RECORDED SUBDIVISIONS ARE SHOWN BY BROKEN LINES THE DISTRICT BENEFITED IS BOUNDED BY A HEAVY DASHED LINE

PROPERTY COVERED BY THIS ASSESSMENT IS SHOWN ON THE FOLLOWING RECORDED MAPS:

HEREIN THE LEGEND OF THE DIFFERENT KINDS OF WORK PERFORMED IS SHOWN AS FOLLOWS:

CITY ENGINEER OF THE CITY OF RIVERSIDE
THE FOLLOWING IS A STATEMENT OF AMOUNTS OF DIFFERENT KINDS OF WORK DONE BY
UNDER
CONTRACT DATED 19 PURSUANT TO
RESOLUTION OF INTENTION NO. ADOPTED BY THE
CITY COUNCIL OF THE CITY OF RIVERSIDE ON THE
DAY OF 19

AT SAID CITY OF RIVERSIDE THIS DAY OF

STREET SUPERINTENDENT
OF THE CITY OF RIVERSIDE

I HEREBY CERTIFY THAT THE ABOVE WORK WAS DONE IN ACCORDANCE WITH LINES AND GRADES FURNISHED BY ME AND THAT THE DIAGRAM OF THE ASSESSMENT DISTRICT FOR THE SAME IS CORRECT



CITY ENGINEER
OF THE CITY OF RIVERSIDE

RECORDED AT O'CLOCK M
THIS DAY OF 19

SUPERINTENDENT OF STREETS
OF THE CITY OF RIVERSIDE

ASSESSMENT NO. 437

SHERMAN DRIVE SANITARY SEWER AND IMPROVEMENT DISTRICT

C. O. BRAND FEBRUARY 5, 1957
A SANITARY SEWER, CURB AND GUTTER AND APPURTENANT WORK IN SHERMAN DRIVE AND GARFIELD STREET BET. GARFIELD AND MAGNOLIA

CIRCLES

MAGNOLIA ACRES M.B. 18/II REC. RIV. CO.

- _____ SEWER MAIN
- _____ & WYE BRANCHES
- _____ & HO. CONN. LATERALS
- _____ O _____ & MANHOLES
- _____ @ _____ & CLEANOUT
- ===== COMB. CURB & GUTTER

C. O. BRAND FEBRUARY 5, 57
7376
14 TH AUGUST 56
AND MODIFIED BY RESOLUTION OF INTENTION NO. 7525
ADOPTED BY THE CITY COUNCIL OF THE CITY OF
RIVERSIDE ON THE 4TH DAY OF DECEMBER 1956


1,576.00	LIN. FT. 8" V.C.P. SEWER
870.35	LIN. FT. 4" V.C.P. HO. CONN.
38	EA. 8"X4" WYE BRANCHES
5	EA. STD. MANHOLES 141-D
1	EA. STD. CLEANOUT 141-B
2,624.16	LIN. FT. COMB. CURB & GUTTER

2nd May 1957
Orval Addington

J. M. Antineb
J. M. Antineb

24TH 9:15 A
JULY 57

Scale ~ 1" = 100'

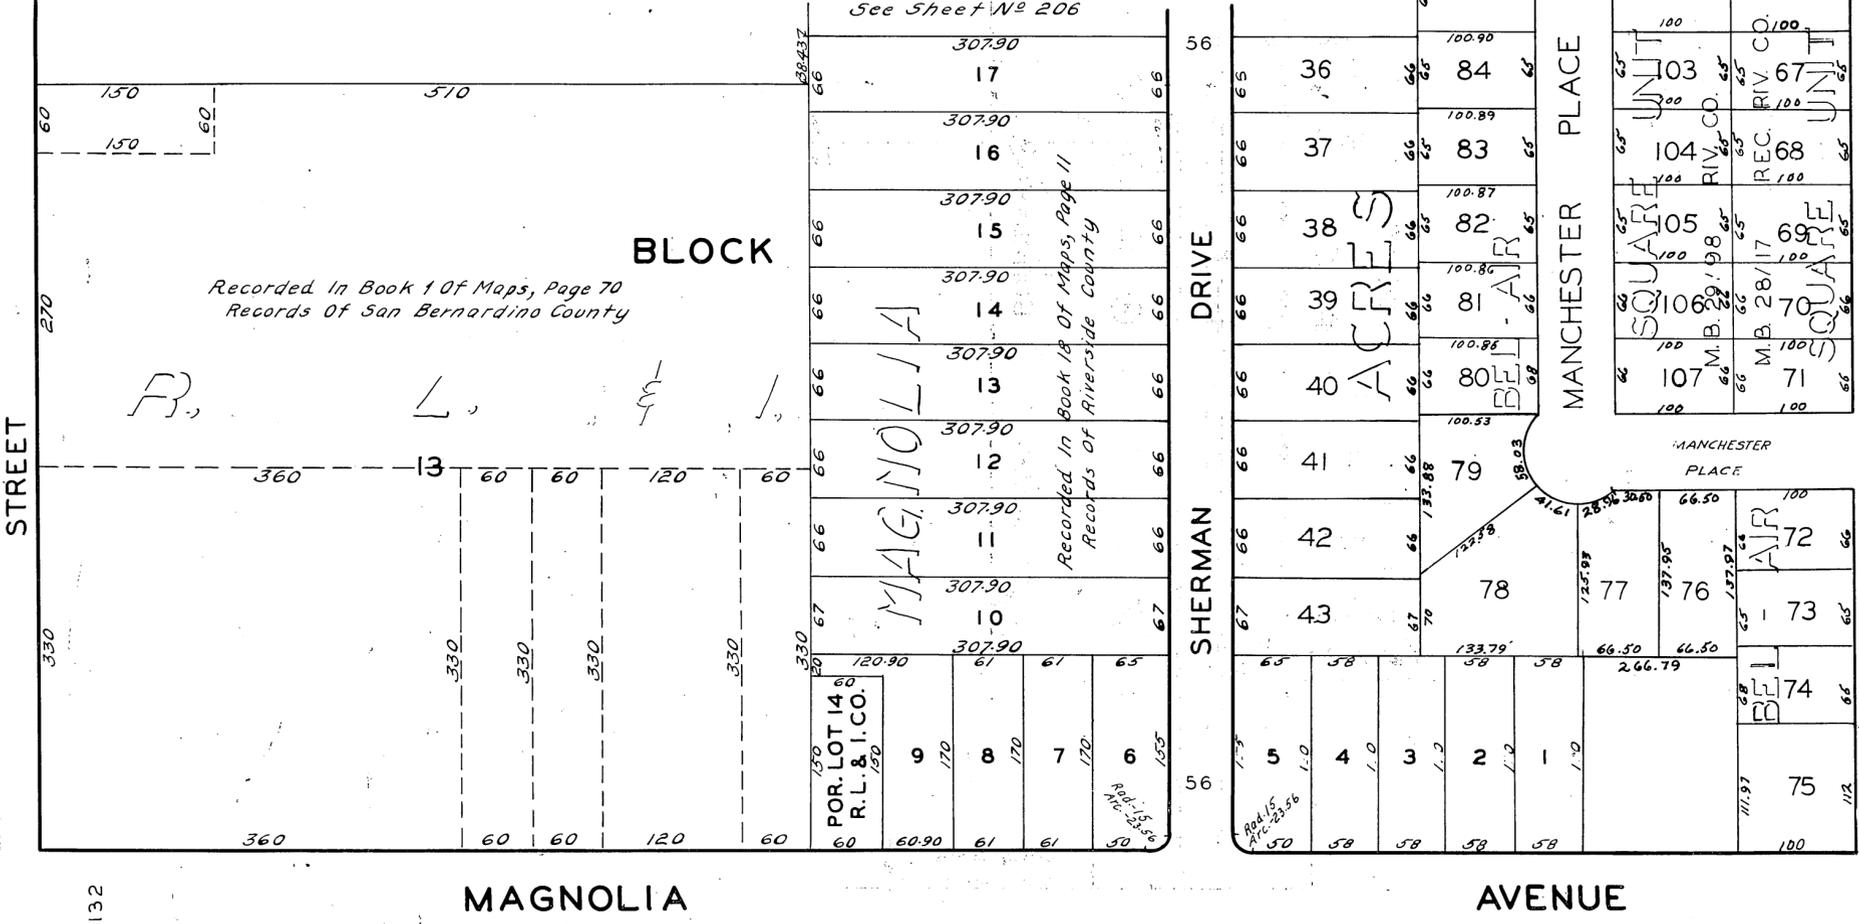


Recorded In Book 1 Of Maps, Page 70
Records Of San Bernardino County

Recorded In Book 19 Of Maps, Page 11
Records Of Riverside County

MANCHESTER PLACE

PACIFIC ELECTRIC R.R.

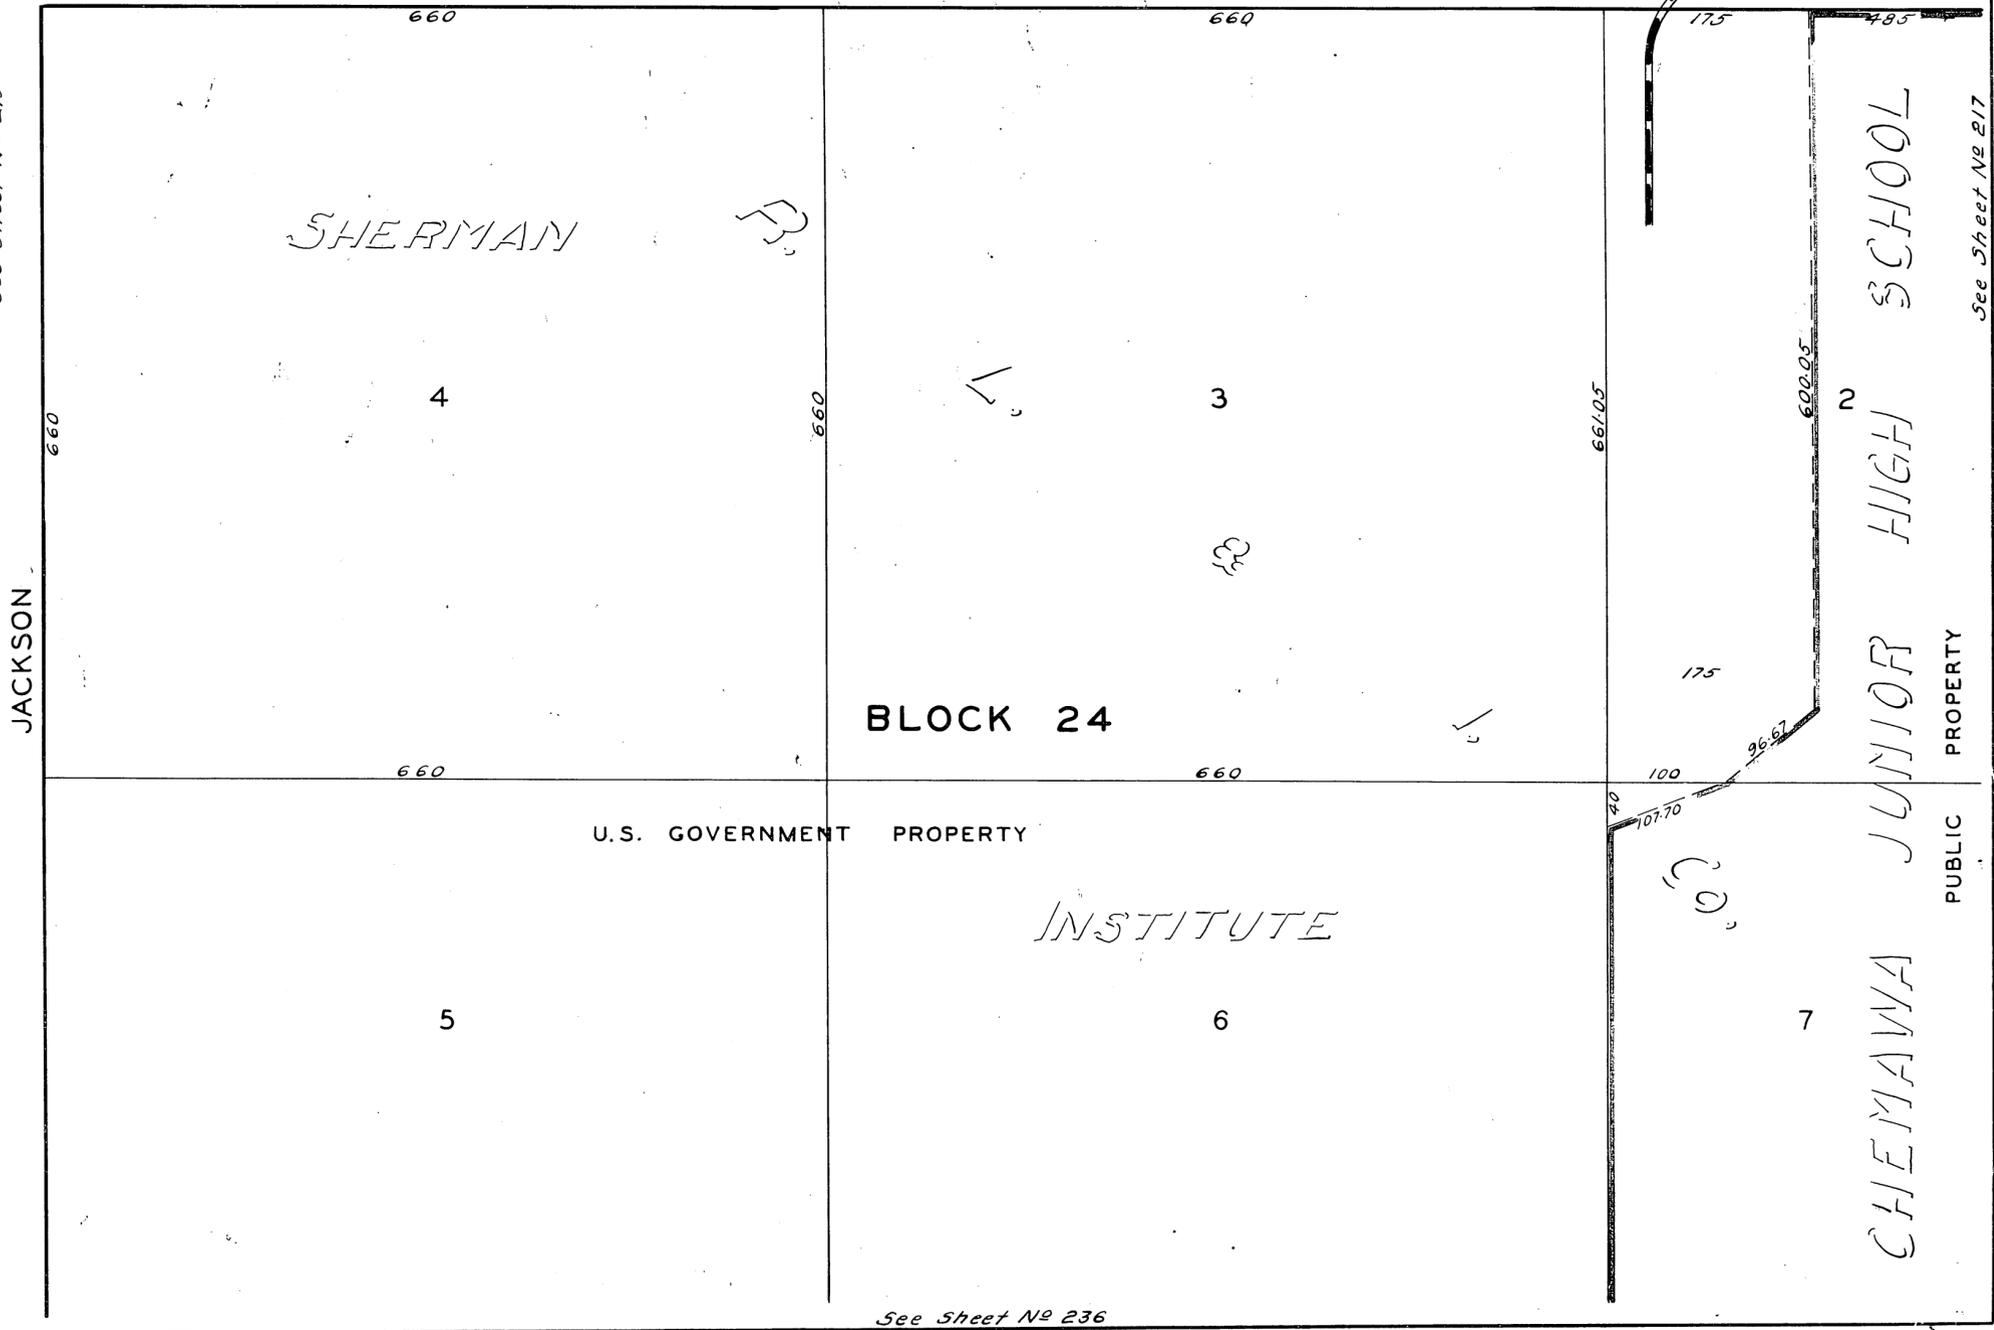

See Sheet No 219

See Sheet No 217

See Sheet No 236

