

BENCH MARK F.A. 499.9  
 SPIKE AND LEAD IN CURB RETURN AT  
 NORTHWEST CORNER OF INTERSECTION OF LINCOLN  
 AND MAUDE ELEV. 932.49

**GENERAL NOTES**

- 1 CONSTRUCTION SHALL BE IN ACCORDANCE WITH THE CITY OF RIVERSIDE DEPARTMENT OF PUBLIC WORKS STANDARD SPECIFICATIONS NO. 461 AND STANDARD DRAWINGS.
- 2 LOCATION OF WYES AND LATERALS TO BE DETERMINED IN THE FIELD.
- 3 ALL STUBS AND LATERALS TO BE CONSTRUCTED IN ACCORDANCE WITH STANDARD DRAWING NO. 562. STUBS SHALL BE PLUGGED AND CAPPED.
- 4 MANHOLE FRAMES AND COVERS TO BE SET TO EXISTING PAVEMENT GRADES.
- 5 PIPE SHALL BE BEDDED CASE II STD DWG NO. 452.
- 6 IRRIGATION LINES SHOWN CROSSING GERTRUDE ST AND KATHLEEN ST TO BE BROKEN & PLUGGED AT WLY TRACT B'DY AND REMOVED THRU TRACT.
- 7 FOG SEAL CENTER 24 OF EXISTING STREETS AFTER SEWER IS COMPLETED.

**NOTICE TO CONTRACTOR**

The existence and location of any underground utility pipes or structures shown on these plans are obtained by a search of available records to the best of our knowledge there are no existing utilities except as shown on these plans. The contractor is required to take due precautionary measures to protect the utility lines shown & any other lines not of record or not shown on these plans.

**QUANTITY ESTIMATE**

8 VITRIFIED CLAY PIPE	2118 LF
4 VITRIFIED CLAY PIPE	1459 LF
8x4 WYES	40 EA
MANHOLES, STD DWG 500	6 EA
PAVEMENT REPLACEMENT	2560 SF

REVISION	
MARK	DESCRIPTION
★	3/22/62 "As built" RK

ALBERT A. WEBB ASSOCIATES  
 CIVIL ENGINEERS - RIVERSIDE, CALIFORNIA  
 APPROVED *Albert A. Webb* DATE 12/10/62  
 CITY OF RIVERSIDE, CALIFORNIA  
 DEPARTMENT OF PUBLIC WORKS  
**SEWER PLAN & PROFILE  
 OF  
 MAUDE STREET  
 TRACT IN NO. 2564**


APPROVED BY *W. M. ...*  
 DATE 12/21/62  
 SHEET 1 OF 3

**PROFILE**

DATE	BY	DATE


**PLAN**

DATE	BY	DATE

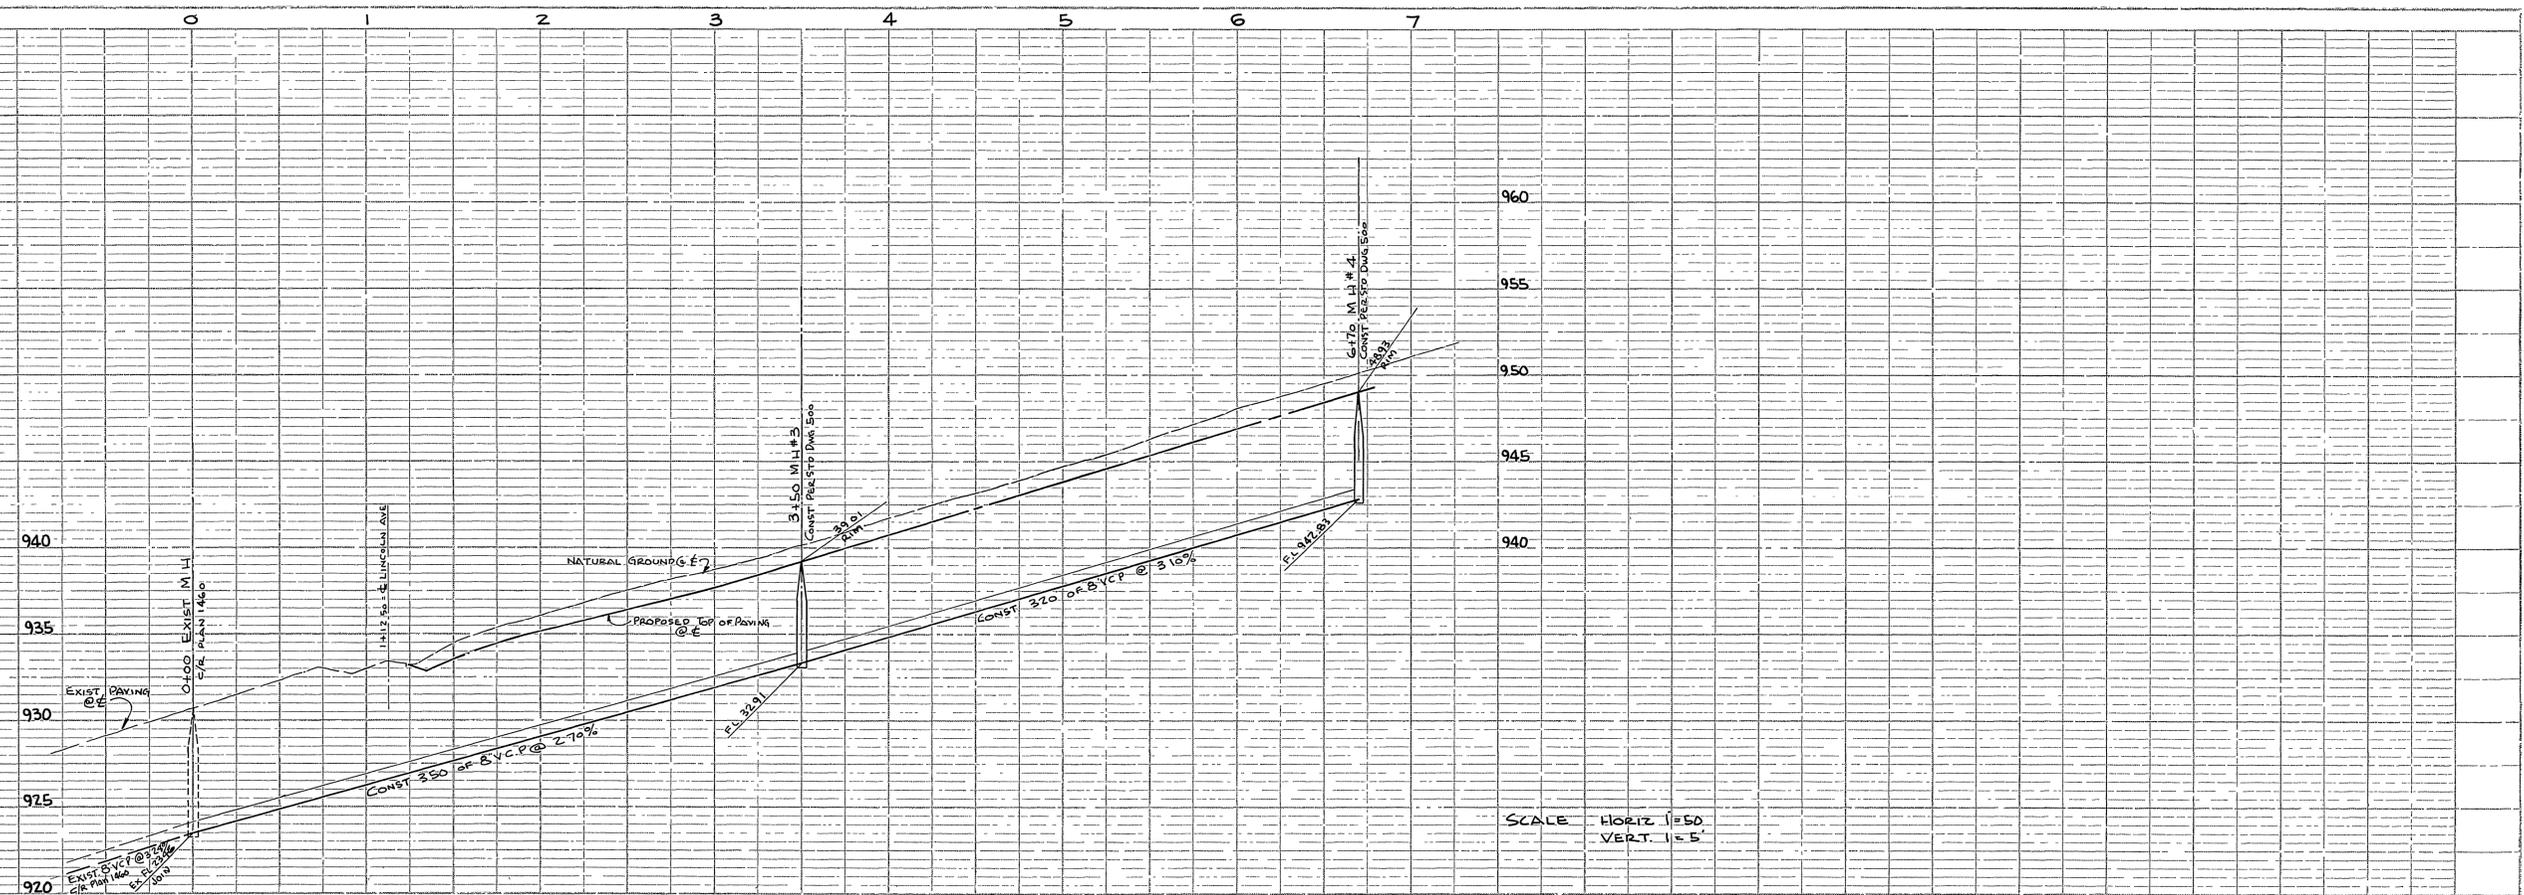

SCALE HORIZ 1"=50'  
 VERT. 1"=5'

BENCH MARK: F.R. 499/3  
 SPIKE & LEAD IN NORTHWEST CORNER RETURN AT  
 INTERSECTION OF LINCOLN AVE & MADISON ST  
 ELEV 932.49

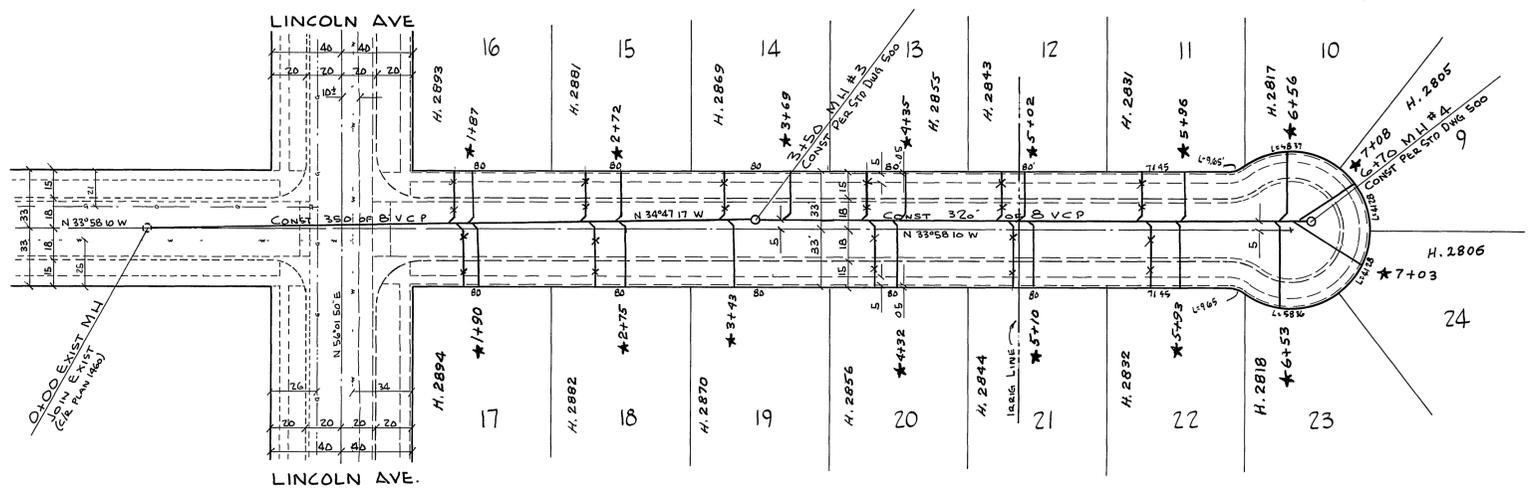

GERTRUDE STREET

PROFILE

NO. 62-287B	DATE
PROJECT	DATE
DESIGNED BY	DATE
CHECKED BY	DATE
APPROVED BY	DATE

PLAN

NO. 62-287B	DATE
PROJECT	DATE
DESIGNED BY	DATE
CHECKED BY	DATE
APPROVED BY	DATE



ALBERT A. WEBB ASSOCIATES  
 CIVIL ENGINEERS - RIVERSIDE, CALIFORNIA  
 APPROVED *Albert A. Webb* DATE 12/10/62  
 R.E. 9816

CITY OF RIVERSIDE, CALIFORNIA  
 DEPARTMENT OF PUBLIC WORKS  
 SEWER PLAN & PROFILE  
 OF  
**GERTRUDE STREET**  
 IN  
 TRACT NO 2564

REVISION		
MARK	DATE	DESCRIPTION
★	3/22/63	"As built" RK

DATE	DECEMBER 1962	SCALE	1"=50'
DRAWN	dw	W.G.	62-287
CHECKED	RON G.R.J.	F.B.	499

APPROVED BY	<i>W.G.</i>	NO.	S-395
DIRECTOR OF PUBLIC WORKS		SHEET	2 OF 3
DATE	12/21/62		

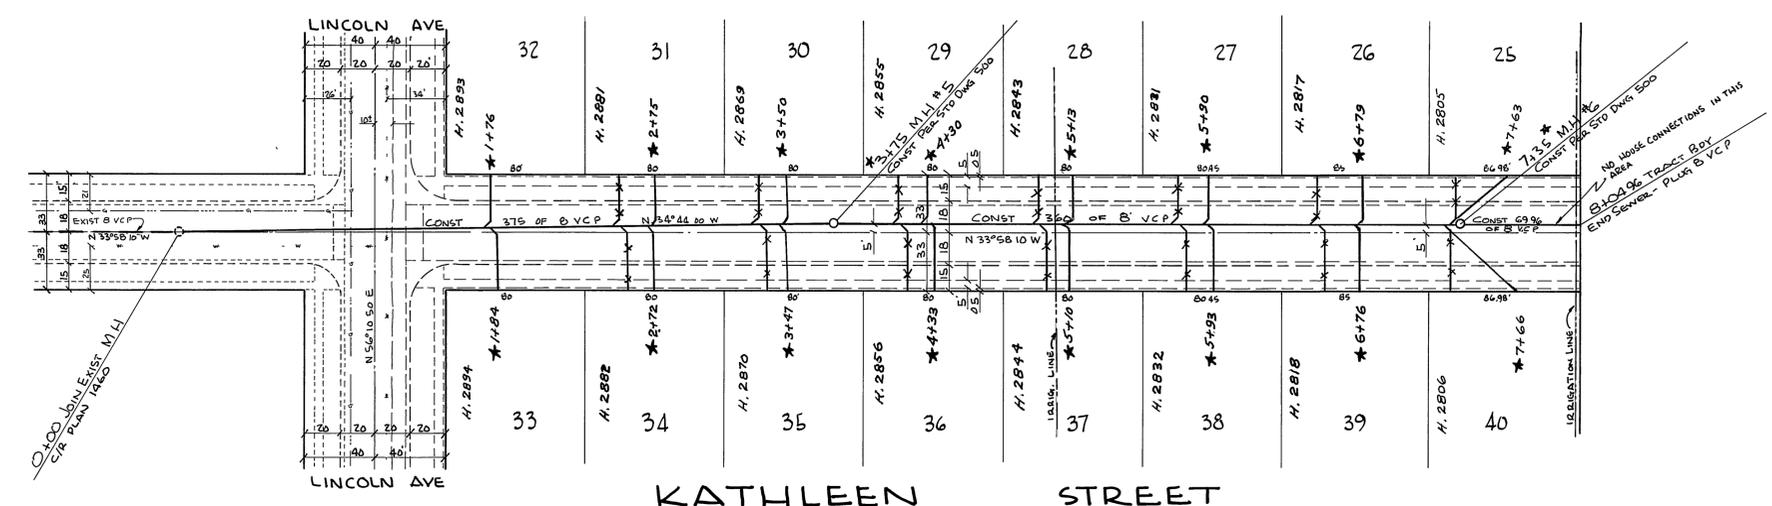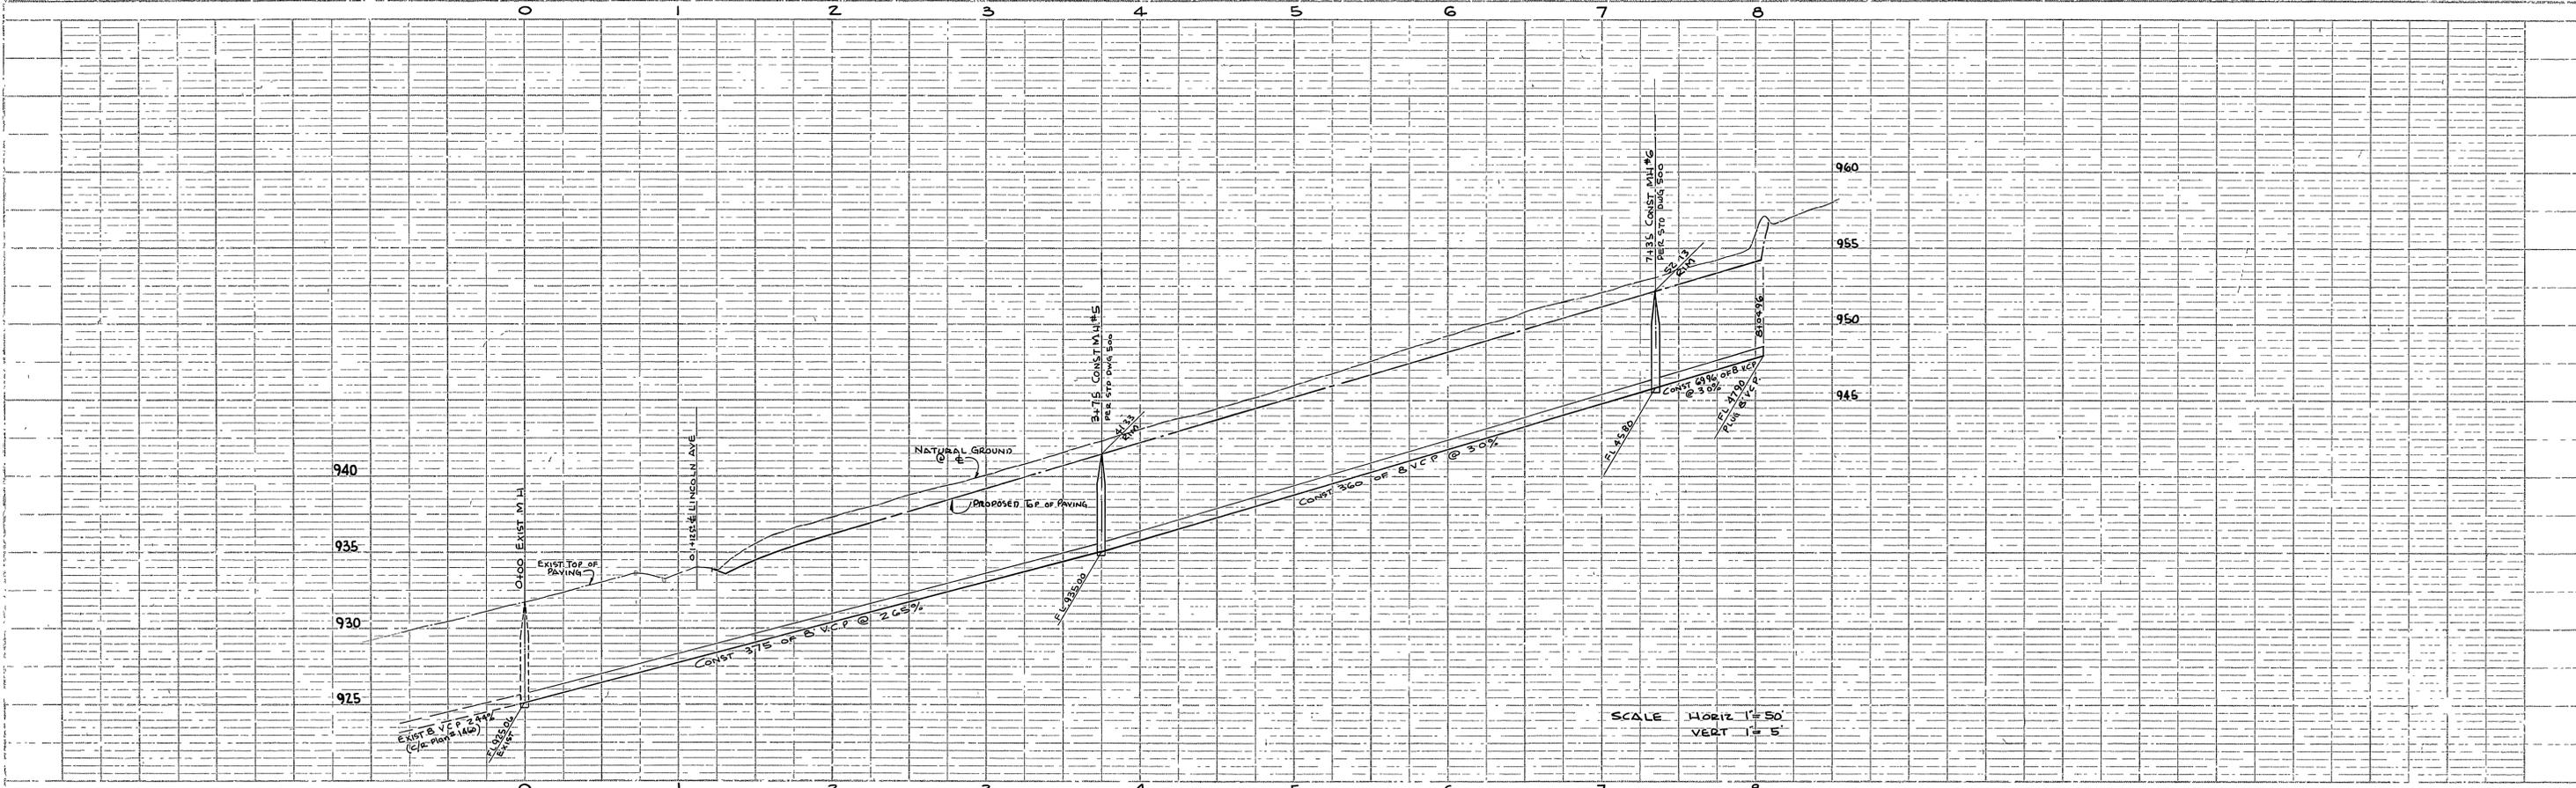

BENCH MARK FB 49519  
 SPIKE & LEAD IN NORTH WEST CURB RETURN  
 AT INTERSECTION OF LINCOLN & MAUDE  
 ELEV 932.49

POSTED ON MAP

ALBERT A. WEBB ASSOCIATES CIVIL ENGINEERS - RIVERSIDE, CALIFORNIA APPROVED: <i>Albert A. Webb</i> DATE 12/19/62 R.F. 9816		CITY OF RIVERSIDE, CALIFORNIA DEPARTMENT OF PUBLIC WORKS	
REVISION MARK DATE DESCRIPTION * 3/22/63 "As built" RK		SEWER PLAN & PROFILE OF KATHLEEN STREET TRACT IN NO. 2564	
DATE DECEMBER 1962 DRAWN du CHECKED Ron v. j.	SCALE 1" = 50' W.O. 62-287 F.B. 499	APPROVED BY <i>W. O. ...</i> DIRECTOR OF PUBLIC WORKS	NO. S-395 DATE 12/2/62 SHEET 3 OF 3

PROFILE

NO.	DATE	BY

PLAN

NO.	DATE	BY