


ASSESSMENT NO. 439

RUMSEY DRIVE AND CARMEL WAY
SANITARY SEWER DISTRICT

ELMER FUNKHOUSER MARCH 26, 1957
SANITARY SEWERS AND APPURTENANCES IN
RUMSEY DRIVE, CARMEL WAY, AND CENTRAL AVENUE.

CIRCLES

RUMSEY ESTATES M.B. 26/25 REC. RIV. CO.
VICTORIA HEIGHTS M.B. 4/92 REC. RIV. CO.

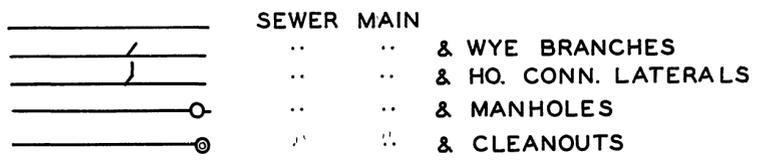

ELMER FUNKHOUSER			
	MARCH 26,	7604	57
22ND	JANUARY		57
1,146.00	LIN. FT. 8" V.C.P. SEWER		
9	8" X 4" WYE BRANCHES		
178.50	4" V.C.P. HO. CONN.		
1	SPECIAL MANHOLE		
5	STD. MANHOLES 141-D		
2	STD. CLEANOUTS 141-B		

2nd May 1957
Oswal Adlampton

J.M. Martine
J.M. Martine

24TH 9:05 A
JULY 57

DIAGRAM

EXHIBITING

IN THE CITY OF RIVERSIDE ON WHICH WORK HAS BEEN DONE UNDER THE OFFICIAL CONTRACT OF THE SUPERINTENDENT OF STREETS OF SAID CITY WITH DATED

FOR THE CONSTRUCTION OF

AS IS MORE PARTICULARLY DESCRIBED IN SAID CONTRACT TO WHICH REFERENCE IS HEREBY MADE FOR FURTHER PARTICULARS; SAID DIAGRAM ALSO SHOWS THE RELATIVE LOCATION OF EACH LOT PORTION OF LOT PIECE OR PARCEL OF LAND ASSESSED FOR THE WORK DONE NUMBERED IN TO CORRESPOND TO THE RED INK NUMBERS IN THE ASSESSMENT

HEREIN FIGURES NEXT TO PROPERTY LINES SHOW LENGTH OF SAID LINES IN FEET. THE MARK (') MEANS FEET. PROPERTY LINES THAT DIFFER FROM THE RECORDED SUBDIVISIONS ARE SHOWN BY BROKEN LINES. THE DISTRICT BENEFITED IS BOUNDED BY A HEAVY DASHED LINE

PROPERTY COVERED BY THIS ASSESSMENT IS SHOWN ON THE FOLLOWING RECORDED MAPS:

HEREIN THE LEGEND OF THE DIFFERENT KINDS OF WORK PERFORMED IS SHOWN AS FOLLOWS:

CITY ENGINEER OF THE CITY OF RIVERSIDE
THE FOLLOWING IS A STATEMENT OF AMOUNTS OF DIFFERENT KINDS OF WORK DONE BY
UNDER
CONTRACT DATED 19 PURSUANT TO
RESOLUTION OF INTENTION NO. ADOPTED BY THE
CITY COUNCIL OF THE CITY OF RIVERSIDE ON THE
DAY OF 19

AT SAID CITY OF RIVERSIDE THIS DAY OF

STREET SUPERINTENDENT
OF THE CITY OF RIVERSIDE

I HEREBY CERTIFY THAT THE ABOVE WORK WAS DONE IN ACCORDANCE WITH LINES AND GRADES FURNISHED BY ME AND THAT THE DIAGRAM OF THE ASSESSMENT DISTRICT FOR THE SAME IS CORRECT.

CITY ENGINEER
OF THE CITY OF RIVERSIDE

RECORDED AT O'CLOCK M
THIS DAY OF 19

SUPERINTENDENT OF STREETS
OF THE CITY OF RIVERSIDE