


760

760

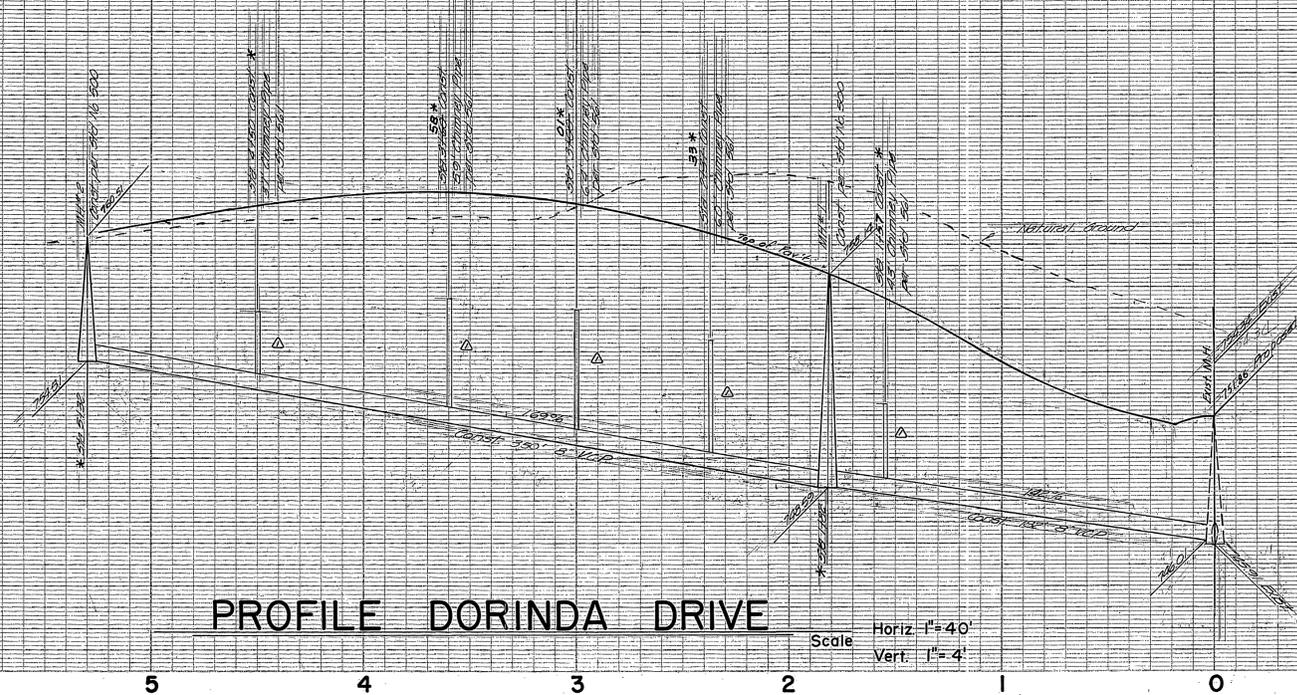

PROFILE DORINDA DRIVE

Scale Horiz. 1" = 40'  
Vert. 1" = 4'

6 5 4 3 2 1 0

BENCH MARK: Nail & Flash, C Jo Jo Way and Crest Ave., Elev. = 757.35' per M & K F. B. 151, Page 5.




Scale 1" = 40'

GENERAL NOTES

1. Construction shall be in accordance with the City of Riverside, Dept. of Public Works, Standard Specifications No. 361 and Standard Drawings.
2. It shall be the responsibility of the contractor to clear the right of way in accordance with the provisions of the BW as it affects each utility, including irrigation lines and appurtenances, and at no cost to the City.
3. Joints shall be in accordance to ASTM Specification 7-425-64, Type I or III, or to ASTM Specification 7-594-66, (Gen'l. Spec.), with certain exceptions or modifications on file with the City Engineer.
4. Location of tees and laterals to be determined by owner.
5. All stubs and laterals to be constructed in accordance with Standard Drawing No. 562. Stubs shall be plugged and capped and shall be 2' long.
6. Manhole frames and covers to be set to finished street grade.
7. Laterals are to be 1" and extended to property line.
8. Prior to construction of sewer, Contractor is to expose existing sewer and contact the Engineer for verification of existing elevations.
9. Pipe shall be bedded per Class I, Standard Drawing No. 452, unless otherwise specified on plan.

NOTICE TO CONTRACTOR


The existence and location of any underground utility pipes or structures shown on these plans are obtained by a search of the available records to the best of our knowledge. There are no existing utilities except as shown on the plans. The contractor is required to take due precautionary measures to protect the utility lines shown and any other lines not of record or not shown on these plans.

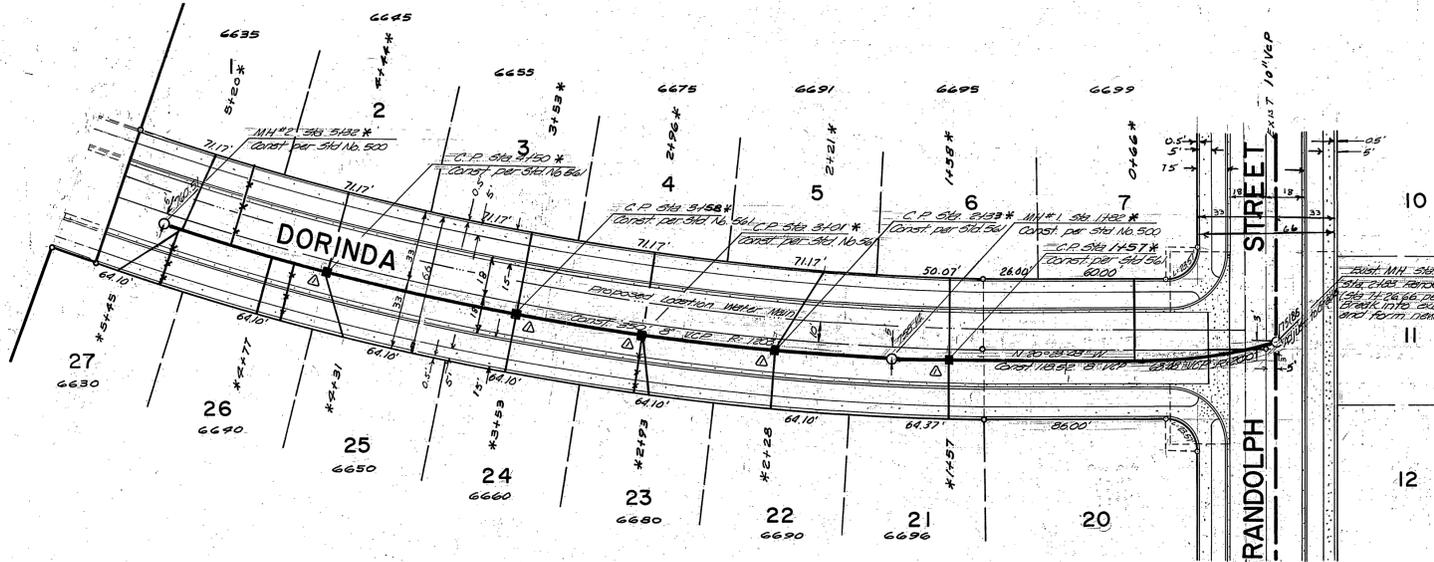


See Sheet 2

\*AS BUILT 11-13-68 E.S.

APPROVED BY <i>Howard Cress</i> CHIEF UTILITIES ENGINEER - WATER		DATE 8/15/68	<b>MAXWELL &amp; KING</b> ENGINEERS SURVEYORS PO BOX 1421 SAN BERNARDINO, CALIFORNIA APPROVED <i>Claude E. King</i> DATE <i>8/15/68</i> RE 13386					
REVISIONS <table border="1"> <thead> <tr> <th>MARK</th> <th>DATE</th> <th>DESCRIPTION</th> </tr> </thead> <tbody> <tr> <td>1</td> <td>8/15/68</td> <td>Added chimney pipes due to rock in trench. See notes on page 1.</td> </tr> </tbody> </table>				MARK	DATE	DESCRIPTION	1	8/15/68
MARK	DATE	DESCRIPTION						
1	8/15/68	Added chimney pipes due to rock in trench. See notes on page 1.						
CITY OF RIVERSIDE, CALIFORNIA DEPARTMENT OF PUBLIC WORKS JO NO. _____ FILE NO. _____ <b>SEWER PLAN &amp; PROFILE</b> <b>DORINDA DRIVE</b> <b>TRACT NO. 3780</b>			DESIGNED BY DRAWN BY CHECKED BY DATE 8-15-68					
S-726 1 2			E-672					

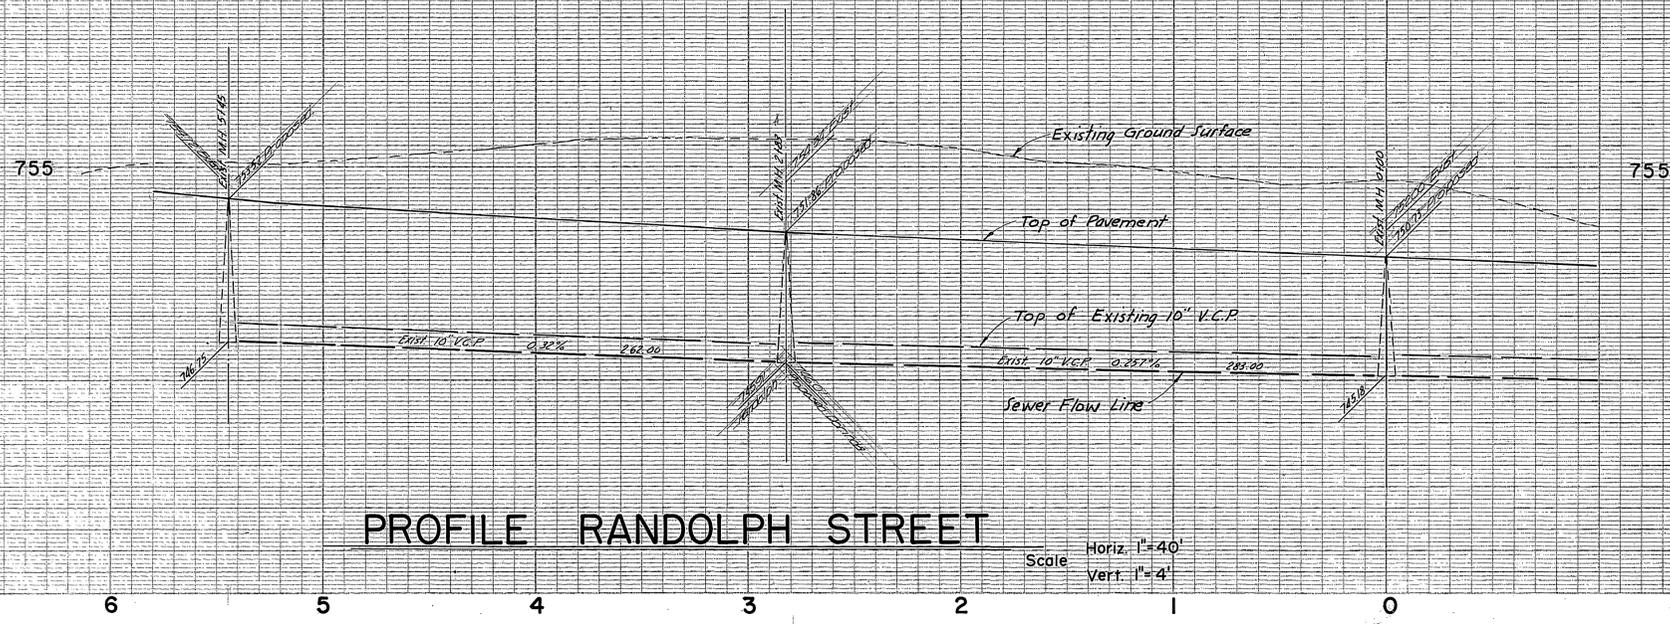

BENCH MARK: Nail & Flash,  $\zeta$  Jo Jo Way and Crest Ave.; Elev. = 757.35 per M & K F.B. 151, Page 5.

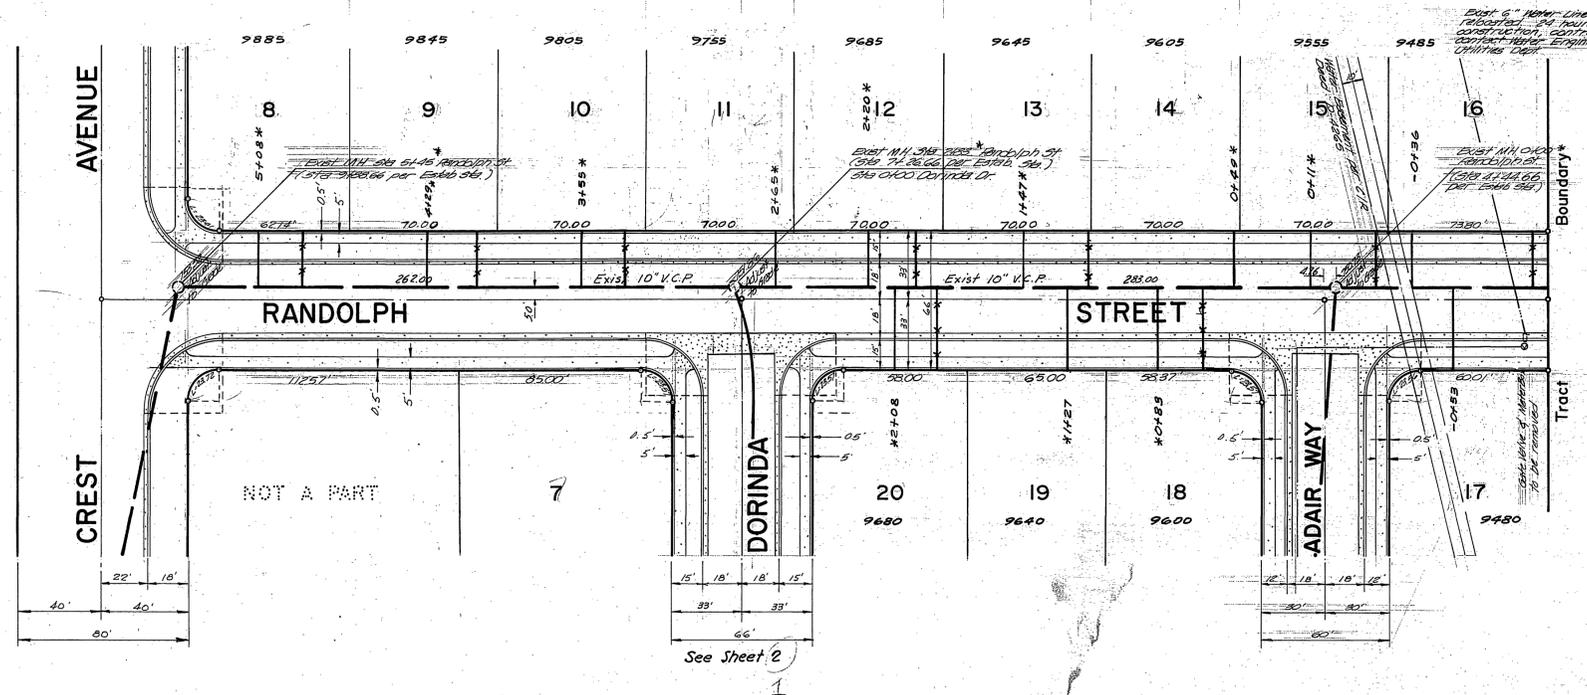

**MAXWELL & KING**  
 ENGINEERS — SURVEYORS  
 PO BOX 1421 SAN BERNARDINO, CALIFORNIA  
 APPROVED *Claude S. King* DATE *Aug 19, 1968*  
 R.E. 13386

RE	
MARK	DATE

JOB NO. | FILE NO.  
 SEWER PLAN & PROFILE  
**RANDOLPH STREET**  
 TRACT NO. 3780

*Paul A. Christensen* *James L. King* S-726  
 8-15-68 2 2

\*AS BUILT 11-12-68 E.S.