


**NOTICE TO CONTRACTOR**

The existence and location of underground utility pipes or structures shown on these plans are obtained by a search of the available records to the best of our knowledge, there are no existing utilities except those shown on the plans.  
 The Contractor is required to take due precautionary measures to protect the utility lines shown, and any other lines not of record or not shown on these plans.

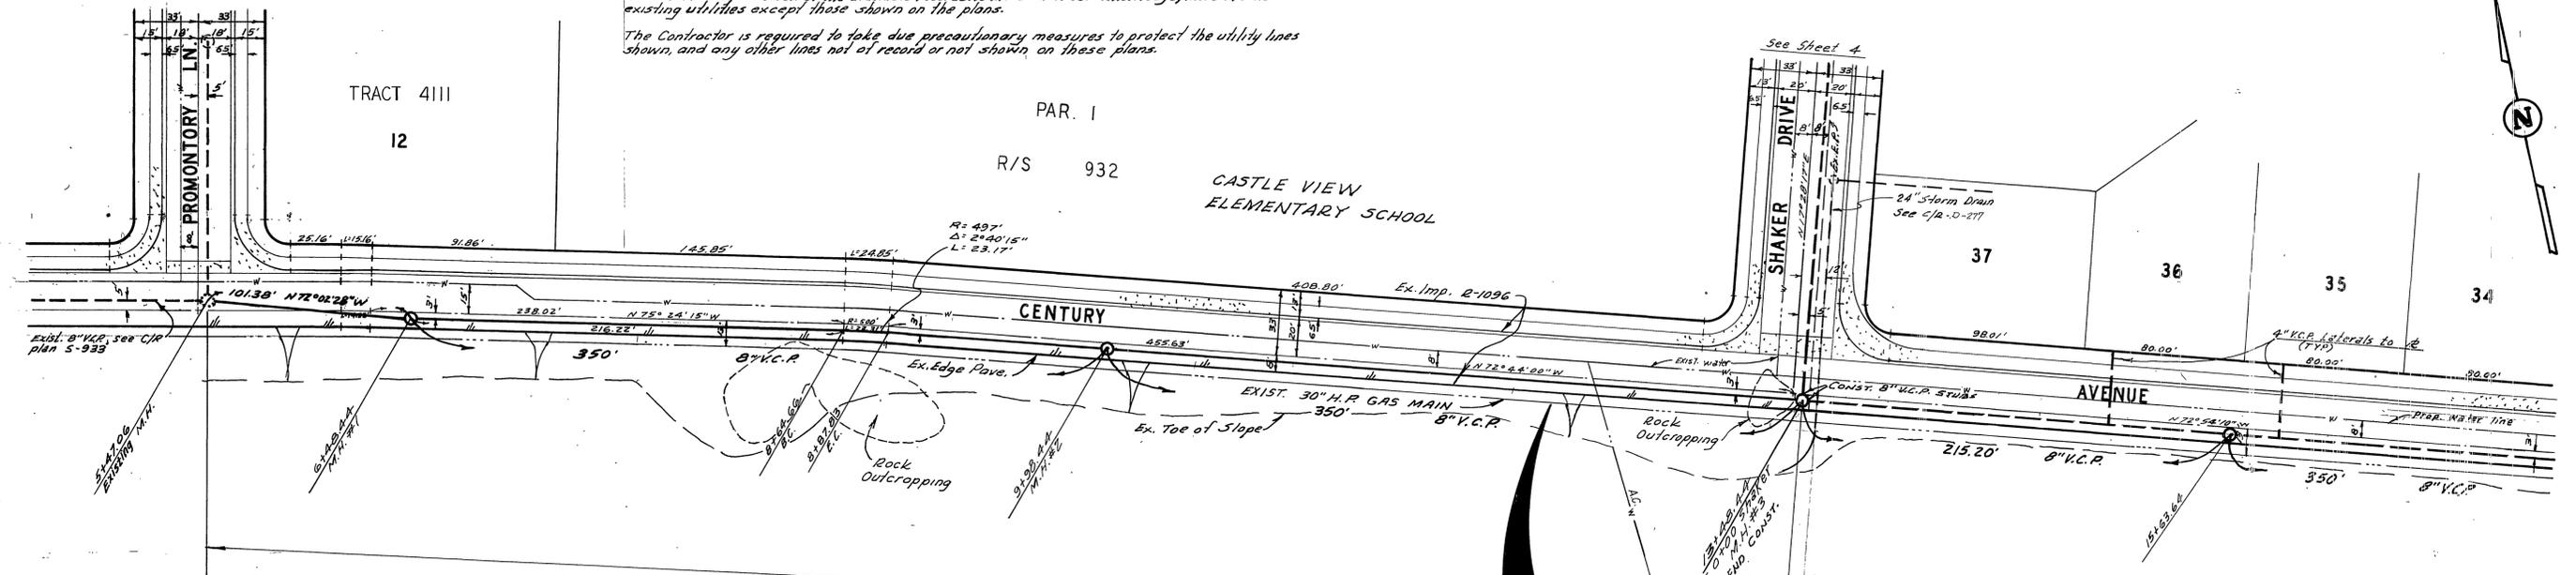

**GENERAL NOTES**

- Construction shall be in accordance with the Standard Specifications for Public Works Construction, 1973 Edition, and City of Riverside Standard Drawings.
- It shall be the responsibility of the Contractor to clear the right of way in accordance with the provisions of the law as it affects each utility including irrigation lines and appurtenances.
- Pipe shall be bedded per Case J, Standard Dwg. No. 452 unless otherwise specified on the Plans.
- All stubs shall be constructed in accordance with Standard Drawing No. 562. Stubs shall be plugged and copped.
- Manhole frames and covers to be set as noted in profile.
- Prior to construction of sewer, Contractor is to expose existing sewer and contact the Engineer for verification of elevation.
- A plug shall be installed and shall remain in place, where the new sewer connects with the existing sewer until such time that the new sewer is accepted by the City.

THIS PORTION OF SEWER IMPROVEMENTS TO BE CONSTRUCTED BY CITY OF RIVERSIDE.

**CAUTION**  
 30" High Pressure Gas Line.  
 Contact Southern California Gas Co. 24 hrs. prior to any grading.  
 Telephone: 1-714-845-2617

Approved By: *Howard J. Orman* 7-22-74  
 Chief Water Utility Engineer Date

ALBERT A. WEBB ASSOCIATES  
 CIVIL ENGINEERS  
 RIVERSIDE, CALIFORNIA  
 APPROVED BY: *Albert A. Webb* DATE: 7/15/74  
 R.E. No. 9876

MARK	REVISIONS	APPR. DATE

CITY OF RIVERSIDE, CALIFORNIA  
 PUBLIC WORKS DEPARTMENT  
 APPROVED BY: *[Signature]* DATE: 1-20-75  
 PRINCIPAL ENGINEER  
 PARK DEPARTMENT  
 TRAFFIC DIVISION  
 CHIEF PUB. WKS. ENGR.

SEWER PLAN AND PROFILE  
 CENTURY AVENUE  
 SEWER EXTENSION FOR TRACT 5900  
 SCALE: Horiz. 1"=40' Vert. 1"=8'

ACCOUNT No. 32-577-543  
 DRAWING NUMBER  
**5-988**  
 SHEET 1 OF 1  
 74-20-B

**BENCH MARK**  
 Chained to 1' north of Tract 5127, 5128 on the west curb of Claridge St. Elev. 1329.51 per A.A. Webb, P.E. 10/16/98 & CIR plan No. 5-819 dated 8/7/72.

\*AS BUILT 8-76 KFT

W.O. 74-20 FOR: BRATTAIN CONST. CO. F.B. 1029

DESIGNED BY: LEB DRAWN BY: BEL CHECKED BY: [Signature]