

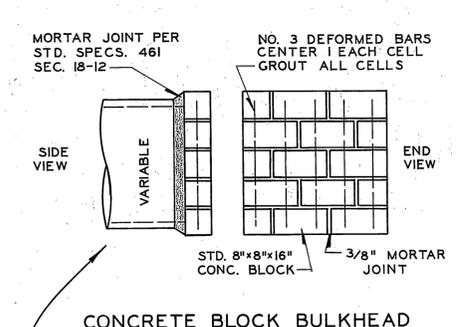
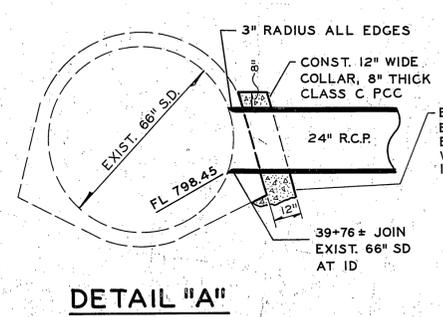


CITY RECORDS SHOW NO SEWER LATERALS WITHIN THE RIGHT-OF-WAY NORTHERLY OF THE STREET CENTER LINE.

BM NAIL IN LEAD IN E'LY CB ARCH WAY 115' S'LY OF CL CENTRAL ELEV. 807.228
FB 728/25-41 714/55

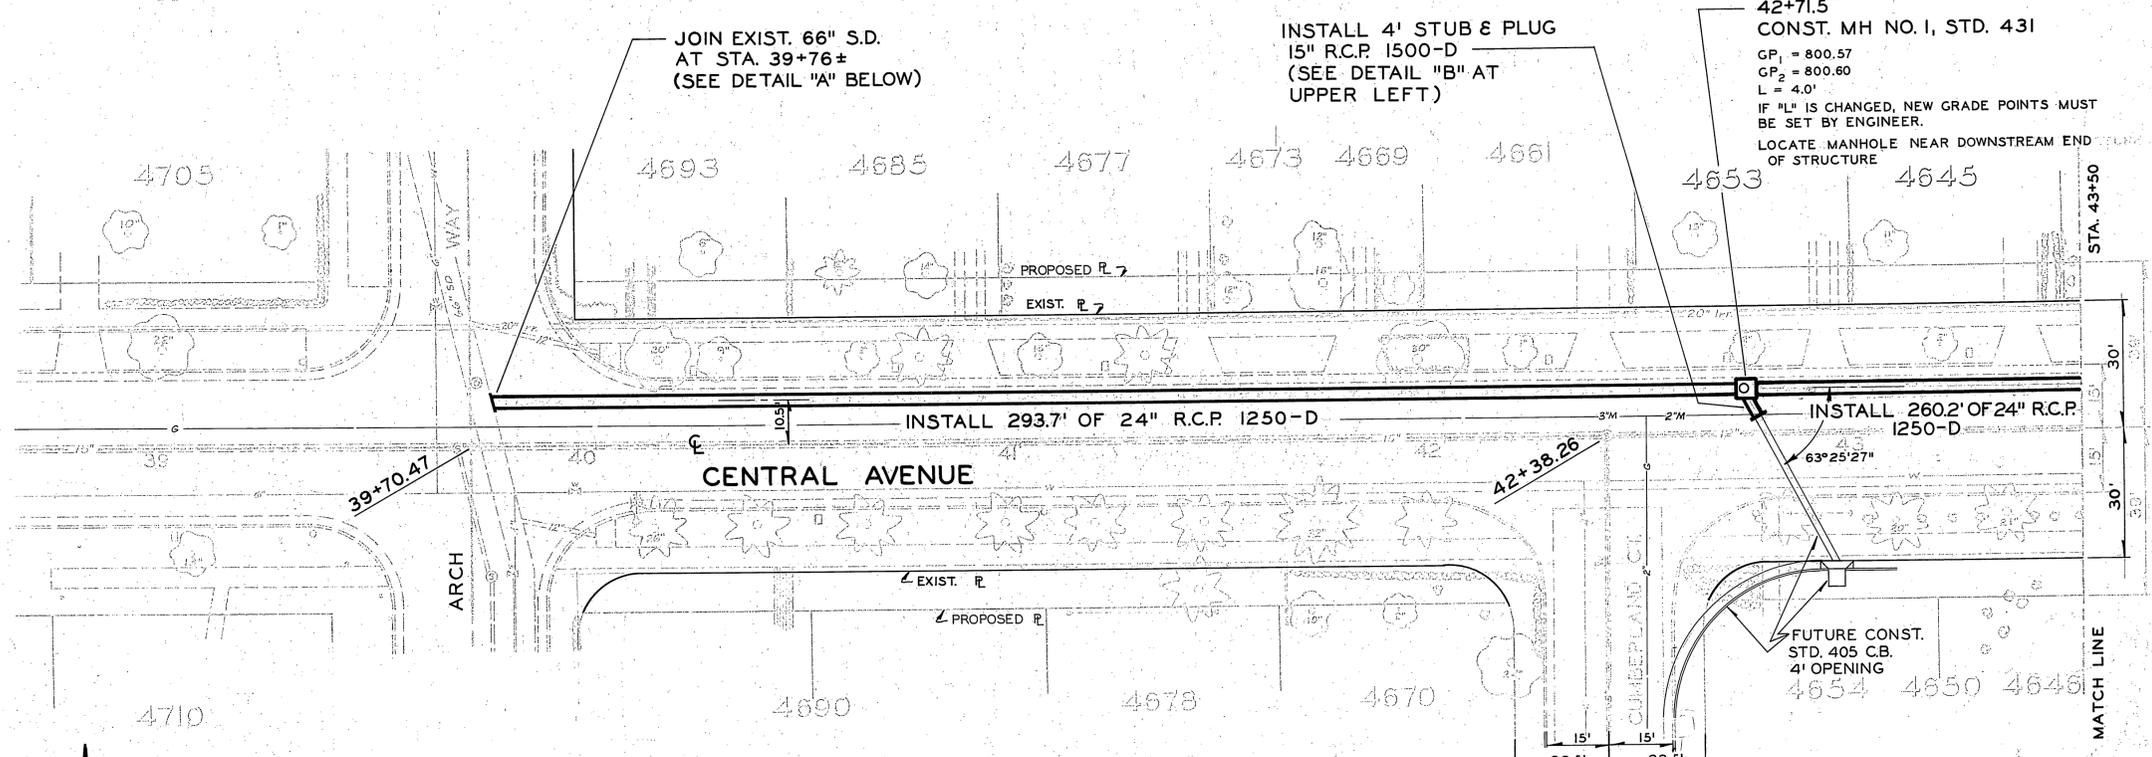



ALTERNATES

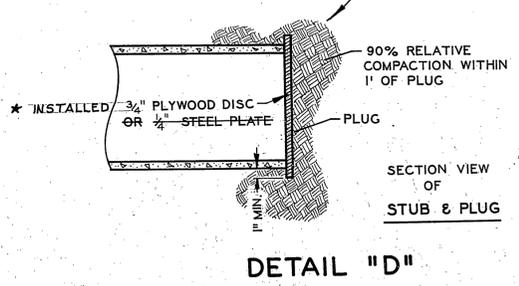


FOR TYPICAL TRENCH SECTION SEE SHEET NO. 3

CITY OF RIVERSIDE, CALIFORNIA
DEPARTMENT OF PUBLIC WORKS
W.D.G. 11/24/66
William D. Gardner
for
Wdg 8-24 8/24/66

A/C 3106
PROJECT S.S. 320
CENTRAL AVE.
STORM DRAIN
ARCH WAY TO PALM AVE
D-141
1 3

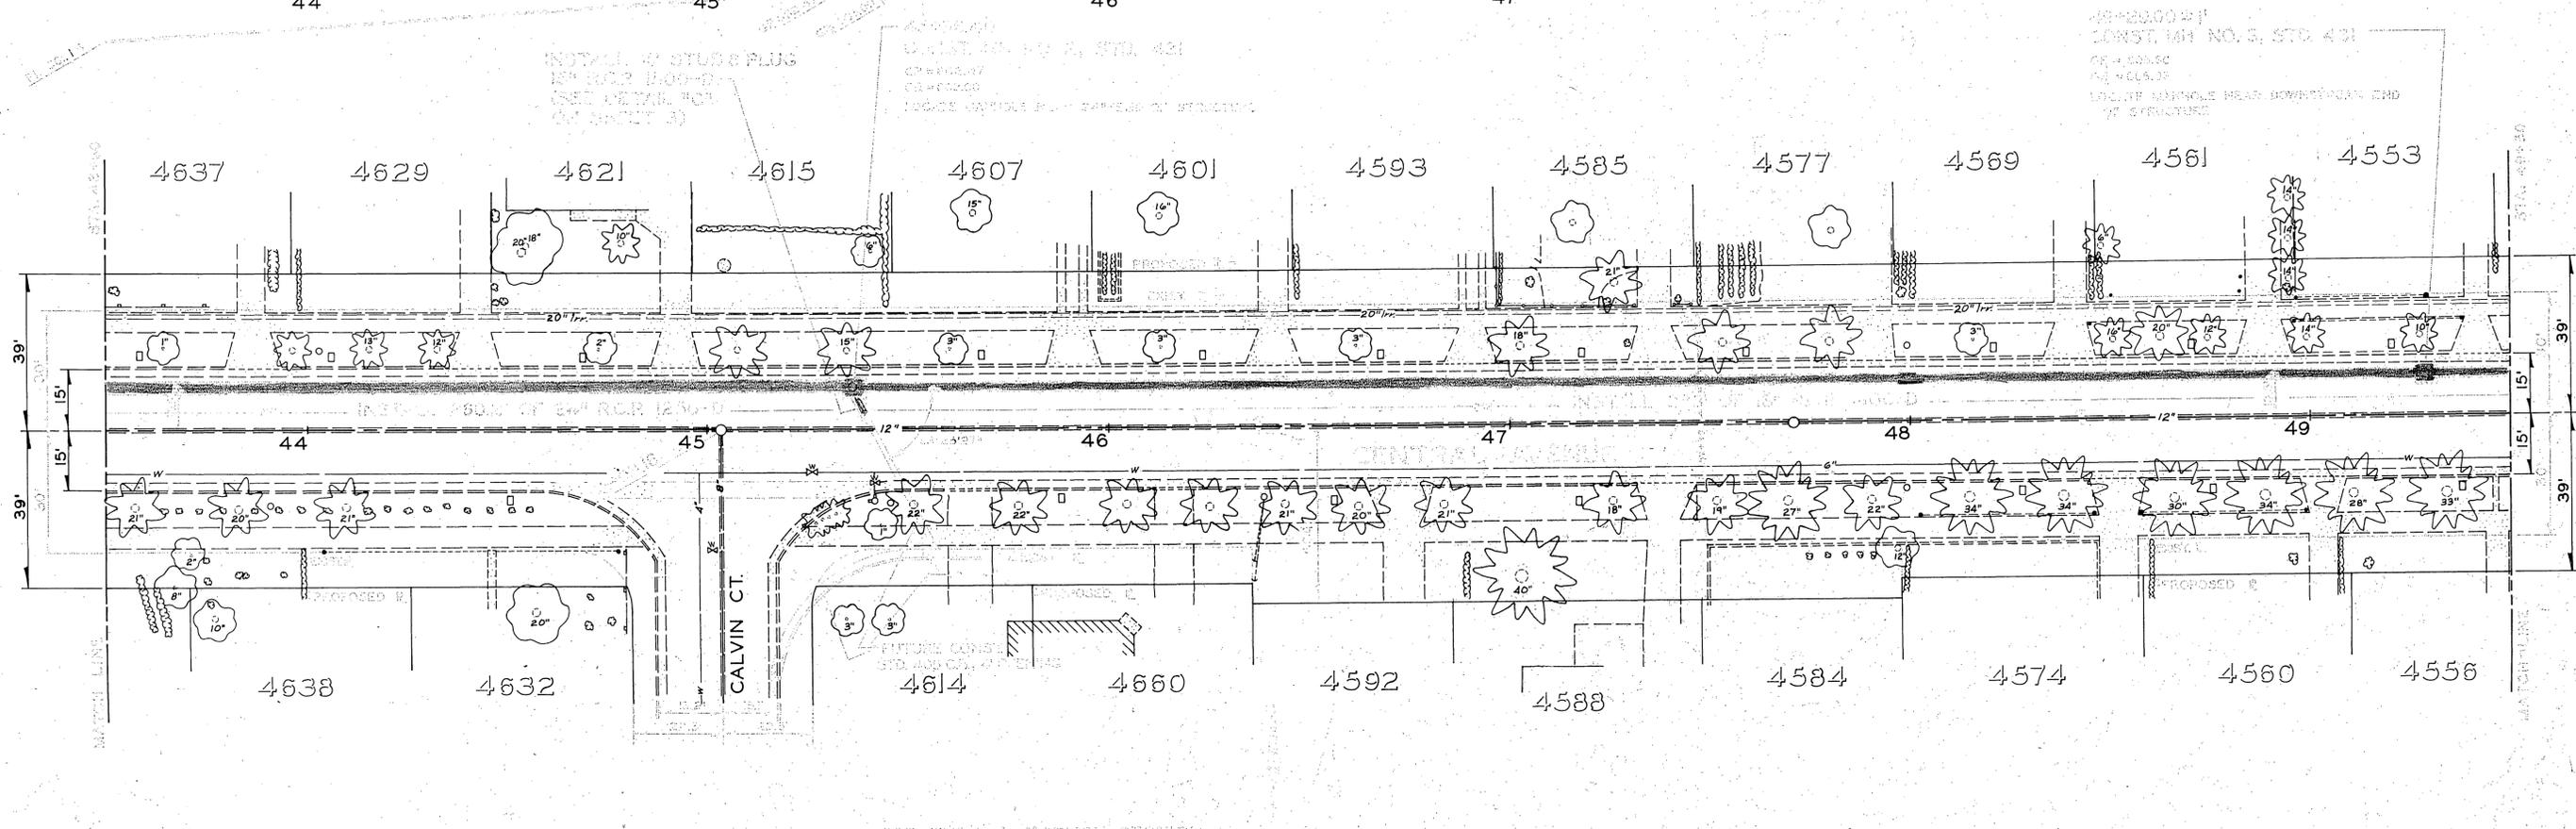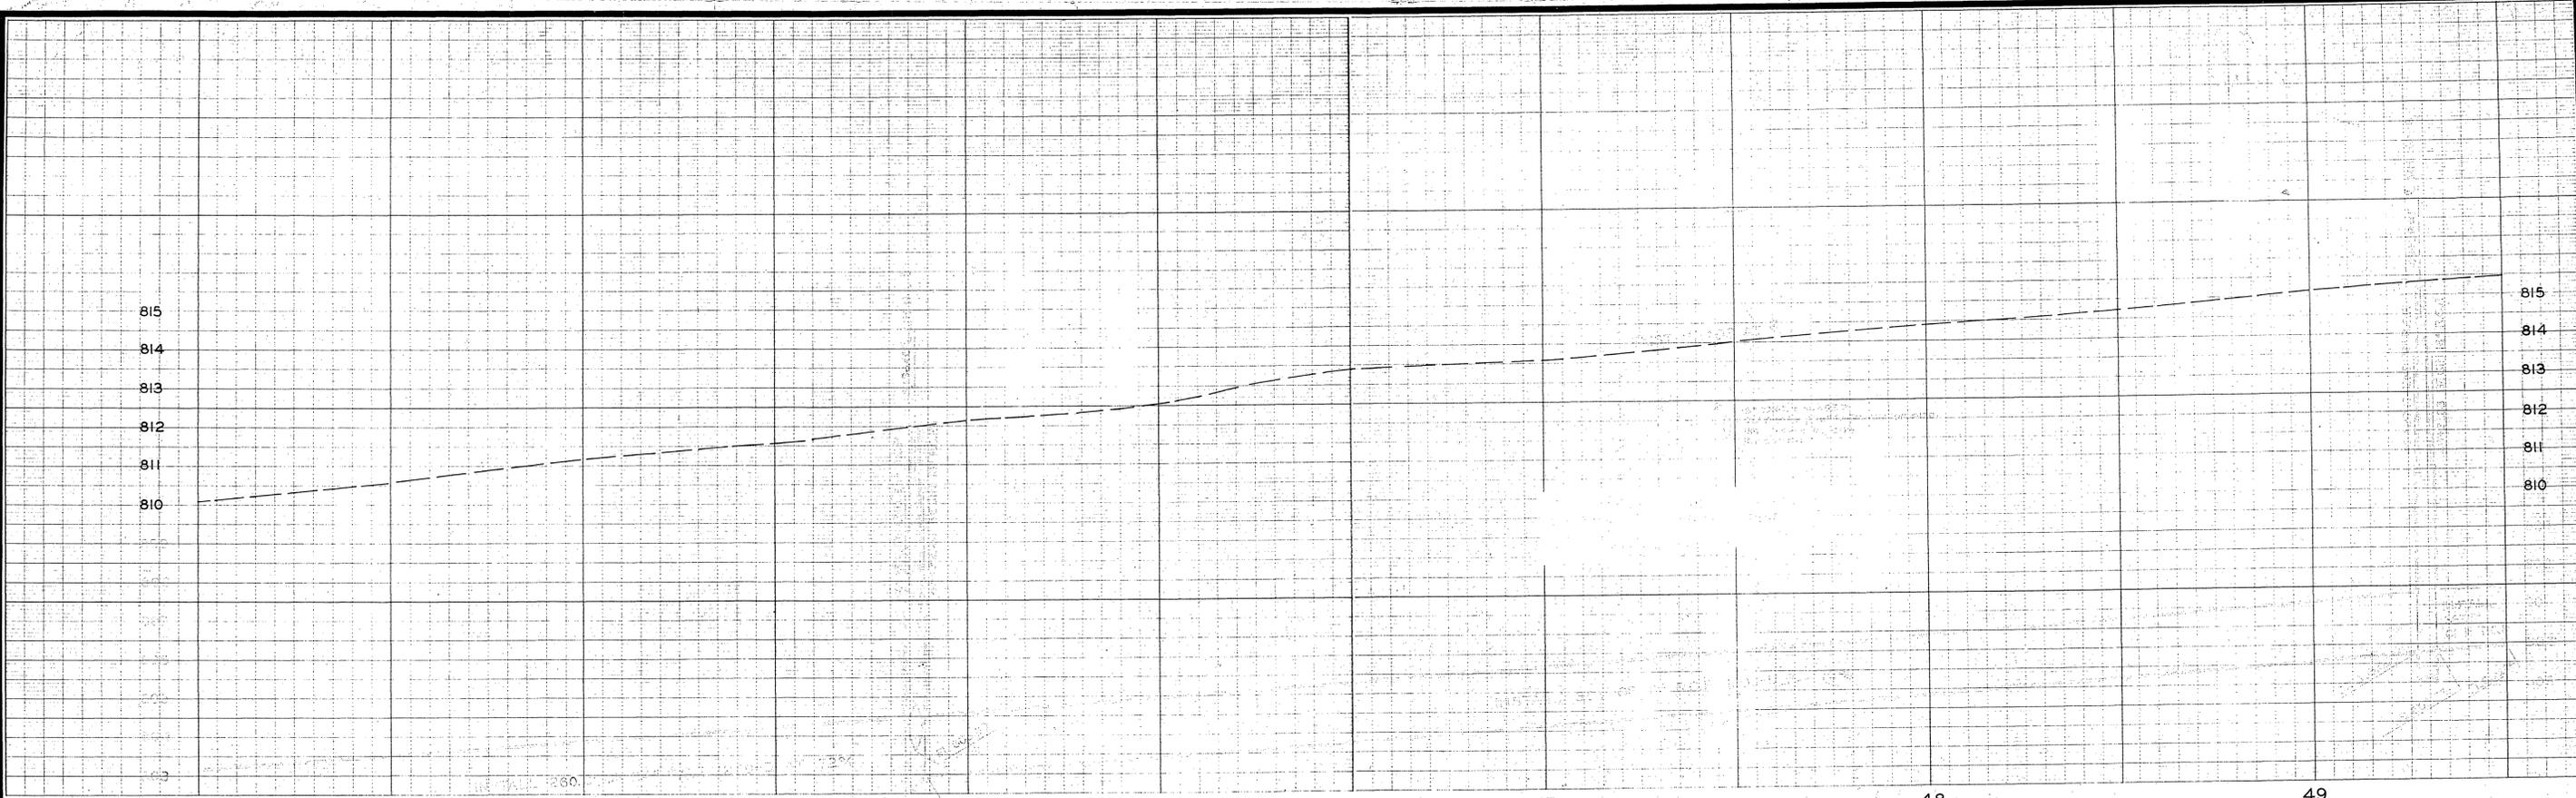

CITY OF RIVERSIDE, CALIFORNIA DEPARTMENT OF PUBLIC WORKS		PROJECT NO. 98-030 D-141 SHEET 2 OF 3
APPROVED BY: _____ OFFICE ENGINEER PARK DEPARTMENT TRAFFIC DIVISION ASSISTANT CITY ENG.	APPROVED BY: _____ DIRECTOR OF PUBLIC WORKS	
MARK: _____ DESIGNED BY: _____ DRAWN BY: _____ CHECKED BY: _____	REVISIONS: _____ APPR. DATE: _____	DATE: _____ HORIZ. SCALE: 1" = 20' VERT. SCALE: 1" = 2' FILE NO. _____

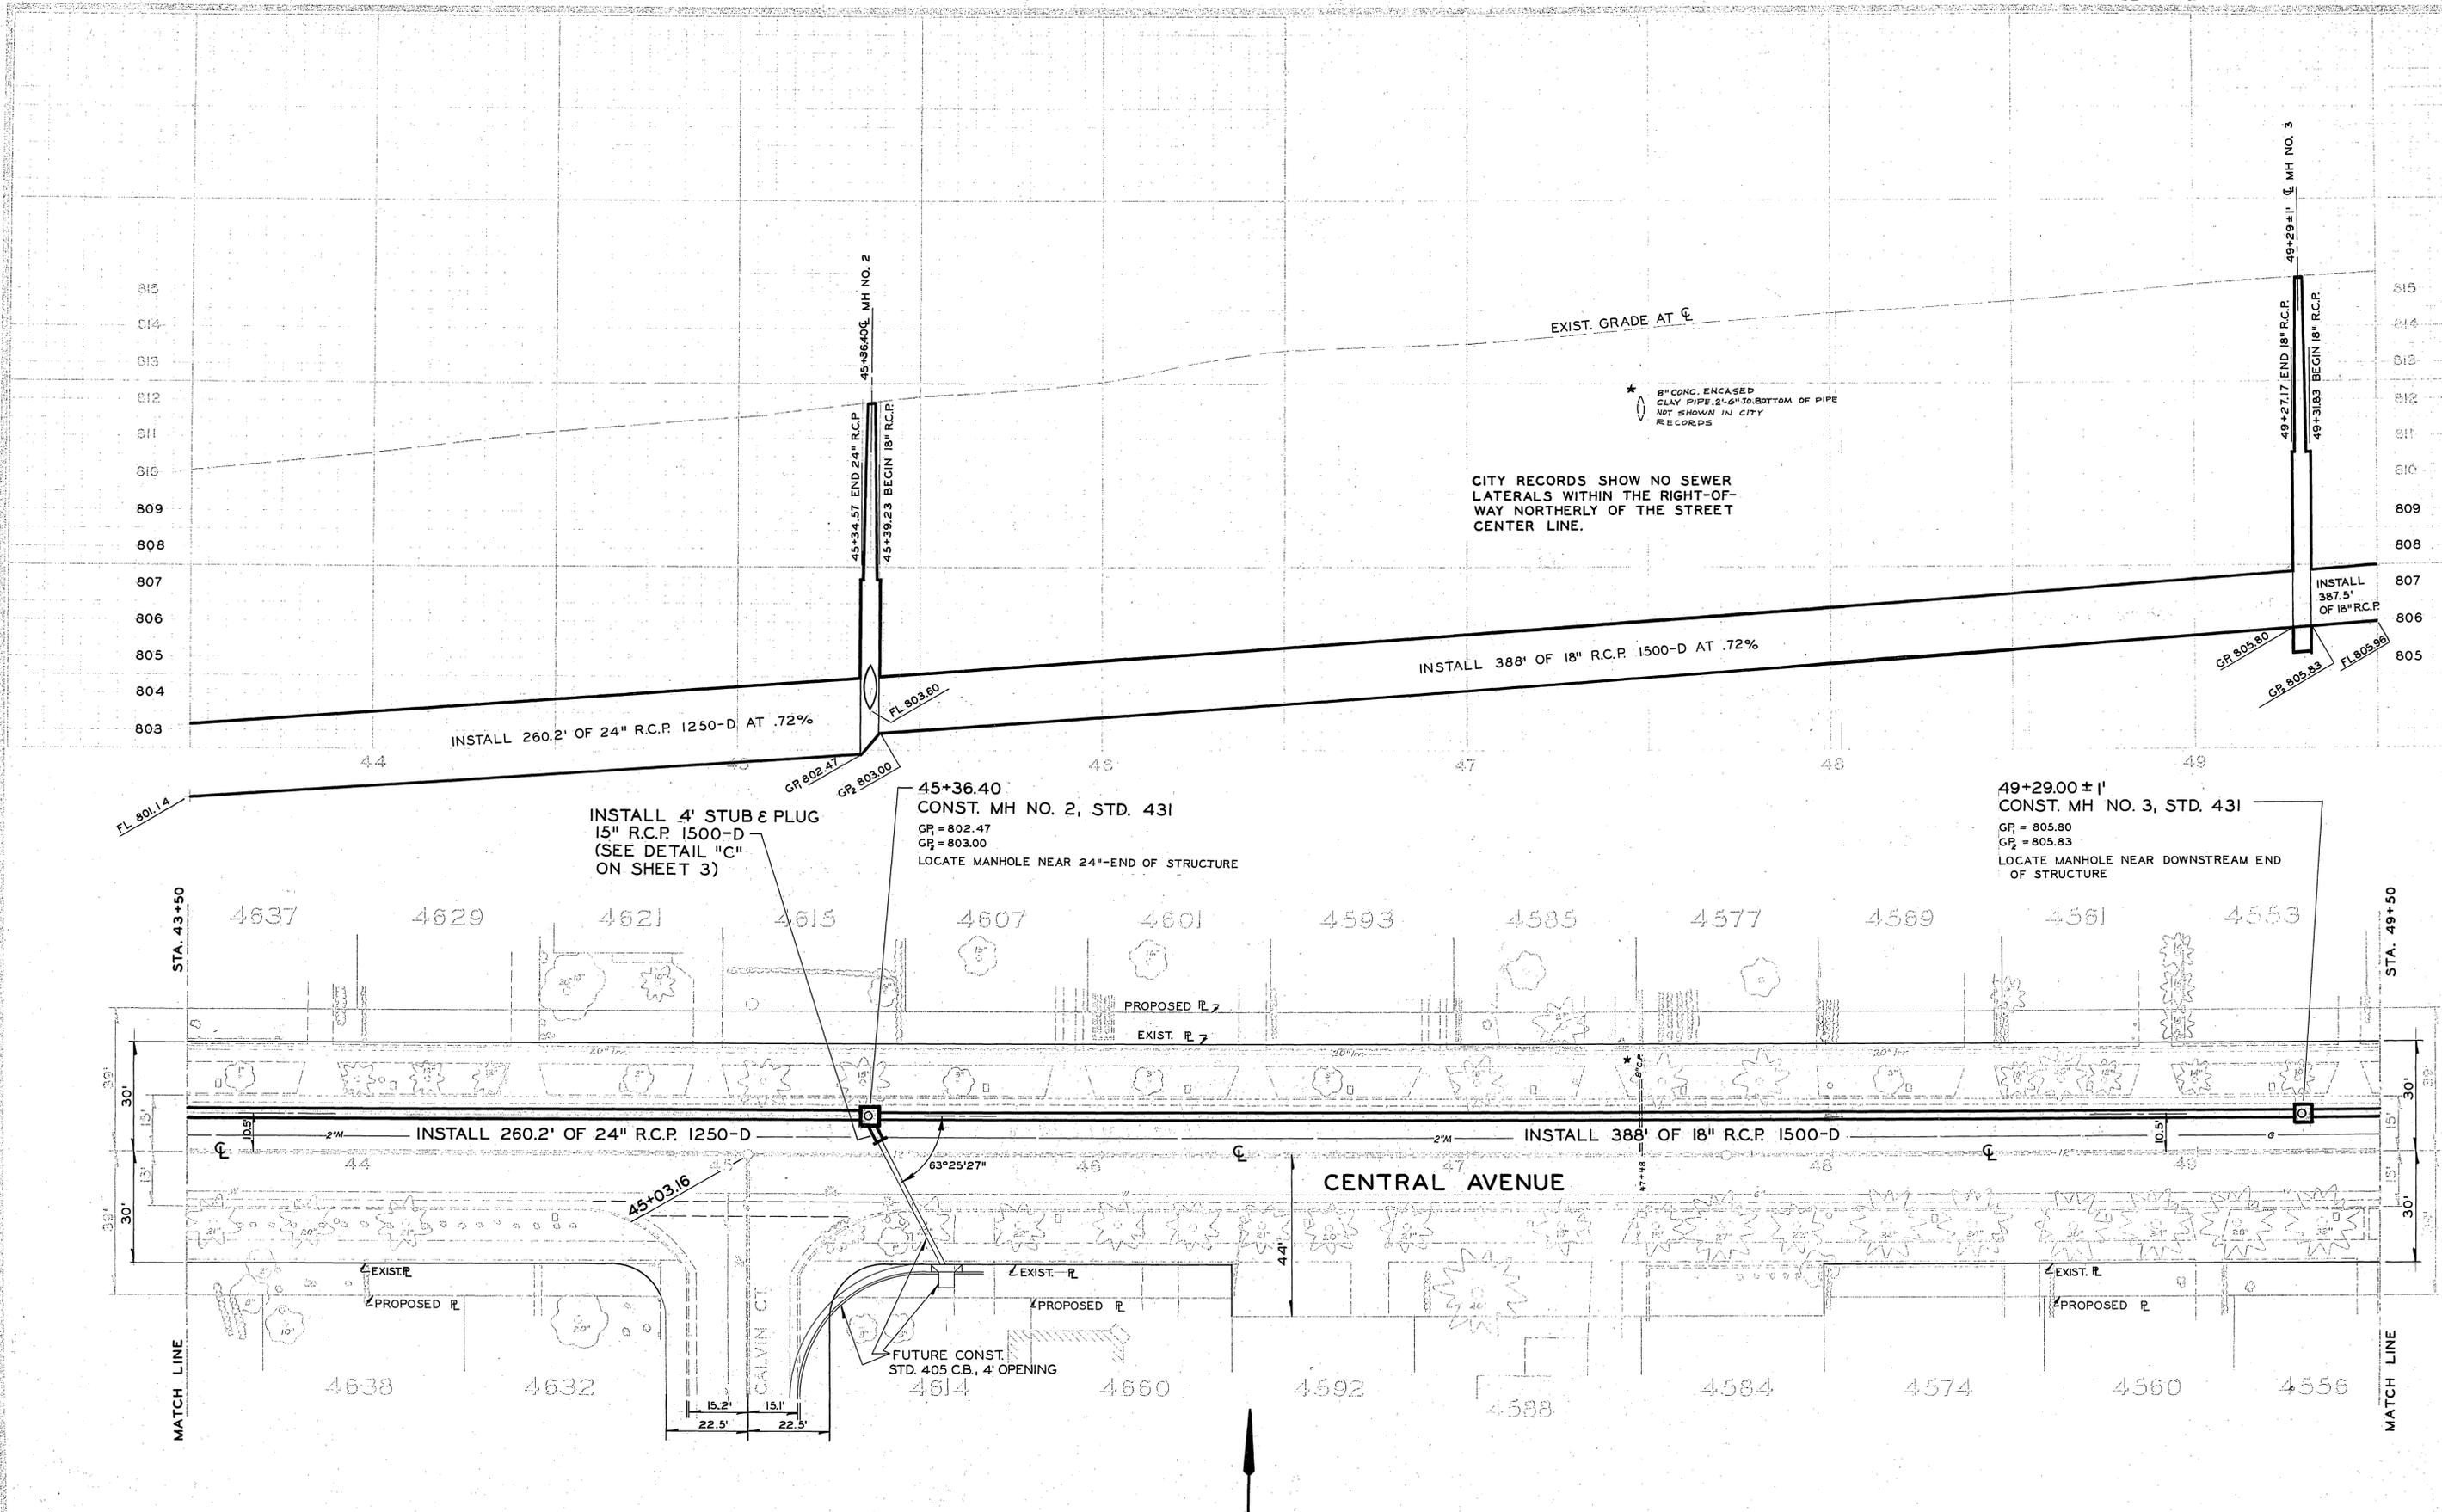

CITY RECORDS SHOW NO SEWER
LATERALS WITHIN THE RIGHT-OF-
WAY NORTHERLY OF THE STREET
CENTER LINE.


* 8" CONC. ENCASED
CLAY PIPE 2'-6" TO BOTTOM OF PIPE
NOT SHOWN IN CITY
RECORDS

INSTALL 4' STUB & PLUG
15" R.C.P. 1500-D
(SEE DETAIL "C"
ON SHEET 3)





45+36.40
CONST. MH NO. 2, STD. 431
GR = 802.47
GP = 803.00
LOCATE MANHOLE NEAR 24"-END OF STRUCTURE

49+29.00 ± 1'
CONST. MH NO. 3, STD. 431
GR = 805.80
GP = 805.83
LOCATE MANHOLE NEAR DOWNSTREAM END
OF STRUCTURE

FOR TYPICAL TRENCH SECTION
SEE SHEET NO. 3

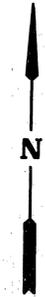

AS BUILT	DATE	BY	CITY OF RIVERSIDE, CALIFORNIA DEPARTMENT OF PUBLIC WORKS	CENTRAL AVE. STORM DRAIN ARCH WAY TO PALM AVE.	D-141 2 3
11/30/66	8/24/66	William D. Hordine			

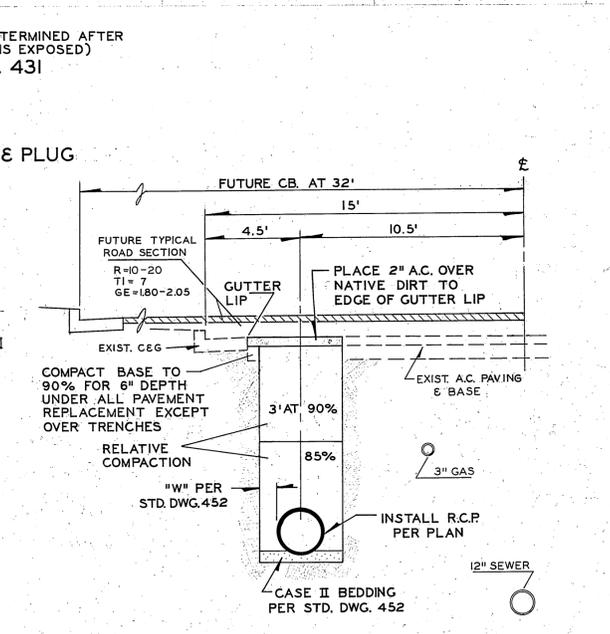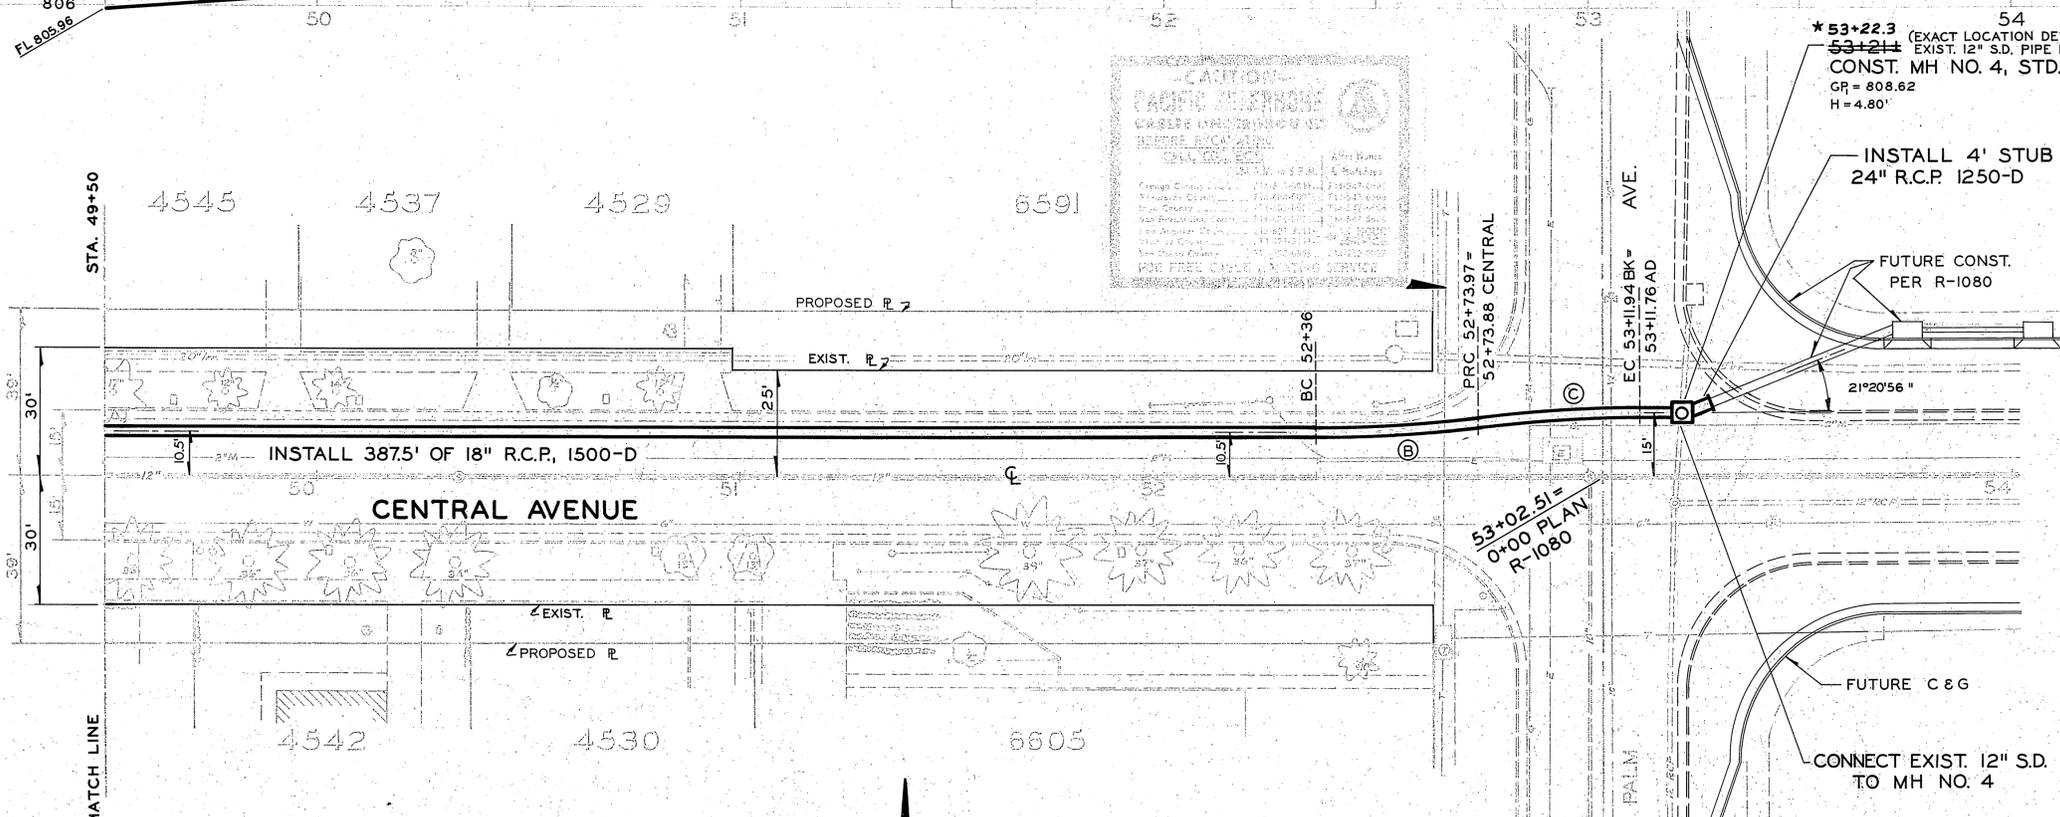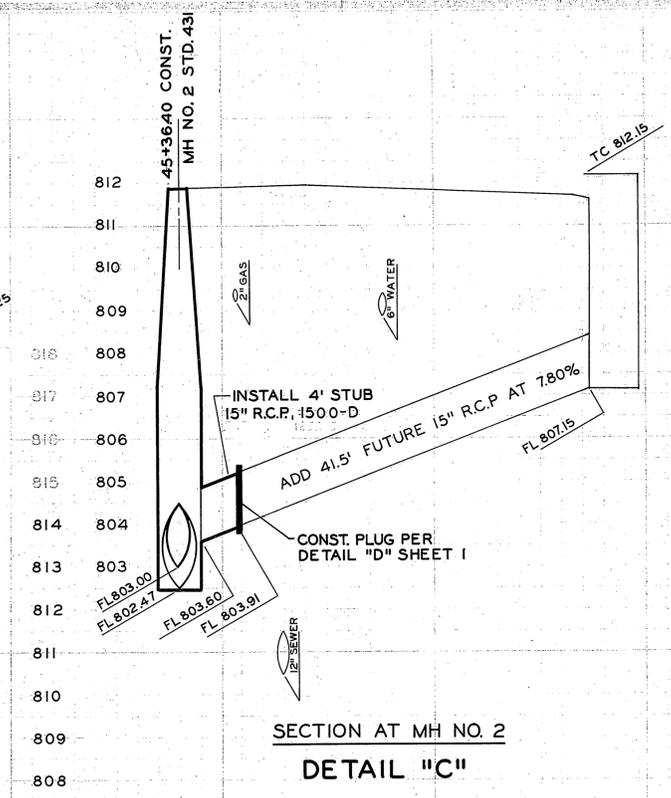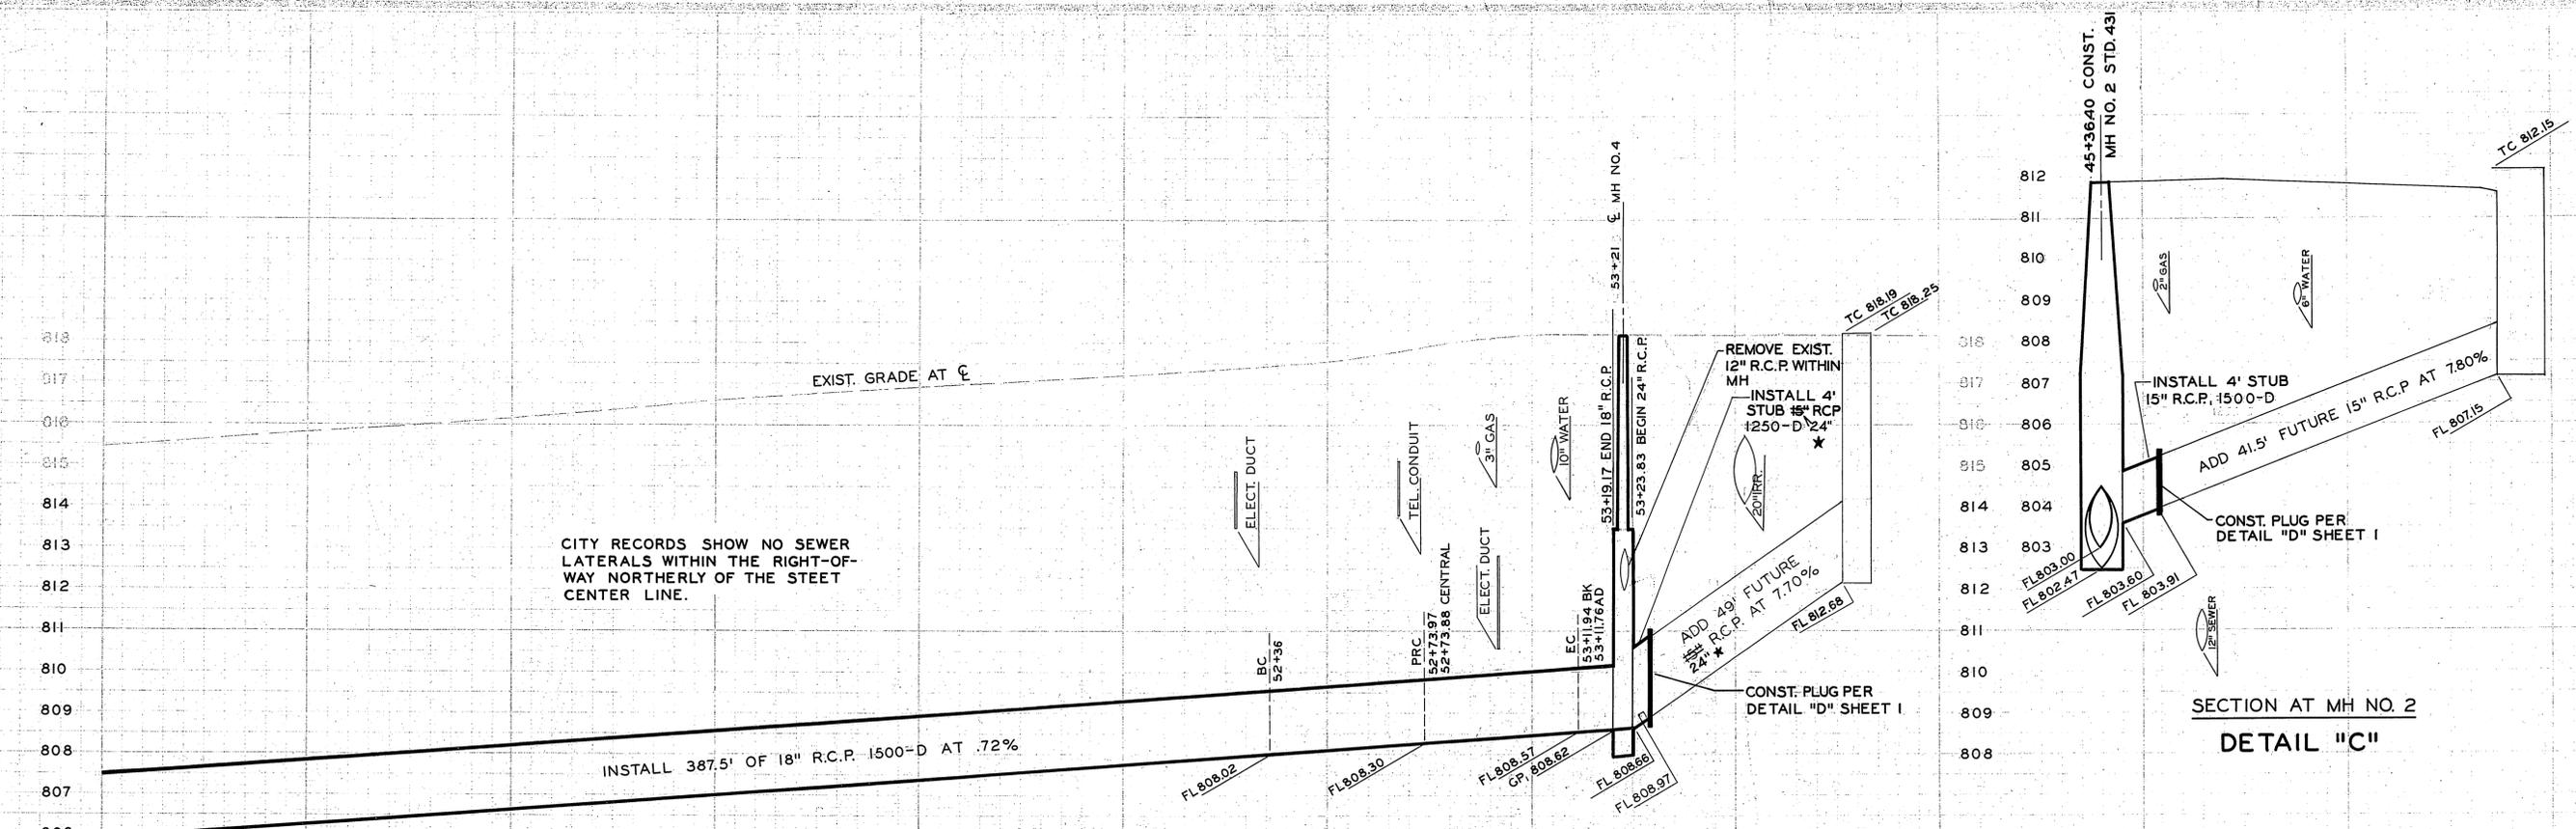

18" R.C.P. ϕ CURVE DATA

$\text{B} = \text{C}$
 $R = 320'$
 $\Delta = 6^\circ 47' 54''$
 $L = 37.97'$
 $T = 19.01'$



AS BUILT *SS 11.31.66*


CITY OF RIVERSIDE, CALIFORNIA
 DEPARTMENT OF PUBLIC WORKS

W.D. Gordon
 8/24/66

**CENTRAL AVE.
 STORM DRAIN**
 ARCH WAY TO PALM AVE.

D-141

A/C 3108
 S.S. 320
 3 3


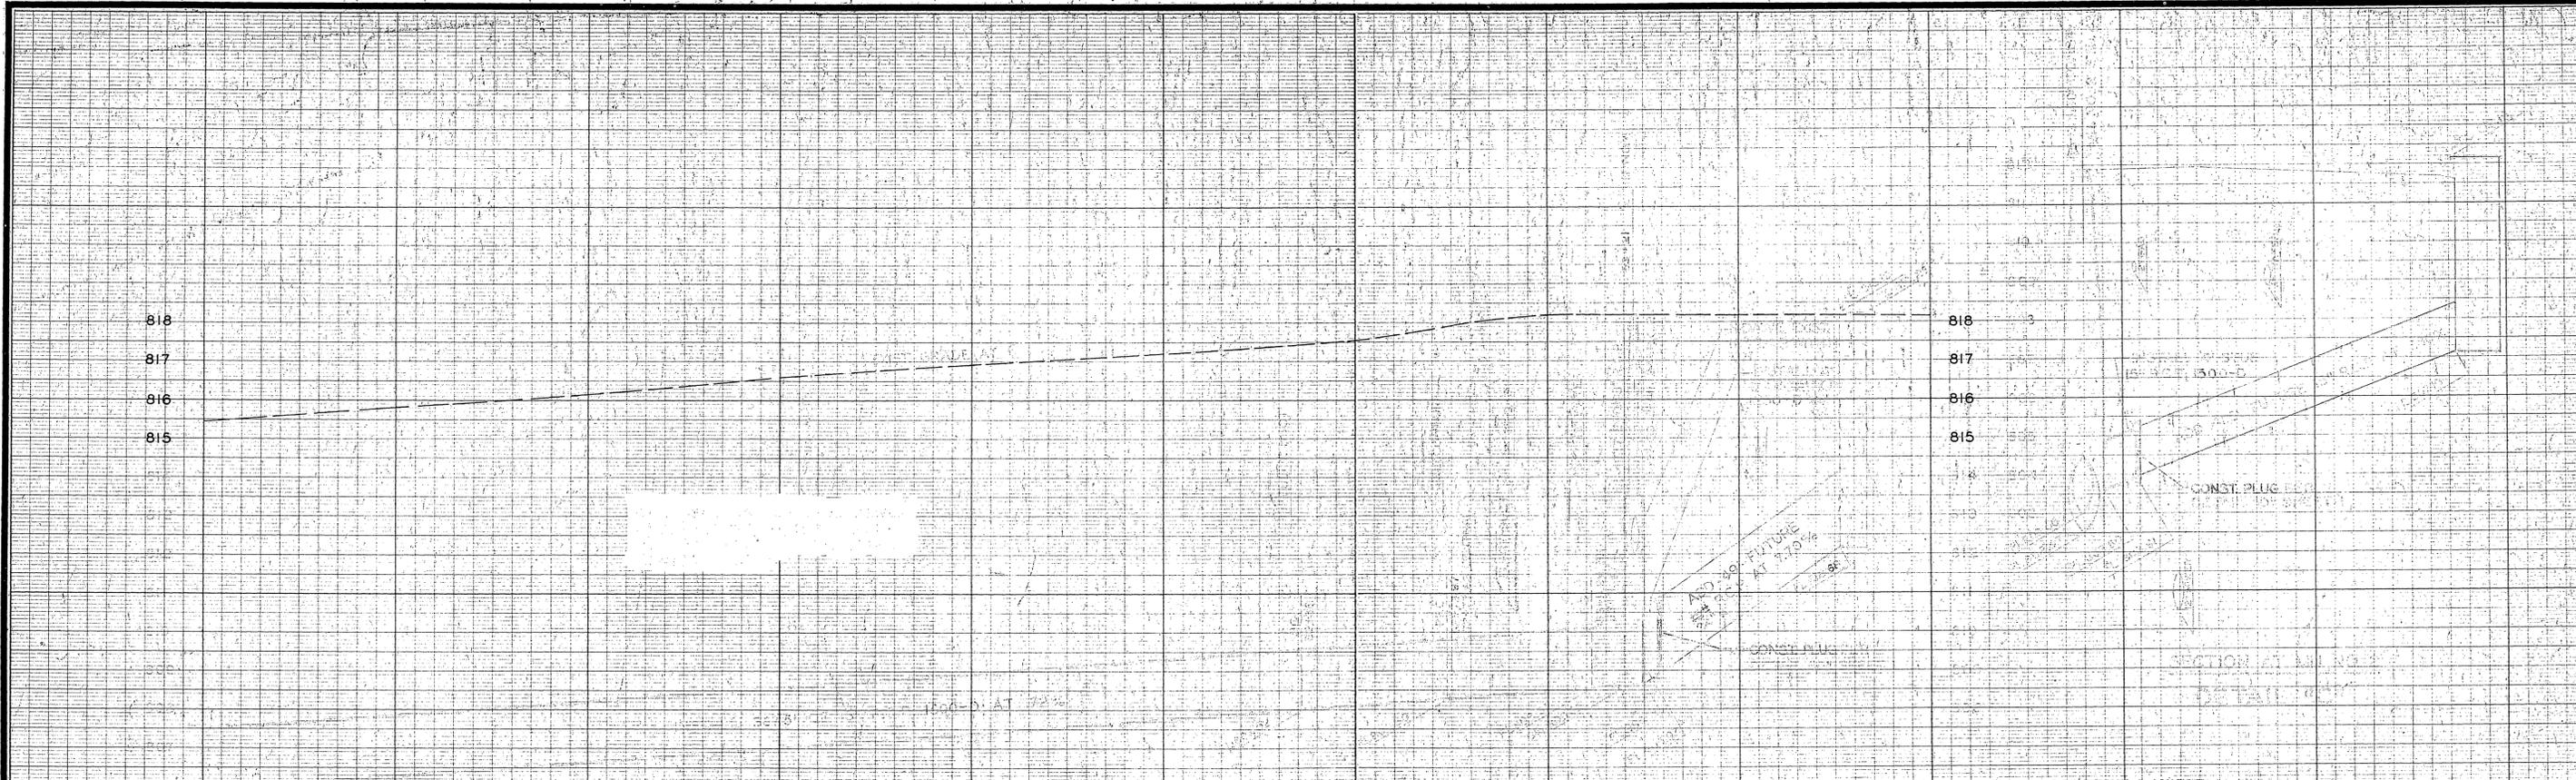


-CAUTION-
PACIFIC TELEPHONE
CABLES UNDERGROUND
BEFORE EXCAVATING

CALL COLLECT
 7:30 A.M. to 5 P.M. & Holidays
 After Hours

Orange County 714-633-0811 714-547-6606
 Riverside County 714-684-0071 714-547-6606
 Inyo County 714-684-0071 714-547-6606
 San Bernardino County 714-684-0071 714-547-6606
 Los Angeles County 213-621-3111
 Ventura County 213-621-3111
 San Diego County 714-298-0595 714-232-0027

24 HOUR SERVICE
 FOR FREE CABLE LOCATING SERVICE

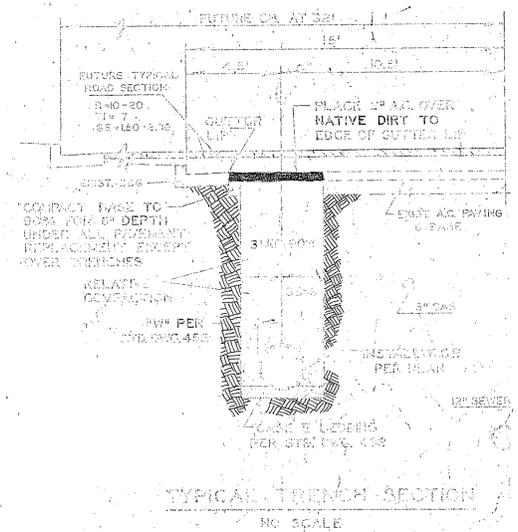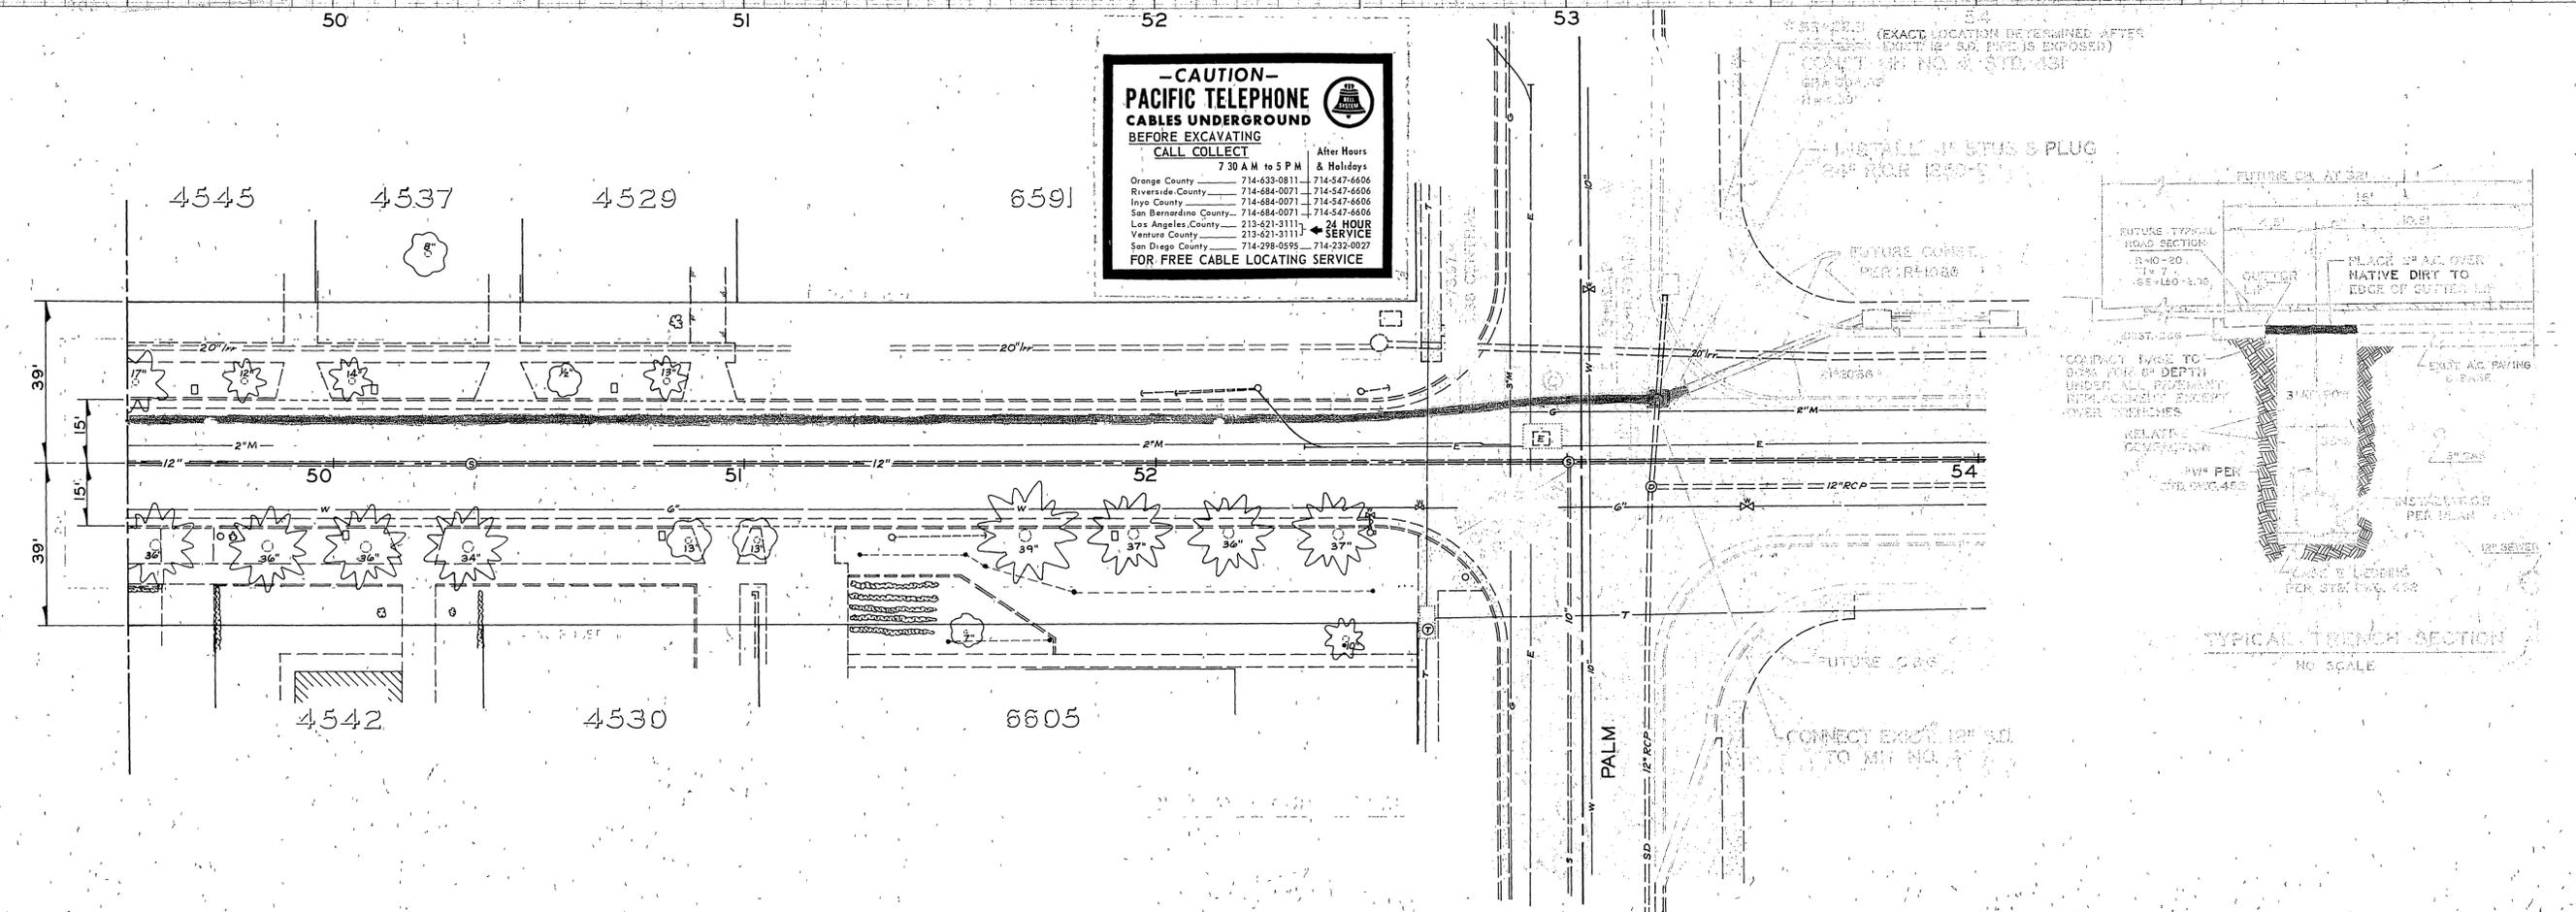

CITY OF RIVERSIDE, CALIFORNIA DEPARTMENT OF PUBLIC WORKS				PROJECT NO.
APPROVED BY	BY	DATE	APPROVED BY	D-14
OFFICE ENGINEER			DIRECTOR OF PUBLIC WORKS	
DESIGNED BY	DRAWN BY	CHECKED BY	DATE	SHEET 3 OF 3
REVISIONS			MARK	HORIZ SCALE 1" = 20'
APPR DATE			DESIGNED BY	VERT SCALE 1" = 2'
APPR DATE			DRAWN BY	FILE NO.
CHECKED BY			CHECKED BY	