

840


830

820

840

830

820

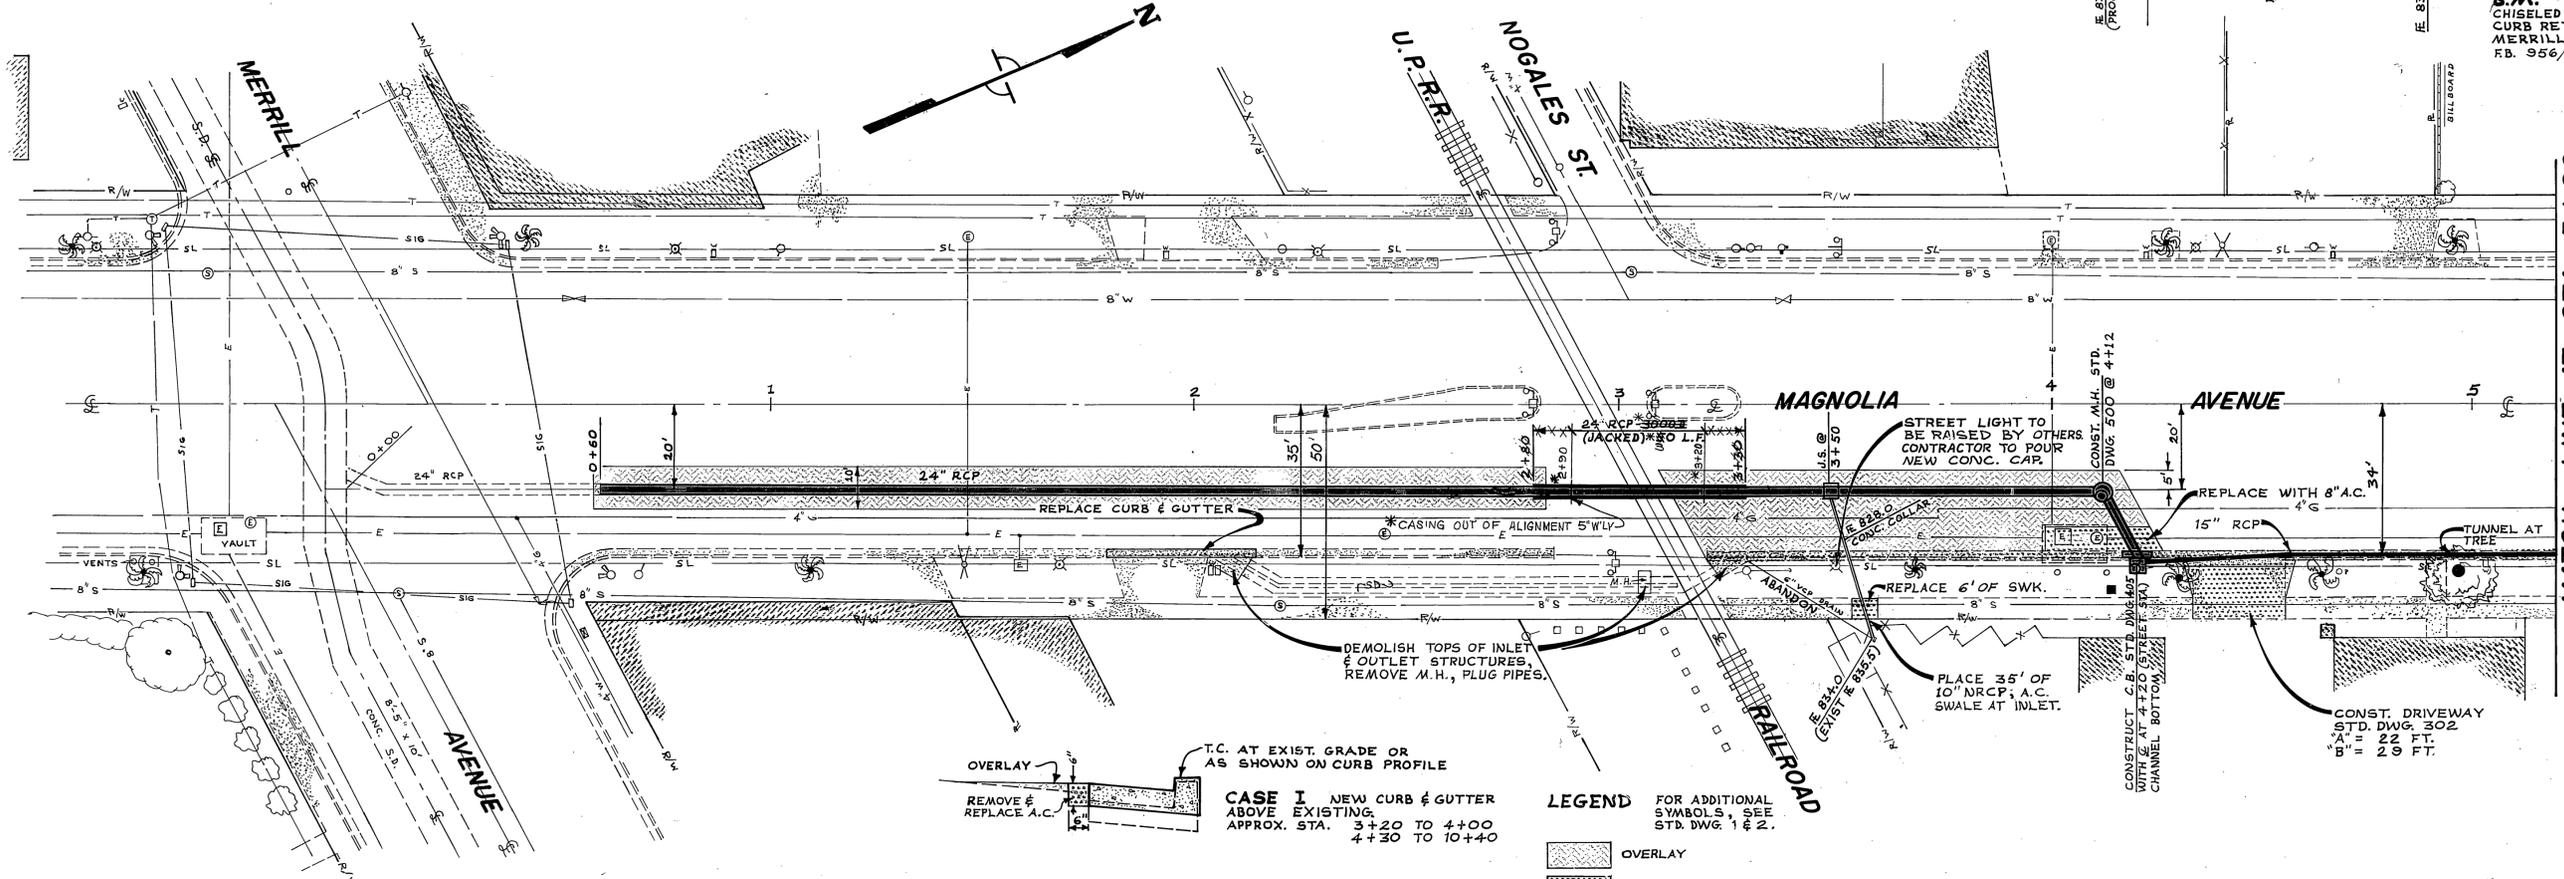

B.M. ELEVATION 832.81
 CHISELED 'X', CENTER OF
 CURB RETURN, NW CORNER
 MERRILL & MAGNOLIA AVE.
 FB. 956/51

OVERLAY
 REMOVE & REPLACE A.C.
 T.C. AT EXIST. GRADE OR AS SHOWN ON CURB PROFILE

CASE I NEW CURB & GUTTER ABOVE EXISTING.
 APPROX. STA. 3+20 TO 4+00
 4+30 TO 10+40

CASE II NEW CURB & GUTTER BELOW EXISTING.
 APPROX. STA. 4+00 TO 4+30
 5+90 TO 6+10
 10+40 TO 11+60

LEGEND FOR ADDITIONAL SYMBOLS, SEE STD. DWG. 1 & 2.


OVERLAY
 REMOVE & REPLACE AS SHOWN

TYP. CURB REPLACEMENT CONDITIONS
 WIDTH OF OVERLAY OR REMOVAL SHOWN ON PLAN
 NOT TO SCALE




CITY OF RIVERSIDE, CALIFORNIA DEPARTMENT OF PUBLIC WORKS		MAGNOLIA AVE. S.D. MERRILL AVENUE TO ELIZABETH STREET		PROJECT NO. 465 DRAWING NUMBER D-273
APPROVED BY PRINCIPAL ENGINEER PARK DEPARTMENT TRAFFIC DIVISION CHIEF P. ENGR.	BY DATE 7/27	APPROVED BY DIRECTOR OF PUBLIC WORKS	DATE 9-27	SHEET 1 OF 2
DESIGNED BY DRAWN BY CHECKED BY D.C.H.		HORIZ. SCALE: 1" = 20' VERT. SCALE: 1" = 4' FILE NO.		

* I-S BUILT 5/1/73 JRG.

MATCH LINE AT STA. 5+20

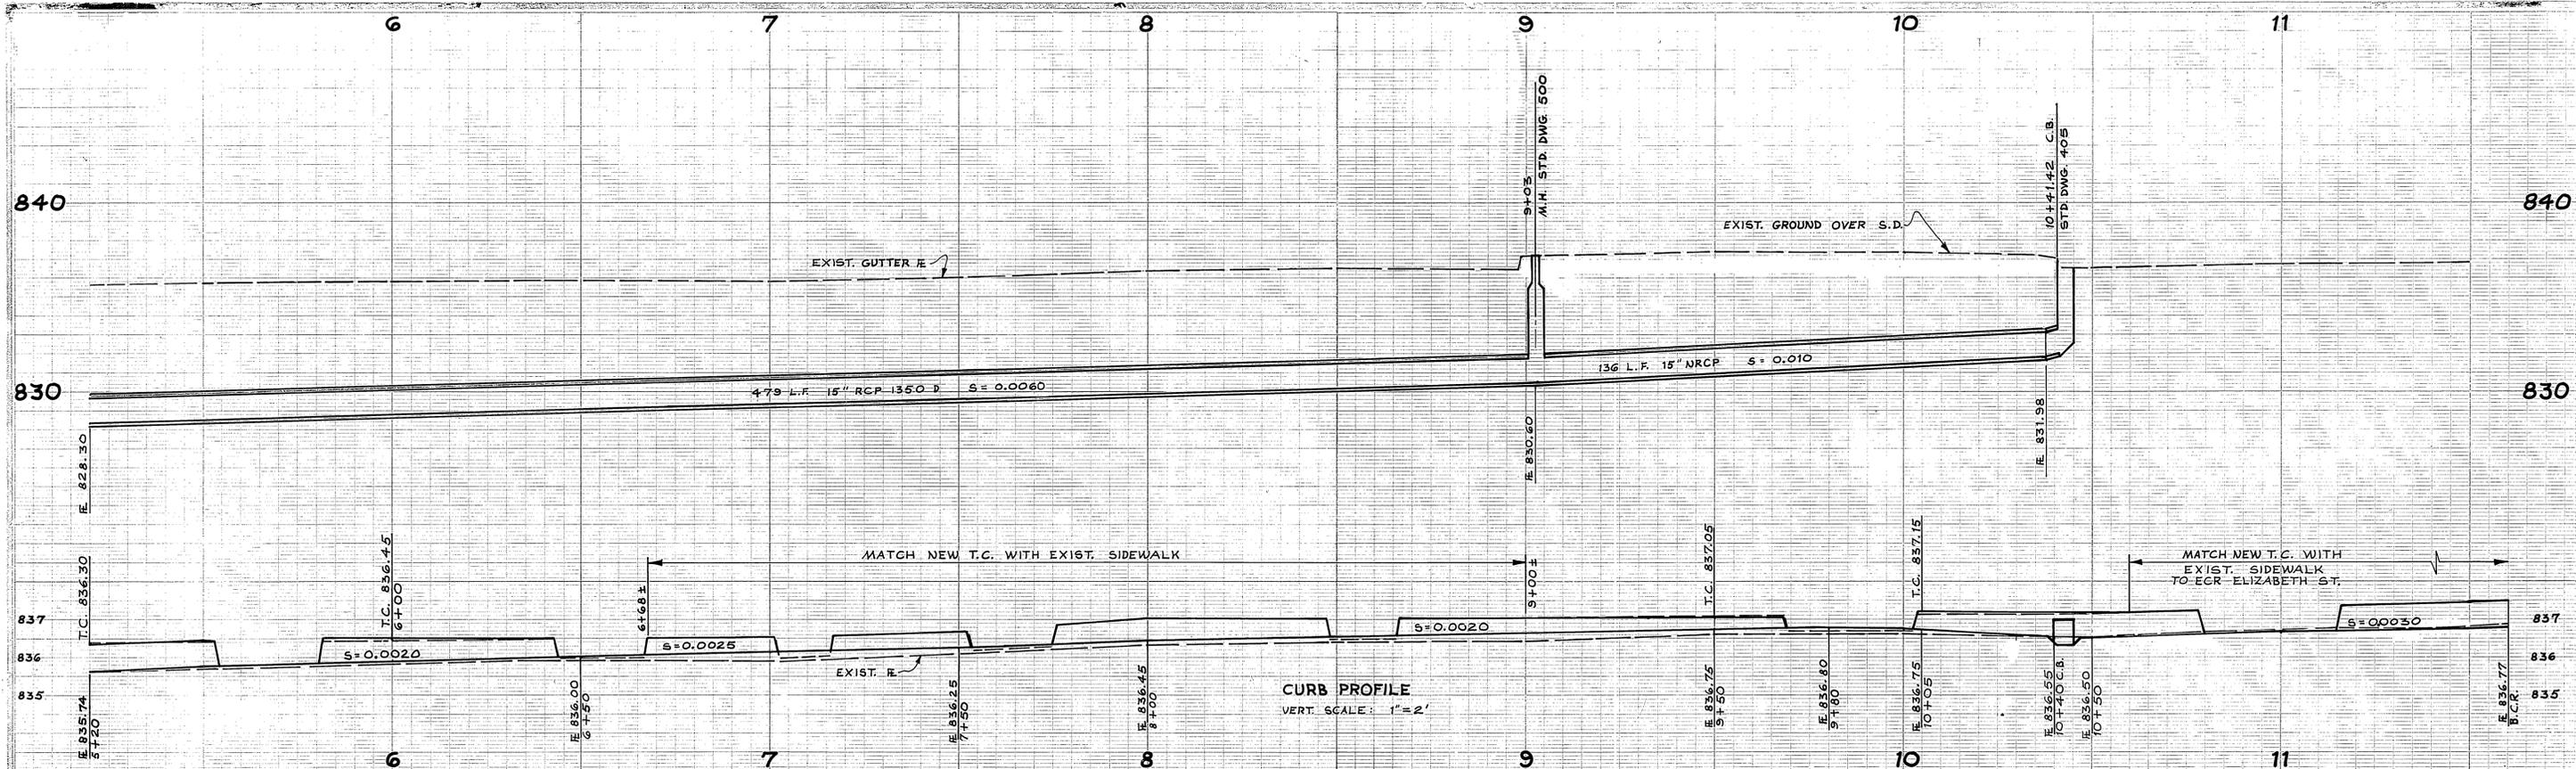

B.M. ELEV. 832.81
CHISELED "X" CENTER
OF CURB RETURN, N.W.
CORNER, MERRILL &
MAGNOLIA AVE.
FB. 956/51

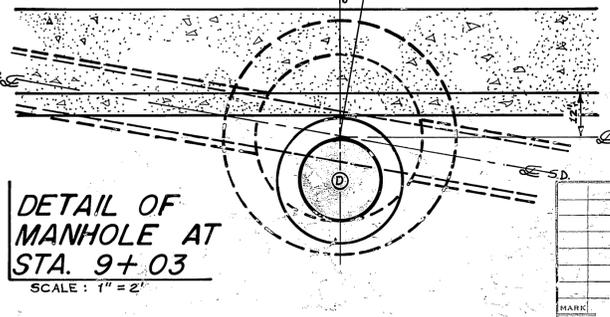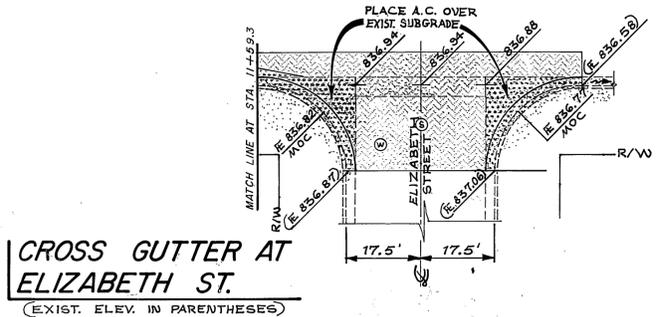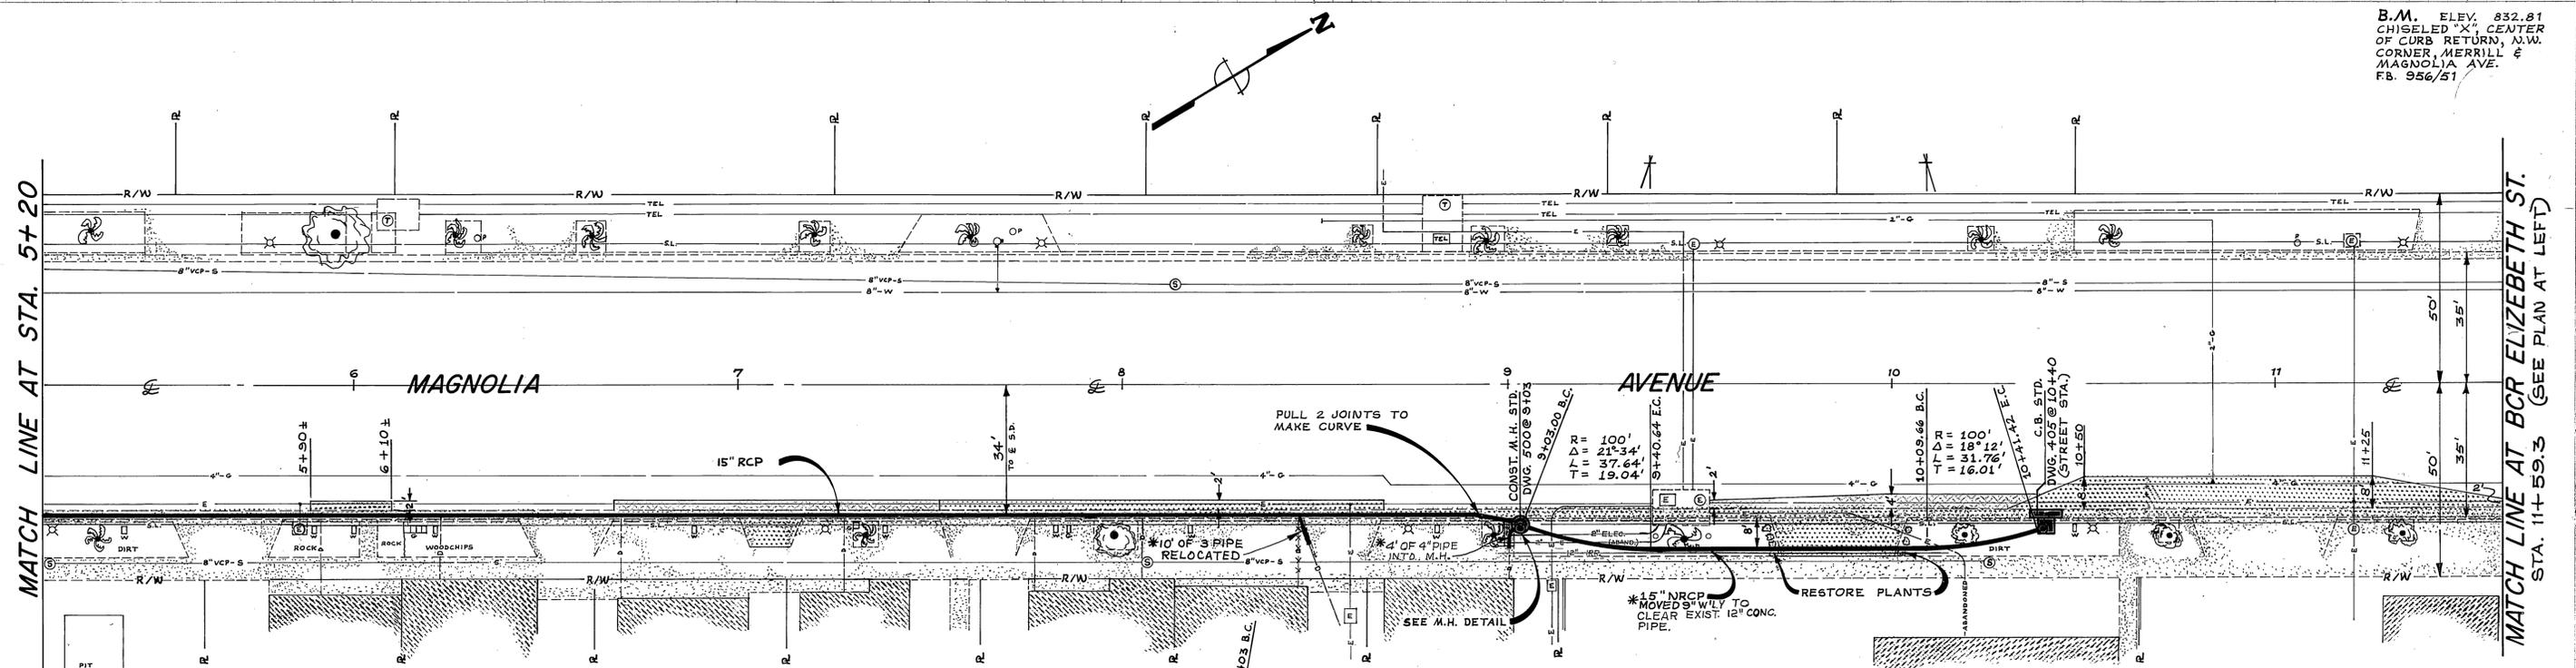

CITY OF OVERSIDE, CALIFORNIA
DEPARTMENT OF PUBLIC WORKS

MAGNOLIA AVE. S.D.
MERRILL AVENUE TO ELIZABETH STREET

PROJECT NO. **D-233**

SHEET 2 OF 2

NO. 30 20' VERT. SCALE 1" = 4' FILE NO.

* AS BUILT 5/1/73 J.R.G.

REVISIONS: MARK, SIGNED BY, DRAWN BY, DATE