


GENERAL CONSTRUCTION NOTES

1. CONSTRUCT EZ MANHOLES PER STD. 431 AS INDICATED BY: ALL MANHOLES SHALL HAVE A 36" CLEAR OPENING.
2. EXACT DEPTH OF UNDERGROUND UTILITIES MARKED ARE UNKNOWN. THE LOCATIONS AND DEPTHS SHOWN ON THE PLAN ARE FROM UTILITY RECORDS. THE CONTRACTOR IS REQUIRED TO TAKE DUE PRECAUTIONARY MEASURES TO LOCATE AND PROTECT ALL UNDERGROUND FACILITIES.
3. CONTRACTOR SHALL RESTORE AT HIS OWN EXPENSE ANY CURB AND GUTTER, OR OTHER IMPROVEMENTS REMOVED OR DAMAGED BY HIS OPERATION.
4. TRENCH BACKFILL AND RESURFACING SHALL BE PER STD. 453. 10" FULL DEPTH AC. SHALL BE USED FOR RESURFACING.
5. PIPE BEDDING SHALL BE PER STD. DWG 452, CASE I. 2500-D SHALL BE USED FOR ALL PIPES.

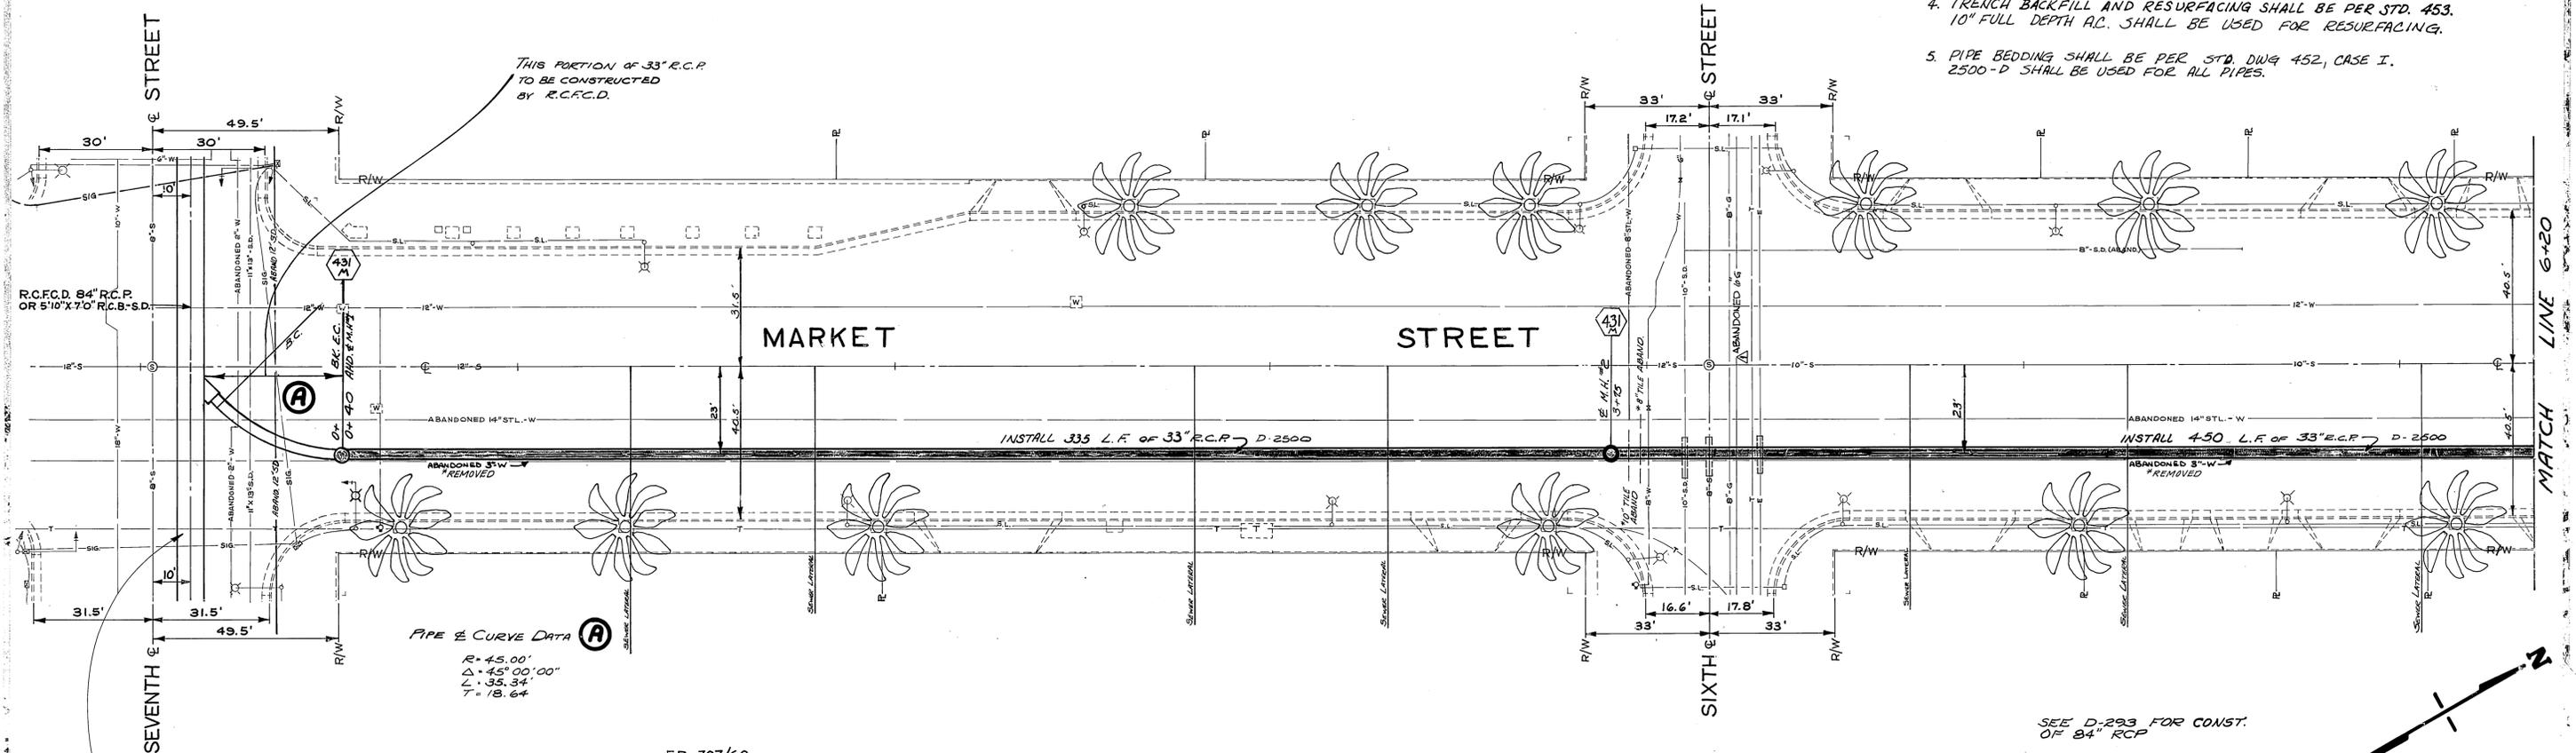

FB 707/60
 ELEV. 846.247
 B.M. PK NAIL IN LEAD ON NLY CB. OF SIXTH ST APPROX. 90' ELY OF E MARKET ST.


-CAUTION-
PACIFIC TELEPHONE
 CABLES UNDERGROUND
 BEFORE EXCAVATING
 CALL COLLECT:
 7:30 A.M. to 5 P.M.
 Orange County 714-633-0811
 Riverside County 714-684-0871

CITY OF DIVERSIDE, CALIFORNIA
 DEPARTMENT OF PUBLIC WORKS
 APPROVED BY
 ENGINEER
 WILLIAM D. ANDERSON
 1/10/73



MARKET STREET
 STORM DRAIN
 FROM SEVENTH ST. TO FOURTH ST.
 ACC. NO. 32-535-498
 DRAWING NO. D-252
 SHEET 0-2

SEE D-293 FOR CONST. OF 84" RCP

*AS BUILT 876 KBT

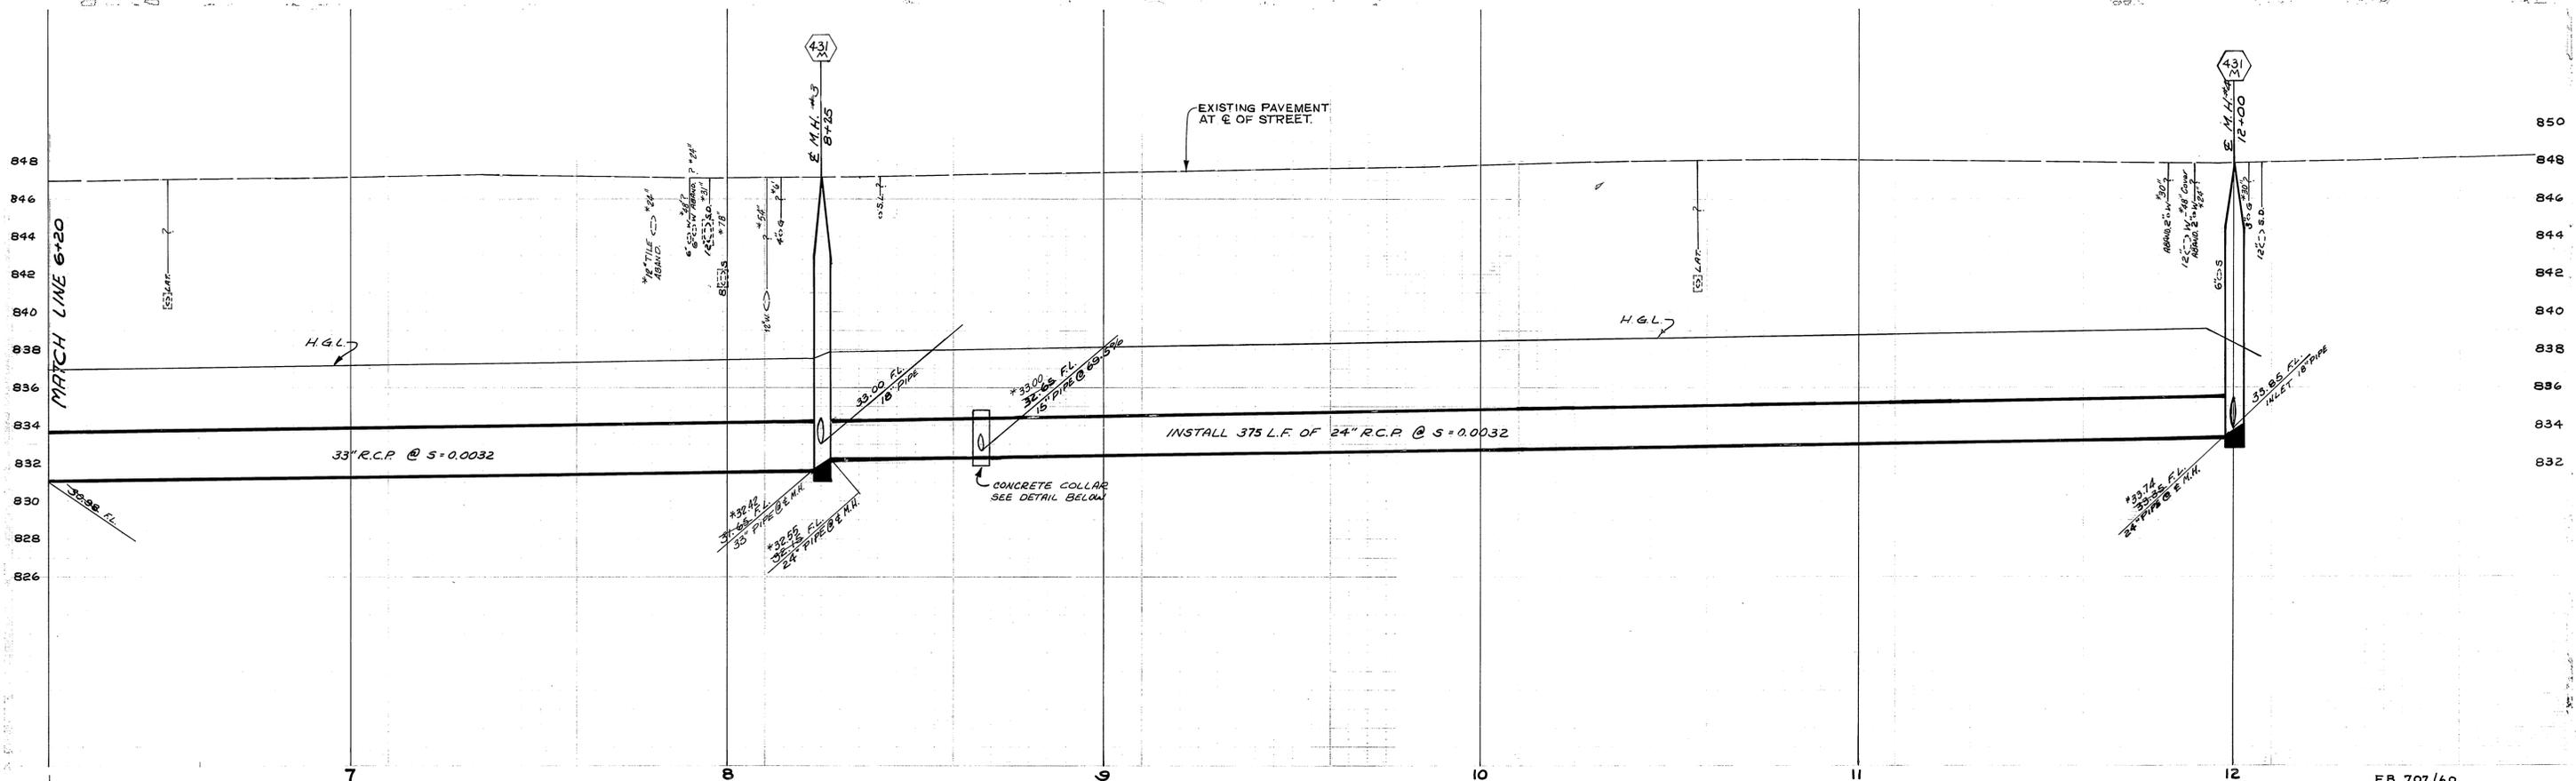

F.B. 707/60
 ELEV. 846.247
 B.M. PK NAIL IN LEAD ON N.E. CORNER OF SIXTH ST. APPROX 90° ELY OF E MARKET ST.

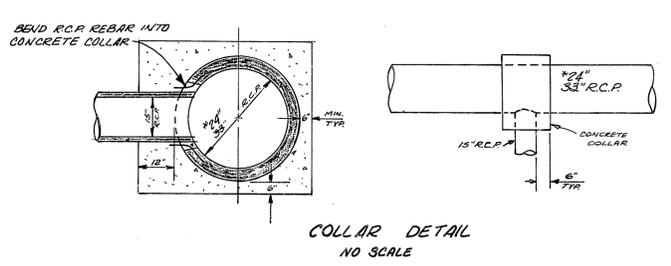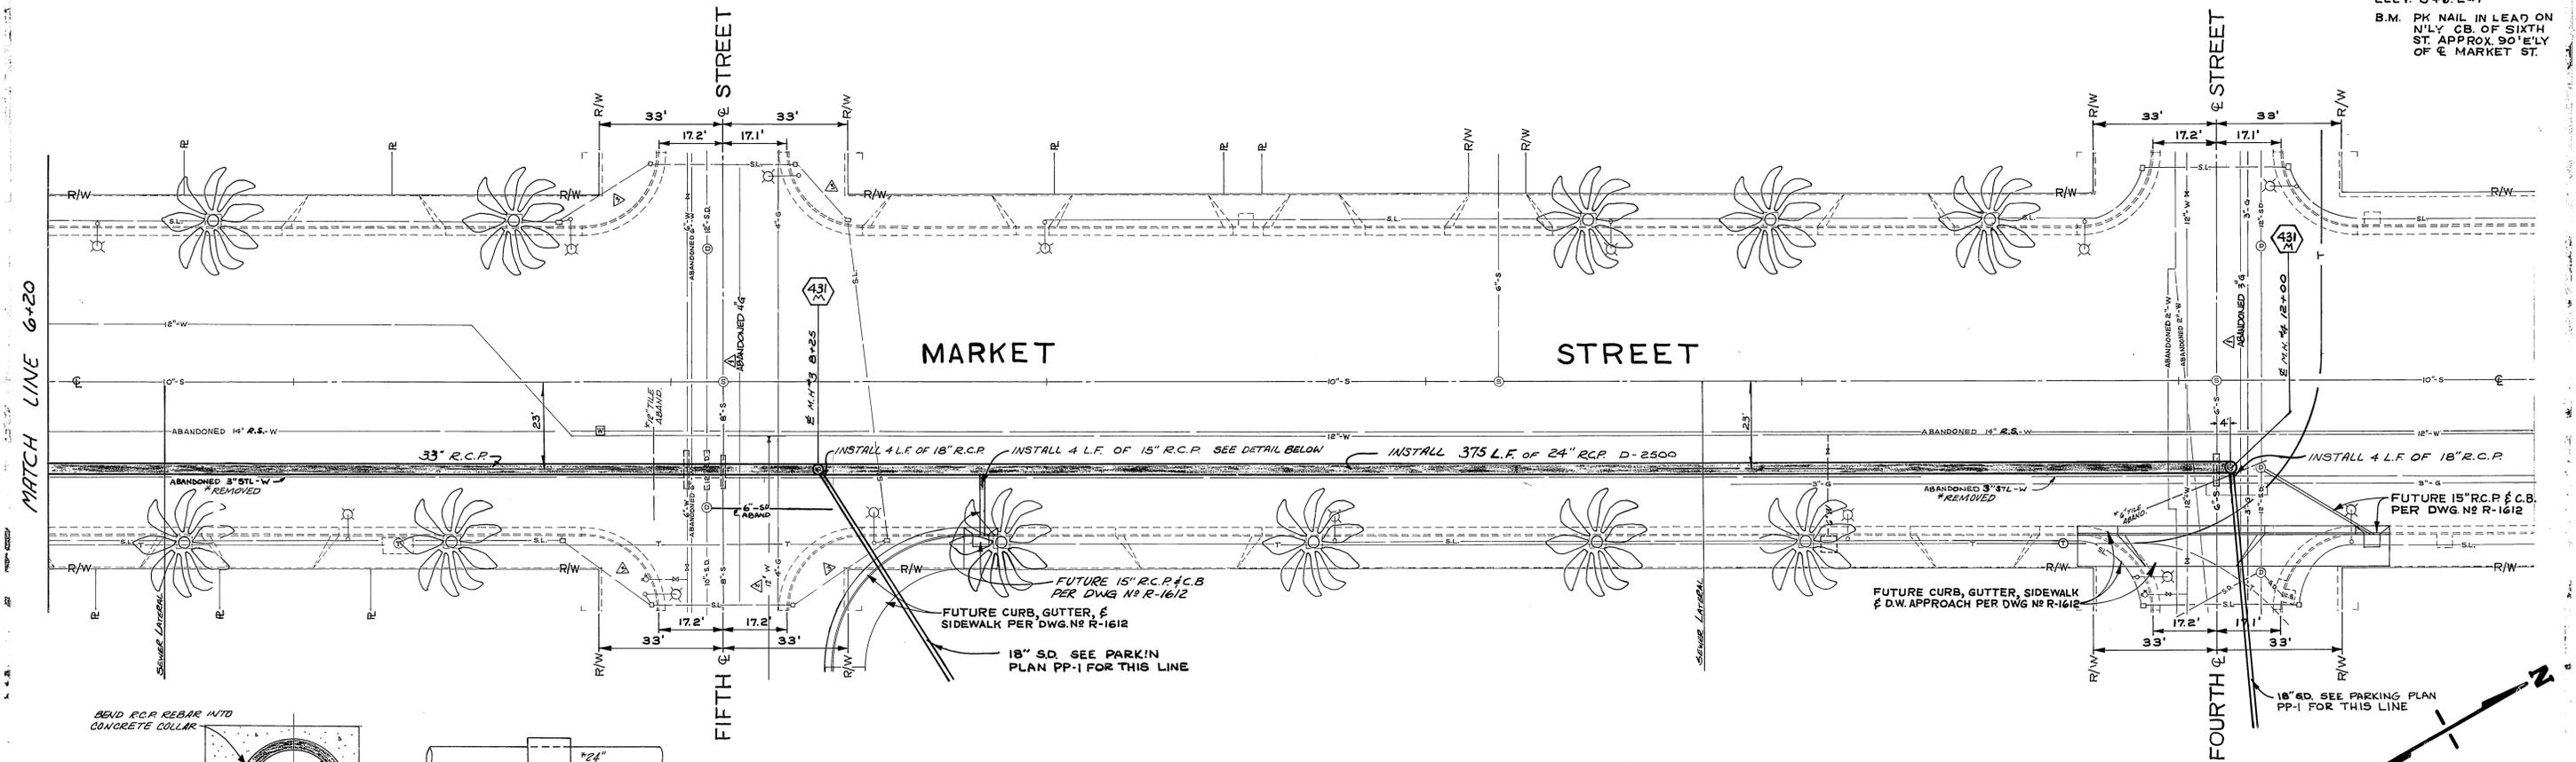

-CAUTION-
PACIFIC TELEPHONE
 CABLES UNDERGROUND
 BEFORE EXCAVATING
 CALL COLLECT:
 7:30 A.M. to 5 P.M.
 After Hours & Holidays
 Orange County 714-633-0811 714-547-8606
 Riverside County 714-681-0071 714-547-0006

REVISED S.L. AT 5TH ST. EX. 11/10/16
 ADDED 12" WATER MAIN AT 5TH ST. EX. 11/10/16
 ADDED ABANDONED GAS LINES EX. 11/10/16
 SJB JRC/RAB
 7/10/17

MARKET STREET
 STORM DRAIN
 FROM SEVENTH ST. TO FOURTH ST.
 ACC. NO. 32-535-498
 DRAWING NO. D-252
 2 - 2