


# RIVERSIDE COUNTY FLOOD CONTROL AND WATER CONSERVATION DISTRICT

## ANZA CHANNEL - STAGE I

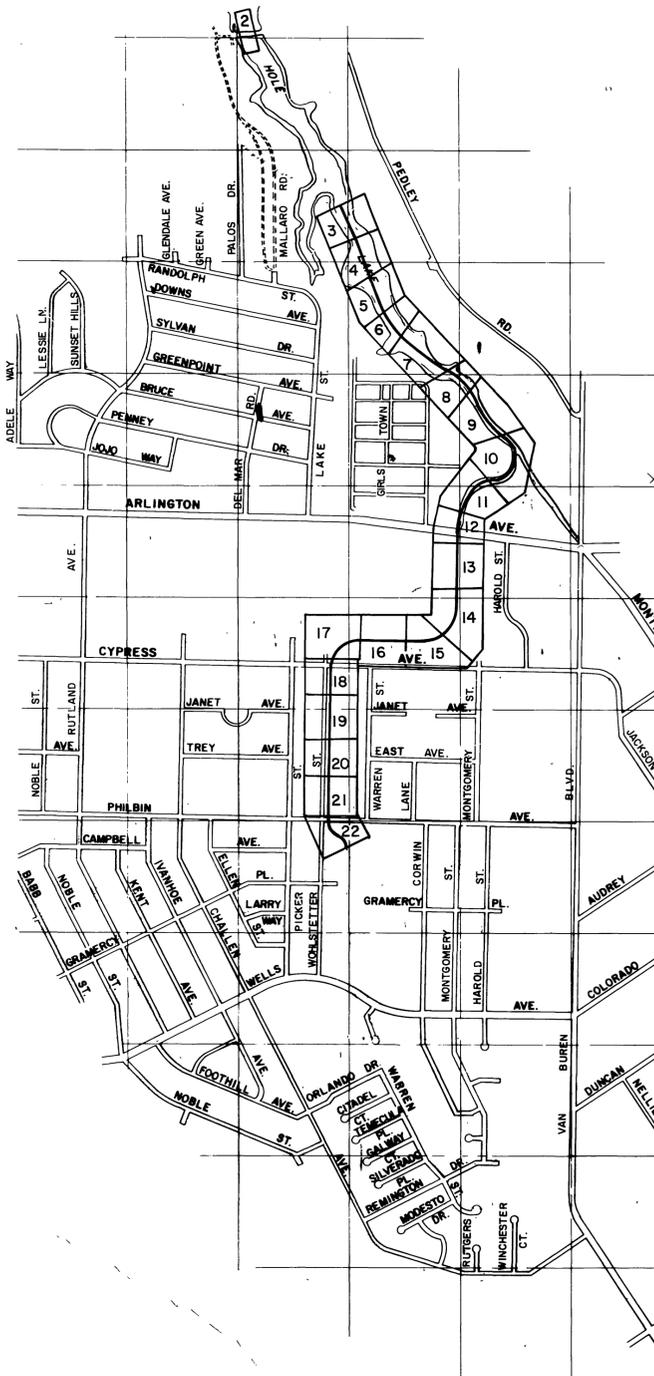

NUMBER	TITLE	SHEET NO.
CB 100	CATCH BASIN NO. 1	35
CB 103	MANHOLE FRAME AND COVER FOR CATCH BASINS	36
CB 105	DETAIL OF CATCH BASIN OPENING	37
LD 201	LOCAL DEPRESSION NO. 2	38
JS 226	JUNCTION STRUCTURE NO. 1	39
JS 228	JUNCTION STRUCTURE NO. 3	40
JS 229	JUNCTION STRUCTURE NO. 4	41
MH 252	MANHOLE NO. 2	42
MH 255	MANHOLE FRAME & COVER, NON-ROCKING	43
MH 257	MANHOLE SHAFT FOR CAST PIPE	44
MH 259	STANDARD DROP STEP	45
CH 327	RECTANGULAR CHANNEL STRUCTURAL DETAILS	46-48
CH 331	MAINTENANCE RAMP FOR VERTICAL WALL CHANNEL	49
BX 401	SINGLE CELL R.C.B. STRUCTURAL DETAILS	50
BX 402	DOUBLE CELL R.C.B. STRUCTURAL DETAILS	51-52
M 801	CHAIN LINK FENCE DETAILS	53
M 802	PIPE BEDDING DETAILS	54
M 803	CONCRETE COLLAR FOR PIPES 12" THROUGH 66"	55
M 805	TIMBER BULKHEADS	56
M 807	SANITARY SEWER PROTECTION	57
M 812	R.C. BOX EXCAVATION & BACKFILL PAY LINES	58
M 813	CURB & GUTTER	59
302	DRIVEWAY APPROACHES	60-62
325	SIDEWALK	63
452	PIPE BEDDING	64-65
453	TRENCH BACKFILL	66-67
500	PRECAST CONCRETE SEWER MANHOLE	68
CWD 030	THRUST BLOCK DETAILS FOR C.I. FITTINGS	69
CWD 320	TYP FLANGED TANGENT OUTLET 4"-12" DIA.	70
CWD 340	TYP THREADED OUTLET (1" - 2 1/2")	71
CWD 405	TYP 6" TANGENT BLOW-OFF	72
CWD 451	TYP 2" AIR VALVE INSTALLATION	73
CWD 500	TYP VALVE BOX FOR GATE VALVE 2"-8"	74
CWD 510	TYP VALVE BOX FOR BUTTERFLY VALVES	75
CWD 515	TYP SPLIT SLEEVE RISER FOR 8" VALVE BOX	76
CWD 810	TYP BLOW-OFF MANHOLE INSTALLATION	77
CWD 900	STANDARD GUARD POST INSTALLATION	78



### CITY OF RIVERSIDE STANDARD DRAWINGS

ABBREVIATIONS	LEGEND
ABND.	ABANDONED
A.C.	ASPHALT CONCRETE
A.C.P.	ASBESTOS CEMENT PIPE
∠ P.T.	ANGLE POINT
B.C.	BEGIN CURVE
B.C.R.	BEGIN CURB RETURN
C.B.	CATCH BASIN
C.I.P.	CAST IRON PIPE
CL	CLASSIFICATION
C.M.P.	CORRUGATED METAL PIPE
CONC.	CONCRETE
COND.	CONDUIT
C.P.	CONTROL POINT
C/R	CITY OF RIVERSIDE
DWY.	DRIVEWAY
E.C.	END CURVE
E.C.R.	END CURB RETURN
EL.	ELEVATION
F.L.	FLOW LINE
G.C.	GRADE CHANGE
H.G.L.	HYDRAULIC GRADE LINE
J.S.	JUNCTION STRUCTURE
L	LENGTH
L.D.	LOCAL DEPRESSION
M.H.	MANHOLE
P.C.C.	PORTLAND CEMENT CONCRETE
P.R.C.	POINT OF REVERSE CURVE
R	RADIUS
R.C.B.	REINFORCED CONCRETE BOX
R.C.P.	REINFORCED CONCRETE PIPE
S.B.	SOIL BORING
S.D.	STORM DRAIN
SHT.	SHEET
STA.	STATION
T	TANGENT LENGTH
T.C.	TOP OF CURB
T.S.	TRANSITION STRUCTURE
R/W	RIGHT OF WAY
EXIST.	EXISTING
T.C.E.	TEMPORARY CONSTRUCTION EASEMENT
MOD	MODIFIED

LEGEND
ANCHOR & POLE
BUILDING
BURIED TELEPHONE CABLE
CATCH BASIN
CONCRETE GUTTER
CONTROL LINE
CULVERT WITH HEADWALLS
CURB FACE
DRIVEWAY
EXISTING FLOW LINE
FENCE (OTHER THAN CHAIN LINK)
FENCE (EXISTING CHAIN LINK)
FENCE (CHAIN LINK TO BE CONST)
FIRE ALARM CONDUIT
FIRE HYDRANT
GAS LINE
GAS METER
IRRIGATION LINE
JUNCTION STRUCTURE NO. 1 & 2
MANHOLE COVER (STORM DRAIN)
MANHOLE (SEWER)
MTD, MCD TELEPHONE
T.C.E. LINE
PARKWAY
SIDEWALK
PROPERTY LINE
ELECTRICAL LINE
SANITARY SEWER LINE
SIGN
SOIL BORING
STORM DRAIN LINE (EXISTING)
STREET LIGHT
STREET LIGHT STANDARD
STREET LIGHT UNDERGROUND
STREET RIGHT OF WAY
TELEPHONE OR POWER POLE
TRAFFIC LIGHT (OVERHEAD)
TRAFFIC LOOP
TRAFFIC SIGNAL CONDUIT
TREE
WALL (BLOCK OR MASONRY)
WATER LINE
WATER METER
WATER VALVE
REINFORCED CONCRETE BOX
RECTANGULAR CONCRETE CHANNEL
INDICATES FUTURE CONSTRUCTION
LIMITS OF GRADING
SPRINKLER HEAD
IRRIGATION CONTROL VALVE


### GENERAL NOTES

- TIES FOR CATCH BASINS AS SHOWN ON THE DRAWINGS ARE FROM CURB RETURN TO CENTER LINE OF CATCH BASIN, UNLESS OTHERWISE SHOWN. WHERE NO TIE IS SHOWN L.D. SHALL BEGIN AT CURB RETURN.
- "V" IS THE DEPTH OF INLET OF CATCH BASINS IN SERIES MEASURED FROM TOP OF CURB TO INVERT OF CONNECTOR PIPE.
- ALL RESURFACING, CURBS, GUTTERS, SIDEWALKS, DRIVEWAYS AND OTHER EXISTING IMPROVEMENTS TO BE RECONSTRUCTED SHALL BE CONSTRUCTED AT THE SAME ELEVATION AND LOCATION AS THE EXISTING IMPROVEMENTS, UNLESS OTHERWISE NOTED.
- STREET RESURFACING SHALL BE 3" A.C. ON 6" CLASS 3 AGGREGATE BASE, UNLESS OTHERWISE SHOWN.
- CHANNEL ACCESS ROAD SHALL BE UNPAVED.
- ALL OPENINGS RESULTING FROM CUTTING OR PARTIAL REMOVAL OF EXISTING CULVERTS, PIPES OR SIMILAR STRUCTURES SHALL BE SEALED WITH 8" OF CLASS "B" CONCRETE, NOTED ON THE DRAWINGS AS "PLUG".
- PIPE CONNECTIONS TO MAIN LINE SHALL CONFORM TO STANDARD DRAWINGS J.S. NO. 3 OR J.S. NO. 4, UNLESS OTHERWISE SHOWN.
- CENTER WALLS OF ALL DOUBLE BOXES SHALL BE ROUNDED PER PIER END DETAIL SHEET NO. 26.
- THE REINFORCEMENT FOR THE ACCESS RAMP WALLS AND SLAB SHALL BE THE SAME AS THE STRUCTURAL SECTION NOTED ON THE PLAN. THE THICKNESS OF THE RAMP SHALL BE 9". THE REINFORCING OF THE CHANNEL WALL SHALL BE BENT INTO THE RAMP SLAB.

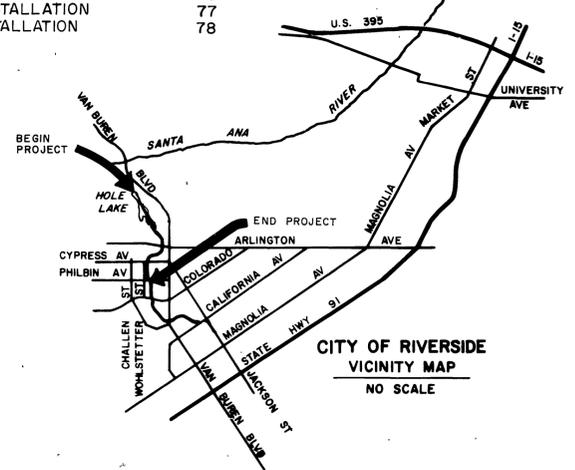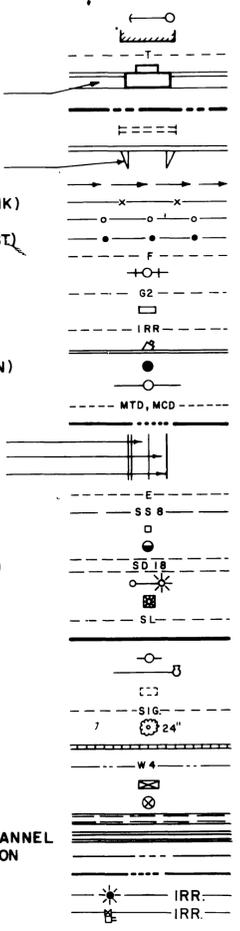



### DRAWING INDEX

TITLE	SHEET NO.
TITLE SHEET, LOCATION MAP, LEGEND & DRAWING INDEX	1
HOLE DAM CULVERT, PLAN & PROFILE	2
MONROE CHANNEL PLAN & PROFILE	3-9
ANZA CHANNEL PLAN & PROFILE	10-22
CONNECTOR PIPE PROFILES	23-24
JUNCTION CHAMBER & SPECIAL JUNCTION STRUCTURE	25
MISCELLANEOUS STRUCTURAL DETAILS	26-27
ACCESS BRIDGE	28
SEWER RELOCATION	29
WATER LINE RELOCATION	30
HOLE DAM ACCESS ROADS	31
ACCESS ROAD CROSS SECTIONS	32
ARLINGTON AVENUE TRAFFIC PLAN	33-34

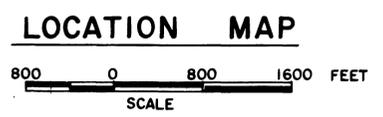


BENCH MARK	APPROVED BY <b>ALDERMAN SWIFT &amp; LEWIS</b> REGISTERED CIVIL ENGINEER NO. 11843	DATE <i>April 24, 1974</i>	REVISIONS	RIVERSIDE COUNTY FLOOD CONTROL AND WATER CONSERVATION DISTRICT	DESIGNED BY: G.L.H. DRAWN BY: E.C.H. DATE DRAWN: OCT. 1973	APPROVED BY: <i>John H. Bussant</i> CHIEF ENGINEER R.E. NO. 8822	DATE: <i>3-4-75</i>	ANZA CHANNEL STAGE I TITLE SHEET	PROJECT NO. 1-0-150 DRAWING NO. 1-302 SHEET NO. 1 OF 78
SCALE:	DATE:		REF.	CHECKED BY: G.L.H.	1970 STORM DRAIN BOND ISSUE PROJECT NO. 18				

AS BUILT

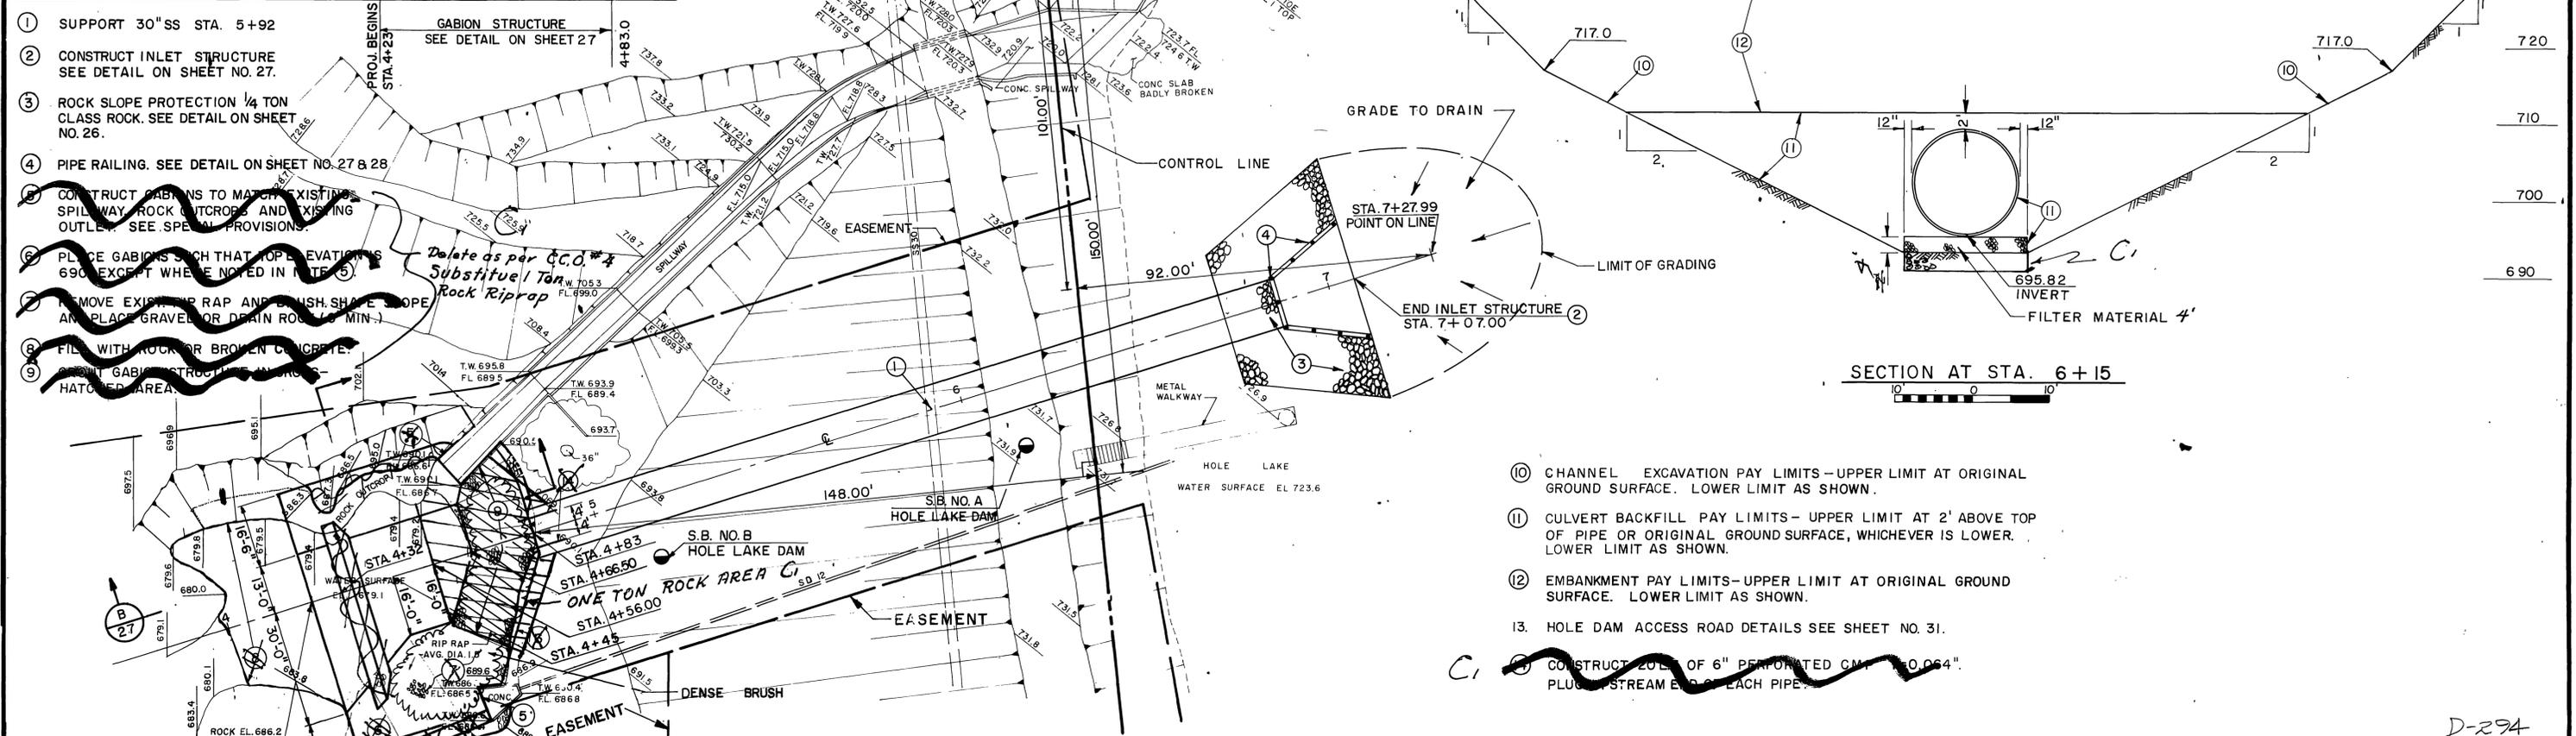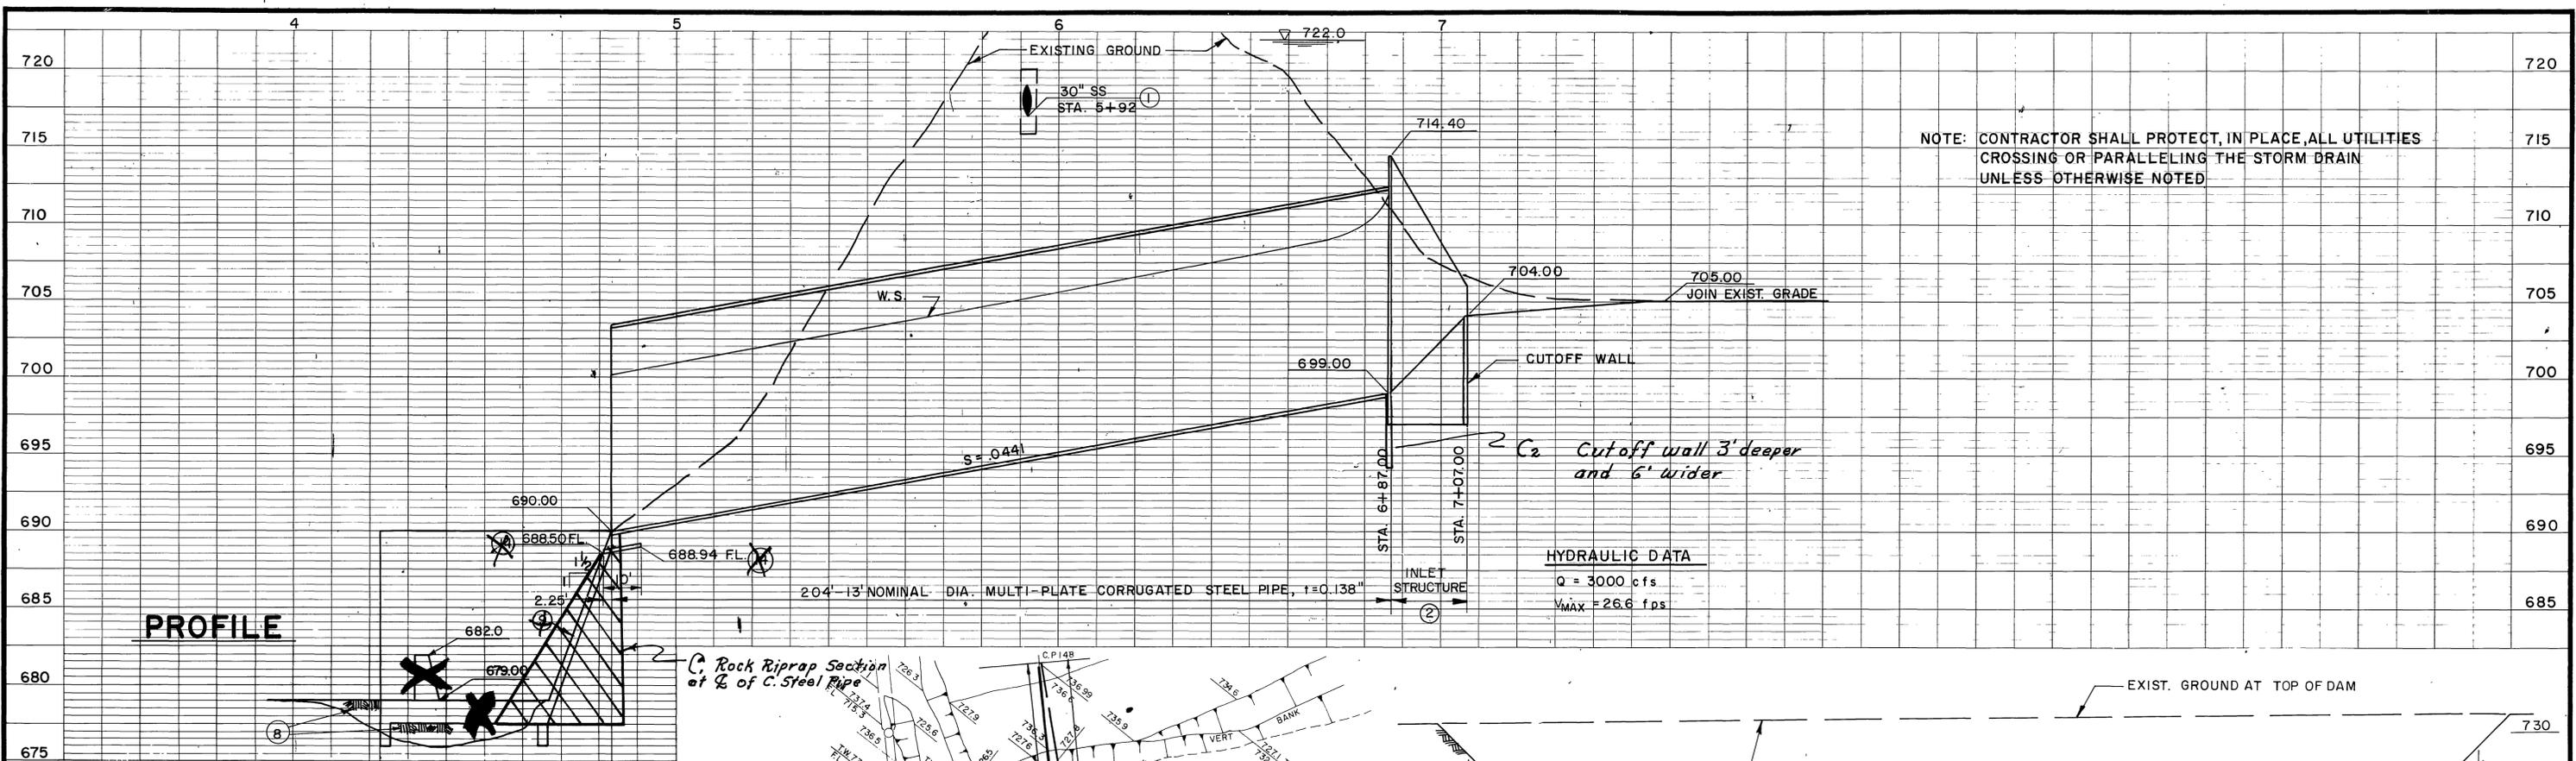

- 1 SUPPORT 30" SS STA. 5+92
- 2 CONSTRUCT INLET STRUCTURE SEE DETAIL ON SHEET NO. 27.
- 3 ROCK SLOPE PROTECTION 1/4 TON CLASS ROCK. SEE DETAIL ON SHEET NO. 26.
- 4 PIPE RAILING. SEE DETAIL ON SHEET NO. 27 & 28.
- 5 CONSTRUCT GABIONS TO MATCH EXISTING SPILLWAY ROCK OUTCROPS AND EXISTING OUTLET. SEE SPECIAL PROVISIONS.
- 6 PLACE GABIONS SUCH THAT TOP ELEVATIONS 690' EXCEPT WHERE NOTED IN NOTE (5).
- 7 REMOVE EXISTING RIP RAP AND FINISH SLOPE AND PLACE GRAVEL OR DRAIN ROCK (1" MIN.).
- 8 FILL WITH ROCK OR BROKEN CONCRETE.
- 9 GABION STRUCTURE ALONG HATCHED AREA.

- 10 CHANNEL EXCAVATION PAY LIMITS - UPPER LIMIT AT ORIGINAL GROUND SURFACE. LOWER LIMIT AS SHOWN.
- 11 CULVERT BACKFILL PAY LIMITS - UPPER LIMIT AT 2' ABOVE TOP OF PIPE OR ORIGINAL GROUND SURFACE, WHICHEVER IS LOWER. LOWER LIMIT AS SHOWN.
- 12 EMBANKMENT PAY LIMITS - UPPER LIMIT AT ORIGINAL GROUND SURFACE. LOWER LIMIT AS SHOWN.
- 13 HOLE DAM ACCESS ROAD DETAILS SEE SHEET NO. 31.

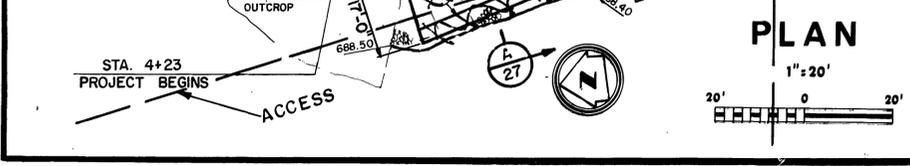

BENCH MARK C.P. 148  
3/4" I.P., R.C.E. 9876 ON  
EASTERLY SIDE OF DAM  
ELEV. 736.99  
SCALE:  
DATE:

APPROVED BY  
DATE *April 24, 1974*  
**AS**  
ALDERMAN  
SWIFT  
& LEWIS  
CONSULTING  
ENGINEERS  
REGISTERED CIVIL ENGINEER  
NO. 11943




NO.	DESCRIPTION	DATE	APPR. DATE
C2	CC #2 Change Cutoff Wall	11/11/73	6/7/74
C1	CCO #4 170N Rock	11/11/73	6/7/74

RIVERSIDE COUNTY FLOOD CONTROL  
AND  
WATER CONSERVATION DISTRICT  
DESIGNED BY: T.V.P. & AGK.  
APPROVED BY:  
DRAWN BY: R.D.F. & SLM.  
DATE DRAWN: OCT. 1973  
DATE: 9-4-75  
CHECKER BY: W.D.L., G.L.H.

ANZA CHANNEL  
STAGE I  
HOLE DAM CULVERT  
STA. 4+23 TO STA. 7+07  
1970 STORM DRAIN BOND ISSUE PROJECT NO. 18

PROJECT NO.  
1-0-150  
DRAWING NO.  
1-302  
SHEET NO.  
2 OF 78

AS BUILT

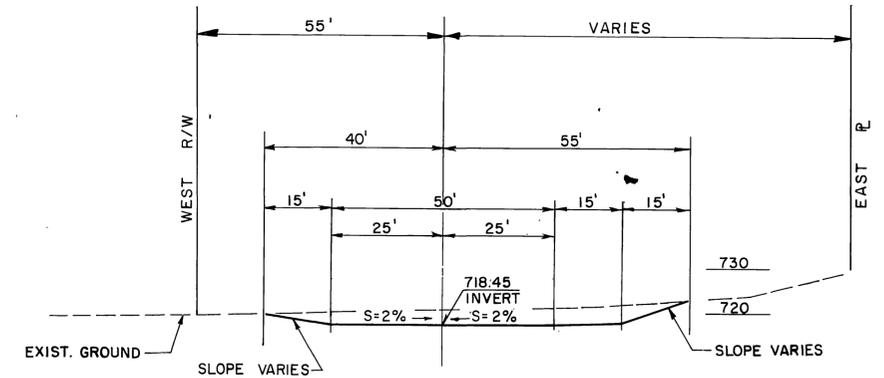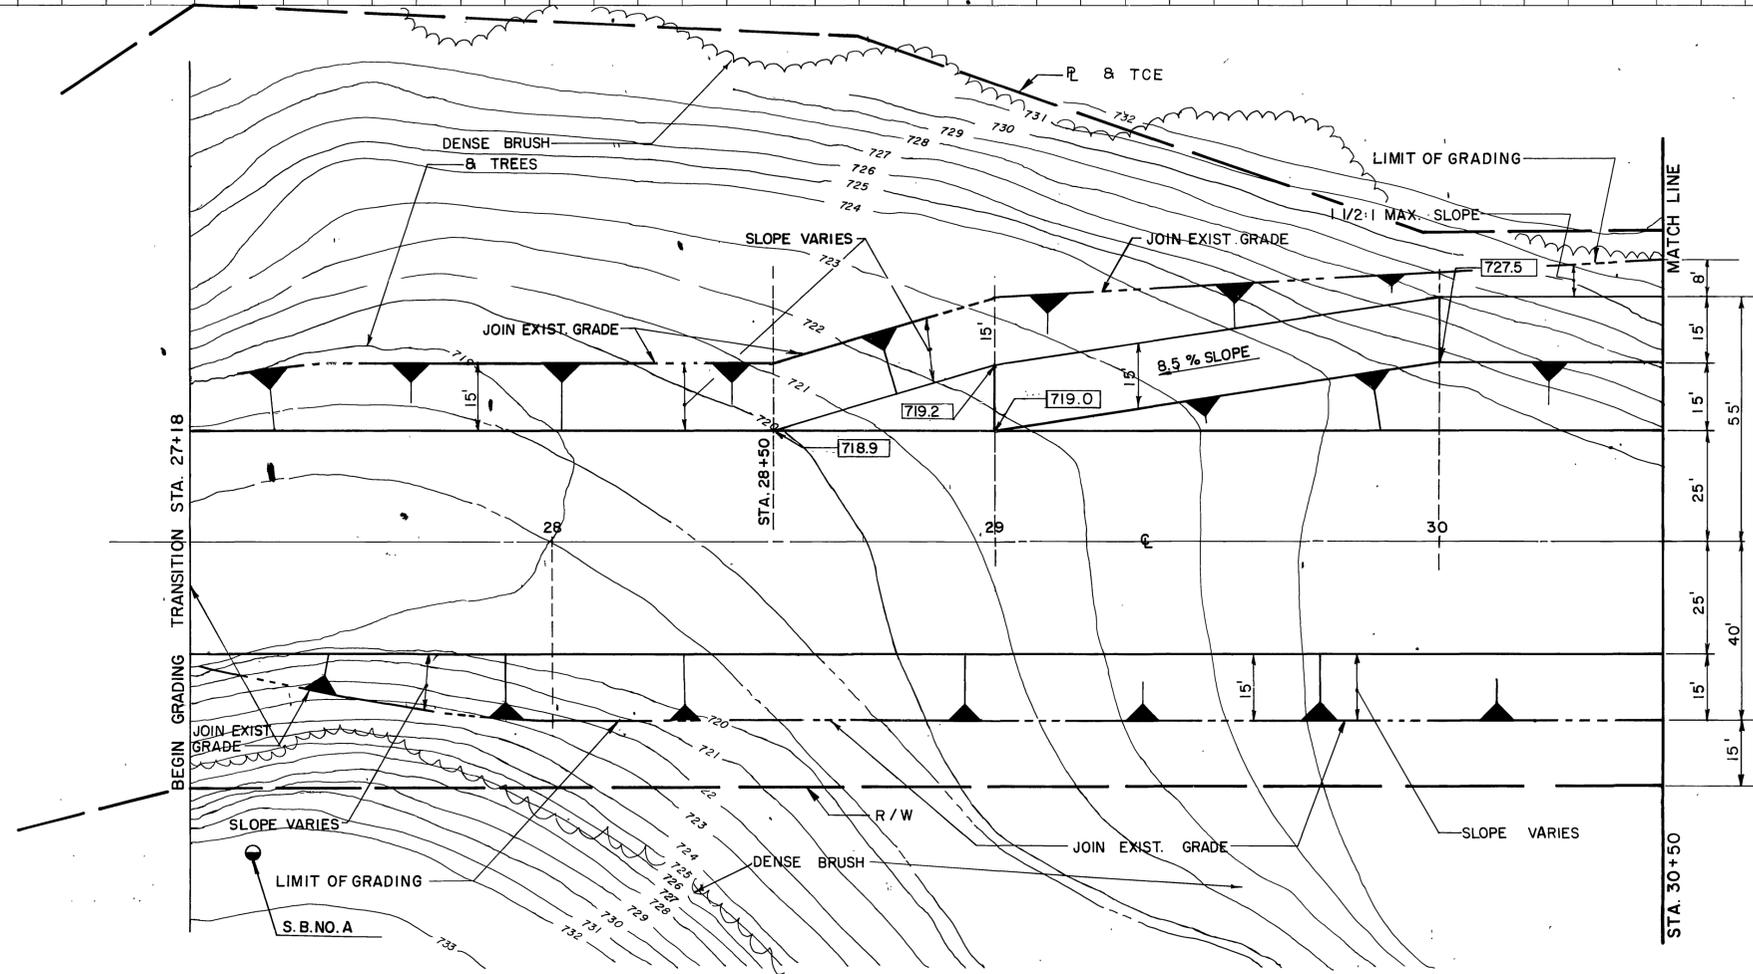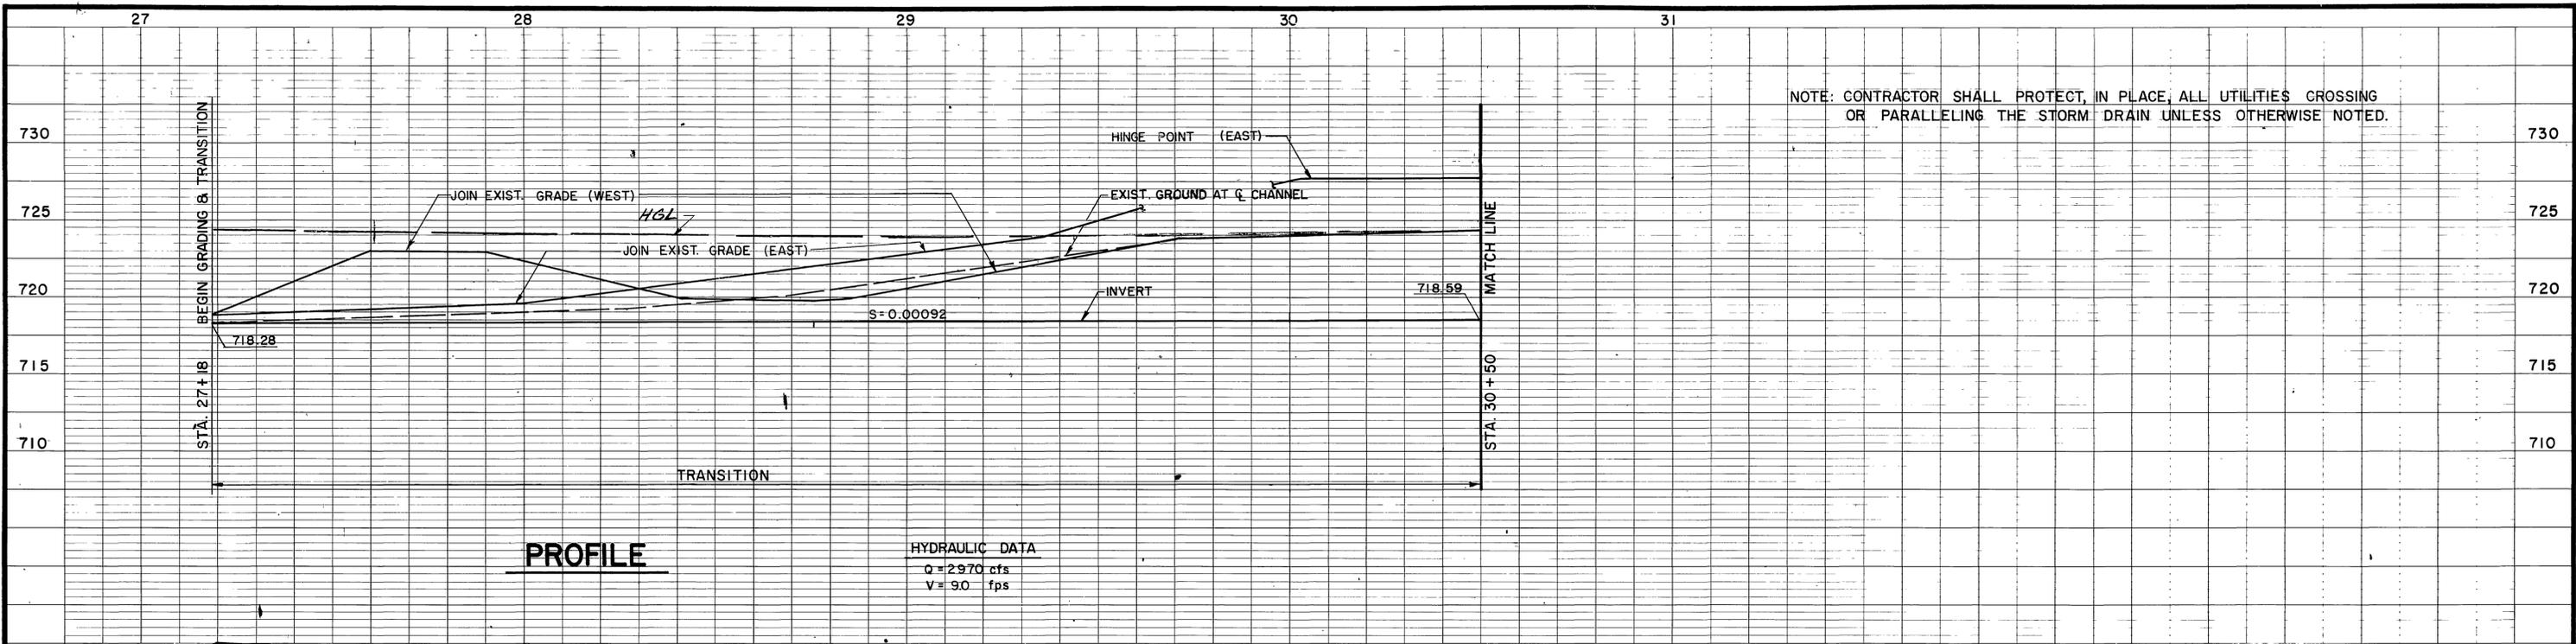

BENCH MARK C.P. 144  
 1 X 2 HUB ON SURVEY CONTROL  
 LINE  
 ELEV. 737.35  
 SCALE:  
 DATE:

**AS**  
 ALDERMAN  
 SWIFT  
 & LEWIS  
 CONSULTING  
 ENGINEERS  
 REGISTERED CIVIL ENGINEER  
 NO. 11543

APPROVED BY  
 DATE April 24, 1974  
 [Signature]

REF.	DESCRIPTION	APPR. DATE
	No Change	

RIVERSIDE COUNTY FLOOD CONTROL  
 AND  
 WATER CONSERVATION DISTRICT

DESIGNED BY: K.E.K.  
 DRAWN BY: A.W.S.  
 DATE DRAWN: OCT 1973  
 CHECKED BY: R.D.C., G.L.H.



APPROVED BY:  
 [Signature]  
 CIVIL ENGINEER R.P. NO. 8822  
 DATE 3-4-75

**ANZA CHANNEL**  
 STAGE I  
 MONROE CHANNEL  
 STA. 27+18 TO STA. 30+50  
 1970 STORM DRAIN BOND ISSUE PROJECT NO. 18

PROJECT NO  
 1-0-150  
 DRAWING NO.  
 1-302  
 SHEET NO  
 3 OF 78

**AS BUILT**



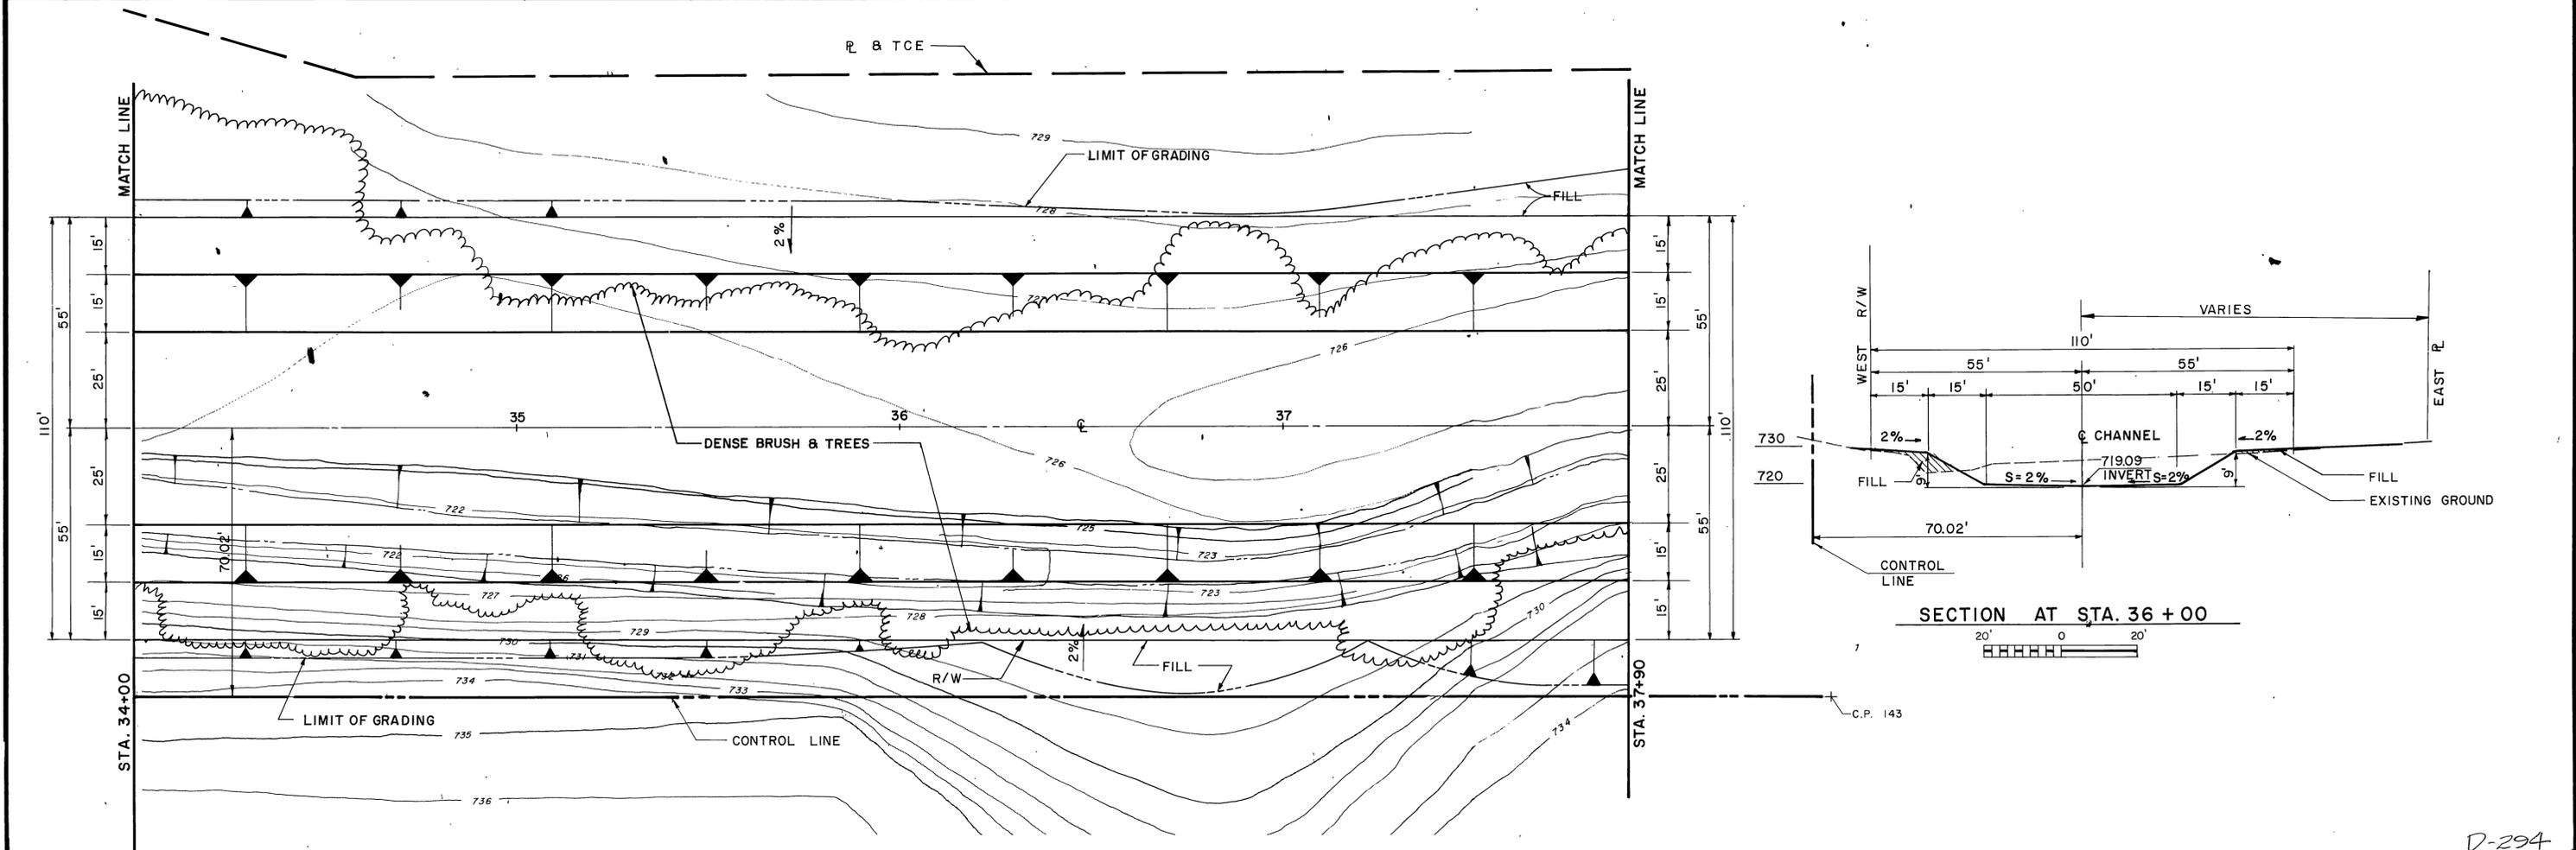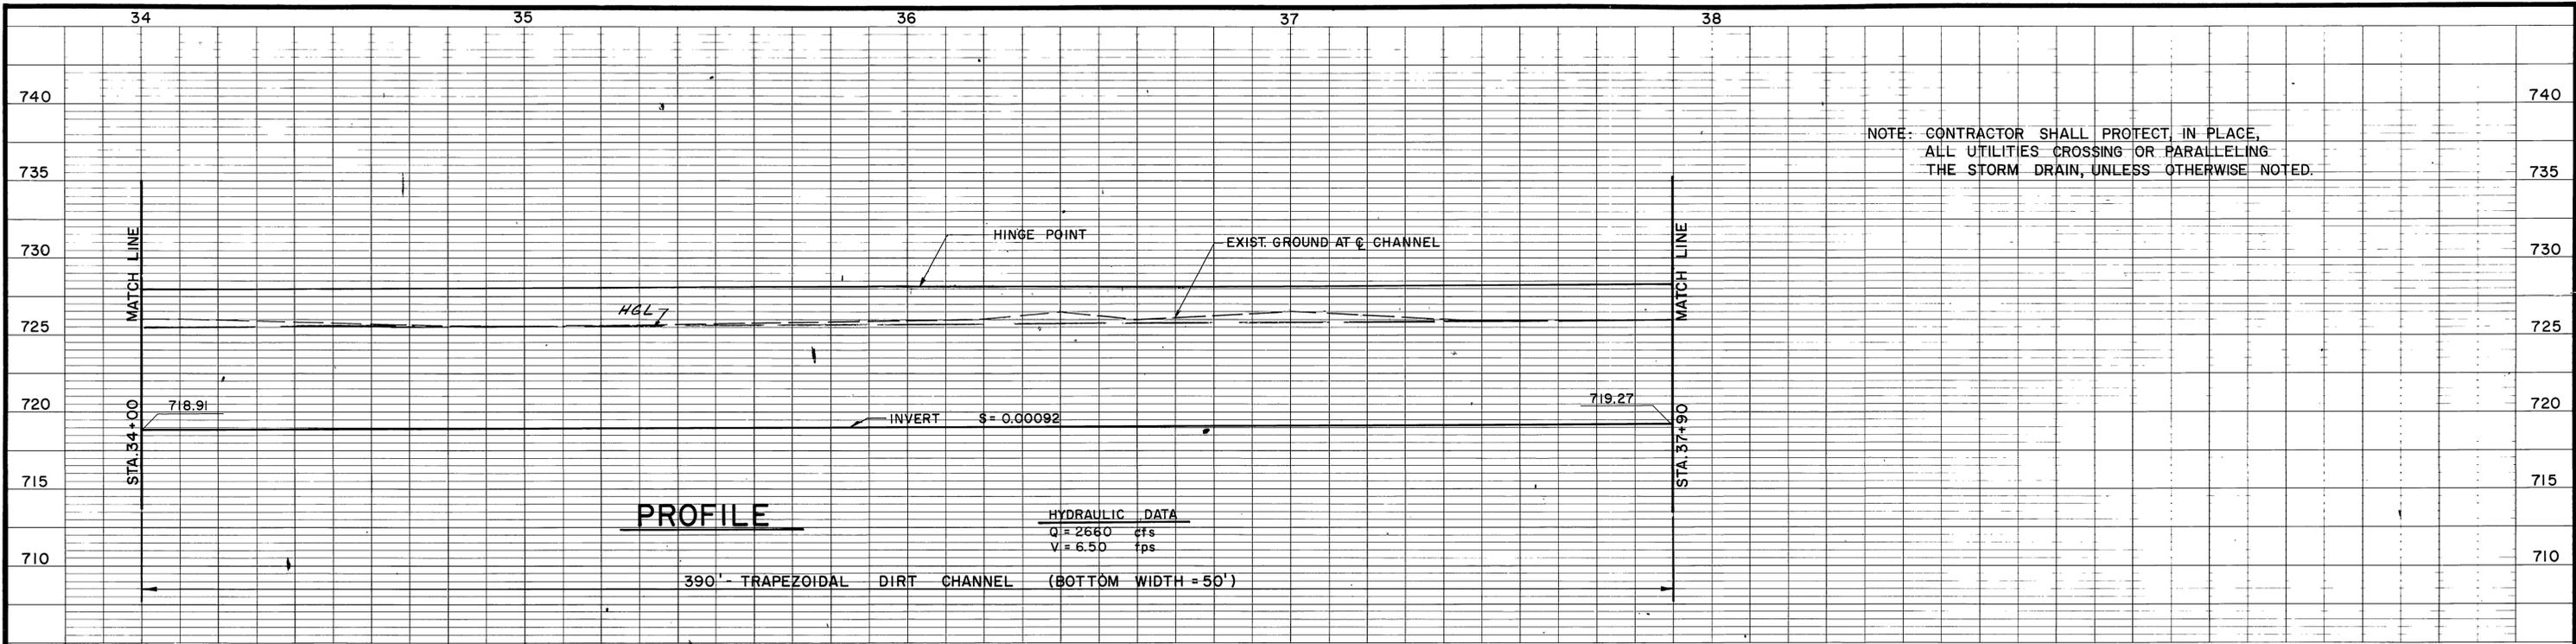

**PLAN**  
 1" = 20'  
 20' 0 20'

BENCH MARK C.P. 143  
 1X2 HUB ON SURVEY CONTROL  
 LINE ELEV. 734.37  
 SCALE:  
 DATE:

**AS**  
 ALDERMAN  
 SWIFT  
 & LEWIS  
 CONSULTING  
 ENGINEERS  
 REGISTERED CIVIL ENGINEER  
 NO. 11848

APPROVED BY  
 DATE April 24, 1974

REF.	DESCRIPTION	APPR. DATE
	No Change	

**RIVERSIDE COUNTY FLOOD CONTROL AND WATER CONSERVATION DISTRICT**




DESIGNED BY: T.V.R.  
 DRAWN BY: J.A.C.  
 DATE DRAWN: OCT. 1973  
 CHECKED BY: R.D.G., G.L.H.

APPROVED BY:  
 DATE: 4-23-74

**ANZA CHANNEL  
 STAGE I  
 MONROE CHANNEL  
 STA. 34+00 TO STA. 37+90  
 1970 STORM DRAIN BOND ISSUE PROJECT NO. 18**


PROJECT NO. 1-0-150  
 DRAWING NO. 1-302  
 SHEET NO. 5 OF 78

**AS BUILT**

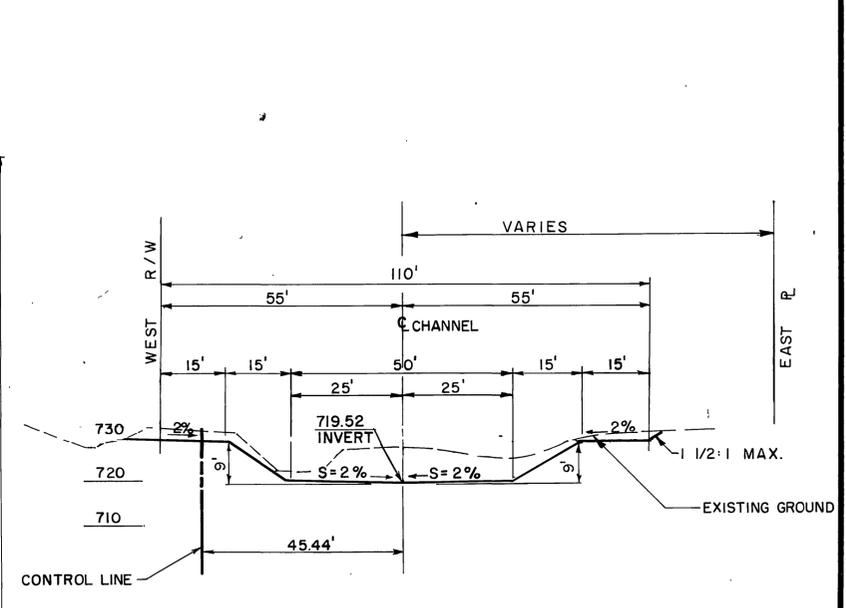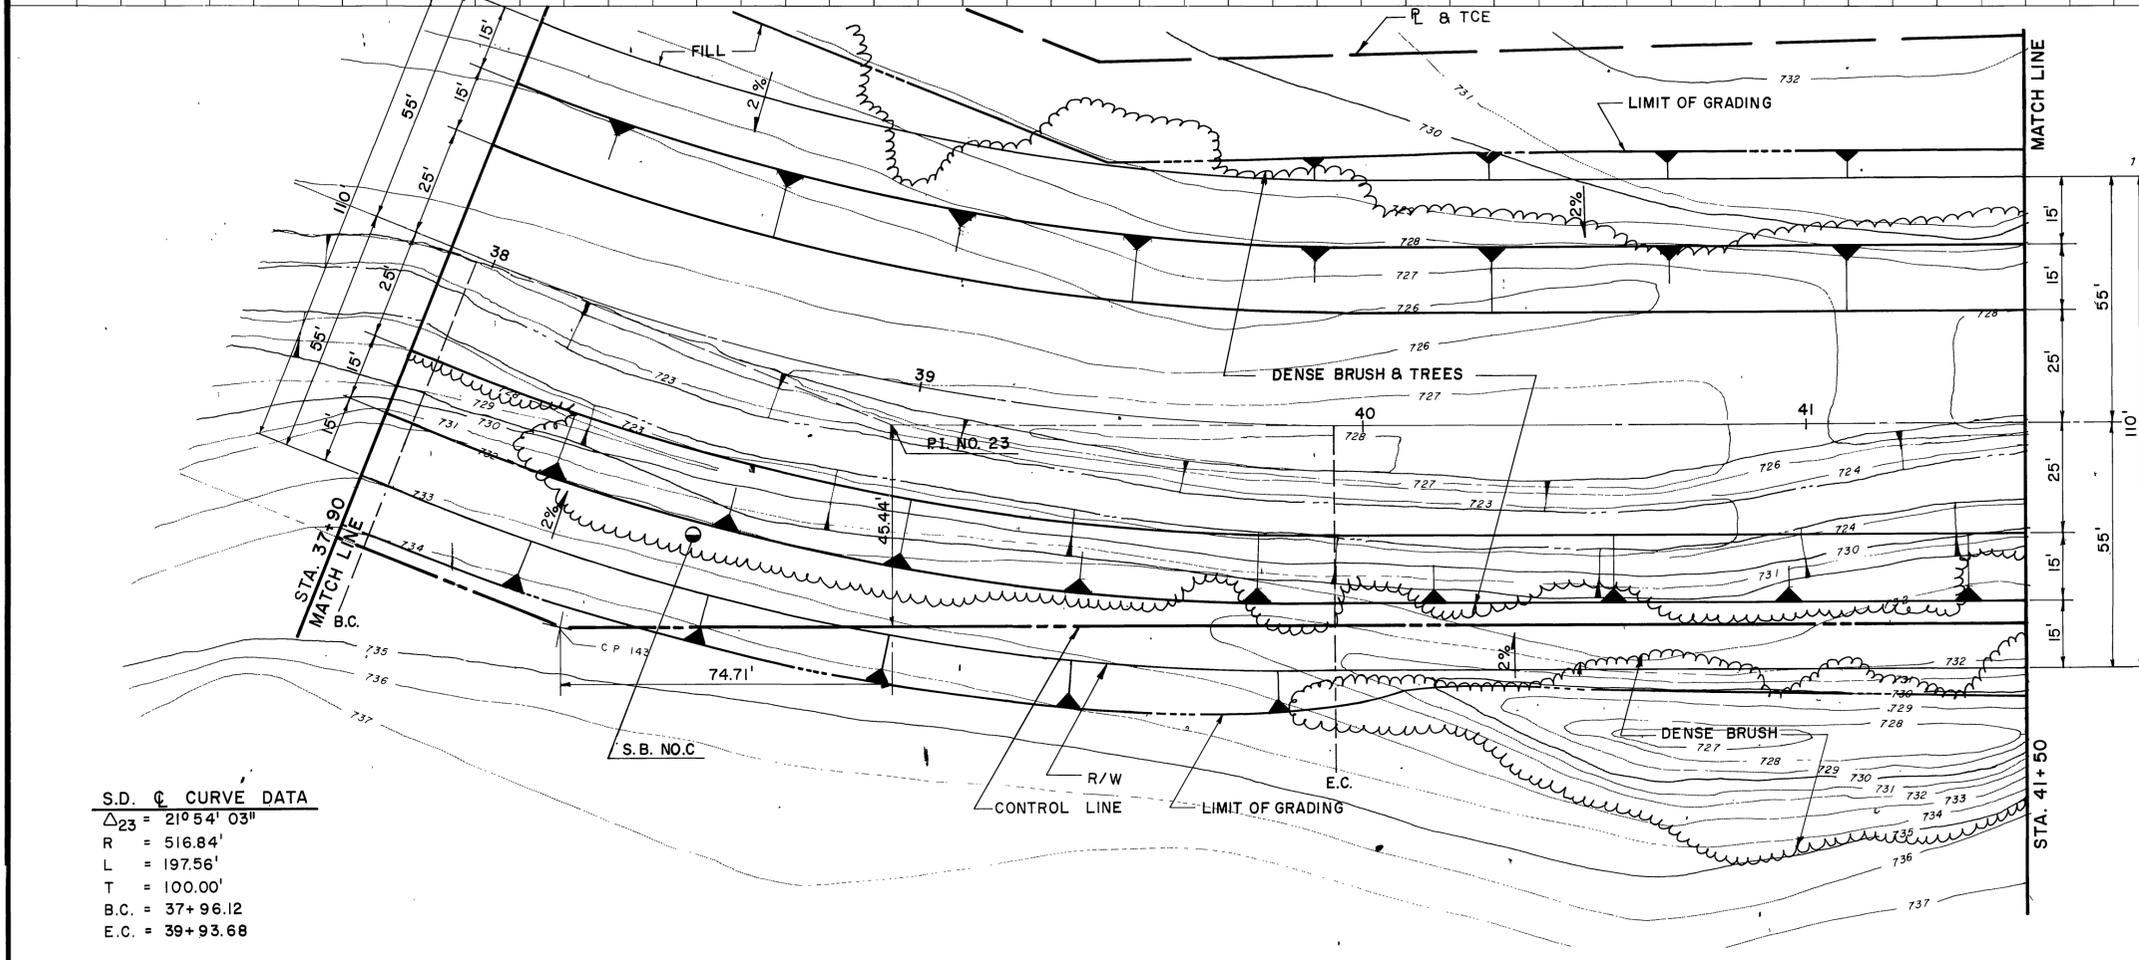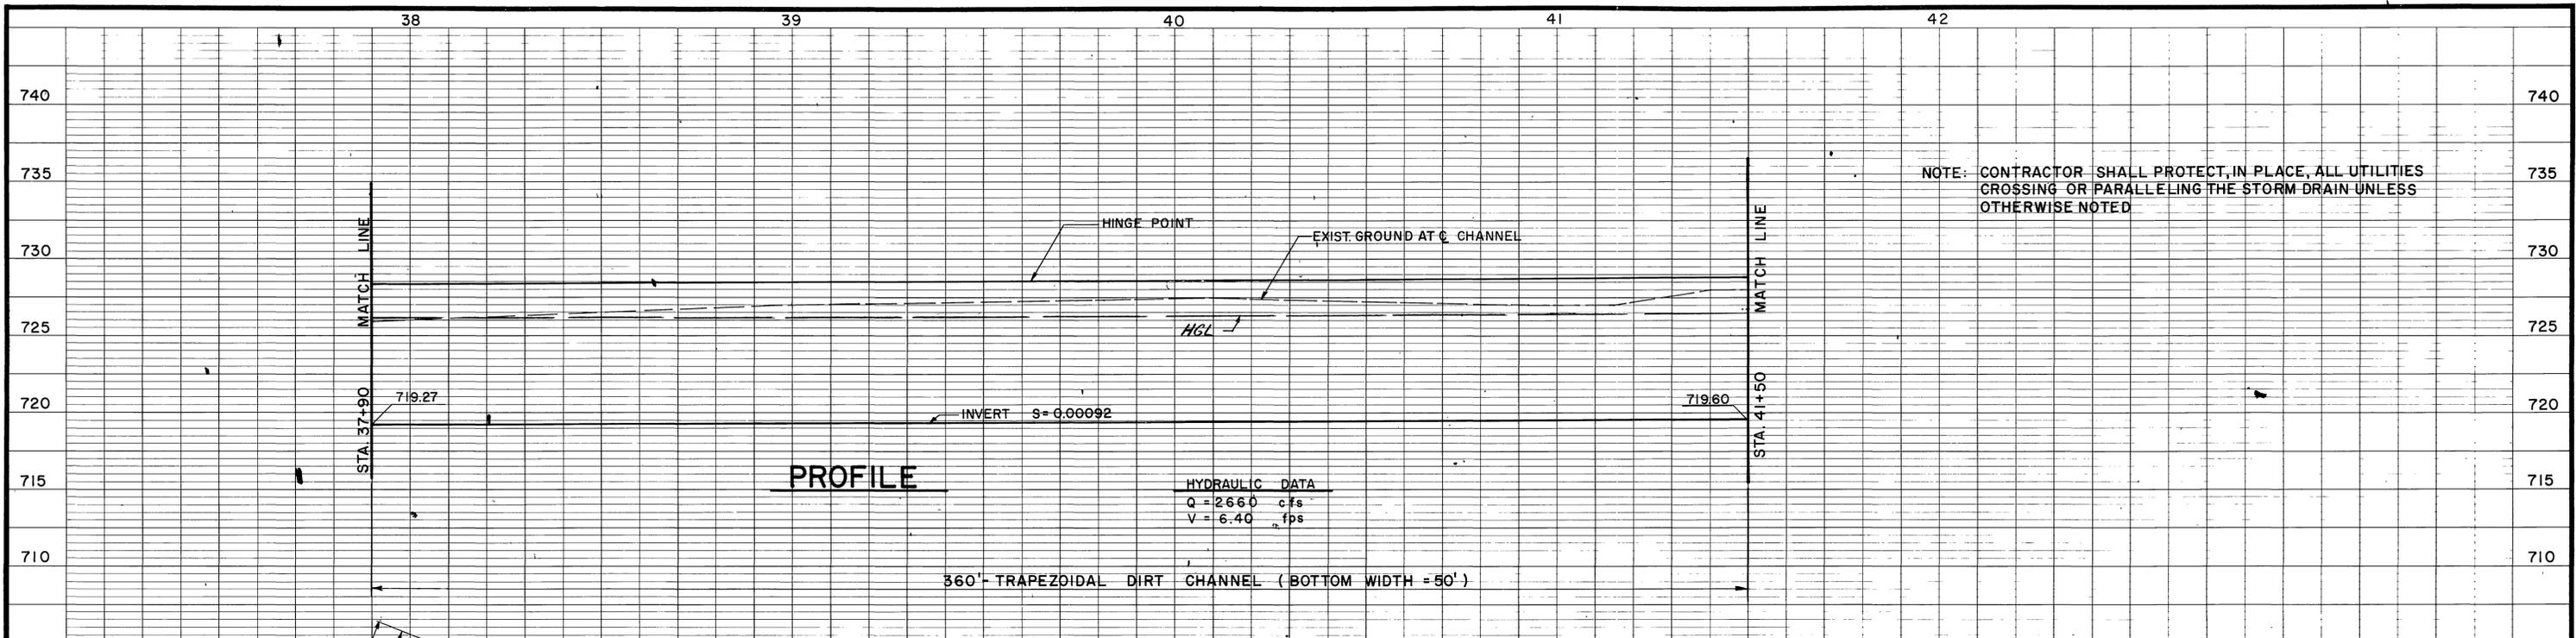

S.D. C. CURVE DATA

$\Delta_{23} = 21^{\circ}54'03''$
R = 516.84'
L = 197.56'
T = 100.00'
B.C. = 37+96.12
E.C. = 39+93.68

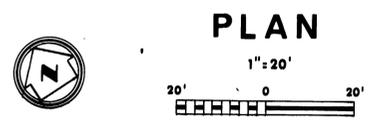

BENCH MARK C.P. 143  
1X2 HUB ON SURVEY CONTROL  
LINE ELEV. 734.37  
SCALE:  
DATE:

APPROVED BY  
DATE *April 22, 1974*  
**AS**  
ALDERMAN  
SWIFT  
& LEWIS  
CONSULTING  
ENGINEERS  
REGISTERED CIVIL ENGINEER  
NO. 14843



REF.	DESCRIPTION	APPR.	DATE
	No Change		

REVISIONS  
RIVERSIDE COUNTY FLOOD CONTROL  
AND  
WATER CONSERVATION DISTRICT  
DESIGNED BY: T.V.R.  
DRAWN BY: J.A.C.  
DATE DRAWN: OCT, 1973  
CHECKED BY: R.D.C., G.L.H.  
APPROVED BY:  
DATE: *3-4-75*  
CHIEF ENGINEER R.E. NO. 8822

ANZA CHANNEL  
STAGE I  
MONROE CHANNEL  
STA. 37+90 TO STA. 41+50  
1970 STORM DRAIN BOND ISSUE PROJECT NO. 18


PROJECT NO.  
1-0-150  
DRAWING NO.  
1-302  
SHEET NO.  
6 OF 78

AS BUILT

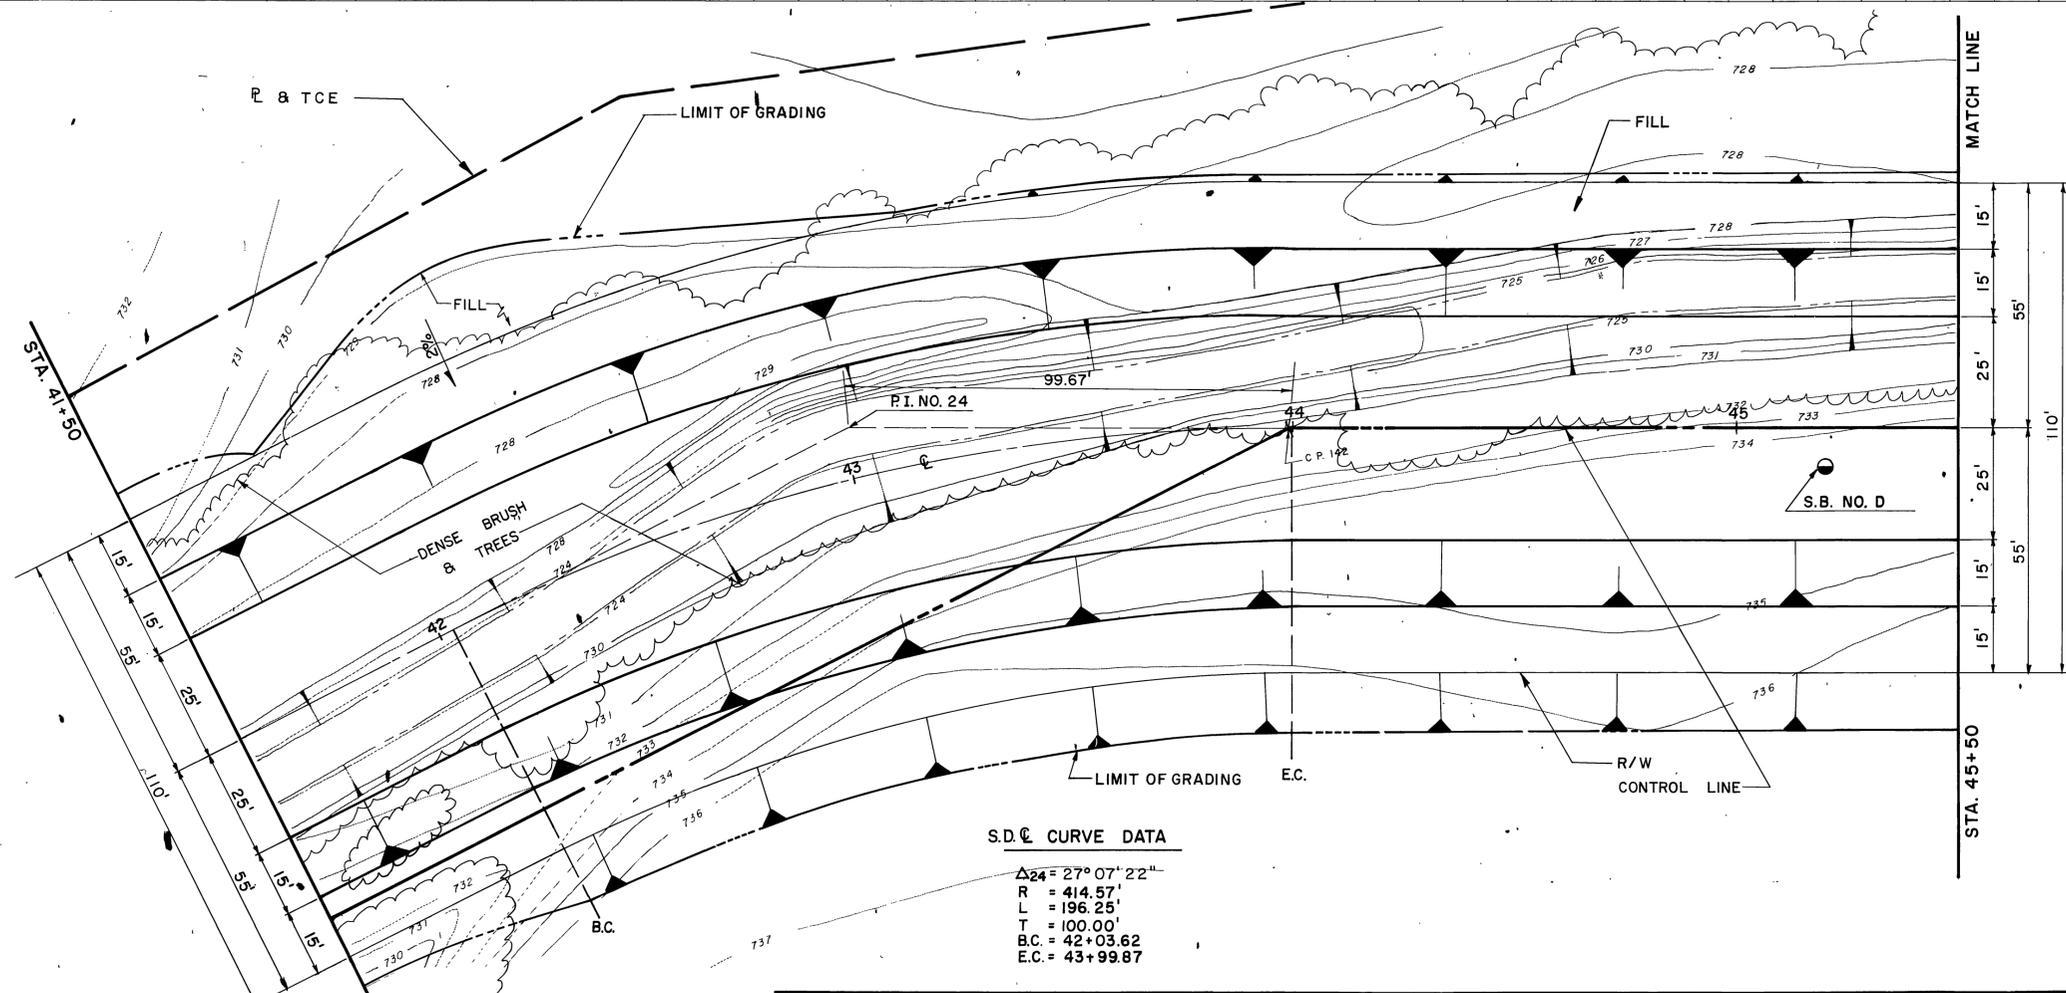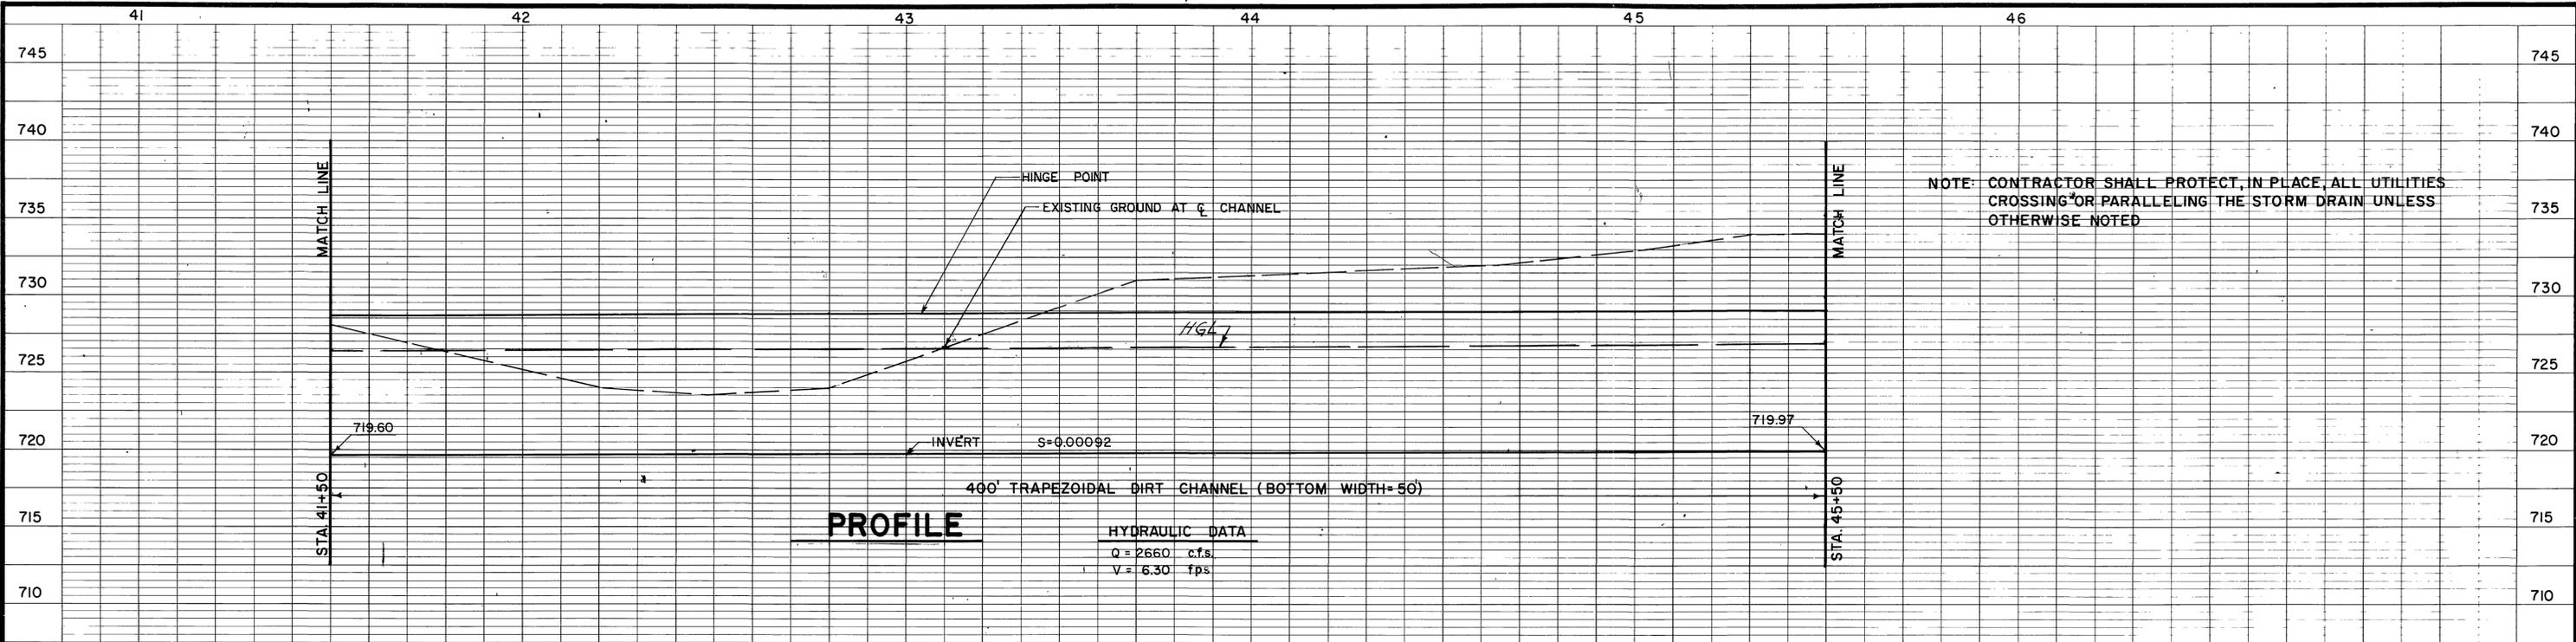

**S.D. CURVE DATA**

$\Delta_{24} = 27^{\circ} 07' 22''$
R = 414.57'
L = 196.25'
T = 100.00'
B.C. = 42+03.62
E.C. = 43+99.87

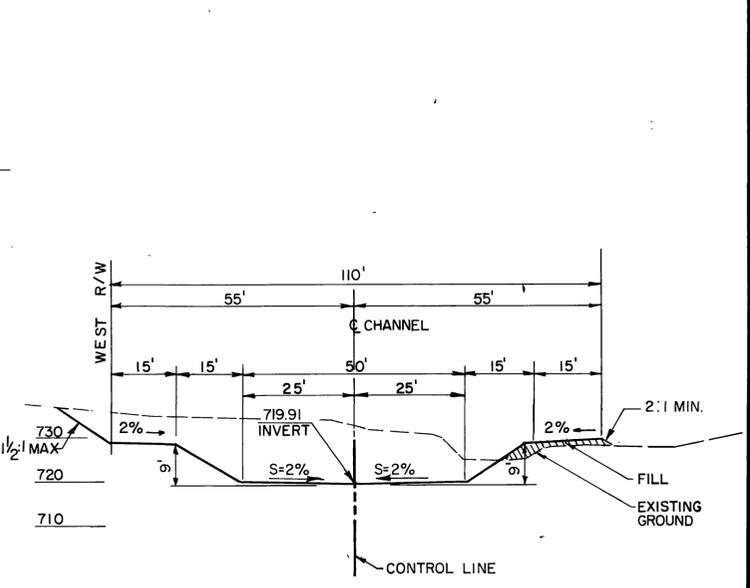

BENCH MARK C.P. 142  
 1x2 HUB ON SURVEY CONTROL  
 LINE  
 ELEV. 731.39  
 SCALE:  
 DATE:

APPROVED BY  
 DATE *April 26, 1974*  
**AS**  
 ALDERMAN  
 SWIFT  
 & LEWIS  
 CONSULTING  
 ENGINEERS  
 REGISTERED CIVIL ENGINEER  
 NO. 11843

REVISIONS
DESCRIPTION
No Change

RIVERSIDE COUNTY FLOOD CONTROL  
 AND  
 WATER CONSERVATION DISTRICT


DESIGNED BY: T.V.P.  
 DRAWN BY: J.A.C.  
 DATE DRAWN: OCT. 1973  
 CHECKED BY: R.D.C., G.L.H.

APPROVED BY:  
*John W. Boyard*  
 CHIEF ENGINEER R.E. NO. 8822  
 DATE: *3-14-75*

ANZA CHANNEL  
 STAGE I  
 MONROE CHANNEL  
 STA. 41+50 TO STA. 45+50  
 1970 STORM DRAIN BOND ISSUE PROJECT NO. 18

PROJECT NO.  
 1-0-150  
 DRAWING NO.  
 1-302  
 SHEET NO.  
 7 OF 78



AS BUILT

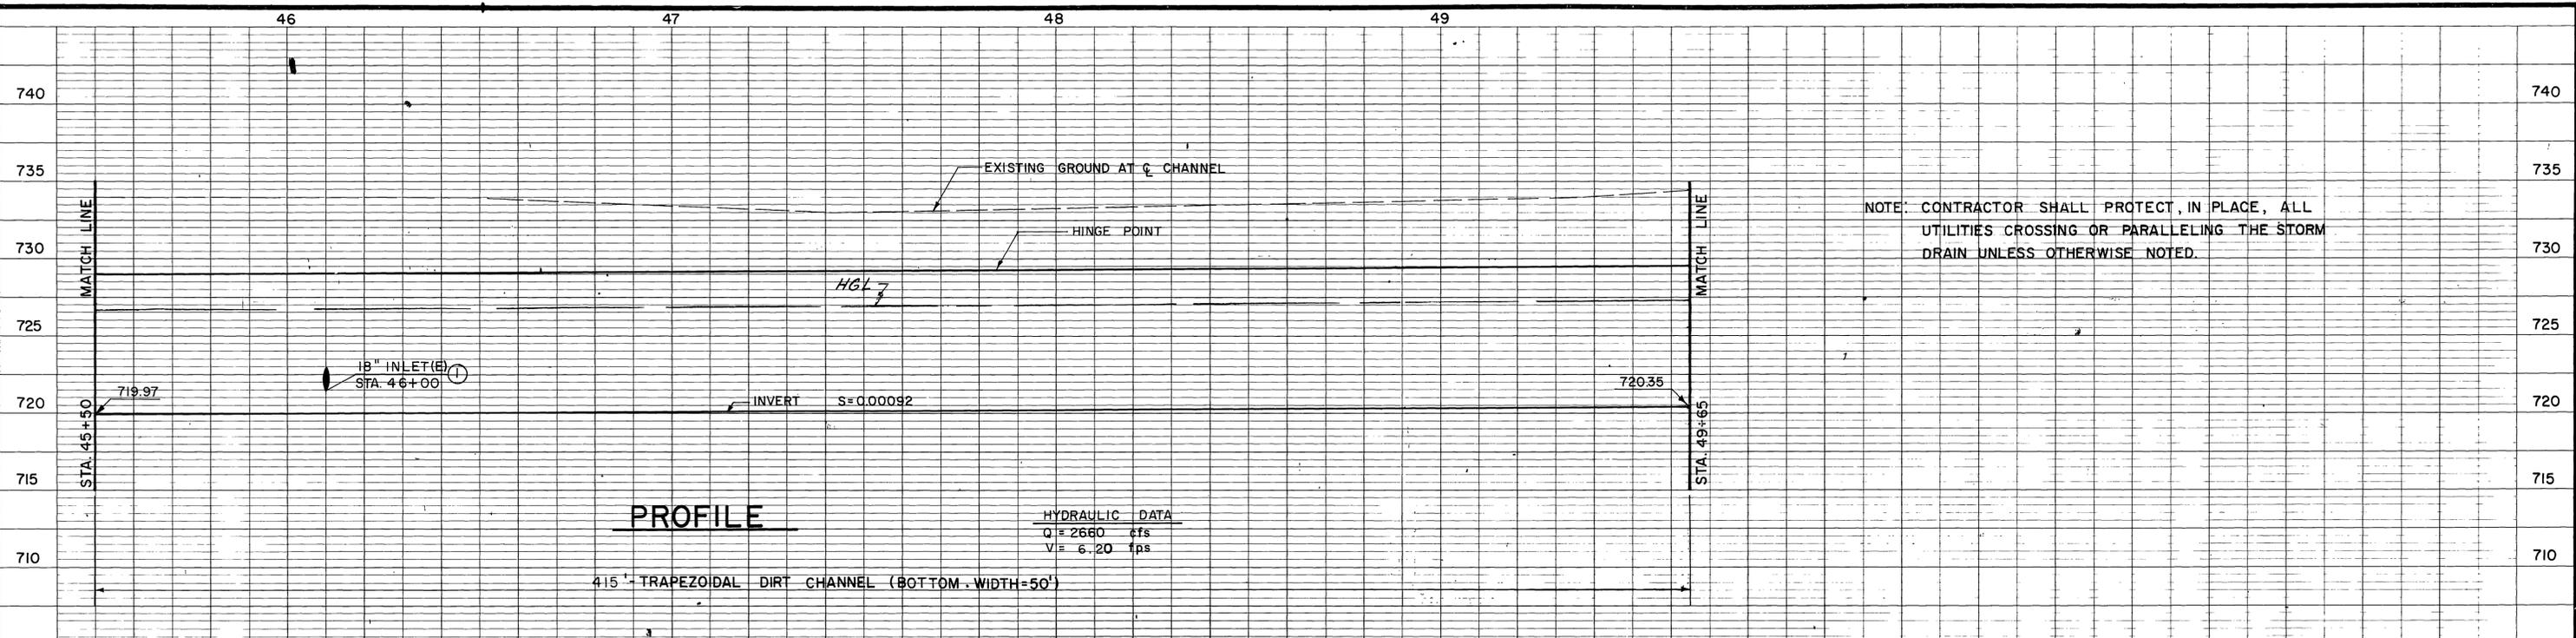


NOTE: CONTRACTOR SHALL PROTECT, IN PLACE, ALL UTILITIES CROSSING OR PARALLELING THE STORM DRAIN UNLESS OTHERWISE NOTED.

HYDRAULIC DATA  
 Q = 2660 cfs  
 V = 6.20 fps

415' TRAPEZOIDAL DIRT CHANNEL (BOTTOM WIDTH=50')

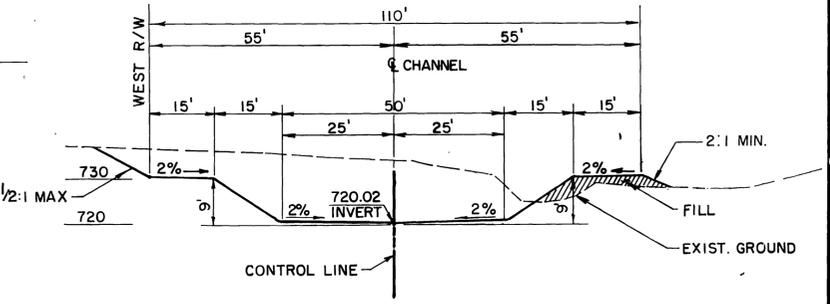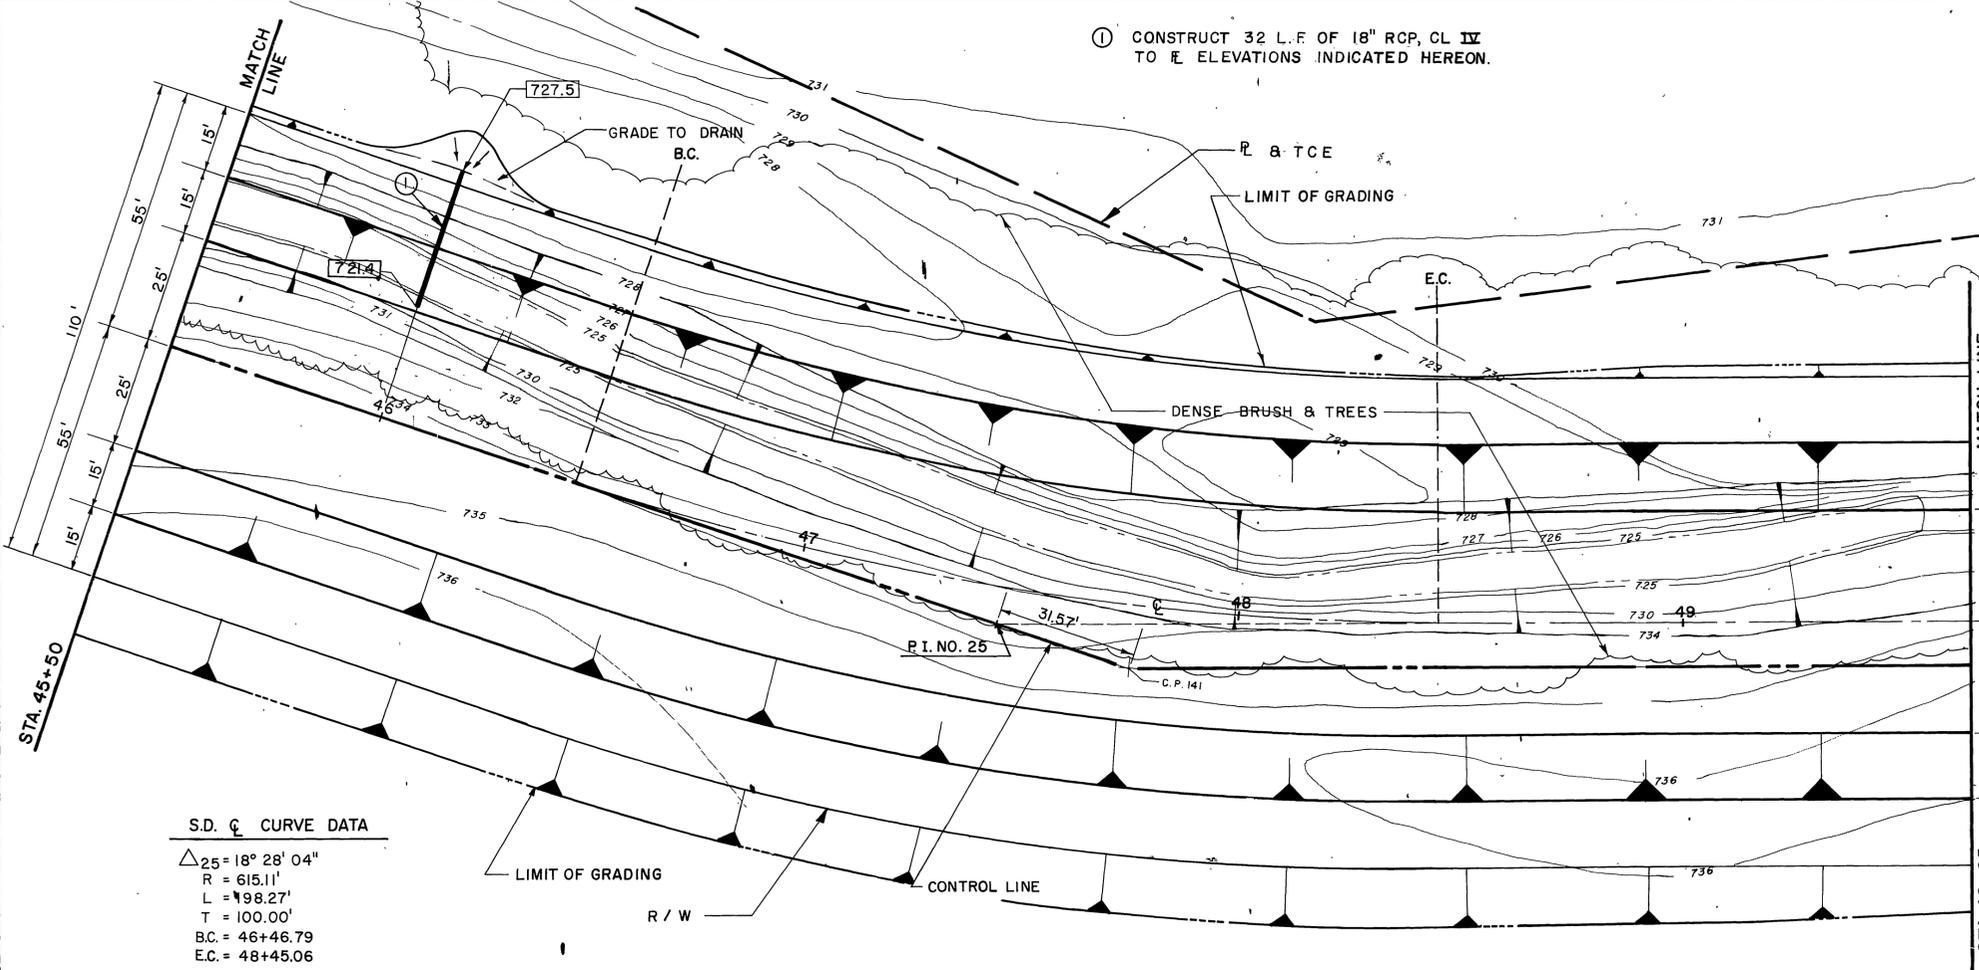


SECTION AT STA. 46+00

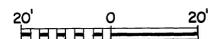

S.D. CURVE DATA  
 $\Delta = 18^\circ 28' 04''$   
 R = 615.11'  
 L = 198.27'  
 T = 100.00'  
 B.C. = 46+46.79  
 E.C. = 48+45.06

PLAN

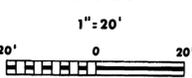

BENCH MARK C.P. 141  
 1x2 HUB ON SURVEY CONTROL  
 LINE  
 ELEV. 734.34  
 SCALE:  
 DATE:

APPROVED BY  
 DATE April 22, 1974  
**AS**  
 ALDERMAN  
 SWIFT  
 & LEWIS  
 CONSULTING  
 ENGINEERS  
 REGISTERED CIVIL ENGINEER  
 NO. 11643


REVISIONS	DESCRIPTION	APPR. DATE
No Change		

RIVERSIDE COUNTY FLOOD CONTROL  
 AND  
 WATER CONSERVATION DISTRICT  
 DESIGNED BY: T.V.P.  
 DRAWN BY: J.A.C.  
 DATE DRAWN: OCT. 1973  
 CHECKED BY: R.D.C., G.L.H.

ANZA CHANNEL  
 STAGE I  
 MONROE CHANNEL  
 STA. 45+50 TO STA. 49+65  
 1970 STORM DRAIN BOND ISSUE PROJECT NO. 18




PROJECT NO.  
 1-0-150  
 DRAWING NO.  
 1-302  
 SHEET NO.  
 8 OF 78

AS BUILT

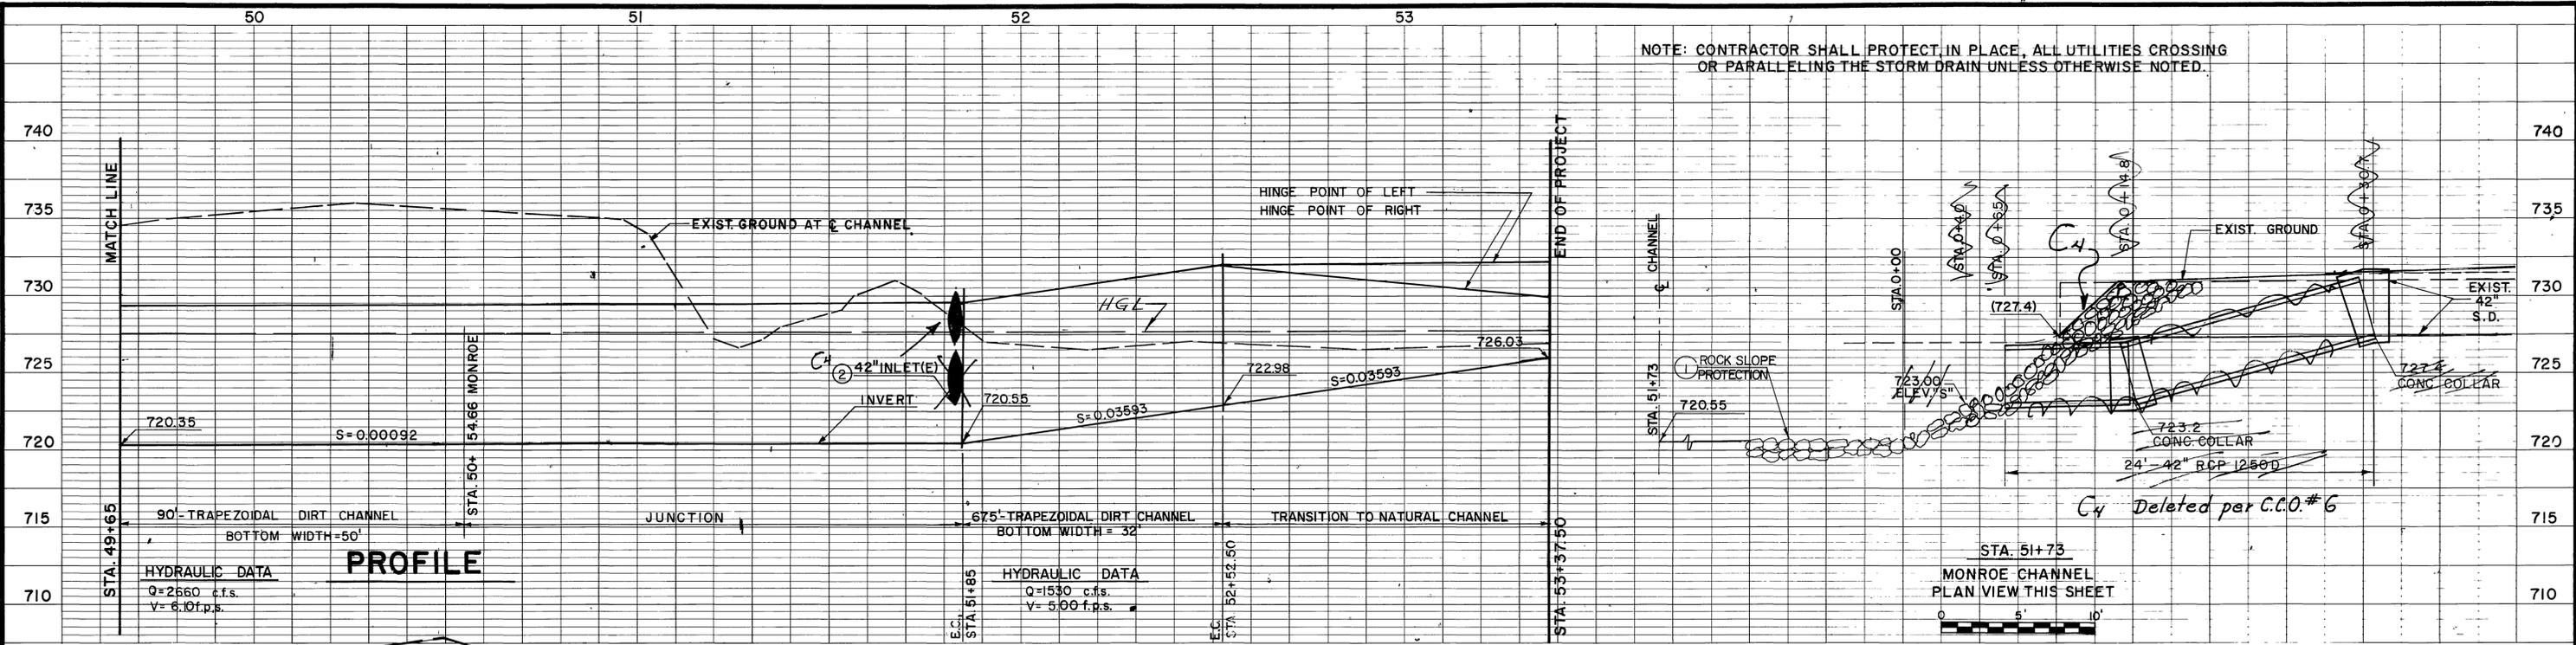

NOTE: CONTRACTOR SHALL PROTECT IN PLACE, ALL UTILITIES CROSSING OR PARALLELING THE STORM DRAIN UNLESS OTHERWISE NOTED.

STA. 51+73  
MONROE CHANNEL  
PLAN VIEW THIS SHEET

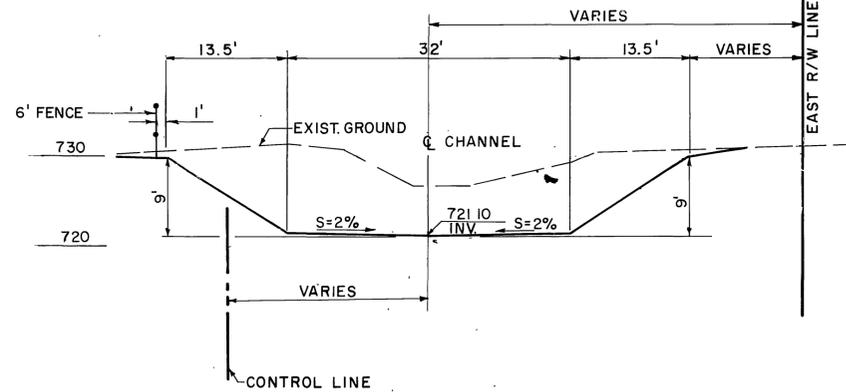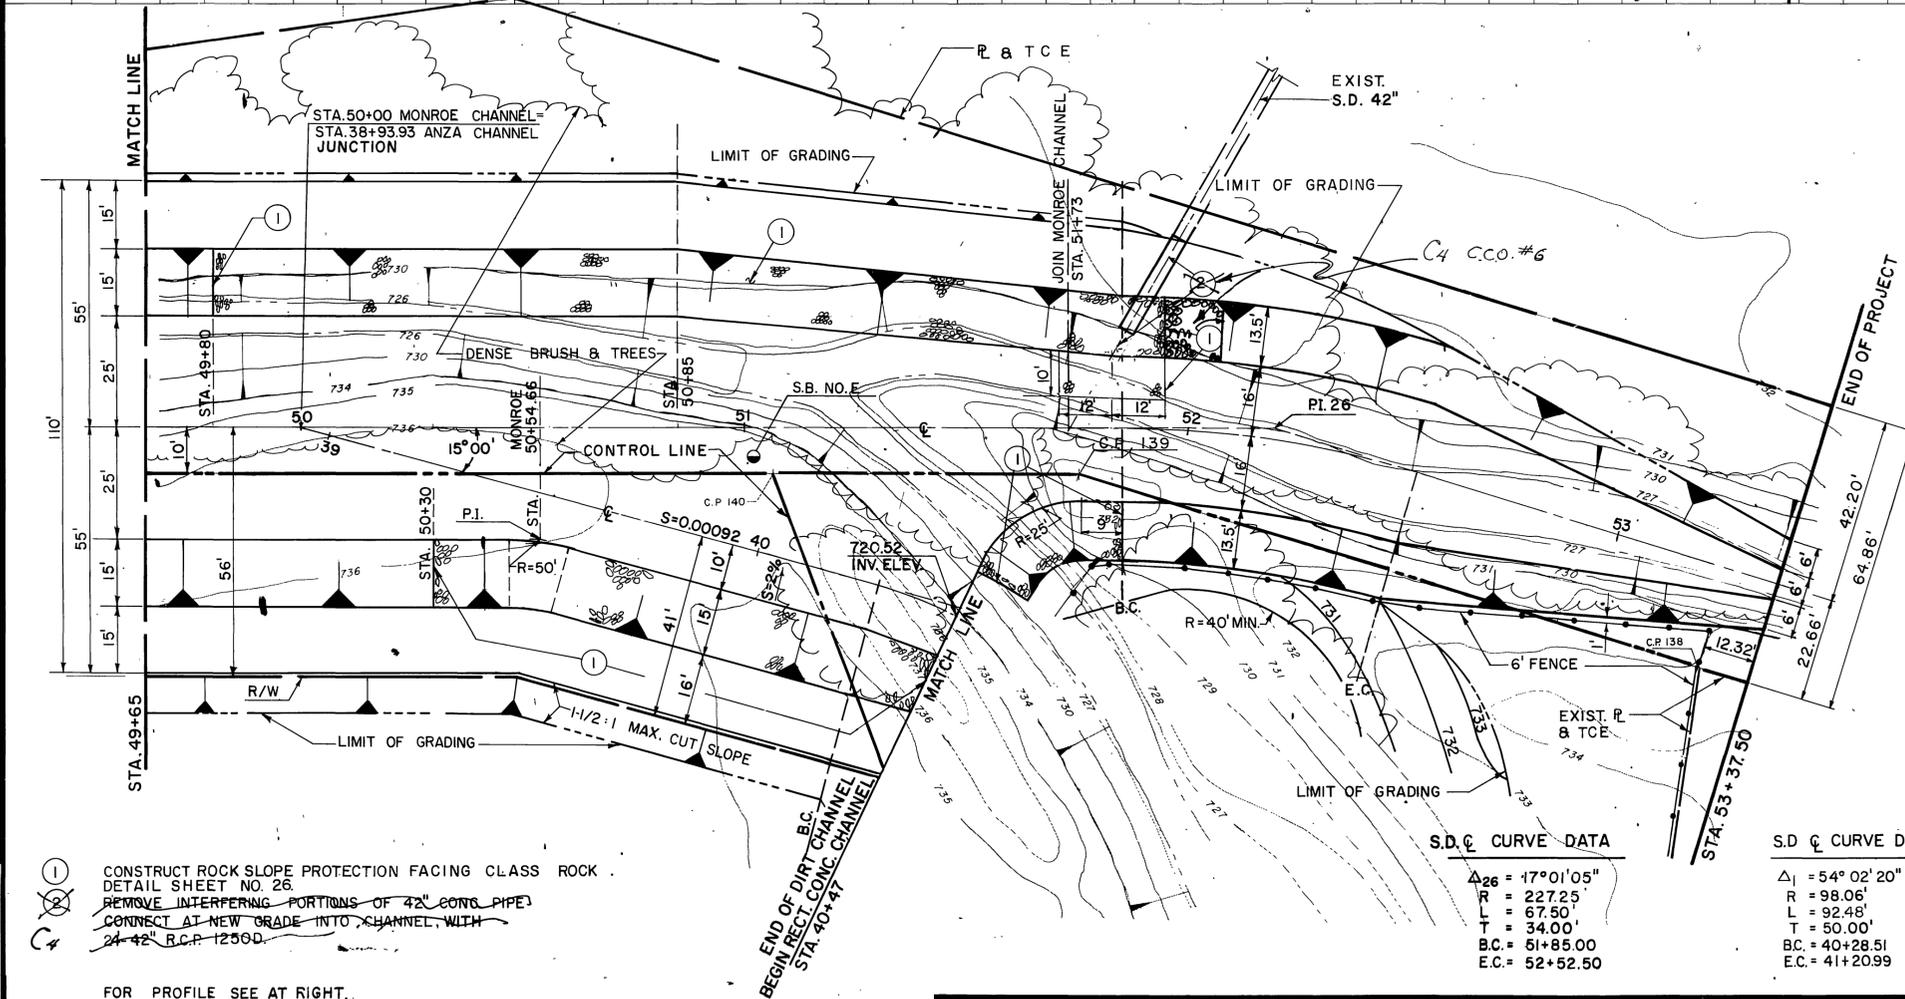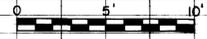


SECTION AT STA. 52+00



- ① CONSTRUCT ROCK SLOPE PROTECTION FACING CLASS ROCK. DETAIL SHEET NO. 26.
- ② REMOVE INTERFERING PORTIONS OF 42\"/>

FOR PROFILE SEE AT RIGHT.

**PLAN**

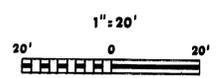

BENCH MARK C.P. 140 1x2 HUB ON SURVEY CONTROL LINE ELEV. 737.06 SCALE: DATE:
---

APPROVED BY  
**AS**  
ALDERMAN SWIFT & LEWIS  
CONSULTING ENGINEERS  
REGISTERED CIVIL ENGINEER  
NO. 11543

DATE: *April 24, 1974*

REVISIONS	DESCRIPTION	APPR. DATE
C4	C.C.O.#6 Changes as shown	4/24/74

RIVERSIDE COUNTY FLOOD CONTROL AND WATER CONSERVATION DISTRICT

DESIGNED BY: T.V.P.  
DRAWN BY: J.A.C.  
DATE DRAWN: OCT. 1973  
CHECKER BY: R.D.C., G.L.H.





APPROVED BY:  
*John W. Conquest*  
CHIEF ENGINEER R/E NO. 8822  
DATE: *3-4-75*

ANZA CHANNEL  
STAGE I  
MONROE CHANNEL  
STA. 45+65 TO STA. 53+37.50  
1970 STORM DRAIN BOND ISSUE PROJECT NO. 18

PROJECT NO. 1-0-150
DRAWING NO. 1-302
SHEET NO. 9 of 78

AS BUILT



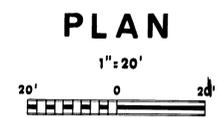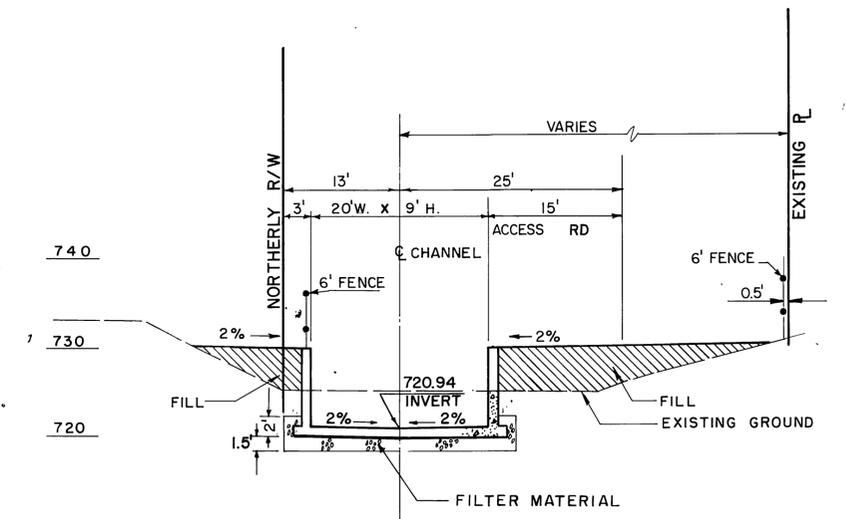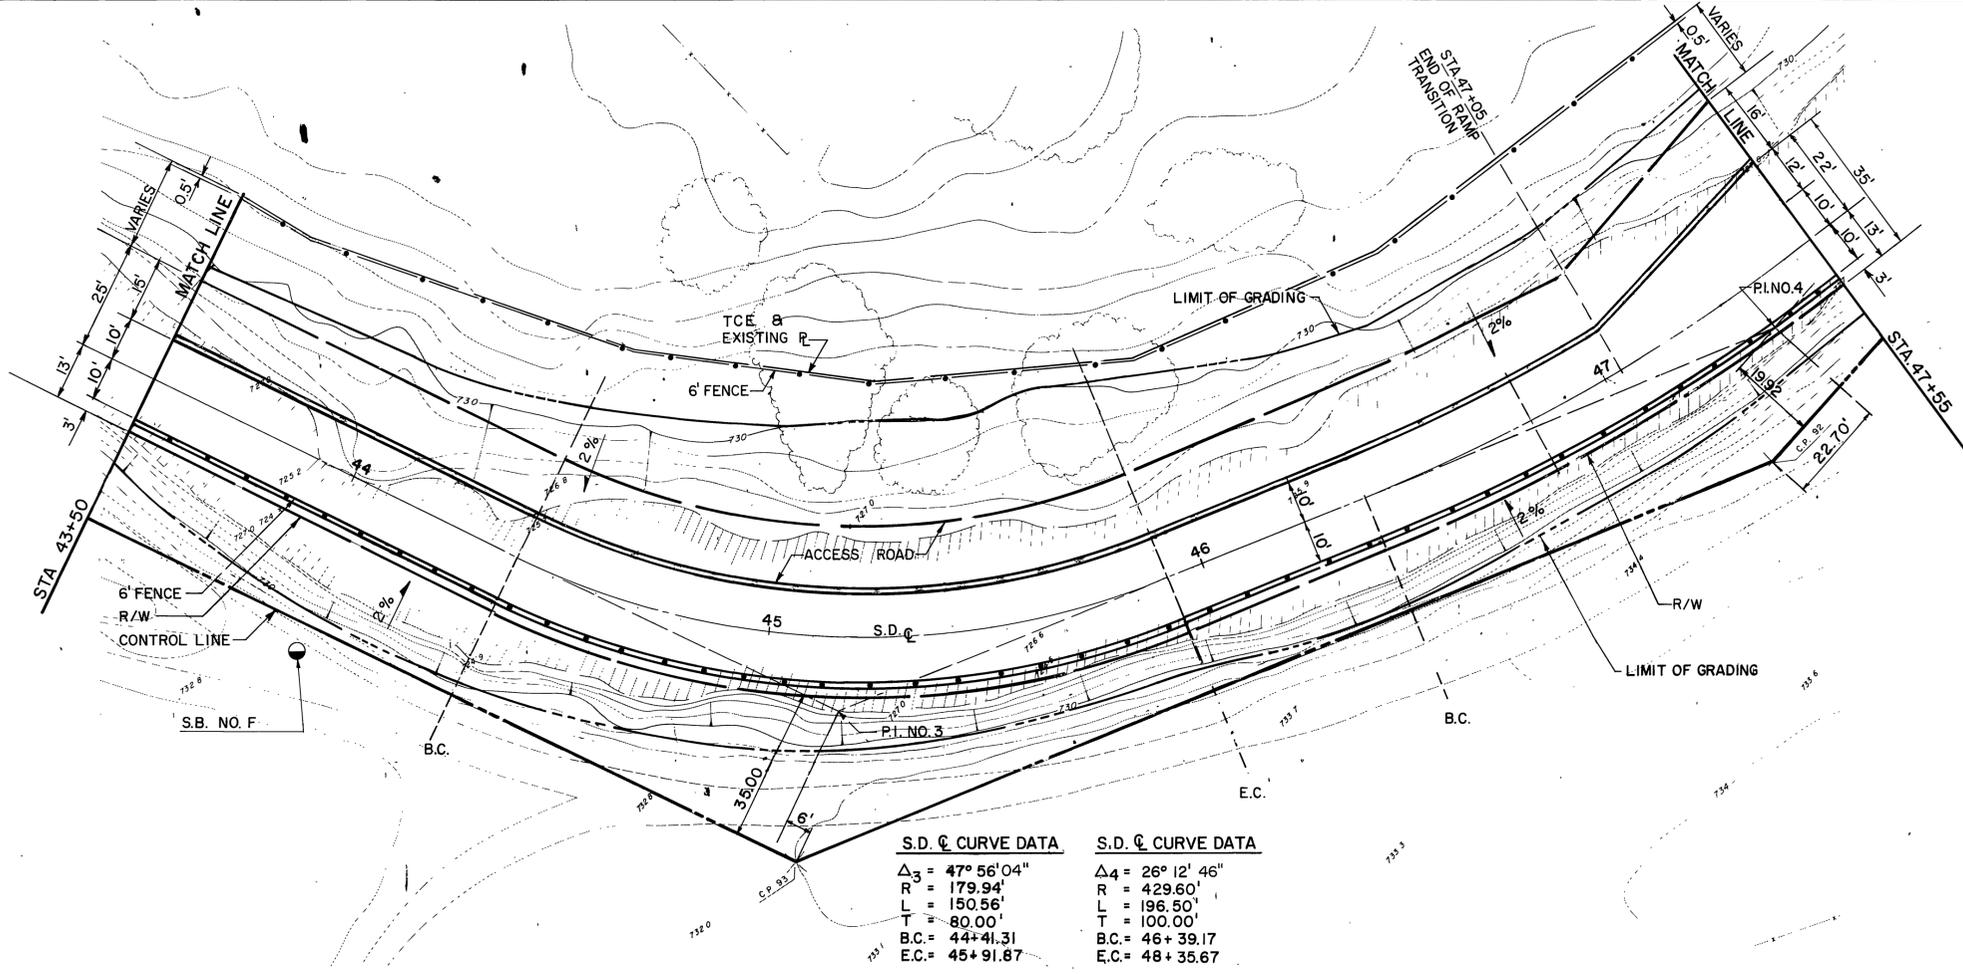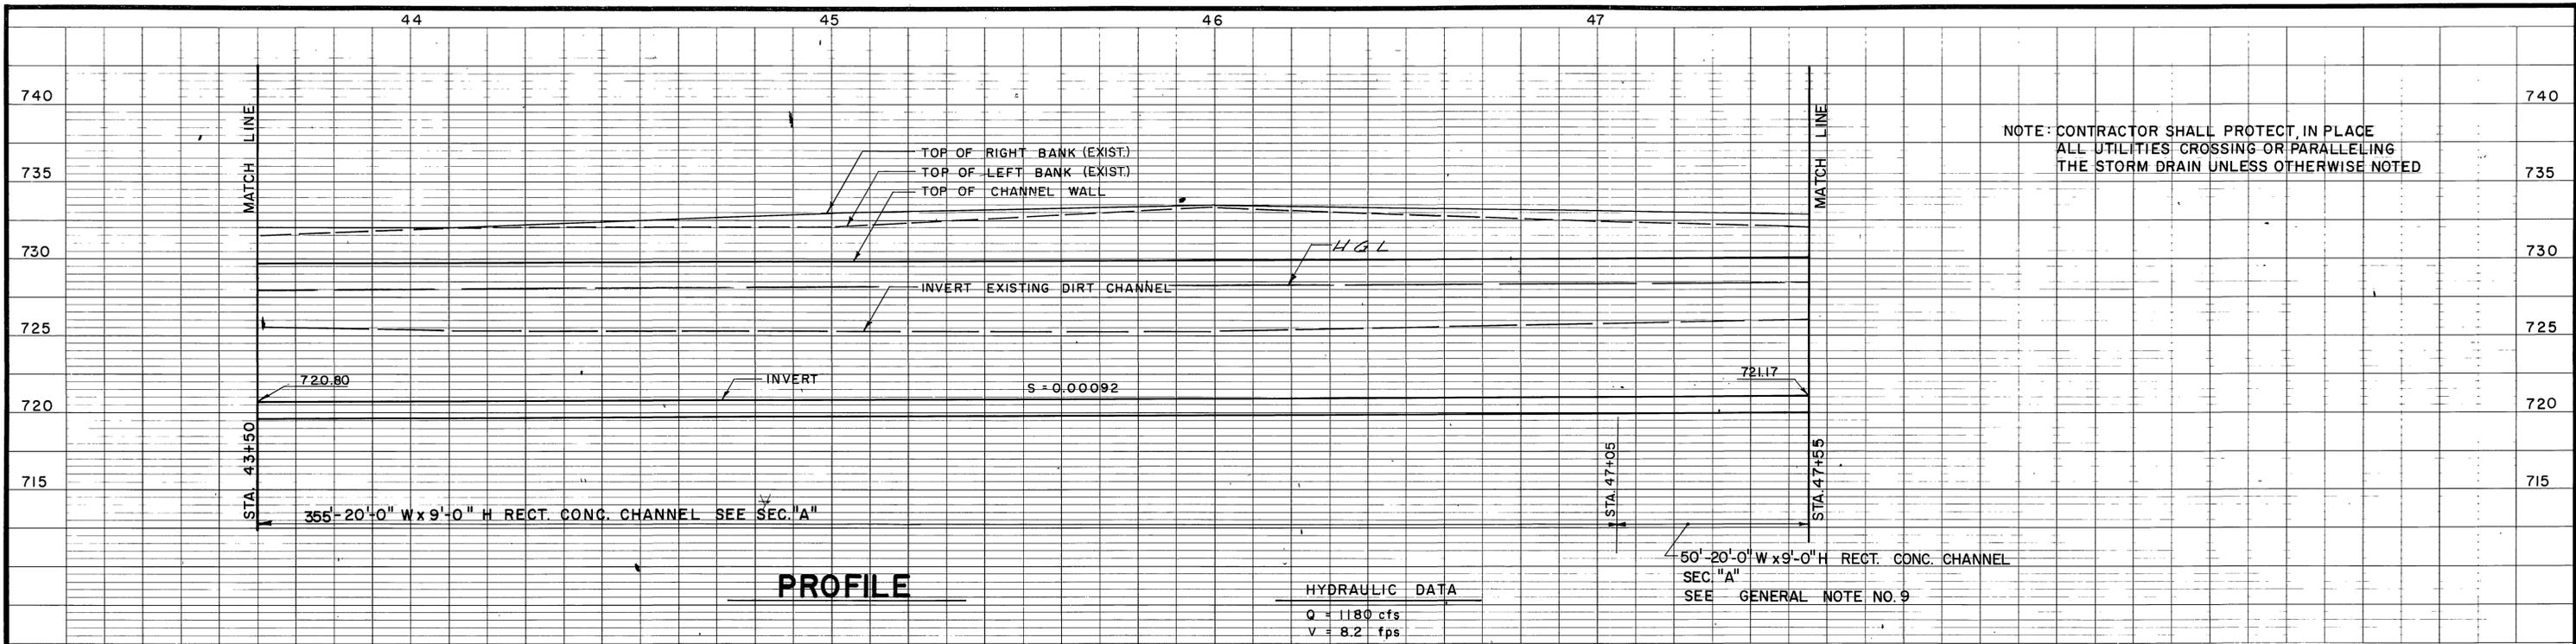

BENCH MARK C.P. 93  
 242 HUB 525 ± NORTHERLY OF ARLINGTON AVE. ON WEST SIDE OF EXIST CHANNEL. ELEV. 733.095

DATE: \_\_\_\_\_

**AS**  
 ALDERMAN SWIFT & LEWIS  
 CONSULTING ENGINEERS  
 REGISTERED CIVIL ENGINEER NO. 11643

APPROVED BY: \_\_\_\_\_  
 DATE: *April 24, 1974*

REF.	DESCRIPTION	APPR. DATE
	No Change	

RIVERSIDE COUNTY FLOOD CONTROL AND WATER CONSERVATION DISTRICT

DESIGNED BY: T.V.P.  
 DRAWN BY: J.A.C.  
 DATE DRAWN: OCT. 1973





APPROVED BY: *John W. Bayant*  
 CHIEF ENGINEER R.E. NO. 8822  
 DATE: *3-4-75*

CHECKED BY: R.D.C. - G.L.H.

**ANZA CHANNEL**  
 STAGE I  
 STA. 43+50 TO STA. 47+55  
 1970 STORM DRAIN BOND ISSUE PROJECT NO. 18

PROJECT NO. 1-0-150  
 DRAWING NO. 1-302  
 SHEET NO. 11 OF 78

AS BUILT

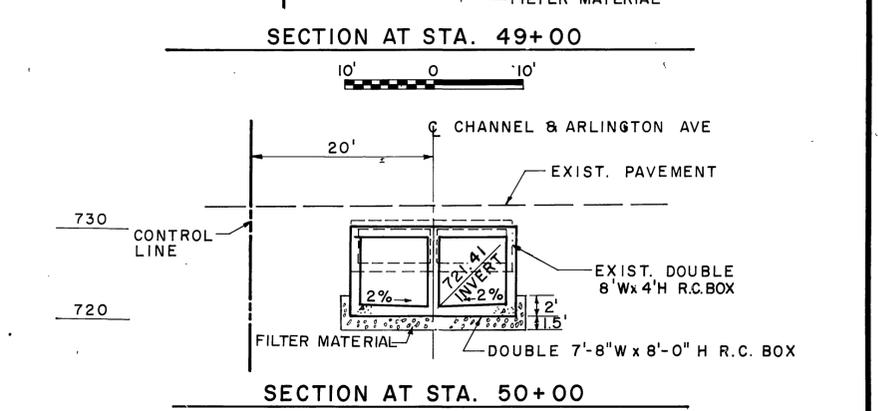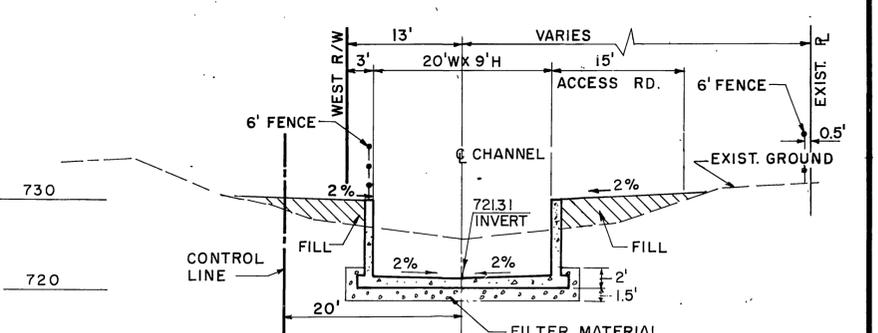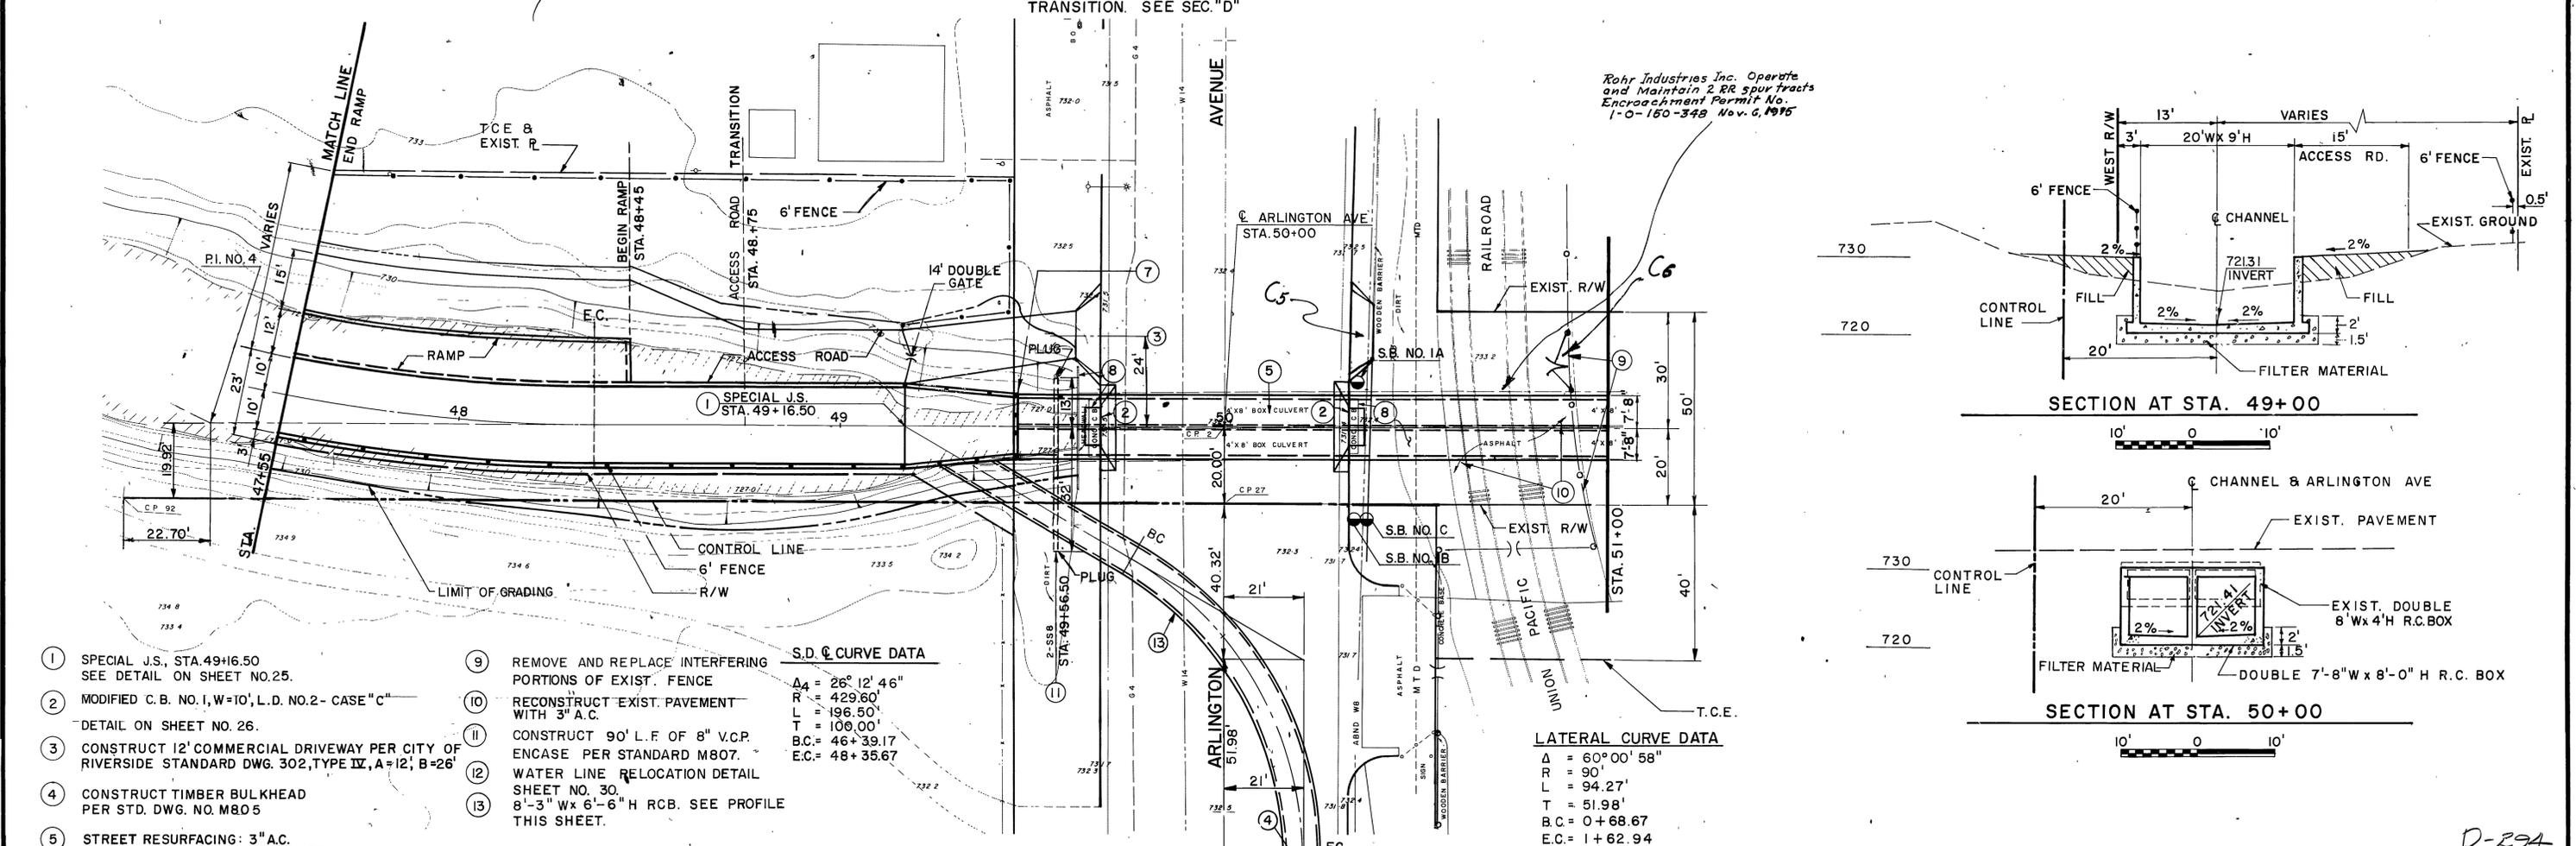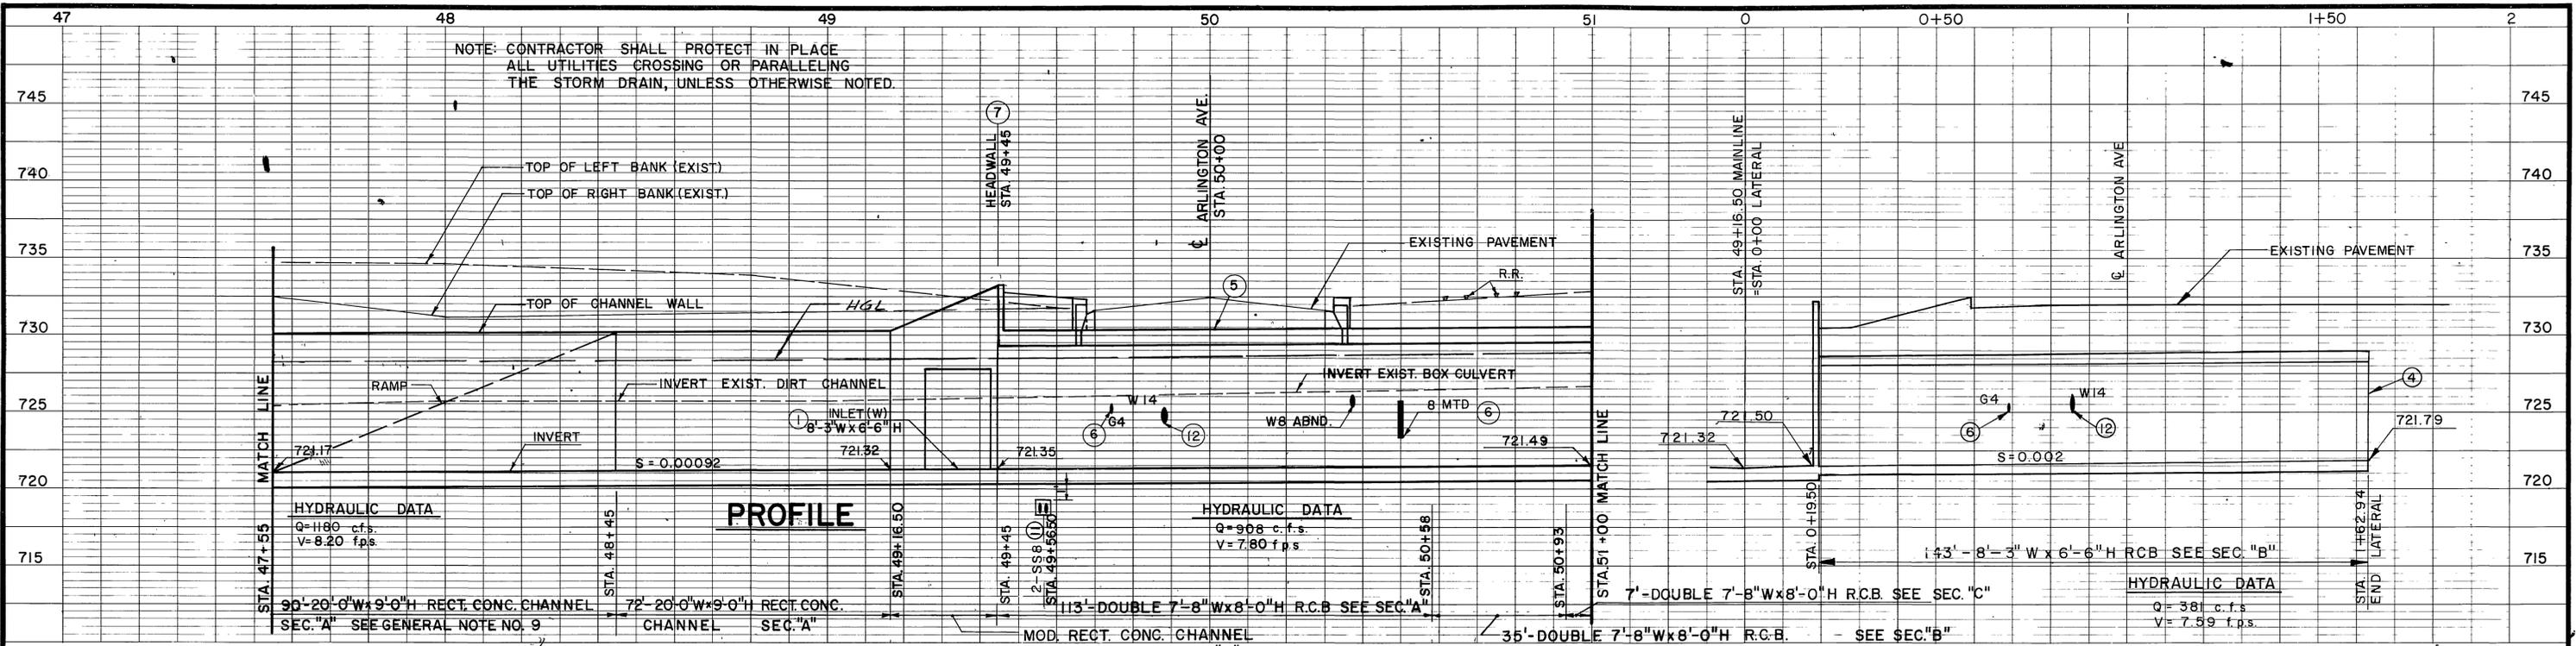

- ① SPECIAL J.S., STA. 49+16.50 SEE DETAIL ON SHEET NO. 25.
- ② MODIFIED C.B. NO. 1, W=10', L.D. NO. 2 - CASE "C" DETAIL ON SHEET NO. 26.
- ③ CONSTRUCT 12' COMMERCIAL DRIVEWAY PER CITY OF RIVERSIDE STANDARD DWG. 302, TYPE IV, A=12', B=26'
- ④ CONSTRUCT TIMBER BULKHEAD PER STD. DWG. NO. M805
- ⑤ STREET RESURFACING: 3" A.C. ON CLASS 3 BASE, FULL DEPTH TO TOP OF R.C.B.
- ⑥ TO BE RELOCATED BY OTHERS. SEE SPECIAL PROVISIONS.
- ⑦ HEADWALL, H=3', SEE DETAIL ON SHEET NO. 26
- ⑧ REMOVE EXIST. HEADWALL, BOX CULVERT, & CATCH BASINS
- ⑨ REMOVE AND REPLACE INTERFERING PORTIONS OF EXIST. FENCE
- ⑩ RECONSTRUCT EXIST. PAVEMENT WITH 3" A.C.
- ⑪ CONSTRUCT 90' L.F. OF 8" V.C.P. ENCASE PER STANDARD M807.
- ⑫ WATER LINE RELOCATION DETAIL SHEET NO. 30.
- ⑬ 8'-3" Wx 6'-6" H RCB. SEE PROFILE THIS SHEET.

**S.D. & CURVE DATA**

Δ<sub>4</sub> = 26° 12' 46"  
 R = 429.60'  
 L = 196.50'  
 T = 100.00'  
 B.C. = 46+39.17  
 E.C. = 48+35.67

**LATERAL CURVE DATA**

Δ = 60° 00' 58"  
 R = 90'  
 L = 94.27'  
 T = 51.98'  
 B.C. = 0+68.67  
 E.C. = 1+62.94

**PLAN**  
 1" = 20'

BENCH MARK C.P. 27  
 NAIL AND TIN ON CENTERLINE OF ARLINGTON AVE. 20' WEST OF CENTERLINE OF CHANNEL.  
 ELEV. 732.337  
 SCALE:  
 DATE:

APPROVED BY  
 DATE *April 24, 1974*  
  
 REGISTERED CIVIL ENGINEER  
 NO. 11843



NO.	REVISIONS	DATE

**RIVERSIDE COUNTY FLOOD CONTROL AND WATER CONSERVATION DISTRICT**  
 DESIGNED BY: T.V.P.  
 DRAWN BY: J.A.C.  
 DATE DRAWN: OCT. 1973  
 CHECKED BY: R.D.C. - G.L.H.


**ANZA CHANNEL STAGE I**  
 STA. 47+55 TO STA. 51+00  
 1970 STORM DRAIN BOND ISSUE PROJECT NO. 18

PROJECT NO. 1-0-150  
 DRAWING NO. J-302  
 SHEET NO. 12 OF 78

AS BUILT

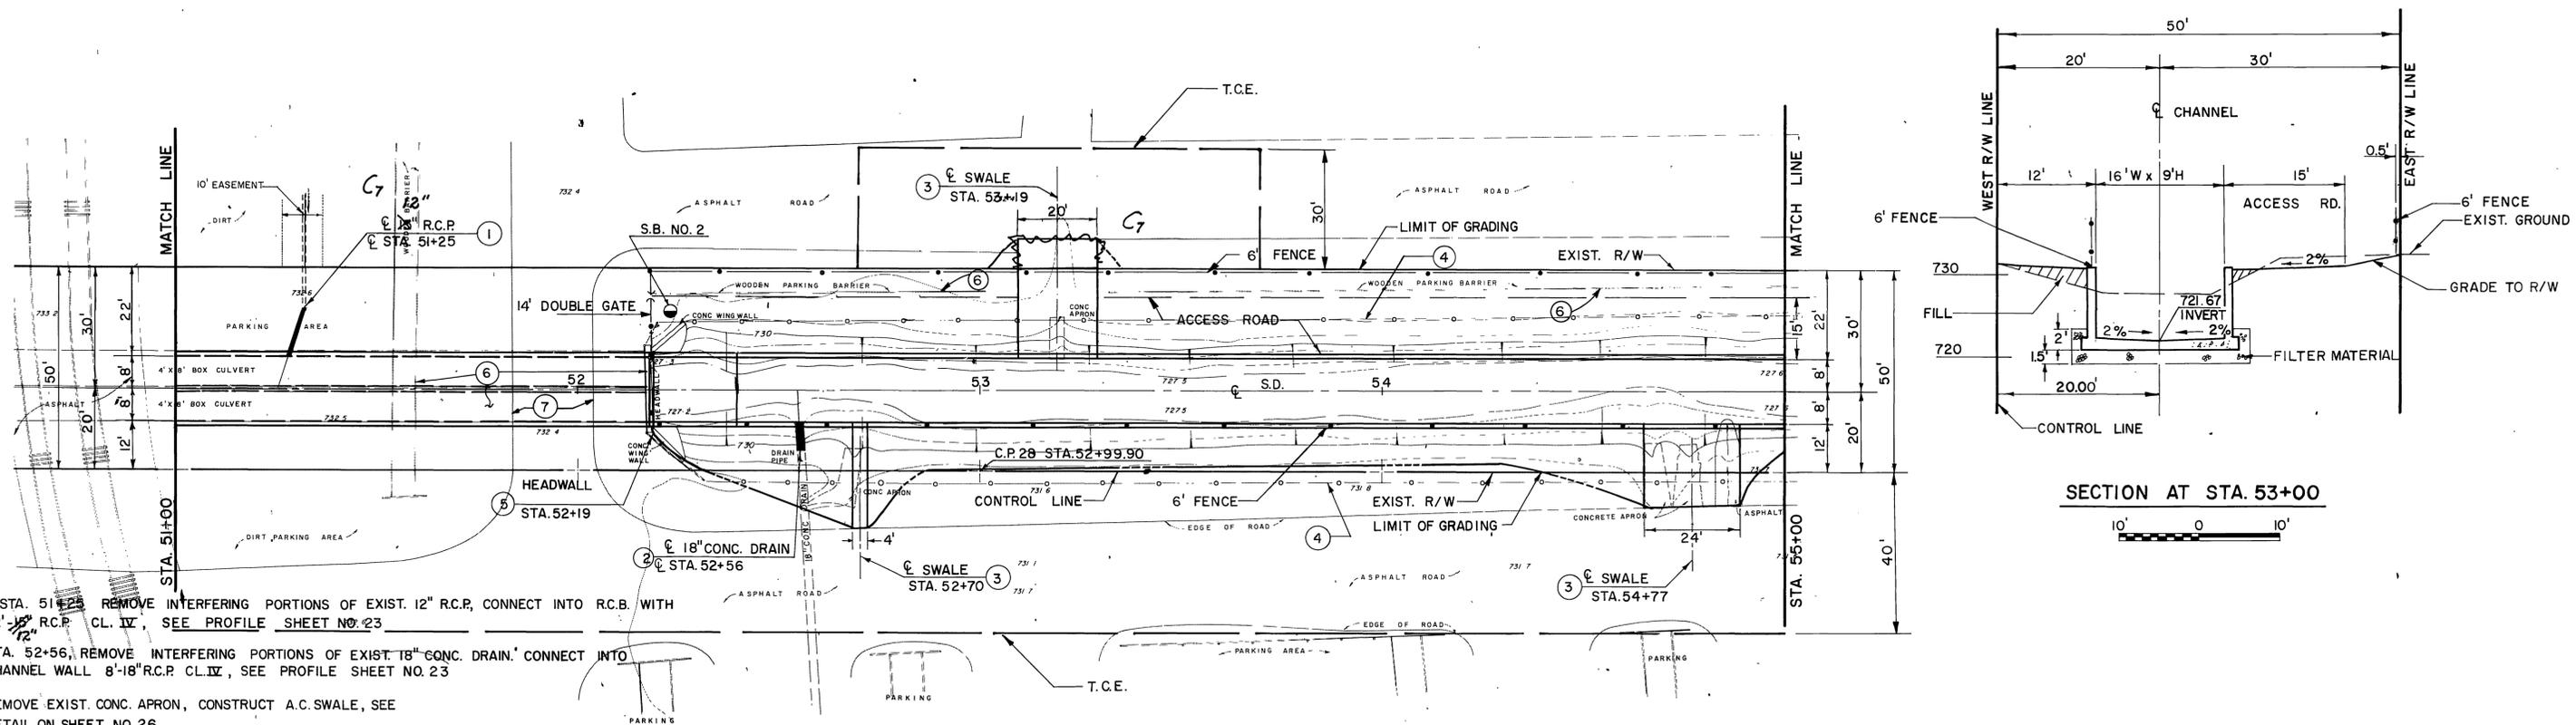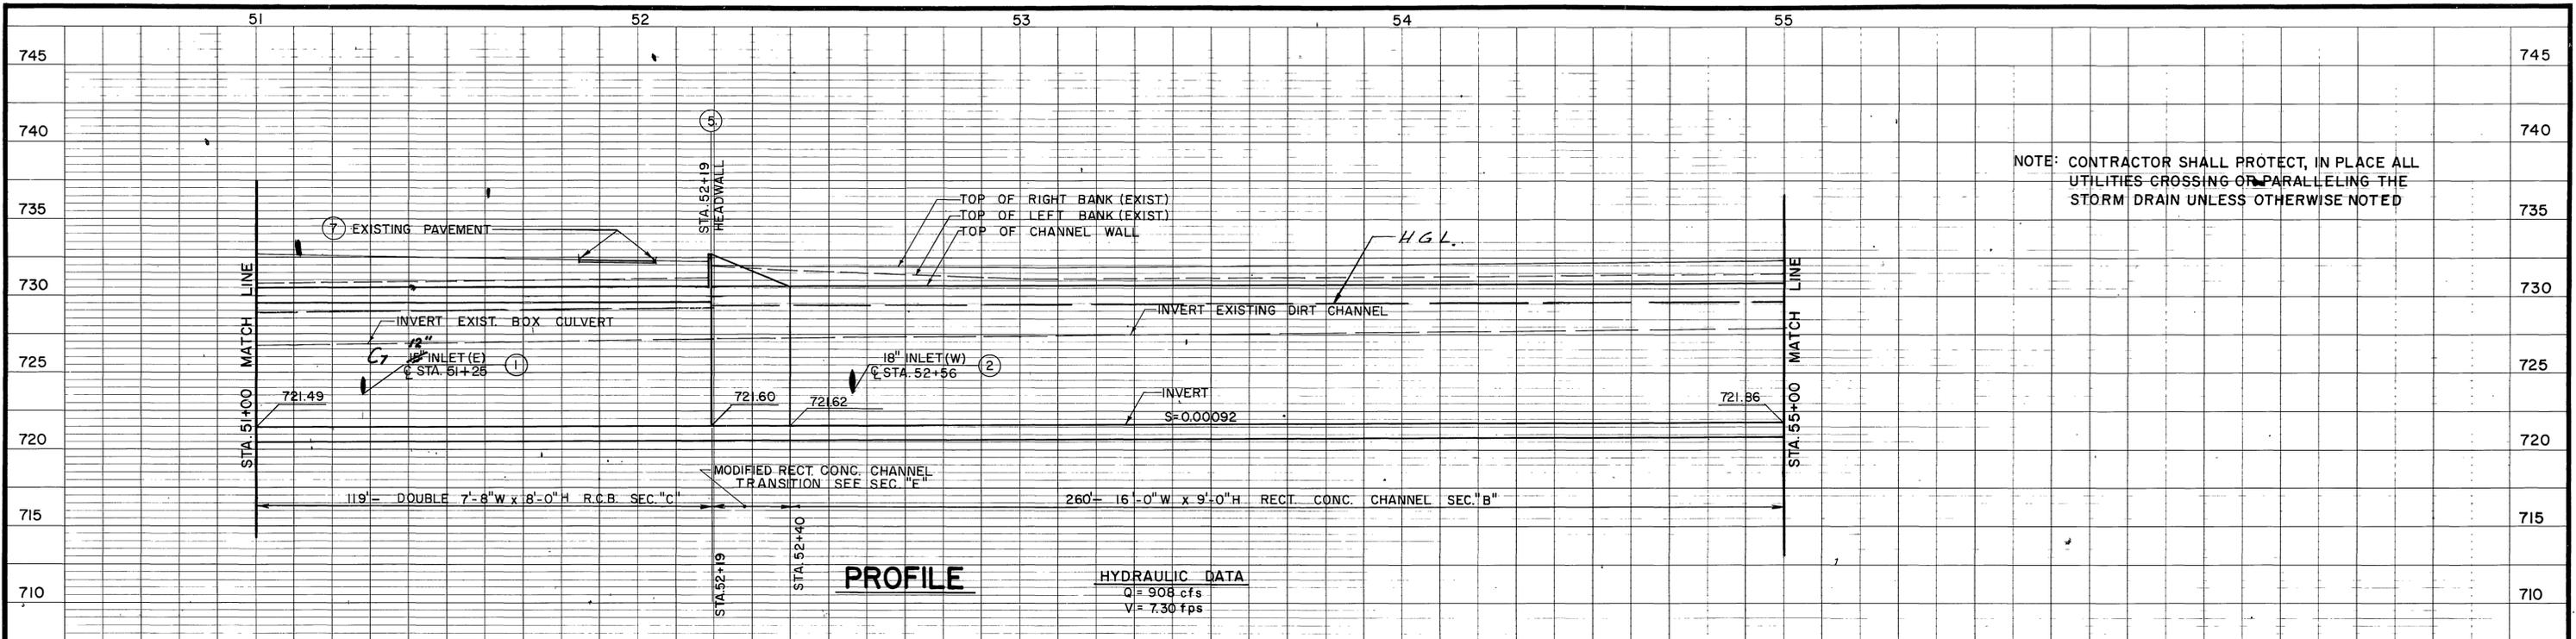

- ① @ STA. 51+25 REMOVE INTERFERING PORTIONS OF EXIST. 12" R.C.P., CONNECT INTO R.C.B. WITH 12" R.C.P. CL. IV, SEE PROFILE SHEET NO. 23
- ② STA. 52+56, REMOVE INTERFERING PORTIONS OF EXIST. 18" CONC. DRAIN, CONNECT INTO CHANNEL WALL 8'-18" R.C.P. CL. IV, SEE PROFILE SHEET NO. 23
- ③ REMOVE EXIST. CONC. APRON, CONSTRUCT A.C. SWALE, SEE DETAIL ON SHEET NO. 26.
- ④ REMOVE EXISTING FENCE.
- ⑤ HEADWALL, H=2', SEE DETAIL ON SHEET NO. 26.
- ⑥ REMOVE EXIST. BOX CULVERT, HEADWALL, AND INTERFERING PORTIONS OF WOOD BARRIER.
- ⑦ CONSTRUCT 3" A.C. AND 6" AGGREGATE BASE ON COMPACTED FILL. JOIN THE EXISTING PAVEMENT GRADE AT EACH SIDE OF EXCAVATION

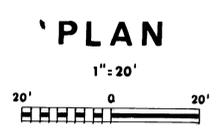

BENCH MARK C.P. 28  
 NAIL AND TIN 300' SOUTHERLY  
 OF ARLINGTON AVE. ON WEST  
 R/W OF CHANNEL.  
 ELEV. 731.087  
 SCALE:  
 DATE:

APPROVED BY  
 DATE April 2, 1974  
**ALDERMAN SWIFT & LEWIS**  
 CONSULTING ENGINEERS  
 REGISTERED CIVIL ENGINEER  
 NO. 11543


REVISIONS	DESCRIPTION	DATE
1	Changes as shown	4/2/74

RIVERSIDE COUNTY FLOOD CONTROL AND WATER CONSERVATION DISTRICT  
 DESIGNED BY: T.V.P.  
 DRAWN BY: E.C.H.  
 DATE DRAWN: OCT. 1973  
 CHECKED BY: R.D.C., G.L.H.

ANZA CHANNEL  
 STAGE I  
 STA. 51+00 TO STA. 55+00  
 1970 STORM DRAIN BOND ISSUE PROJECT NO. 18

PROJECT NO. 1-0-150  
 DRAWING NO. 1-302  
 SHEET NO. 13 OF 78

AS BUILT


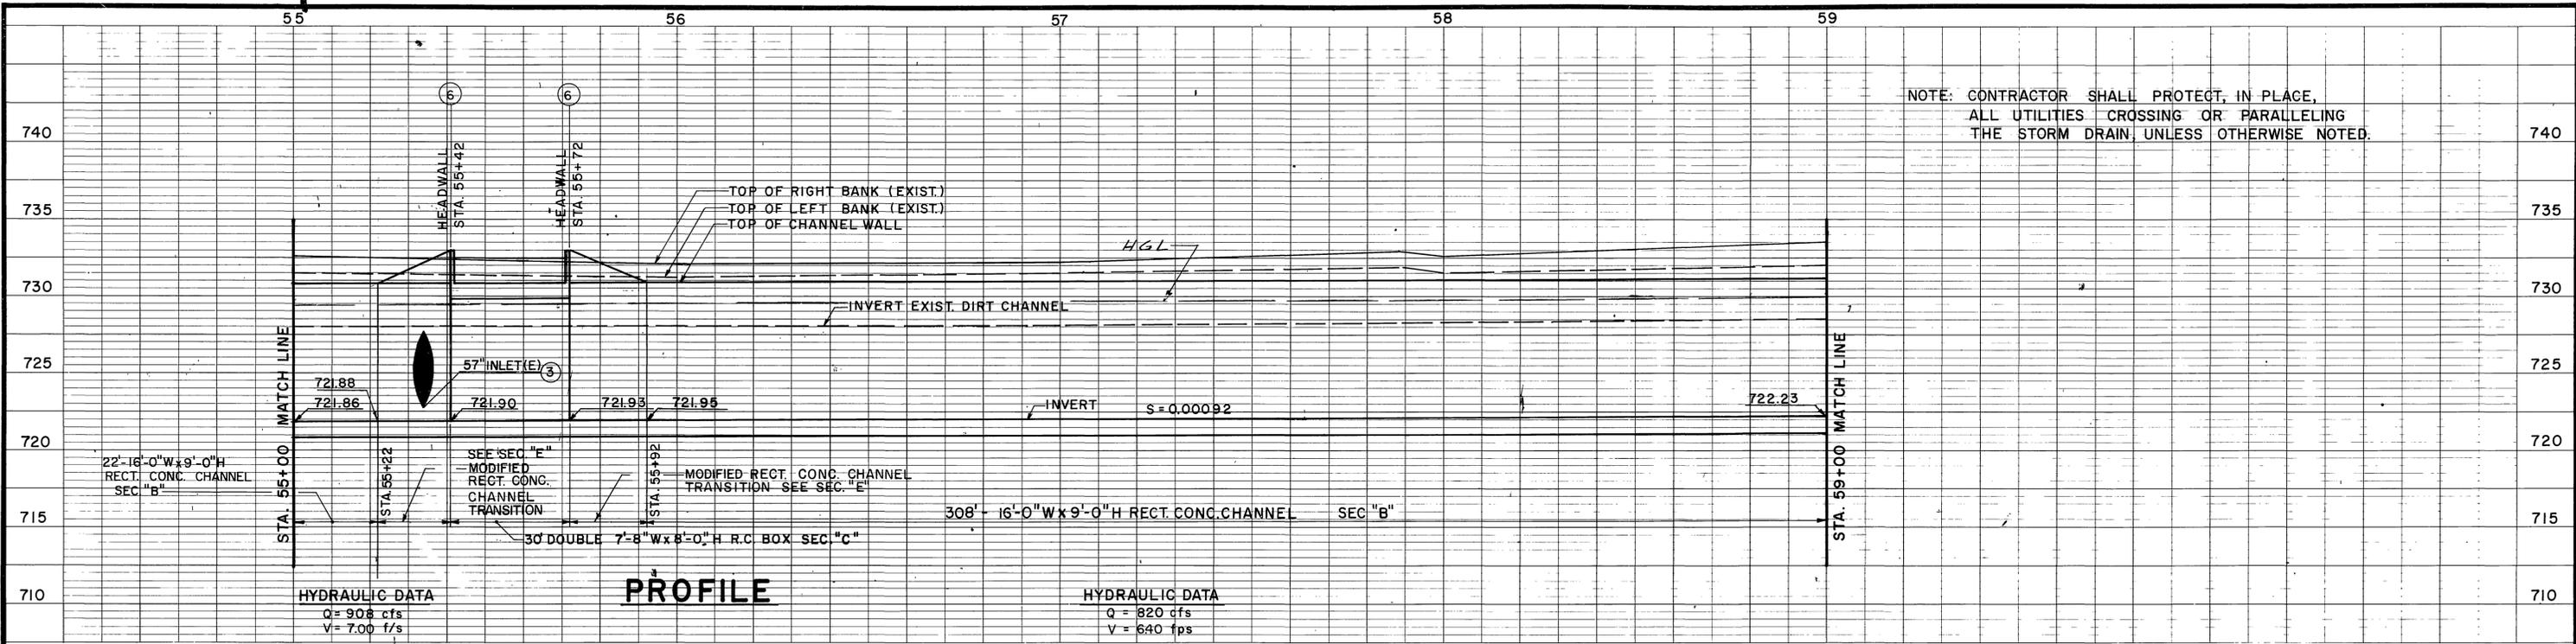


NOTE: CONTRACTOR SHALL PROTECT, IN PLACE, ALL UTILITIES CROSSING OR PARALLELING THE STORM DRAIN, UNLESS OTHERWISE NOTED.

HYDRAULIC DATA  
Q = 908 cfs  
V = 7.00 f/s

**PROFILE**


HYDRAULIC DATA  
Q = 820 cfs  
V = 6.40 f/s

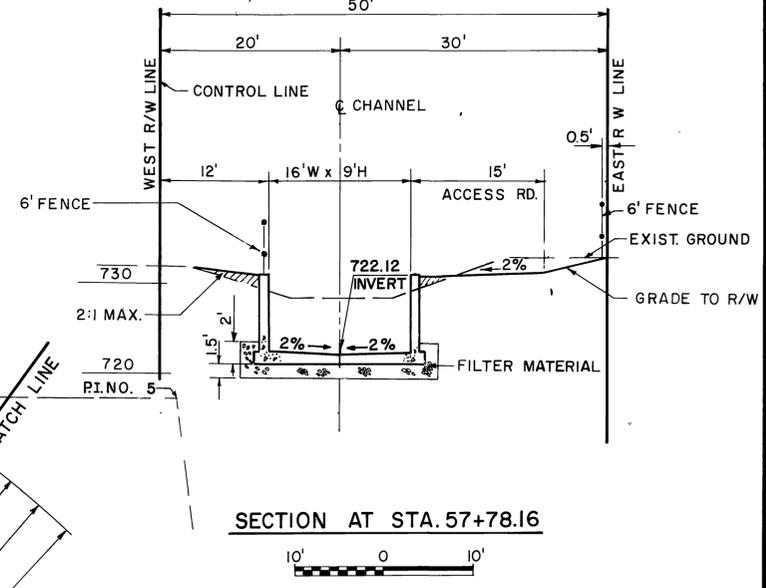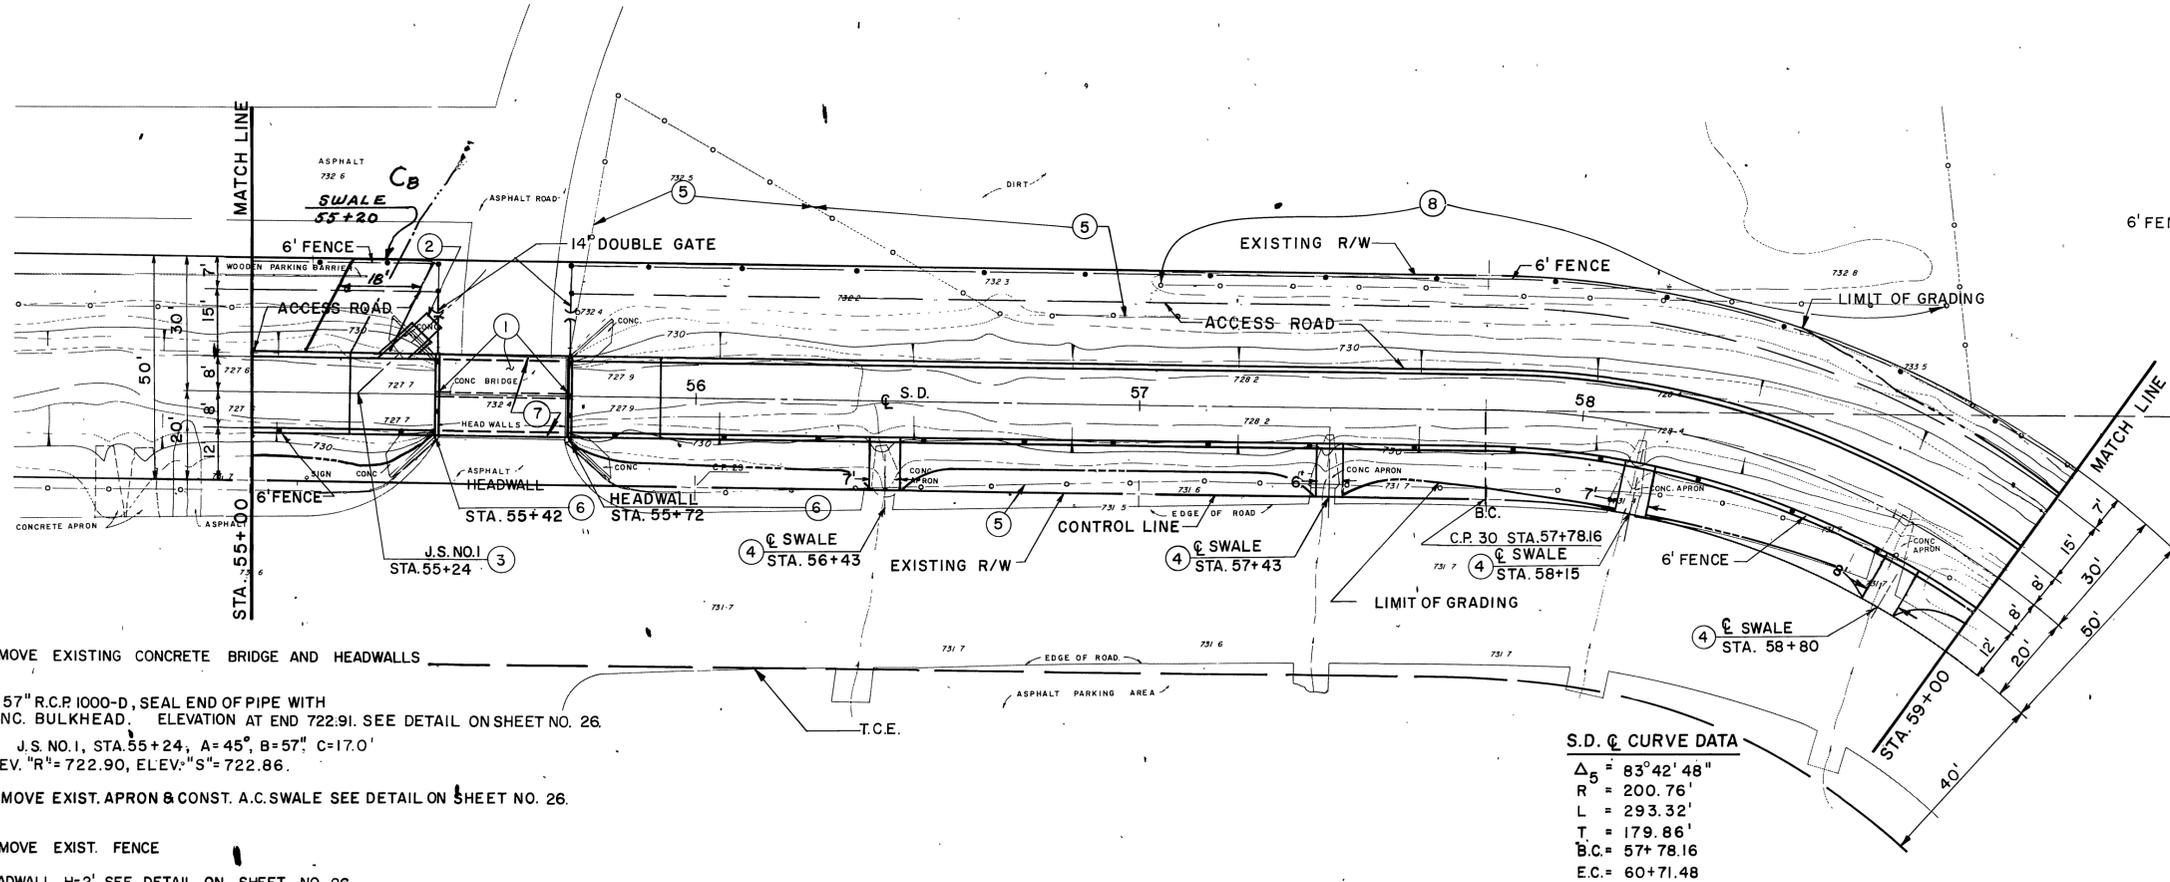

- ① REMOVE EXISTING CONCRETE BRIDGE AND HEADWALLS
- ② 4'-57" R.C.P. 1000-D, SEAL END OF PIPE WITH CONC. BULKHEAD. ELEVATION AT END 722.91. SEE DETAIL ON SHEET NO. 26.
- ③ J.S. NO. 1, STA. 55+24, A=45°, B=57°, C=17.0' ELEV. "R"= 722.90, ELEV. "S"= 722.86.
- ④ REMOVE EXIST. APRON & CONST. A.C. SWALE SEE DETAIL ON SHEET NO. 26.
- ⑤ REMOVE EXIST. FENCE
- ⑥ HEADWALL, H=2', SEE DETAIL ON SHEET NO. 26.
- ⑦ CONSTRUCT 3" A.C. AND 6" AGGREGATE BASE ON COMPACTED FILL. JOIN EXISTING PAVEMENT GRADE AT EACH SIDE OF EXCAVATION
- ⑧ SALVAGE EXIST. FENCE. SEE SPECIAL PROVISIONS.

S.D. & CURVE DATA  
 $\Delta_5 = 83^\circ 42' 48''$   
 $R = 200.76'$   
 $L = 293.32'$   
 $T = 179.86'$   
 $B.C. = 57+78.16$   
 $E.C. = 60+71.48$

**PLAN**

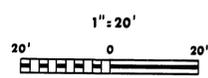

BENCH MARK C.P. 30  
1x2 HUB ON WEST R/W OF CHANNEL AT B.C.  
ELEV. 731.72  
SCALE:  
DATE:

APPROVED BY  
DATE April 24, 1974  
ALDERMAN SWIFT & LEWIS CONSULTING ENGINEERS  
REGISTERED CIVIL ENGINEER  
NO. 11843


NO.	REVISIONS	DATE
1	16' Swale Added on shown	10/24/74

RIVERSIDE COUNTY FLOOD CONTROL AND WATER CONSERVATION DISTRICT  
 DESIGNED BY: T.V.P.  
 DRAWN BY: J.A.C.  
 DATE DRAWN: OCT. 1973  
 CHECKED BY: R.D.C., G.L.H.

ANZA CHANNEL  
 STAGE I  
 STA. 55+00 TO STA. 59+00  
 1970 STORM DRAIN BOND ISSUE PROJECT NO. 18

PROJECT NO. 1-0-150  
 DRAWING NO. 1-302  
 SHEET NO. 14 OF 78


D-29A

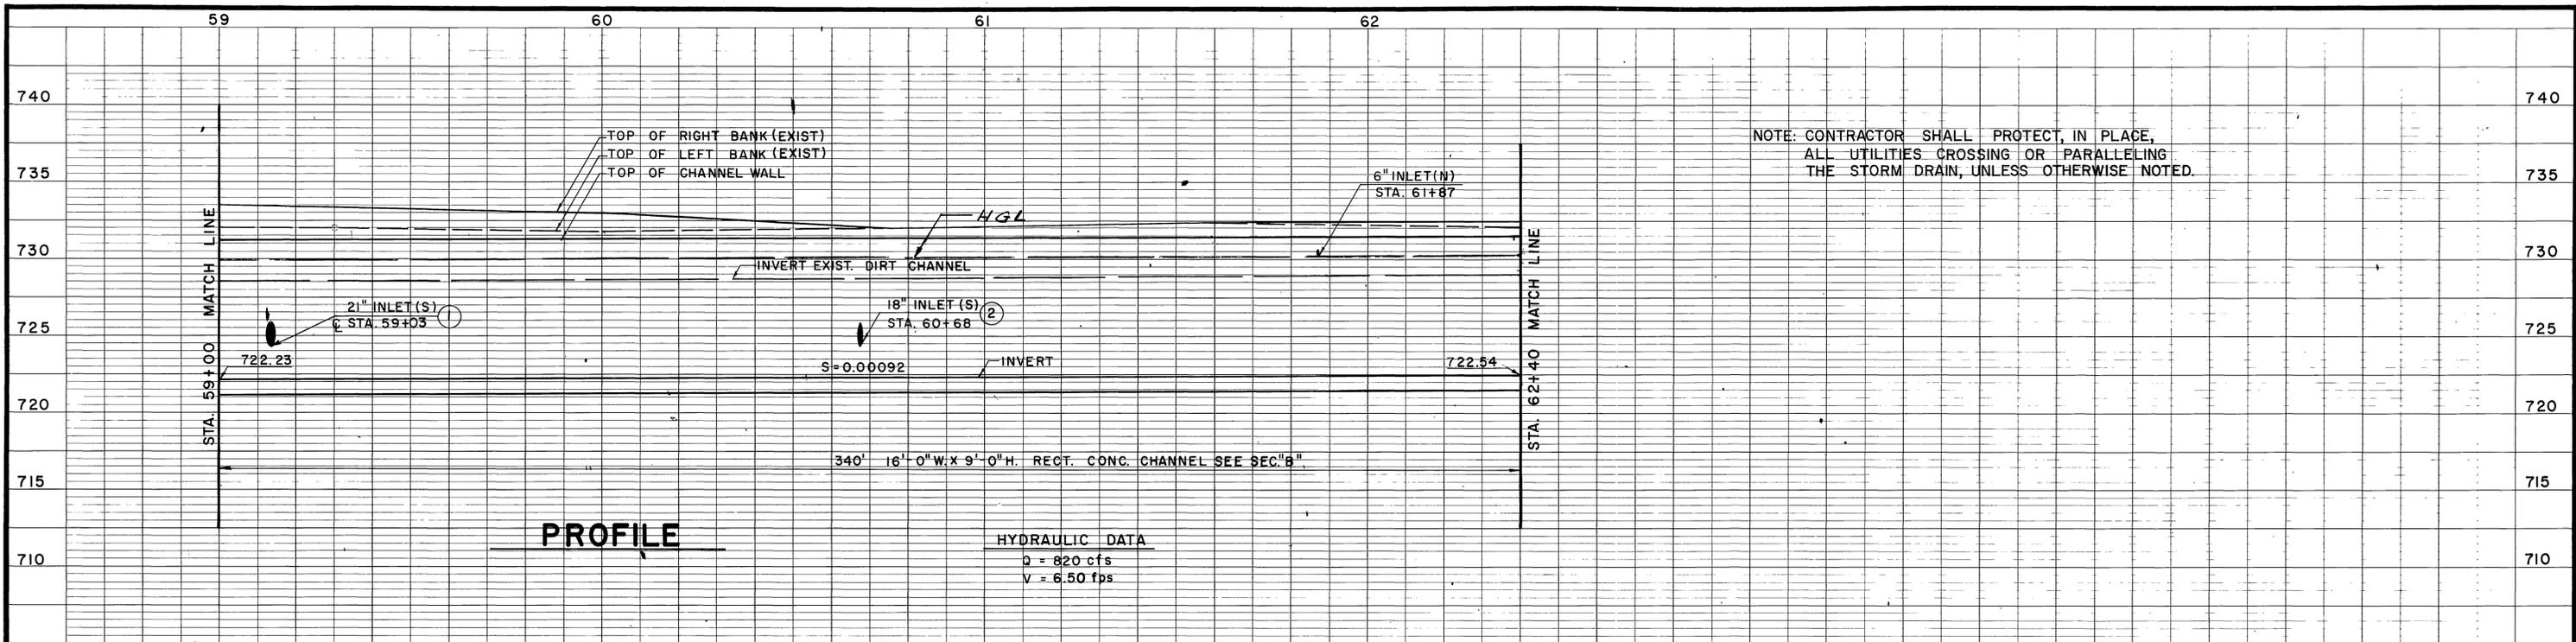

NOTE: CONTRACTOR SHALL PROTECT, IN PLACE, ALL UTILITIES CROSSING OR PARALLELING THE STORM DRAIN, UNLESS OTHERWISE NOTED.


HYDRAULIC DATA  
 Q = 820 cfs  
 V = 6.50 fps

- 1 CONNECT 21" R.C.P INTO CHANNEL WALL. 24'-21" R.C.P CL. IV FOR PROFILE SEE SHEET NO. 23.
- 2 REMOVE INTERFERING PORTIONS OF EXIST. 18" C.M.P AND REPLACE AT NEW GRADE INTO CHANNEL WALL. 20'-18" R.C.P CL. IV, FOR PROFILE SEE SHEET NO. 23.
- 3 REMOVE EXIST. CONCRETE APRON & CONSTRUCT A.C. SWALE SEE DETAIL ON SHEET NO. 26.
- 4 CONNECT EXIST. 6" C.M.P INTO CHANNEL WALL.
- 5 REMOVE EXIST. FENCE
- 6 CONNECT EXIST. 7' CHAIN LINK FENCE TO CHANNEL FENCE.
- 7 SALVAGE EXIST. FENCE. SEE SPECIAL PROVISIONS.

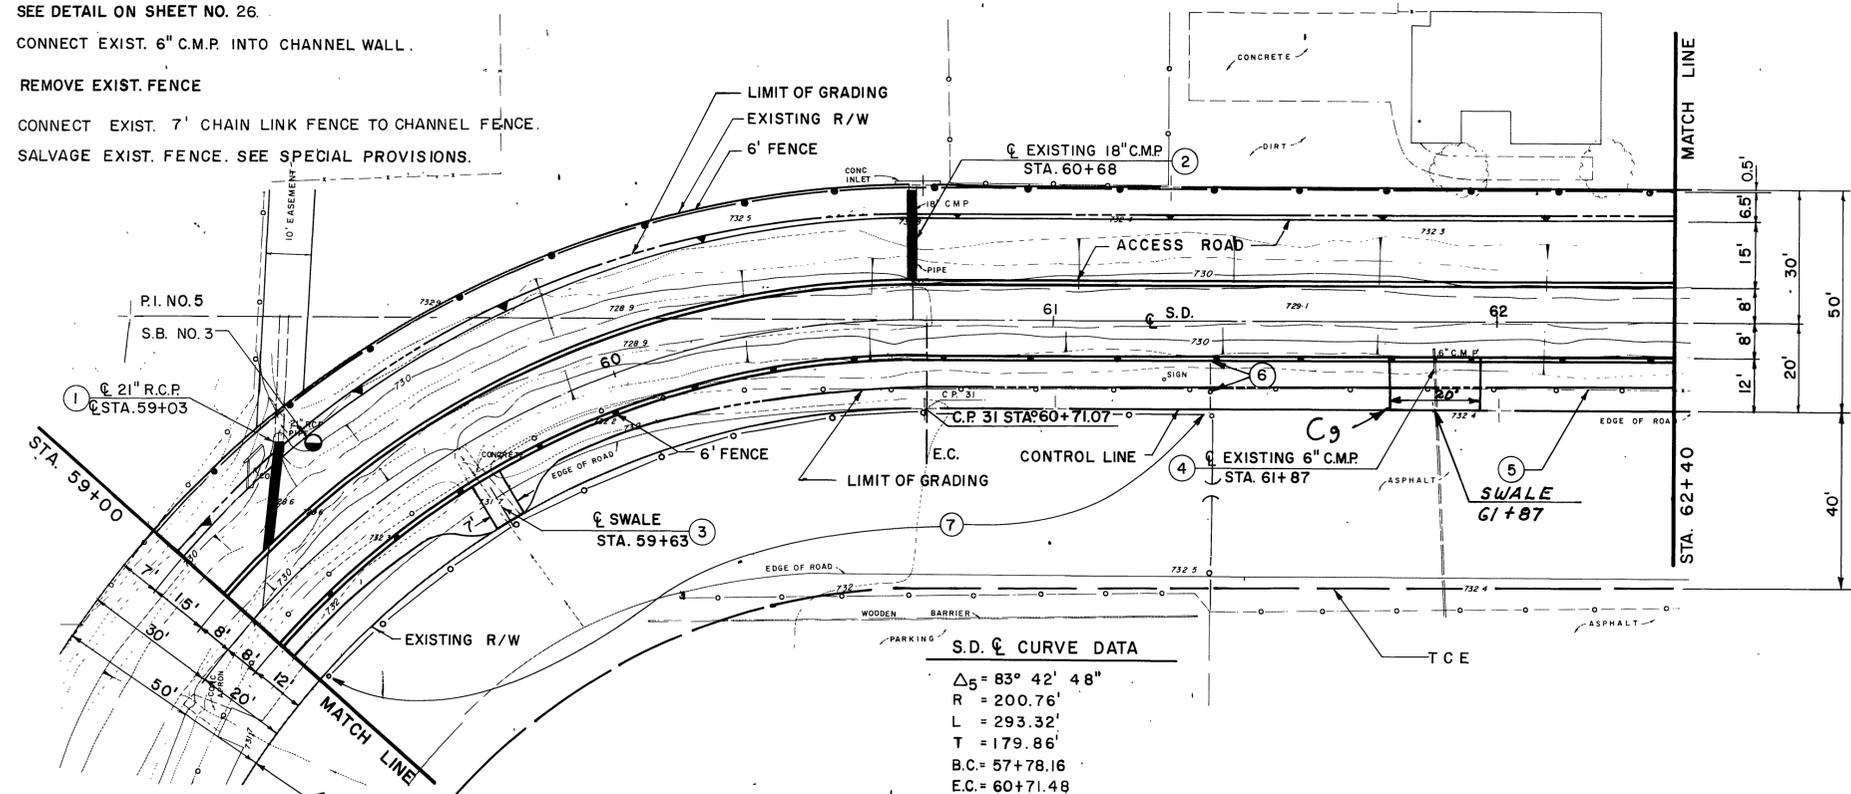

S.D. CURVE DATA

$\Delta_5 = 83^\circ 42' 48''$
$R = 200.76'$
$L = 293.32'$
$T = 179.86'$
$B.C. = 57+78.16$
$E.C. = 60+71.48$

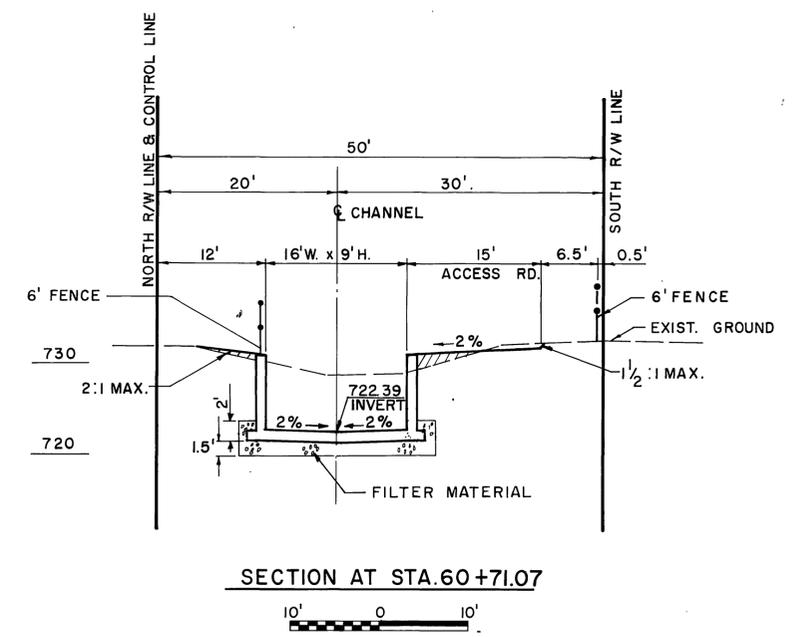

PLAN  
 1" = 20'  
 20' 0 20'

BENCH MARK C.P. NO. 31  
 1" I.P. ON NORTH R/W OF  
 CHANNEL AT E.C.  
 ELEV. 731.938  
 SCALE:  
 DATE:

APPROVED BY  
**AS**  
 ALDERMAN SWIFT & LEWIS  
 CONSULTING ENGINEERS  
 REGISTERED CIVIL ENGINEER  
 NO. 11843

NO.	DESCRIPTION	DATE
1	20' Swale Added	11/27/77


DESIGNED BY: K.E.K.  
 DRAWN BY: R.D.F.  
 DATE DRAWN: OCT. 1973  
 CHECKED BY: R.D.C., G.L.H.

RIVERSIDE COUNTY FLOOD CONTROL AND WATER CONSERVATION DISTRICT  
 APPROVED BY:  
**John W. Boyce**  
 CHIEF ENGINEER R.E. NO. 8822  
 DATE: 3-4-75

ANZA CHANNEL  
 STAGE I  
 STA. 59+00 TO STA. 62+40  
 1970 STORM DRAIN BOND ISSUE PROJECT NO. 18

PROJECT NO. 1-0-150  
 DRAWING NO. 1-302  
 SHEET NO. 15 OF 78



AS BUILT

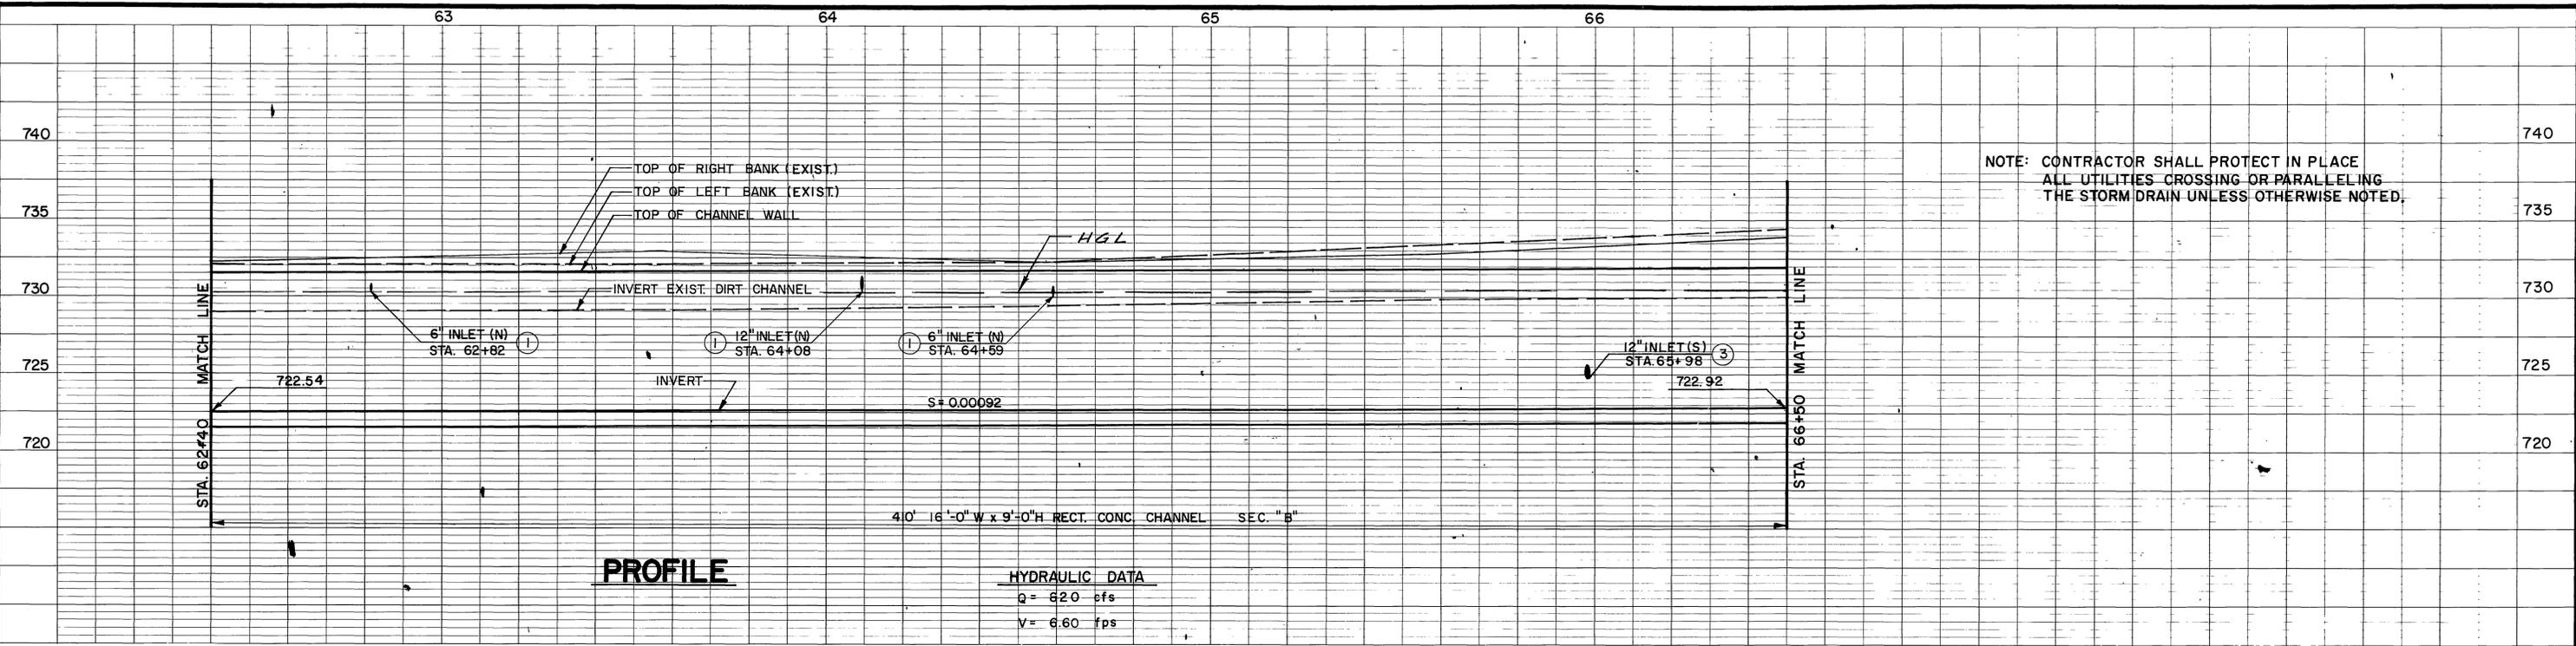

NOTE: CONTRACTOR SHALL PROTECT IN PLACE ALL UTILITIES CROSSING OR PARALLELING THE STORM DRAIN UNLESS OTHERWISE NOTED.


**PROFILE**

**HYDRAULIC DATA**  
 Q = 620 cfs  
 V = 6.60 fps

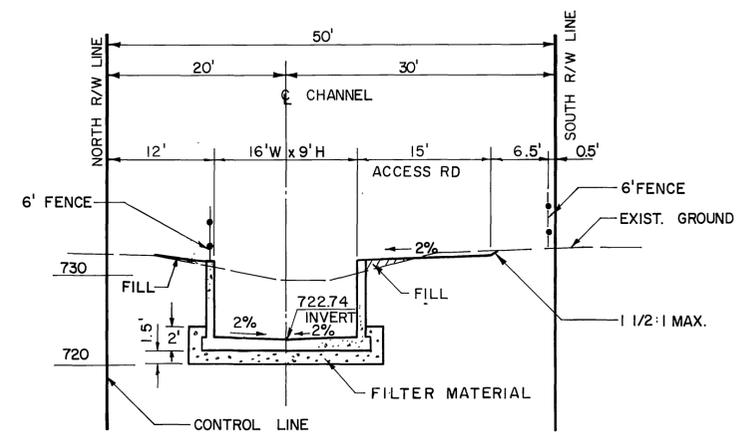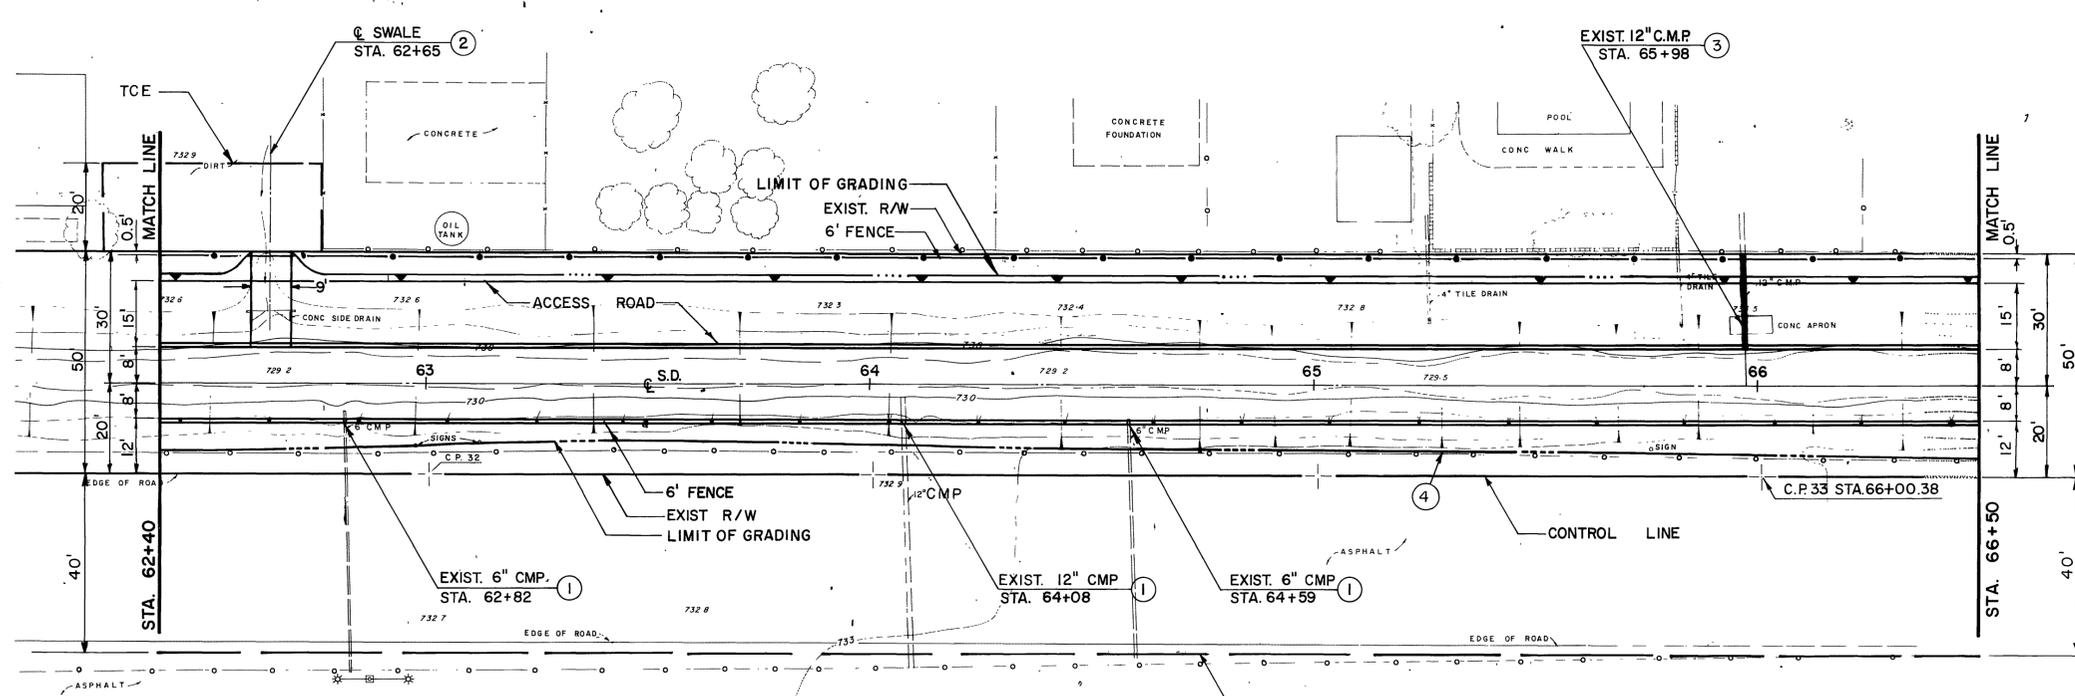

**SECTION AT STA. 64+52**

- ① CONNECT EXIST. PIPE INTO CHANNEL WALL.
- ② REMOVE EXIST. APRON & WALL AND CONSTRUCT A.C. SWALE SEE DETAIL ON SHEET NO. 26
- ③ REMOVE INTERFERING PORTIONS OF EXIST. 12" C.M.P. AND CONNECT 20'-12" R.C.P. CL. IV INTO CHANNEL WALL FOR PROFILE SEE SHEET NO. 23
- ④ REMOVE EXISTING FENCE

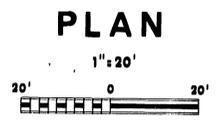

BENCH MARK C.P. 32  
 NAIL AND TIN ON NORTHERLY  
 R/W 230' ± WEST OF E.C.  
 ELEV. 732.69  
 SCALE:  
 DATE:

APPROVED BY  
 DATE April 26, 1974  
**ALDERMAN SWIFT & LEWIS**  
 CONSULTING ENGINEERS  
 REGISTERED CIVIL ENGINEER  
 NO. 11645



REF.	DESCRIPTION	APPR. DATE
	No Change	

REVISIONS  
 RIVERSIDE COUNTY FLOOD CONTROL AND WATER CONSERVATION DISTRICT  
 DESIGNED BY: K.E.K.  
 DRAWN BY: E.G.H.  
 DATE DRAWN: OCT. 1973  
 CHECKED BY: R.D.C., G.L.H.  
 APPROVED BY:  
 DATE 3-6-75  
 CHIEF ENGINEER R.E. NO. 8822



**ANZA CHANNEL**  
**STAGE I**  
 STA. 62+40 TO STA. 66+50  
 1970 STORM DRAIN BOND ISSUE PROJECT NO. 18

PROJECT NO. 1-0-150  
 DRAWING NO. 1-302  
 SHEET NO. 16 OF 78


AS BUILT

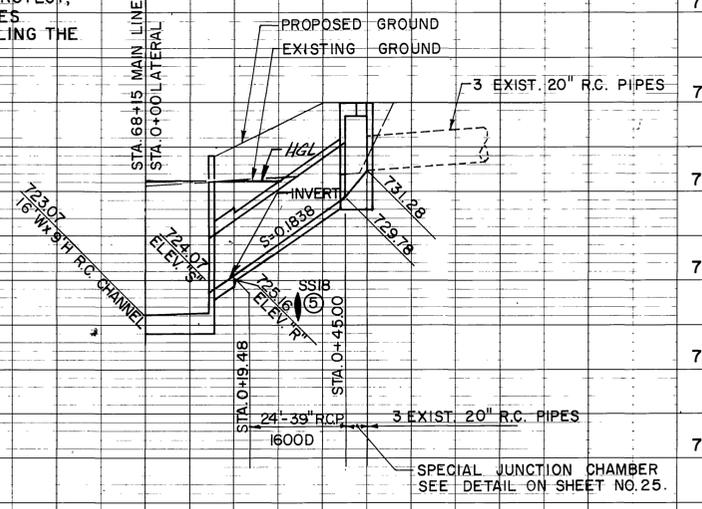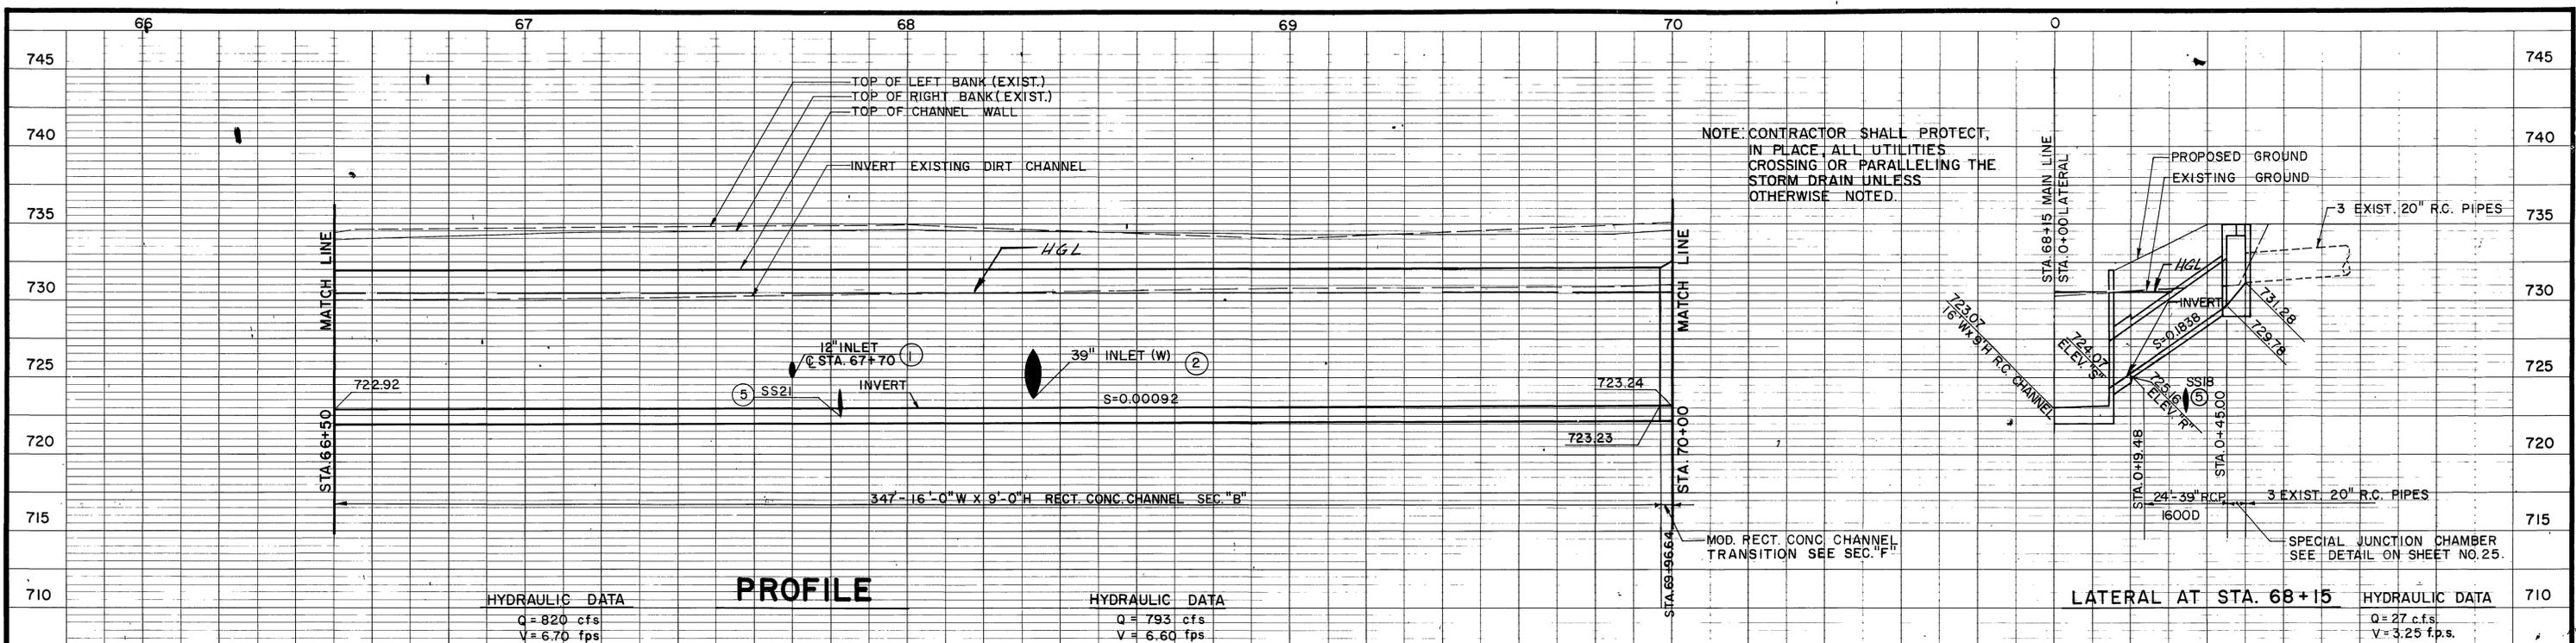

HYDRAULIC DATA	<b>PROFILE</b>	HYDRAULIC DATA	LATERAL AT STA. 68+15	HYDRAULIC DATA
Q = 820 cfs V = 6.70 fps		Q = 793 cfs V = 6.60 fps		Q = 27 c.f.s V = 3.25 f.p.s.

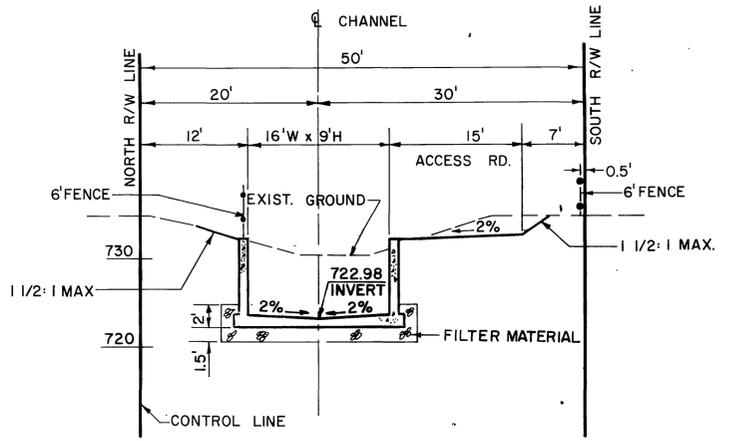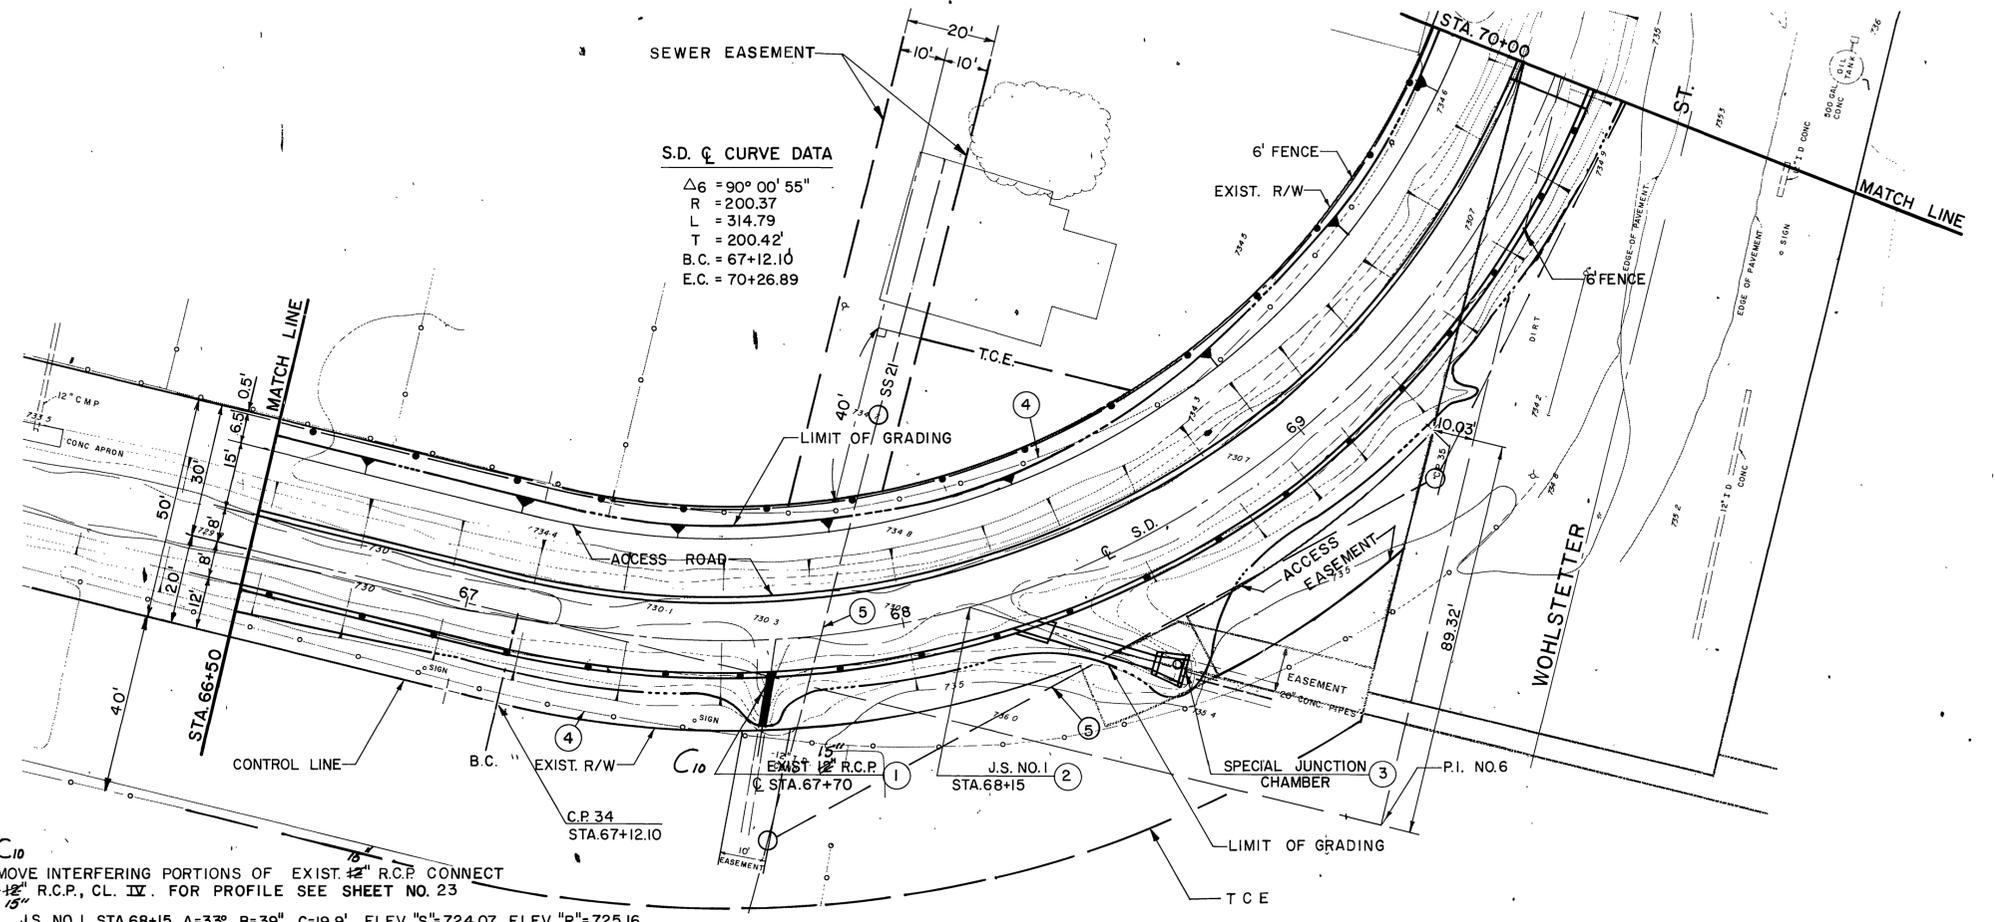

- 1 REMOVE INTERFERING PORTIONS OF EXIST. 12" R.C.P. CONNECT 12"-12" R.C.P., CL. IV. FOR PROFILE SEE SHEET NO. 23
- 2 J.S. NO. 1, STA. 68+15, A=33', B=39', C=19.9', ELEV. "S" = 724.07, ELEV. "R" = 725.16, SEE PROFILE THIS SHEET.
- 3 SPECIAL JUNCTION CHAMBER 24'-39" R.C.P., 1600 D SEE PROFILE THIS SHEET, SEE DETAIL ON SHEET NO. 25.
- 4 REMOVE EXISTING FENCE.
- 5 SEWER RELOCATION DETAIL SHEET NO. 29.

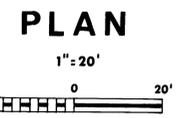

BENCH MARK C.P. NO. 34  
1" I.P. ON NORTHERLY R/W OF  
CHANNEL AT B.C.  
ELEV. 734.77  
SCALE:  
DATE:

APPROVED BY  
**AS**  
ALDERMAN  
SWIFT  
& LEWIS  
CONSULTING  
ENGINEERS  
REGISTERED CIVIL ENGINEER  
NO. 14543




REVISIONS	DESCRIPTION	DATE
1	Change as shown	4/26/74

RIVERSIDE COUNTY FLOOD CONTROL  
AND  
WATER CONSERVATION DISTRICT  
DESIGNED BY: T.V.P.  
DRAWN BY: E.C.H.  
DATE DRAWN: OCT. 1973  
CHECKED BY: R.D.C.-GLH.

ANZA CHANNEL  
STAGE I  
STA. 66+50 TO STA. 70+00  
1970 STORM DRAIN BOND ISSUE PROJECT NO. 18

PROJECT NO.  
1-0-150  
DRAWING NO.  
1-302  
SHEET NO.  
17 OF 78

AS BUILT

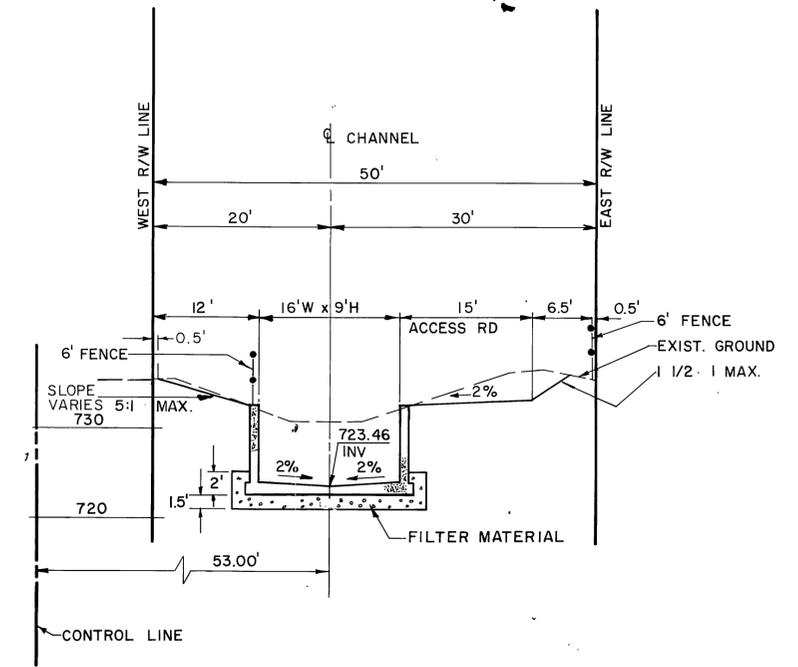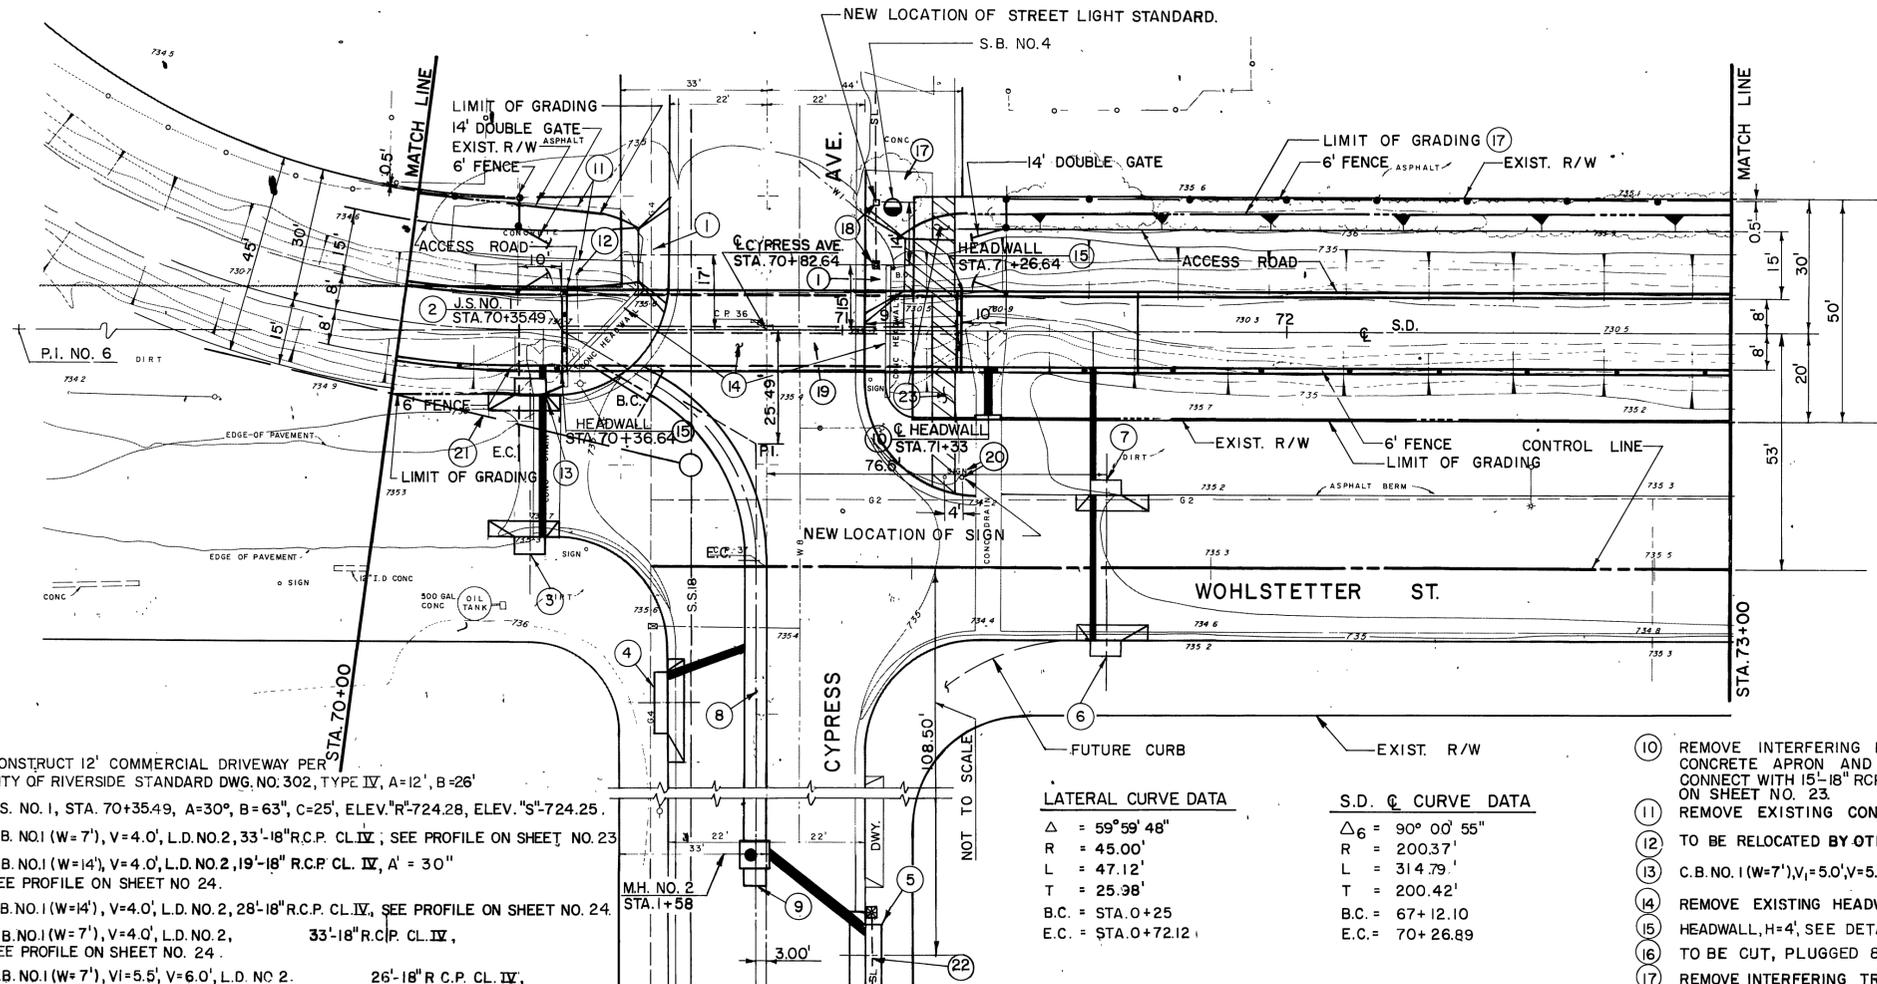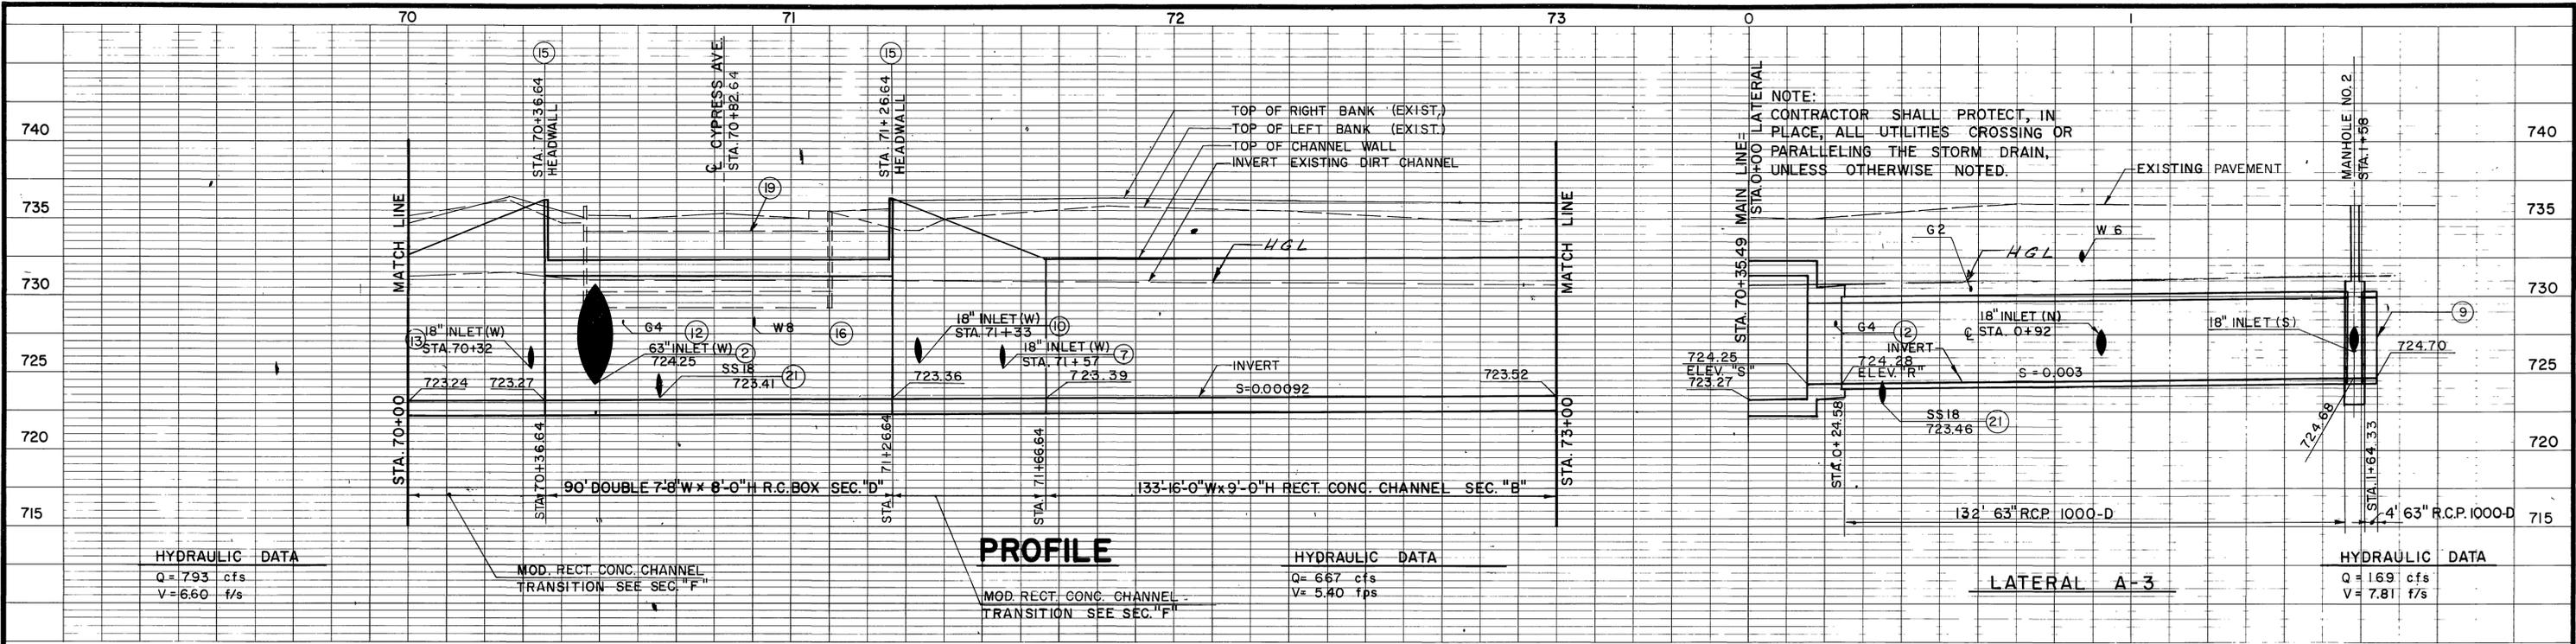

- 1 CONSTRUCT 12' COMMERCIAL DRIVEWAY PER CITY OF RIVERSIDE STANDARD DWG. NO. 302, TYPE IV, A=12', B=26'
- 2 J.S. NO. 1, STA. 70+35.49, A=30°, B=63", C=25', ELEV. "R"-724.28, ELEV. "S"-724.25
- 3 C.B. NO.1 (W=7'), V=4.0', L.D. NO.2, 33'-18" R.C.P. CL. IV; SEE PROFILE ON SHEET NO. 23
- 4 C.B. NO.1 (W=14'), V=4.0', L.D. NO.2, 19'-18" R.C.P. CL. IV, A' = 30" SEE PROFILE ON SHEET NO. 24.
- 5 C.B. NO.1 (W=14'), V=4.0', L.D. NO.2, 28'-18" R.C.P. CL. IV, SEE PROFILE ON SHEET NO. 24.
- 6 C.B. NO.1 (W=7'), V=4.0', L.D. NO.2, 33'-18" R.C.P. CL. IV, SEE PROFILE ON SHEET NO. 24.
- 7 C.B. NO.1 (W=7'), V=5.5', V=6.0', L.D. NO.2, 26'-18" R.C.P. CL. IV, SEE PROFILE ON SHEET NO. 24.
- 8 6" RCP SEE PROFILE THIS SHEET.
- 9 SEAL END WITH CONC. BULKHEAD. SEE DETAIL ON SHEET NO. 26.

**LATERAL CURVE DATA**

Δ = 59° 59' 48"

R = 45.00'

L = 47.12'

T = 25.98'

B.C. = STA. 0+25

E.C. = STA. 0+72.12

**S.D. @ CURVE DATA**

Δ = 90° 00' 55"

R = 200.37'

L = 314.79'

T = 200.42'

B.C. = 67+12.10

E.C. = 70+26.89

- 10 REMOVE INTERFERING PORTIONS OF EXISTING CONCRETE APRON AND CONSTRUCT CONC. HEADWALL. CONNECT WITH 15'-18" RCP CL. IV. SEE DETAIL & PROFILE ON SHEET NO. 23.
- 11 REMOVE EXISTING CONCRETE APRON.
- 12 TO BE RELOCATED BY OTHERS. SEE SPECIAL PROVISIONS FOR G4 DETAILS.
- 13 C.B. NO.1 (W=7'), V=5.0', V=5.5', L.D. NO.2, 4'-18" R.C.P. CL. IV SEE PROFILE ON SHEET NO. 23.
- 14 REMOVE EXISTING HEADWALL AND BOX CULVERT
- 15 HEADWALL, H=4', SEE DETAIL ON SHEET NO. 26
- 16 TO BE CUT, PLUGGED & RELOCATED BY OTHERS. SEE SPECIAL PROVISIONS.
- 17 REMOVE INTERFERING TREES AND SHRUBS.
- 18 RELOCATE STREET LIGHT STANDARD TO LOCATION SHOWN HEREON.
- 19 CONSTRUCT 3" A.C. & 6" AGGREGATE BASE ON COMPACTED FILL. JOIN EXIST. PAVEMENT GRADE AT EACH SIDE OF R.C. BOX.
- 20 RELOCATE SIGN TO LOCATION SHOWN HEREON.
- 21 SS18 RELOCATION DETAIL SHEET NO. 29.
- 22 RELOCATE SL AROUND CB
- 23 CONSTRUCT NEW 5' SIDEWALK. D-294

BENCH MARK C.P. 37 BRASS DISK DOWN 0.25' AT THE INTERSECTION OF WOHLSTETTER ST. AND CYPRESS AVE. ELEV. 736.35

SCALE: 1" = 20'

APPROVED BY: ALDERMAN SWIFT & LEWIS CONSULTING ENGINEERS

DATE: April 24, 1974

REGISTERED CIVIL ENGINEER NO. 17543

REVISIONS

RIVERSIDE COUNTY FLOOD CONTROL AND WATER CONSERVATION DISTRICT

DESIGNED BY: T.V.P.

DRAWN BY: E.C.H.

DATE DRAWN: OCT. 1973

CHECKED BY: R.D.C. GLH.

APPROVED BY: [Signature]

CHIEF ENGINEER R.E. NO. 8822

DATE: 3-4-75

ANZA CHANNEL STAGE I

STA. 70+00 TO STA. 73+00

1970 STORM DRAIN BOND ISSUE PROJECT NO. 18


PROJECT NO. 1-0-150

DRAWING NO. 1-302

SHEET NO. 18 OF 78



AS BUILT



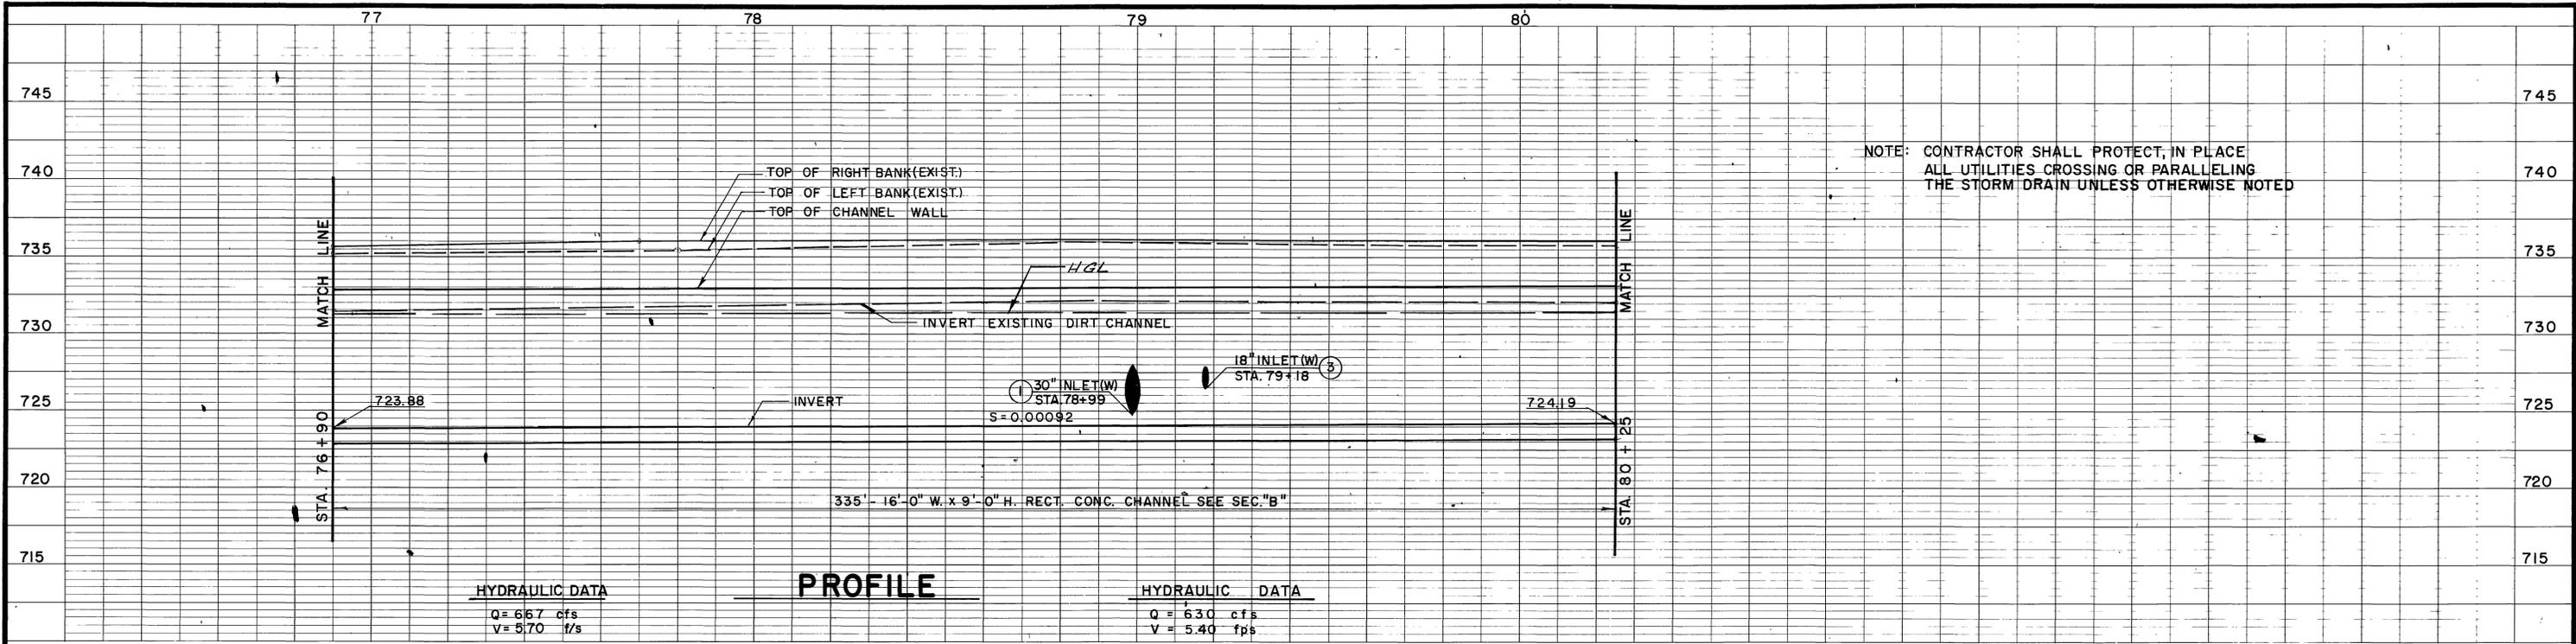

NOTE: CONTRACTOR SHALL PROTECT, IN PLACE ALL UTILITIES CROSSING OR PARALLELING THE STORM DRAIN UNLESS OTHERWISE NOTED

HYDRAULIC DATA	PROFILE	HYDRAULIC DATA
Q = 667 cfs		Q = 630 cfs
V = 5.70 f/s		V = 5.40 f/s

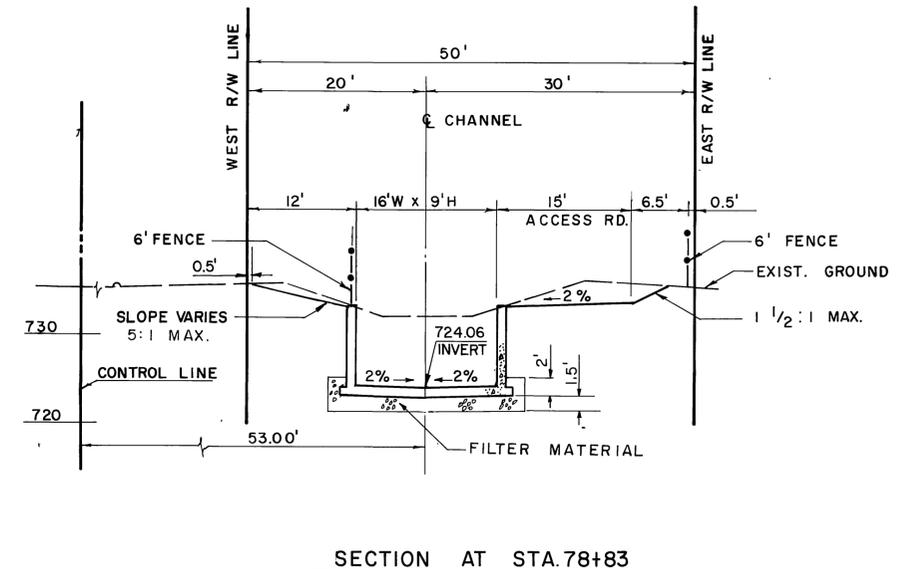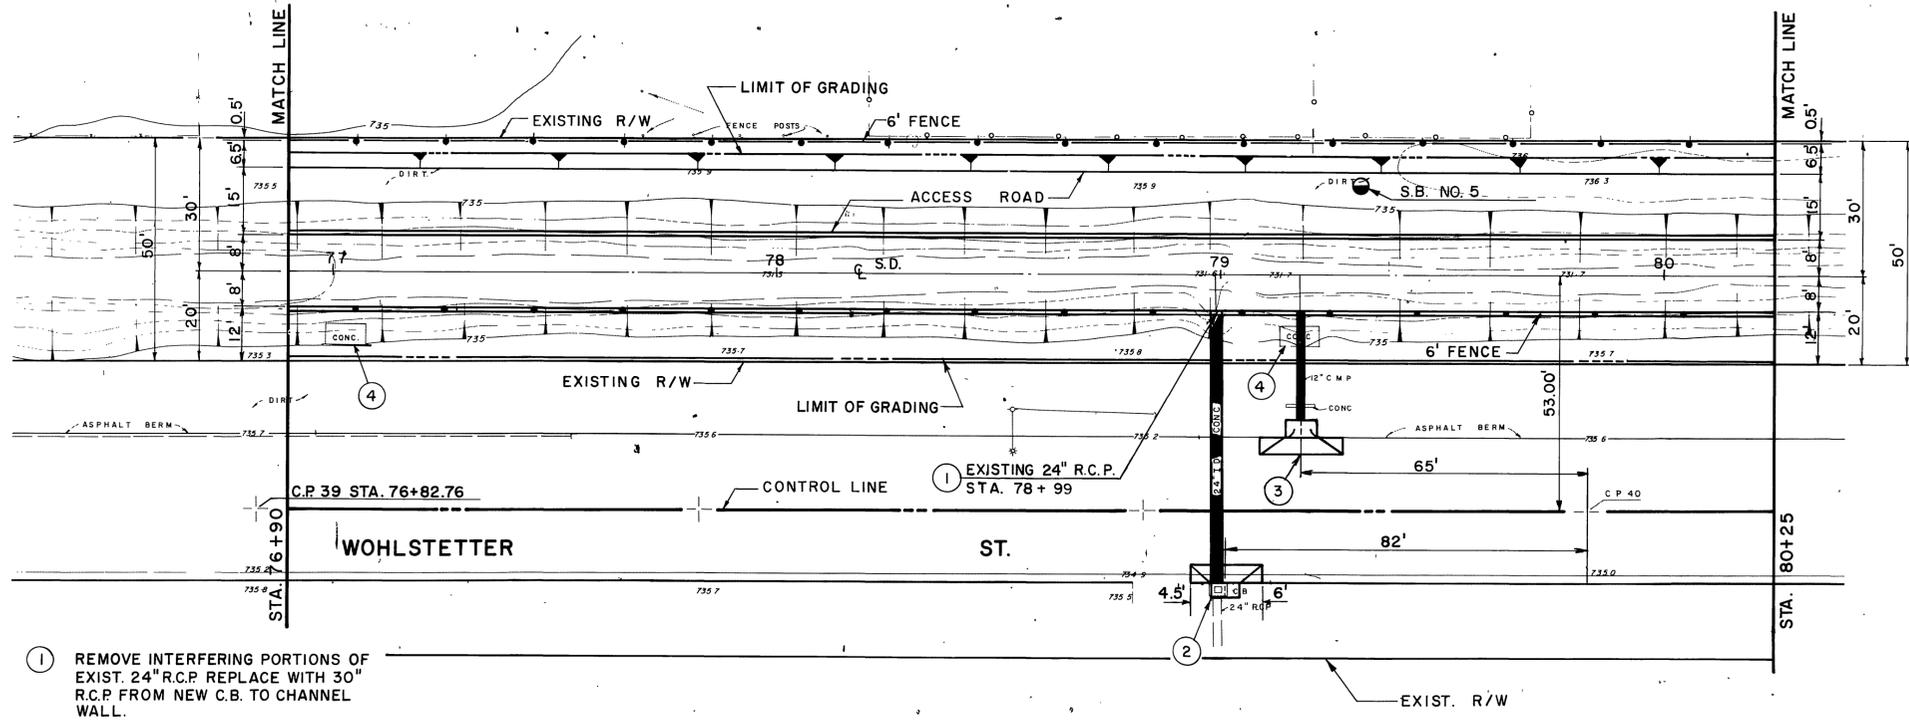

SECTION AT STA. 78+83



- ① REMOVE INTERFERING PORTIONS OF EXIST. 24" R.C.P. REPLACE WITH 30" R.C.P. FROM NEW C.B. TO CHANNEL WALL.
- ② REMOVE EXIST. C.B., CONST. C.B. NO. 1, W=7', V1=3.0', V=5.0', L.D. NO. 2, CASE C. 62'-30" R.C.P., 1800 D. CONNECT 24" RCP TO REAR OF C.B. FOR PROFILE SEE SHEET NO. 24.
- ③ REMOVE EXIST. INLET AND EXIST. 12" C.M.P. CONST. C.B. NO. 1, W=7', V=4.0', L.D. NO. 2, CASE C, 26'-18" R.C.P., C.L. IV FOR PROFILE SEE SHEET NO. 24.
- ④ REMOVE EXISTING CONCRETE APRON & WALL

**PLAN**



BENCH MARK C.P. 39  
NAIL AND TIN ON CENTERLINE  
OF WOHLSTETTER ST. 600±  
SOUTH OF CYPRESS.  
ELEV. 736.805

APPROVED BY  
DATE *April 24, 1972*

**AAS**  
ALDERMAN  
SWIFT  
& LEWIS  
CONSULTING  
ENGINEERS

REGISTERED CIVIL ENGINEER  
NO. 11843

REVISIONS	DESCRIPTION	DATE
	No Change	

RIVERSIDE COUNTY FLOOD CONTROL AND WATER CONSERVATION DISTRICT

DESIGNED BY: T.V.P.  
DRAWN BY: R.D.F.  
DATE DRAWN: OCT. 1973

APPROVED BY:  
*[Signature]*  
CHIEF ENGINEER W.E. NO. 8822




CHECKED BY: R.D.C., G.L.H.  
DATE: *3-4-75*

**ANZA CHANNEL**  
STAGE I  
STA. 76+90 TO STA. 80+25  
1970 STORM DRAIN BOND ISSUE PROJECT NO. 18

PROJECT NO. 1-0-150  
DRAWING NO. 1-302  
SHEET NO. 20 OF 78

AS BUILT

D-294

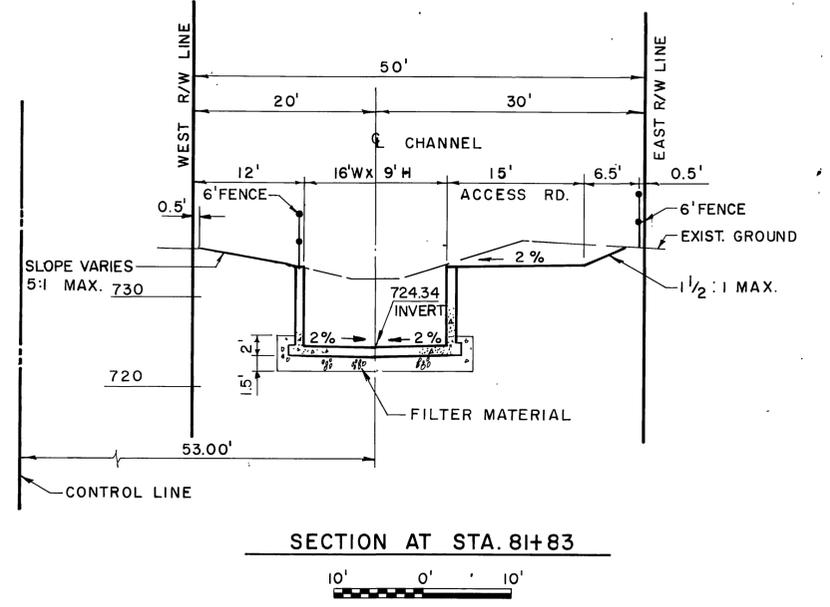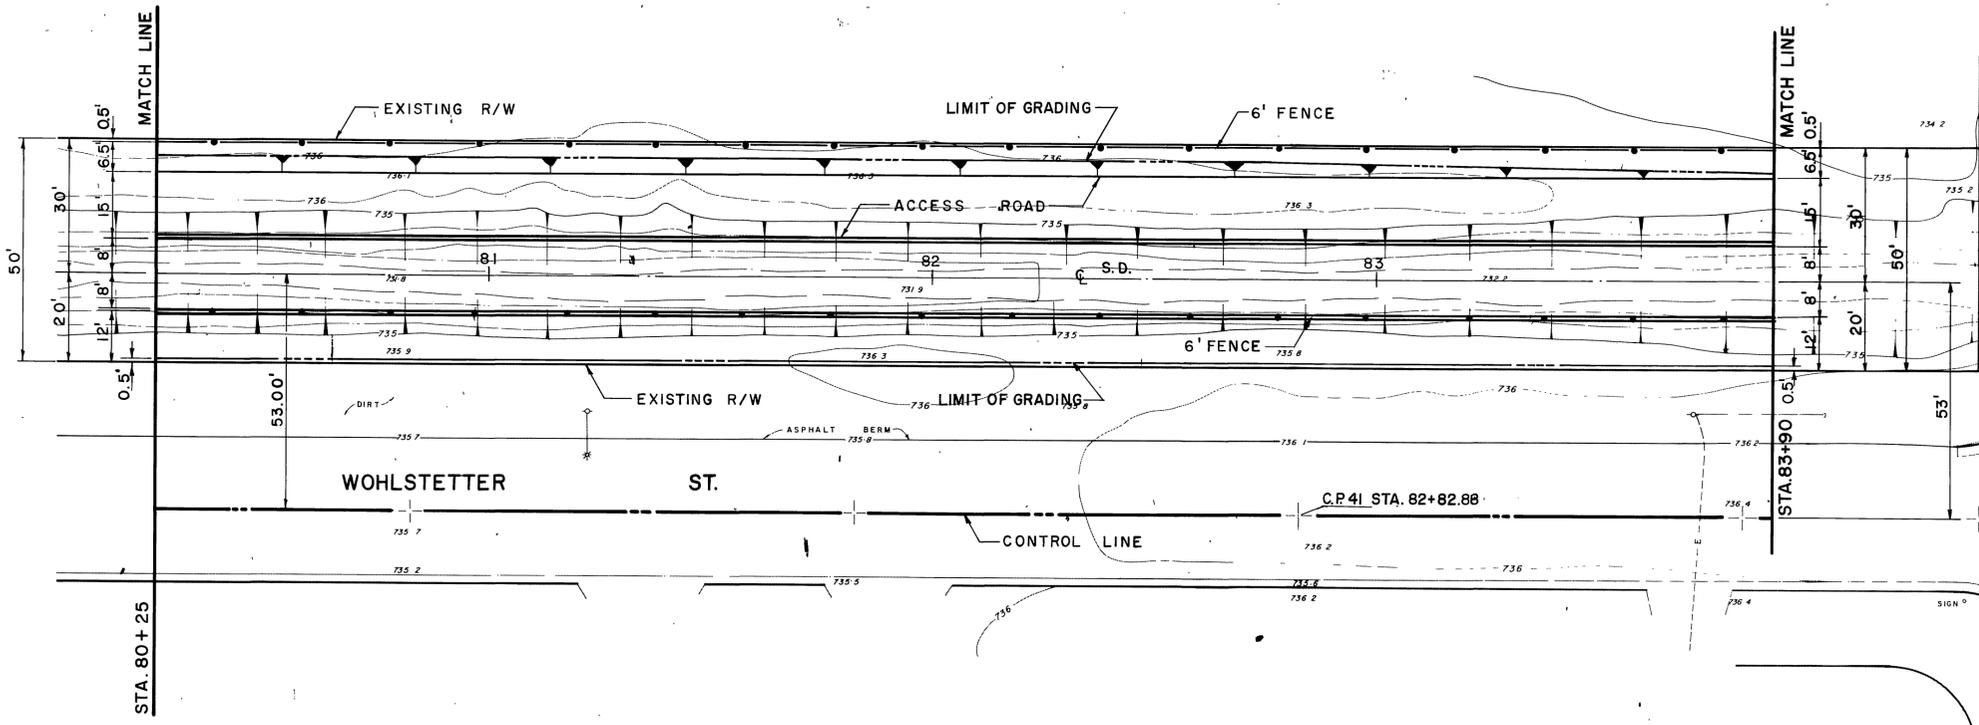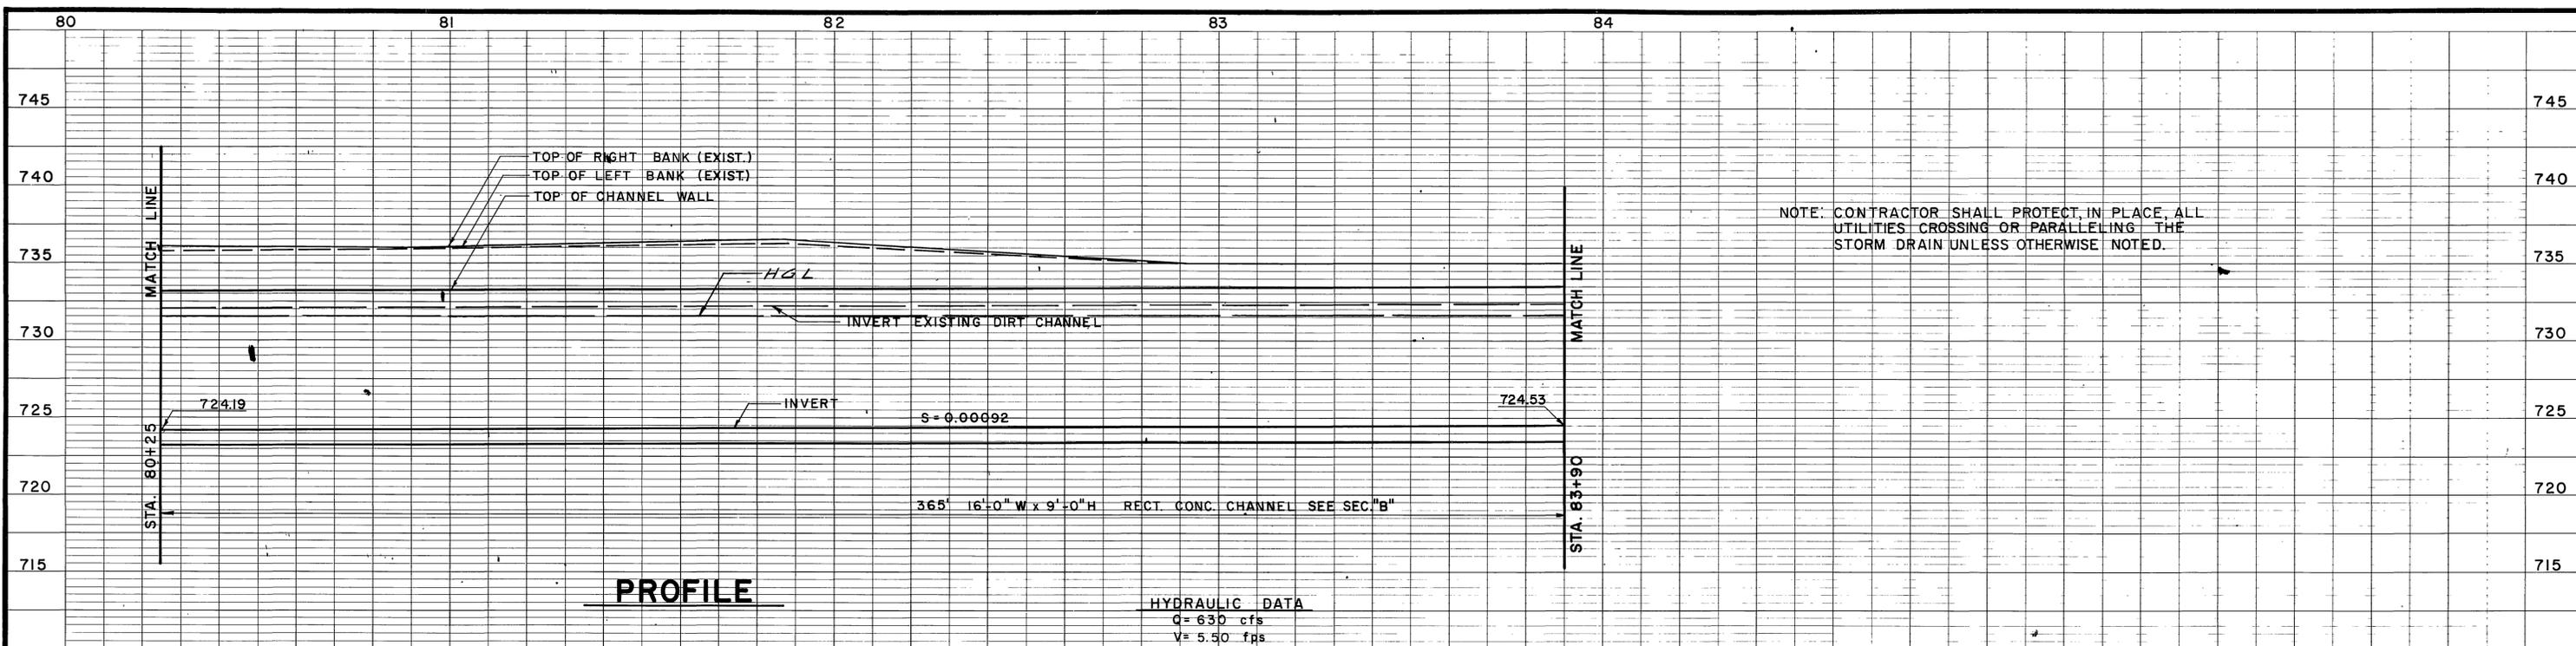

**PLAN**  
 1" = 20'  
 20' 0' 20'

BENCH MARK C.P. 41  
 NAIL AND TIN ON CENTERLINE OF  
 WOHLSTETTER ST. 193' ± NORTH  
 OF PHILBIN AVE.  
 EL. 736.19

**AS**  
 ALDERMAN SWIFT & LEWIS  
 CONSULTING ENGINEERS  
 REGISTERED CIVIL ENGINEER  
 NO. 11543

REF.	DESCRIPTION	APPR.	DATE
	No Change		

APPROVED BY: *[Signature]* DATE: April 22, 1974

DESIGNED BY: K.E.K.  
 DRAWN BY: R.D.F.  
 DATE DRAWN: OCT. 1973

APPROVED BY: *[Signature]*  
 CHIEF ENGINEER R.E. NO. 8822  
 DATE: 3-4-75

CHECKED BY: R.D.C., G.L.H.



**RIVERSIDE COUNTY FLOOD CONTROL AND WATER CONSERVATION DISTRICT**

ANZA CHANNEL  
 STAGE I  
 STA. 80+25 TO STA. 83+90  
 1970 STORM DRAIN BOND ISSUE PROJECT NO. 18


PROJECT NO. 1-0-150  
 DRAWING NO. 1-302  
 SHEET NO. 21 OF 78

AS BUILT

D-294

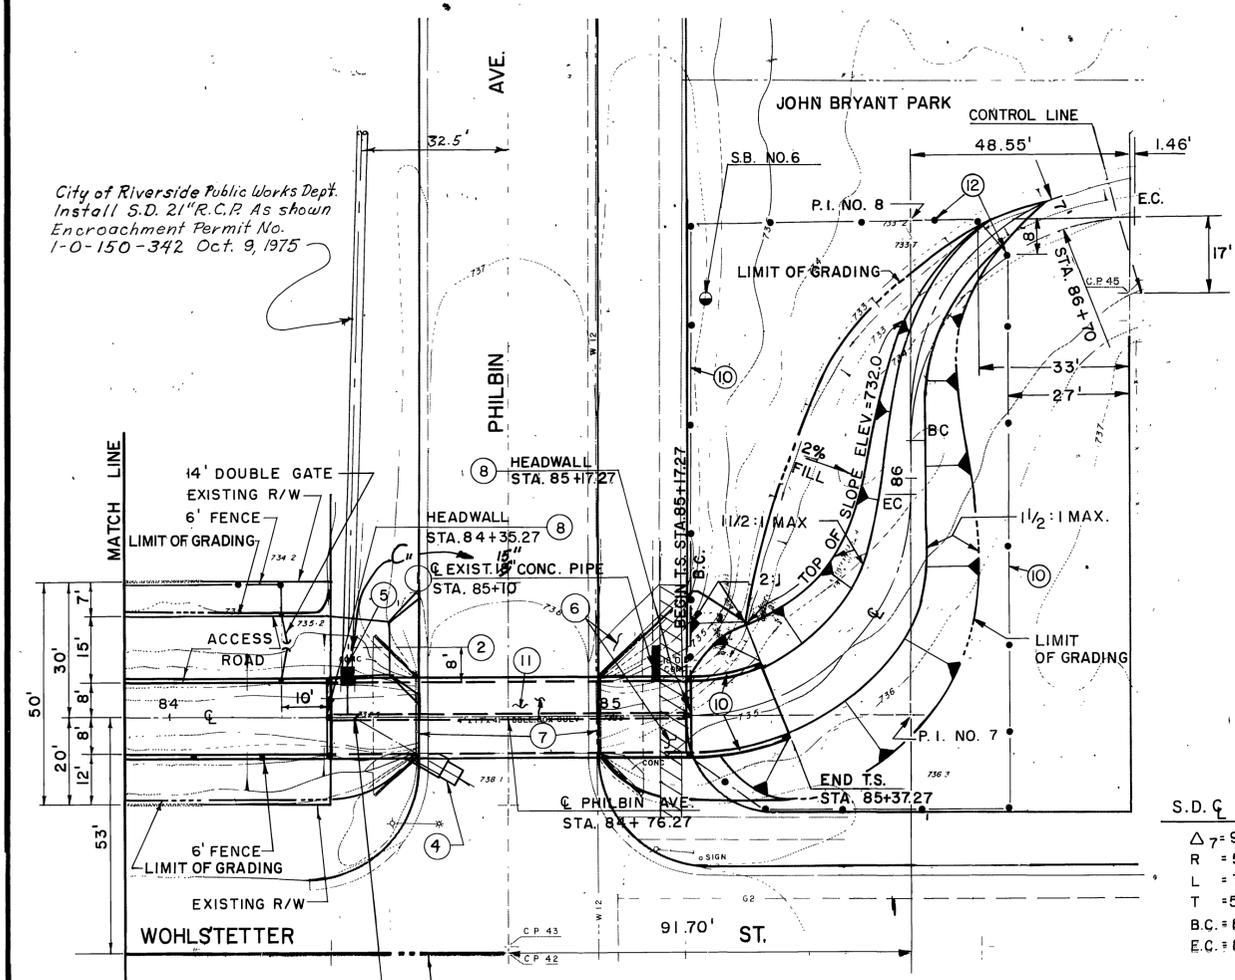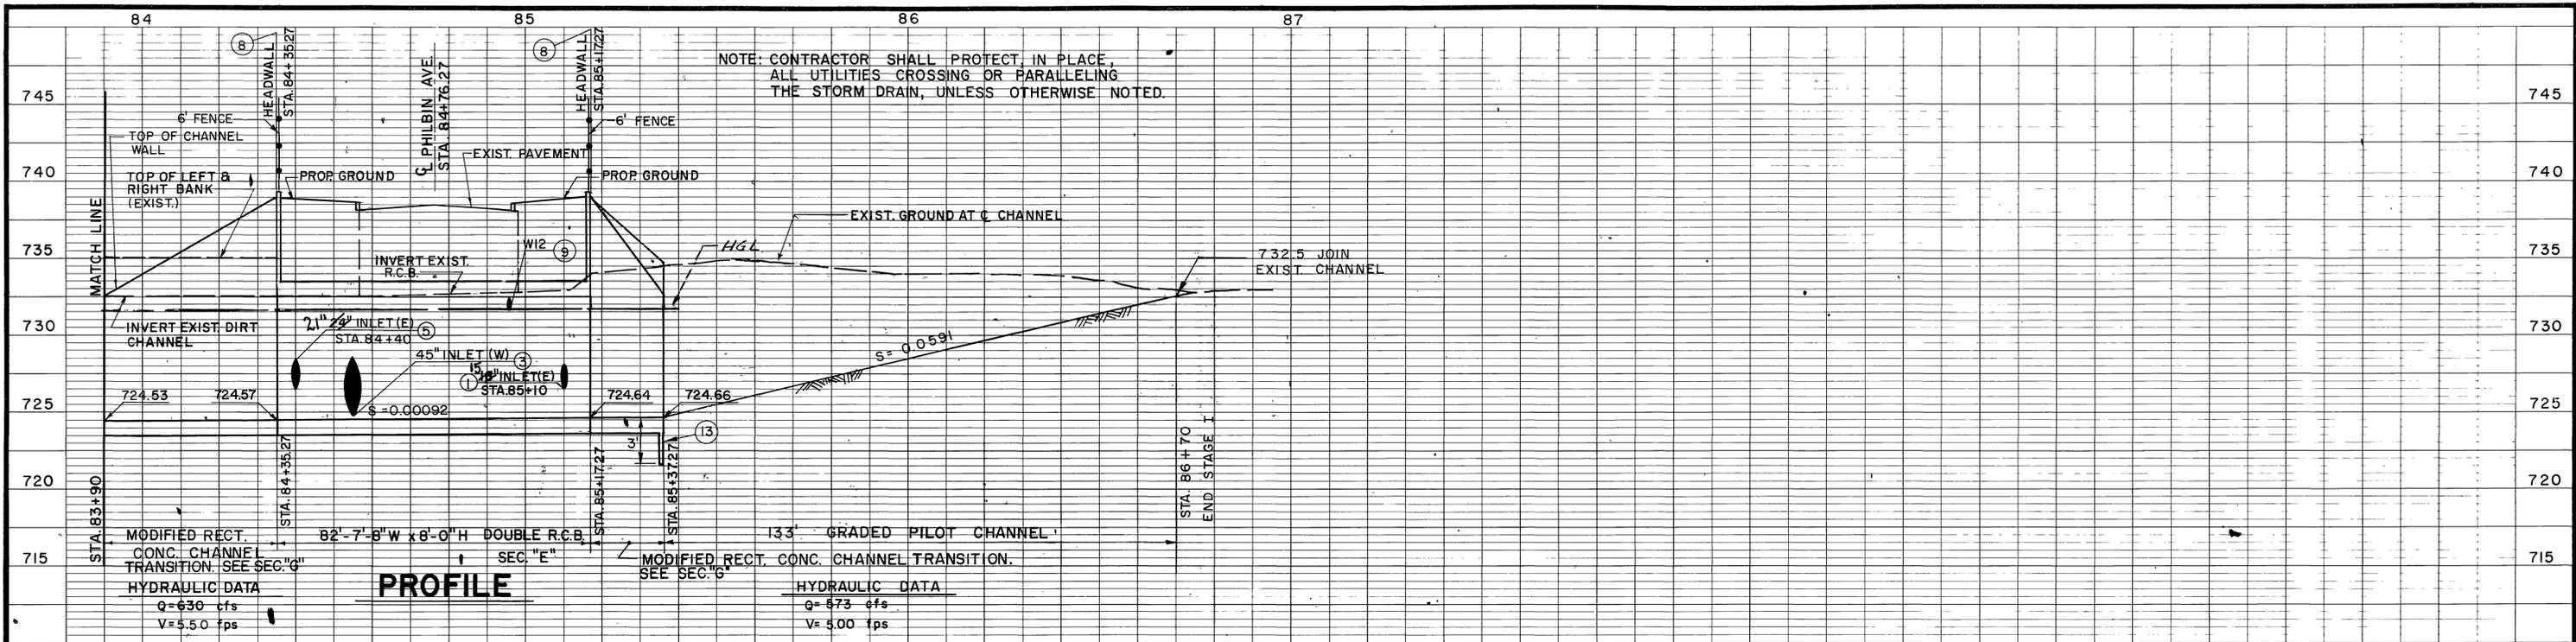

- ① REMOVE INTERFERING PORTIONS OF EXIST. 18" R.C.P. & CONNECT 12" R.C.P. CL. IV INTO R.C. BOX SEE PROFILE ON SHEET NO. 24
- ② CONSTRUCT 12' COMMERCIAL DRIVEWAY PER CITY OF RIVERSIDE STANDARD DWG. 302, TYPE IV, A=12', B=26'
- ③ J.S. NO. 1, STA. 84+40.27, A=30° B=45", C=23.4', ELEV. "R"=724.93 ELEV. "S"=724.92
- ④ 4'-45" R.C.P. 1100-D, ELEV. AT END 724.94 SEAL END OF PIPE WITH CONC. BULKHEAD. SEE DETAIL ON SHEET NO. 26.
- ⑤ 4'-21" R.C.P. CL. III, END ELEV. 726.58, ELEV. "S"=726.57 PLUG END OF PIPE.
- ⑥ REMOVE EXISTING SIDEWALK BACK TO ANGLE POINT. CONSTRUCT NEW 5' WIDE SIDEWALK TO CONNECT DIRECTLY TO EXISTING SIDEWALK ALONG WOHLSTETTER ST.
- ⑦ REMOVE EXIST. HEADWALLS & BOX CULVERT
- ⑧ HEADWALL, H=6'-0" SEE DETAIL ON SHEET NO. 26.
- ⑨ TO BE CUT AND PLUGGED & RELOCATED BY OTHERS. BYPASS MUST BE PROTECTED IN SERVICE. SEE SPECIAL PROVISIONS.
- ⑩ CONSTRUCT 6' CHAIN LINK FENCE

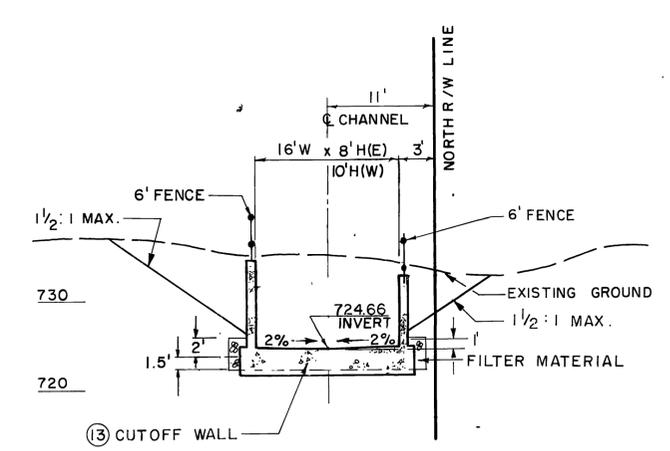

S.D. CURVE DATA	S.D. CURVE DATA
Δ 7 = 90° 00' 56"	Δ 8 = 90° 00' 22"
R = 50.00'	R = 50.00'
L = 78.55'	L = 78.55'
T = 50.01'	T = 50.01'
B.C. = 85+17.96	B.C. = 86+07.88
E.C. = 85+98.51	E.C. = 86+86.43

- ⑪ CONST. 3" A.C. & 6" AGGREGATE BASE ON COMPACTED FILL. JOIN EXIST. PAVEMENT GRADE ON EACH SIDE OF EXCAVATION
- ⑫ RAISE CHAIN LINK FABRIC 18" ABOVE E.L. PROVIDE HORIZONTAL BARBED WIRE STRAND @ 6" AND 12" ABOVE E.L.
- ⑬ 12" THICK CUTOFF WALL. SEE DETAIL SHEET NO. 26.

**PLAN**



BENCH MARK C.P. 42  
BRASS DISK 0.16 DOWN AT  
INTERSECTION OF WOHLSTETTER  
AND PHILBIN NORTH. EL. 737.429

SCALE:  
DATE:

APPROVED BY  
**ALDERMAN SWIFT & LEWIS**  
REGISTERED CIVIL ENGINEER  
NO. 11843

DATE: April 26, 1974

REVISIONS	DESCRIPTION	APPR. DATE
1	Change Size R.C.P. as shown	4/24/74

RIVERSIDE COUNTY FLOOD CONTROL AND WATER CONSERVATION DISTRICT

DESIGNED BY: T.V.P.  
DRAWN BY: R.D.F.  
DATE DRAWN: OCT. 1973

APPROVED BY:  
*John W. Bussant*  
CHIEF ENGINEER R.E. NO. 8822

DATE: 3-4-75




**ANZA CHANNEL**  
STAGE I

STA. 83+90 TO STA. 86+90,  
1970 STORM DRAIN BOND ISSUE PROJECT NO. 18

PROJECT NO  
1-0-150

DRAWING NO.  
1-302



SHEET NO.  
22 OF 78

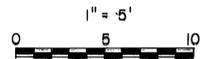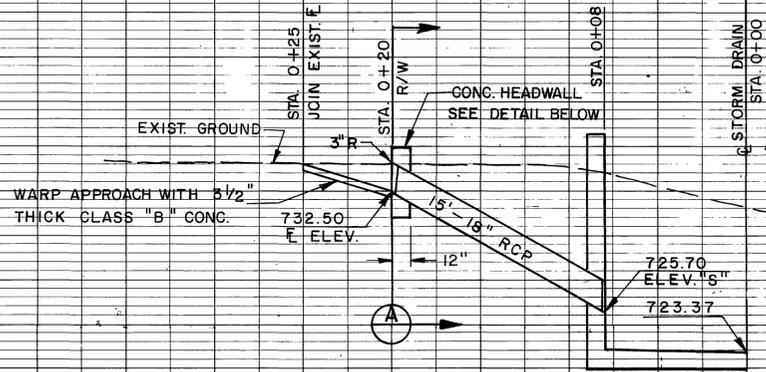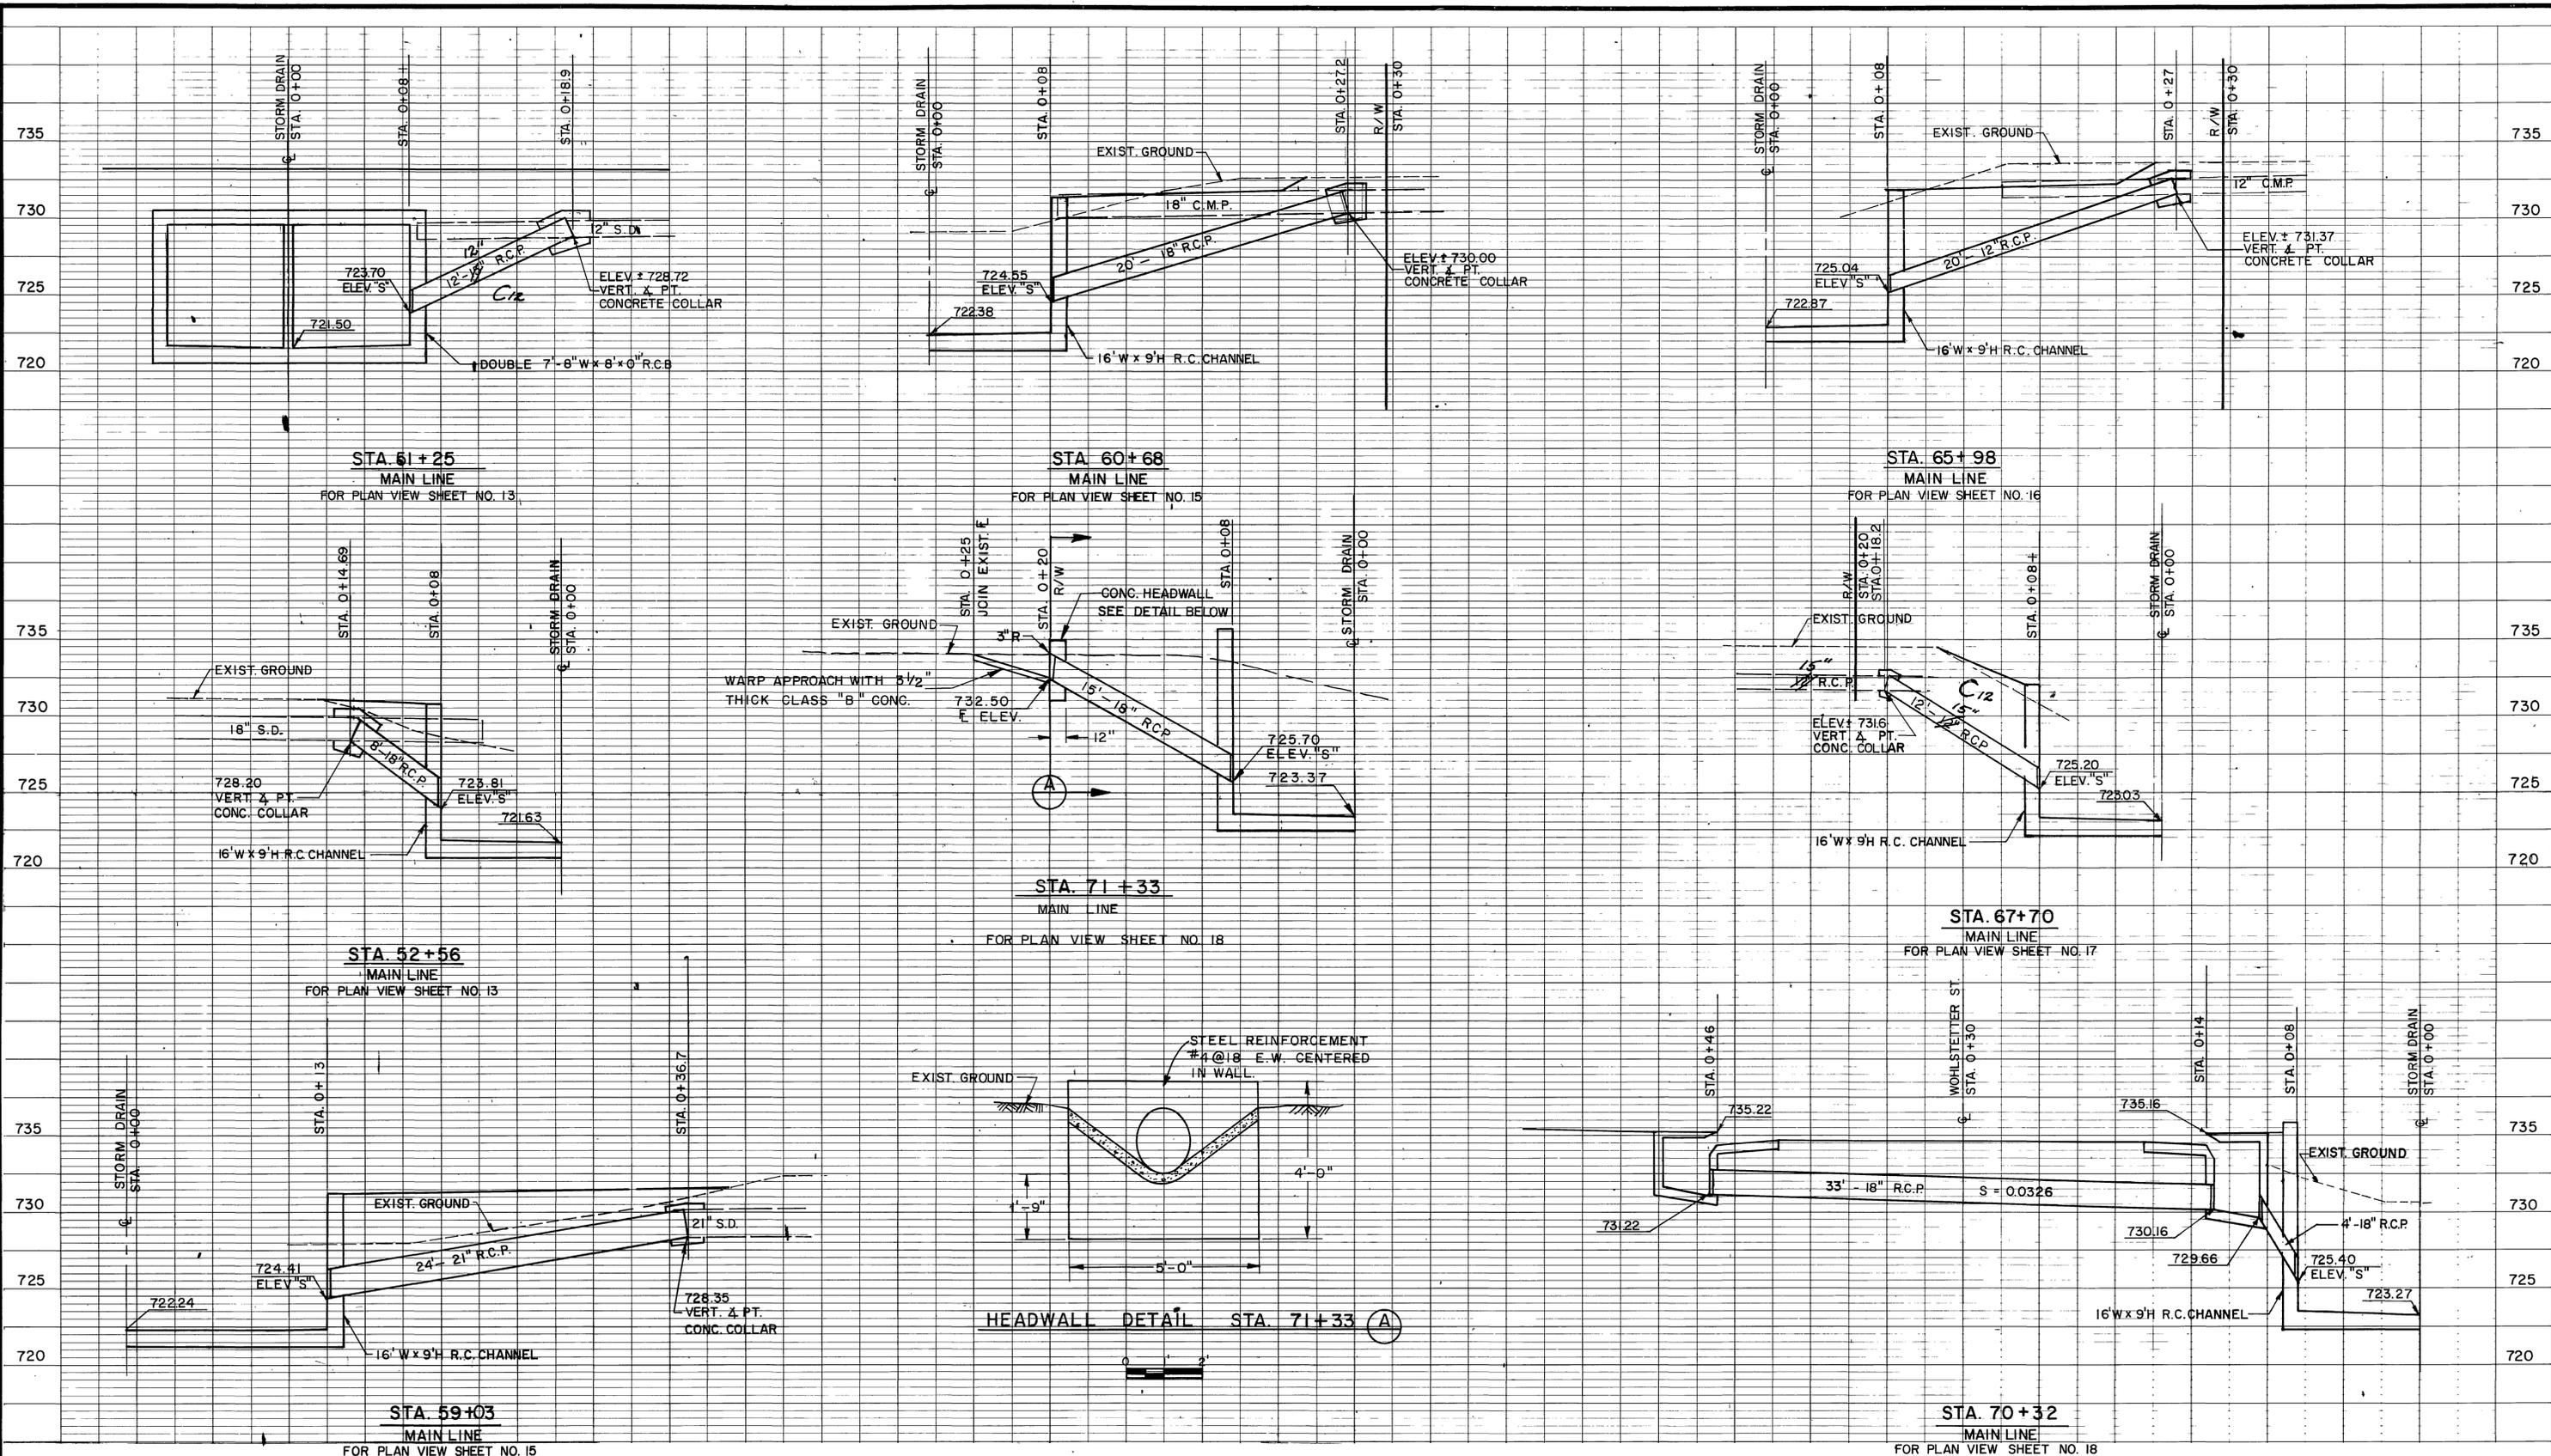

BENCH MARK		APPROVED BY	REVISIONS	RIVERSIDE COUNTY FLOOD CONTROL AND WATER CONSERVATION DISTRICT DESIGNED BY: K.K. DRAWN BY: A.W.S. DATE DRAWN: OCT. 1973 CHECKED BY: R.D.C.	ANZA CHANNEL STAGE I CONNECTOR PIPE PROFILE 1970 STORM DRAIN BOND ISSUE PROJECT NO. 18	PROJECT NO.
		DATE: April 24, 1974	C.R. REF. R.C.P. Change - size DESCRIPTION APPR. DATE: 10/6/70			APPROVED BY: [Signature] CHIEF ENGINEER R.E. NO. 8822 DATE: 3-4-75

AS BUILT


D-294

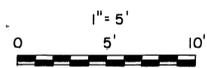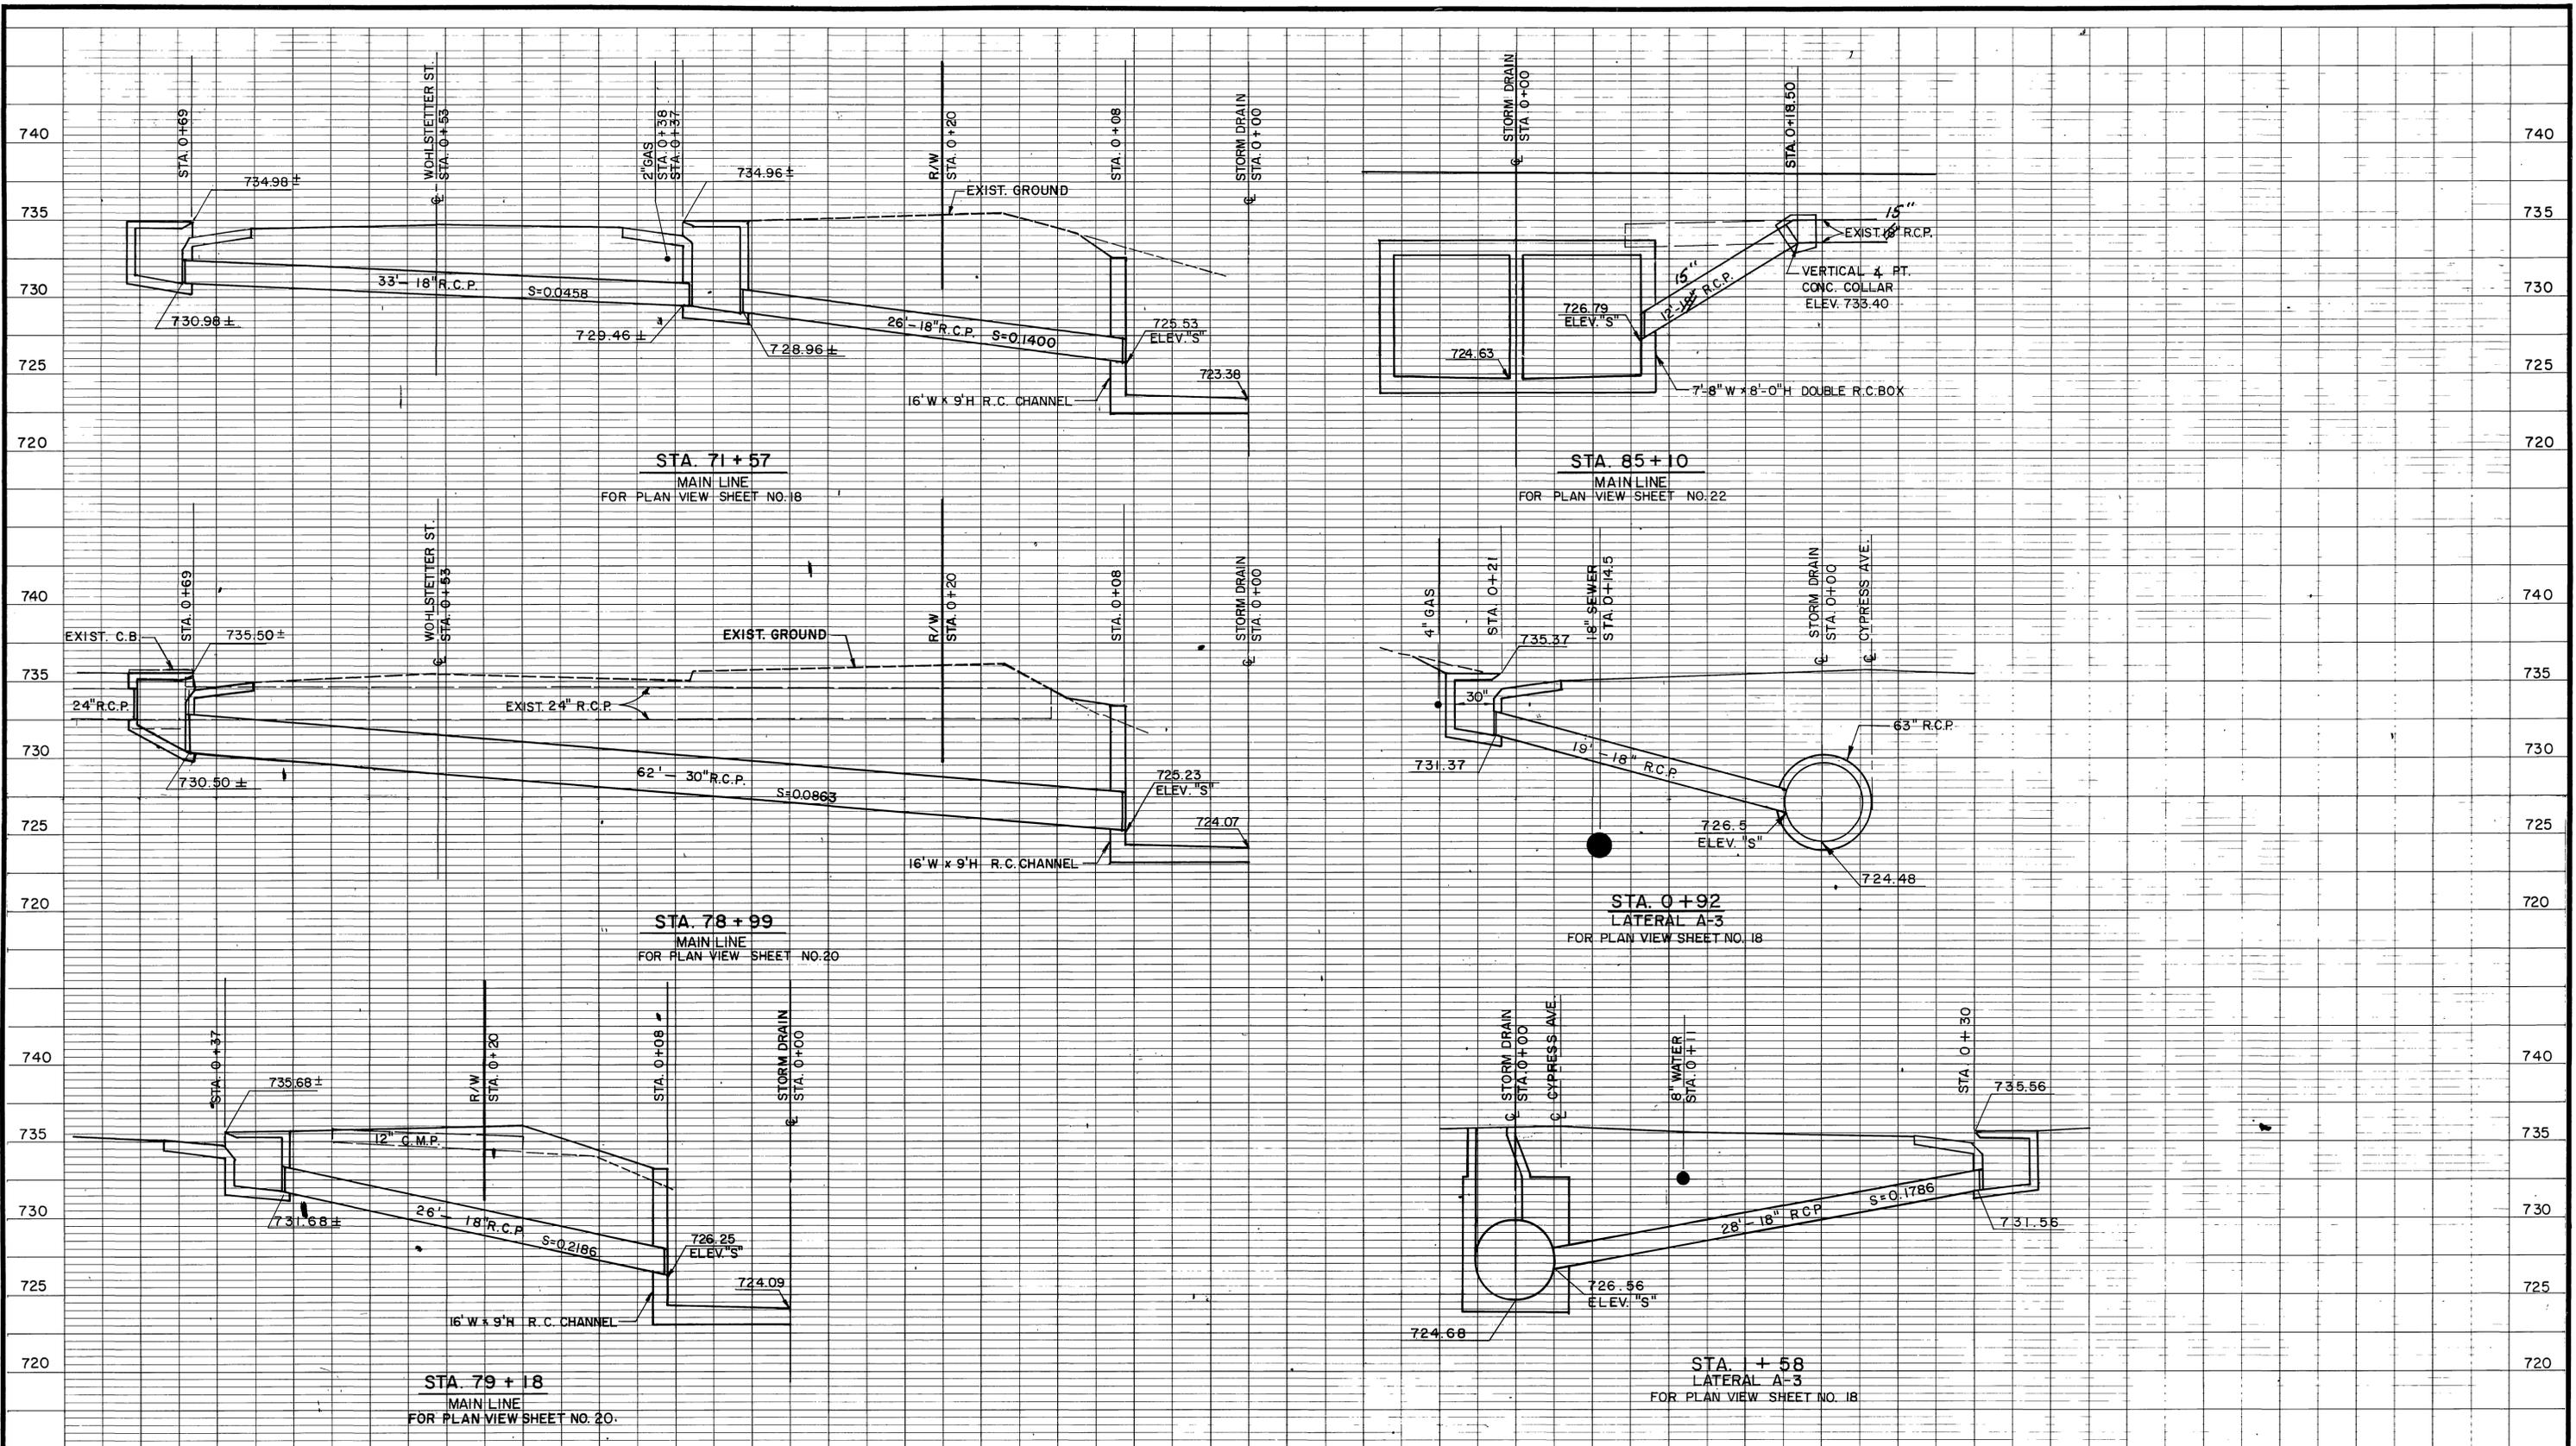


BENCH MARK	APPROVED BY <b>AS</b> ALDERMAN SWIFT & LEWIS CONSULTING ENGINEERS REGISTERED CIVIL ENGINEER NO. 11643	DATE: <i>Jan 29, 1978</i>	REVISIONS	RIVERSIDE COUNTY FLOOD CONTROL AND WATER CONSERVATION DISTRICT	ANZA CHANNEL STAGE I CONNECTOR PIPE PROFILE 1970 STORM DRAIN BOND ISSUE PROJECT NO. 18	PROJECT NO. 1-0-150
SCALE:	DESIGNED BY: K. K.	DRAWN BY: A.W.B.	DATE DRAWN: OCT. 1973	APPROVED BY: <i>John W. ...</i> CHIEF ENGINEER R.E. NO. 8822	DRAWING NO. 1-302	SHEET NO. 24 OF 78
DATE:	DESCRIPTION: <i>Change R.C.P. size</i>	APPR. DATE: <i>1/26/78</i>	CHECKED BY: R.D.C.	DATE: <i>3-4-75</i>		

AS BUILT

D-294


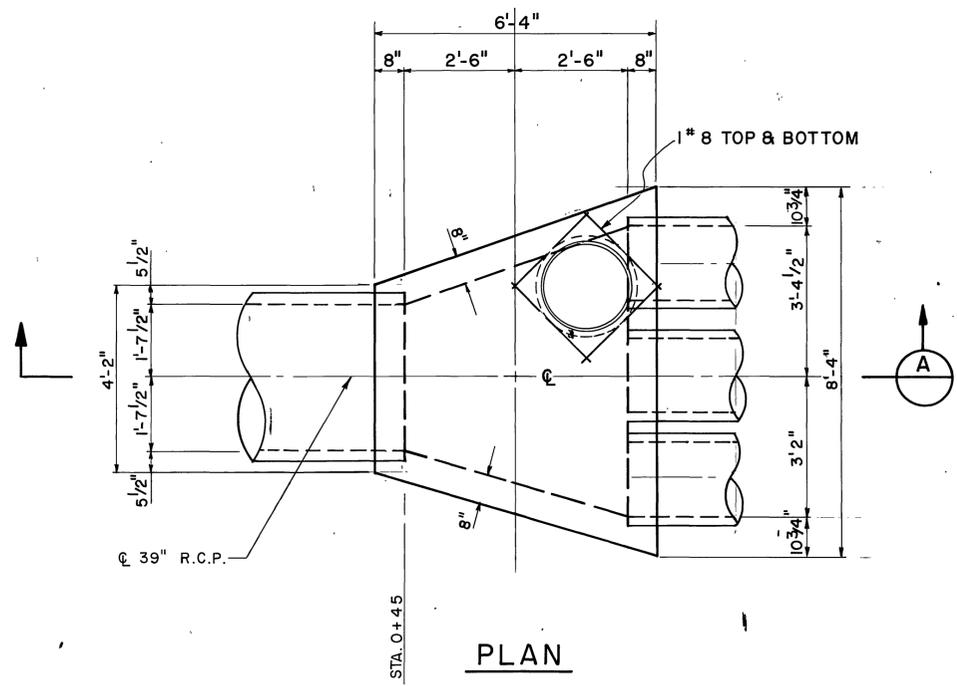


PLAN

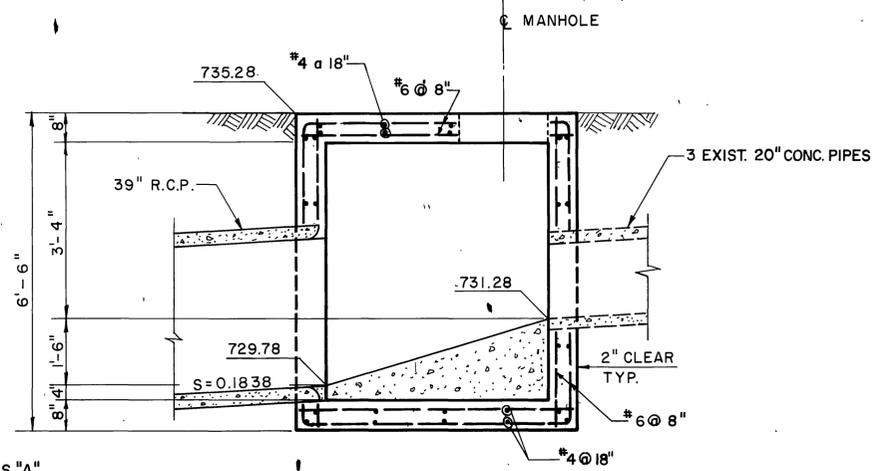


SECTION A  
JUNCTION CHAMBER

- NOTES
1. CONCRETE SHALL BE CLASS "A"
  2. FLOOR OF JUNCTION CHAMBER SHALL BE STEEL TROWLED TO OUTLET
  3. BACKFILL UNDER PIPES WITH 1-3-5 MIX CONCRETE OR COMPACT SOIL TO RELATIVE DENSITY REQUIRED BY SPECIFICATIONS.
  4. REINFORCING STEEL SHALL BE 2" CLEAR FROM FACE OF CONCRETE UNLESS OTHERWISE SHOWN.
  5. MANHOLE FRAME AND COVER PER STD. DRAWING CB 103
  6. SEE SHEET NO. 17 FOR OVERALL PLAN VIEW

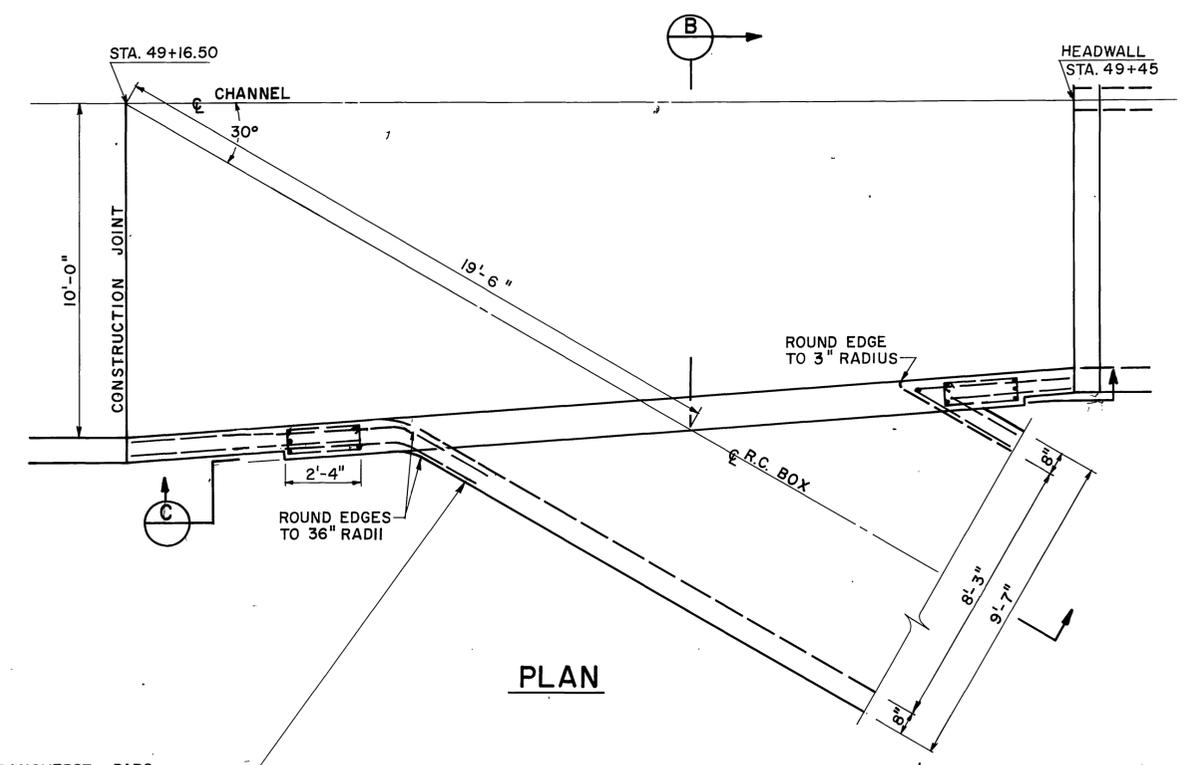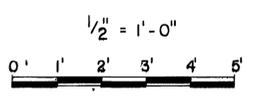


PLAN

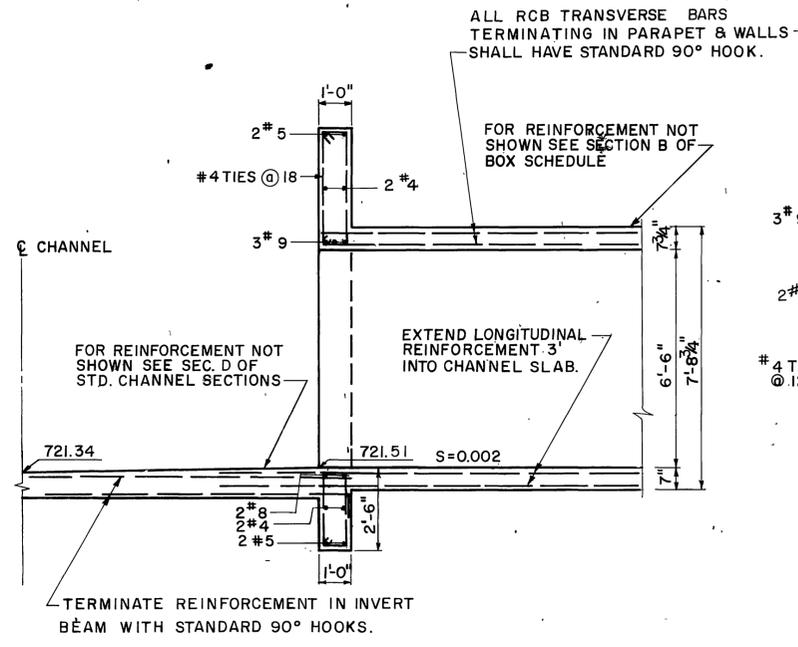


SECTION B

- NOTES
1. CONCRETE SHALL BE CLASS "A"
  2. REINFORCING STEEL SHALL BE 2" CLEAR FROM FACE OF CONCRETE UNLESS OTHERWISE SHOWN
  3. SEE SHEET NO. 12 FOR OVERALL PLAN VIEW.

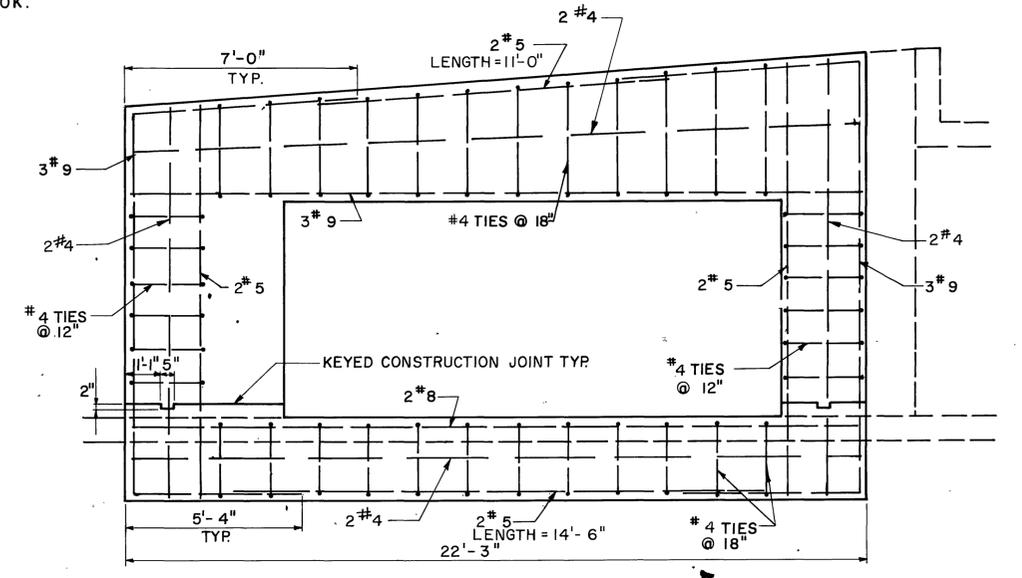


SECTION C  
SPECIAL JUNCTION STRUCTURE STA. 49+16.50

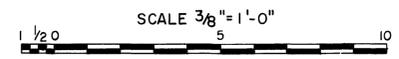


BENCH MARK	APPROVED BY <b>AS</b> ALDERMAN SWIFT & LEWIS ENGINEERS REGISTERED CIVIL ENGINEER NO. 41848	REVISIONS	RIVERSIDE COUNTY FLOOD CONTROL AND WATER CONSERVATION DISTRICT	ANZA CHANNEL STAGE I JUNCTION CHAMBER AND SPECIAL JUNCTION STRUCTURE 1970 STORM DRAIN BOND ISSUE PROJECT NO. 18	PROJECT NO. 1-0-150
SCALE:	DATE: April 29, 1974	DESIGNED BY: T.V.P.	APPROVED BY: <i>John W. Lewis</i> CHIEF ENGINEER R.E. NO. 8822	DRAWING NO. 1-302	SHEET NO. 25 OF 78
DATE:	DATE DRAWN: OCT. 1973	NO CHANGE	CHECKED BY: R.D.C.	DATE: 3-4-75	

**AS BUILT**

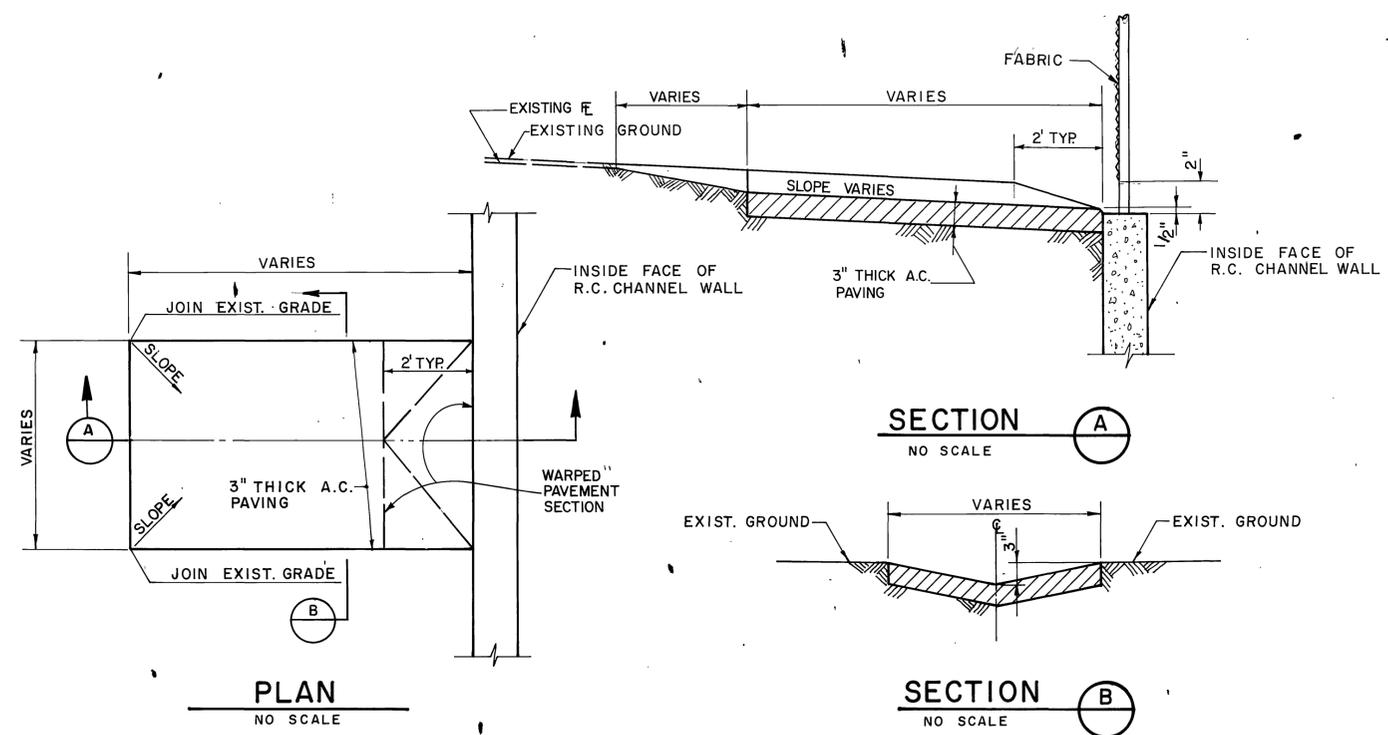


**TYPICAL SWALE DETAIL**  
STATIONS: 52+70; 53+19; 54+77; 56+43; 57+43; 58+15; 58+80; 59+63; 62+65


**NOTES**  
1. STRUCTURAL CONCRETE SHALL BE CLASS "A"

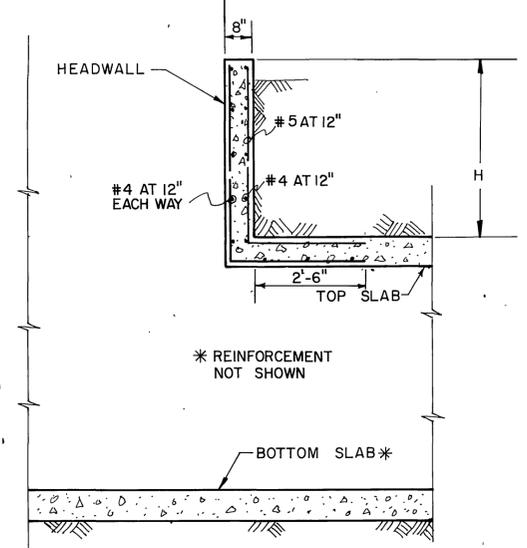



**TYPICAL HEADWALL DETAIL**  
NO SCALE

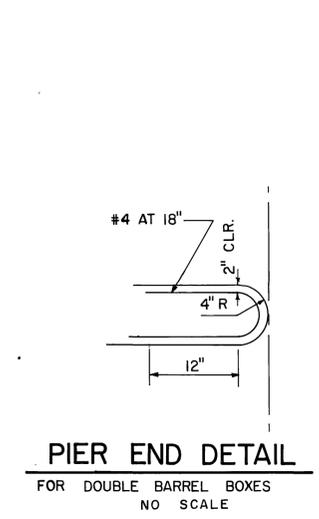

**PIER END DETAIL**  
FOR DOUBLE BARREL BOXES  
NO SCALE

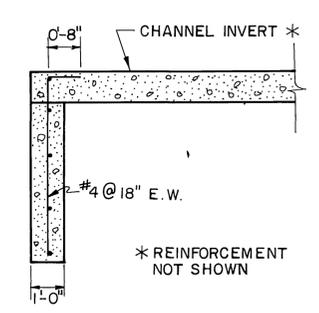


**TYPICAL CUTOFF WALL DETAIL**  
NO SCALE

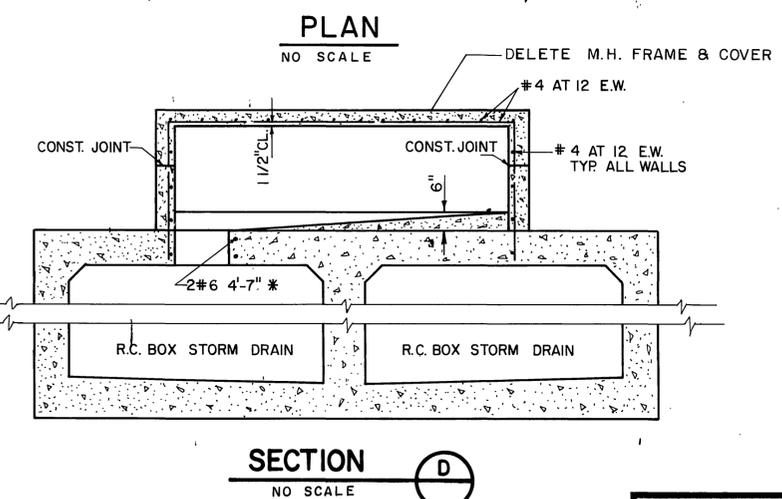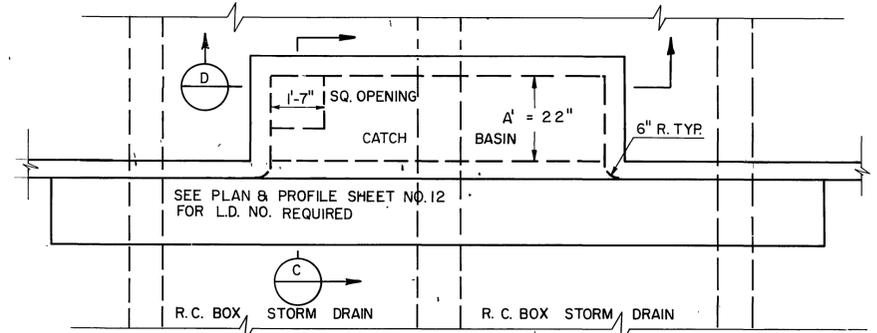


**TYPICAL MODIFIED C.B. NO. 1 DETAIL**  
SEE SHEET NO. 12 FOR OVERALL PLAN VIEW

\* FOR INFORMATION NOT SHOWN SEE STANDARD DWG. NO. C.B. 100  
\* PUT REINFORCEMENT SHOWN UNDER CUT BARS & OVER UNCUT BARS


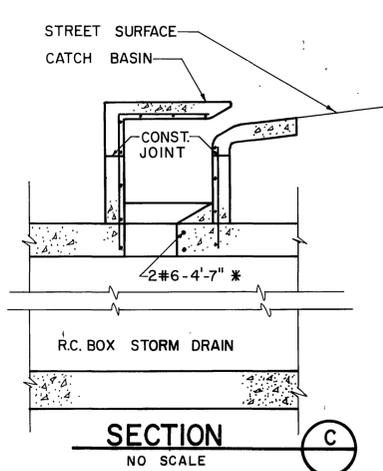


**SECTION C**  
NO SCALE

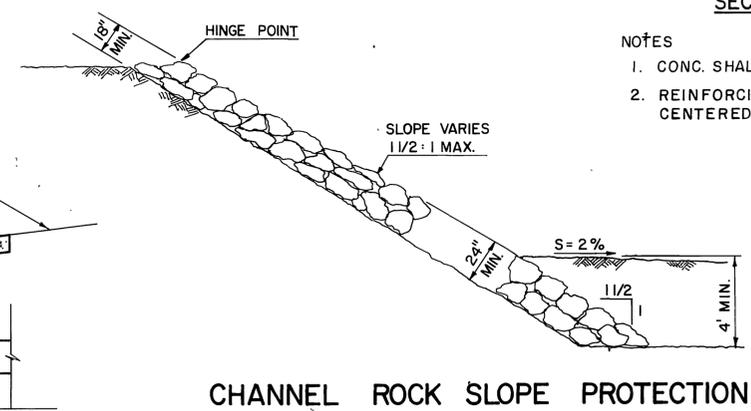

**CHANNEL ROCK SLOPE PROTECTION**  
SEE SHEET NOS. 2, 9 & 10 FOR OVERALL PLAN VIEW  
NO SCALE

**NOTES**  
1. CONC. SHALL CLASS "B"  
2. REINFORCING STEEL SHALL BE CENTERED IN BULKHEAD.

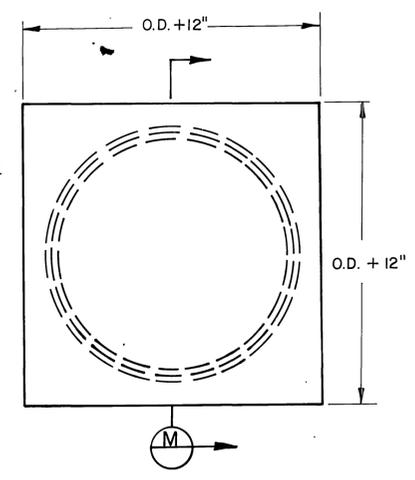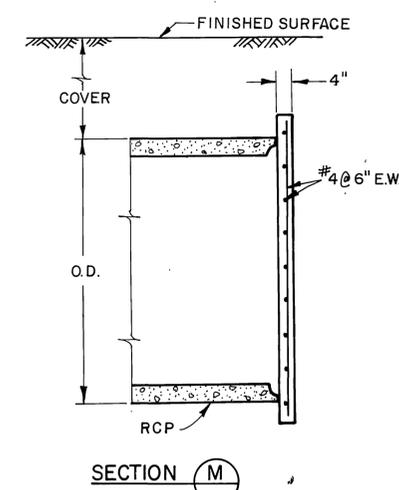


**CONCRETE BULKHEAD**  
NO SCALE


BENCH MARK	APPROVED BY <b>ALDERMAN SWIFT &amp; LEWIS</b> REGISTERED CIVIL ENGINEER NO. 41543	REVISIONS	RIVERSIDE COUNTY FLOOD CONTROL AND WATER CONSERVATION DISTRICT	PROJECT NO. 1-0-150
SCALE:	DATE: <i>April 24, 1974</i>		DESIGNED BY: K.E.K. DRAWN BY: T.L.K. DATE DRAWN: OCT. 1973	DRAWING NO. 1-302
DATE:		No Change	APPROVED BY: <i>John S. Bergant</i> CHIEF ENGINEER R.E. NO. 8822 DATE: <i>3-7-75</i>	SHEET NO. 26 OF 78
		REF. DESCRIPTION APPR. DATE	CHECKED BY: R.D.C. G.L.H.	MISCELLANEOUS STRUCTURAL DETAILS 1970 STORM DRAIN BOND ISSUE PROJECT NO. 18

AS BUILT

D-294








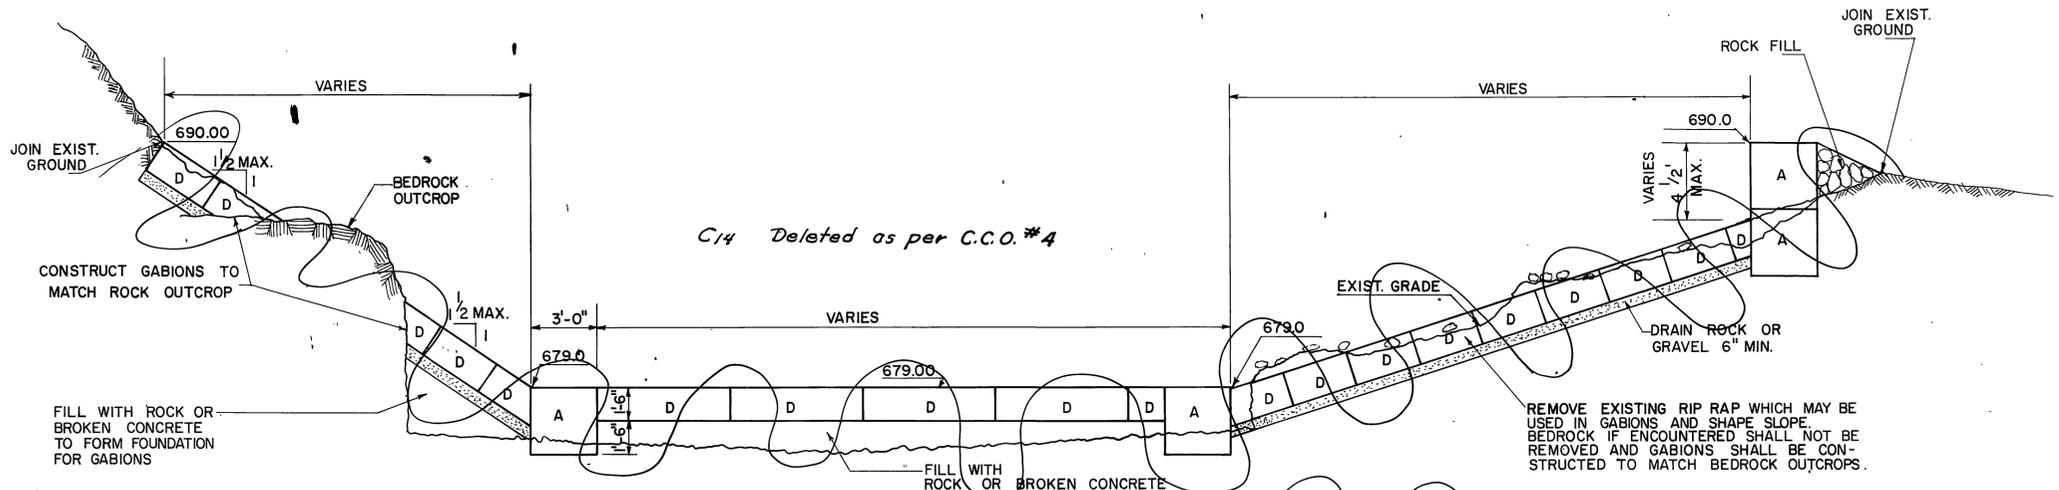


- NOTES:
- ① DELETE CAP SCREW AT THIS LOCATION TO PROVIDE FOR EXPANSION.
  2. SEE SHEET 28 FOR PIPE RAILING DETAILS.
  3. CLEAR COVER FOR STEEL SHALL BE 1/2 INCHES EACH FACE FOR WALLS AND 2 INCHES EACH FACE FOR BOTTOM SLAB AND CUTOFF WALLS.
  4. REINFORCING BAR CUTOFF AT NOTED COVER, UNLESS OTHERWISE SPECIFIED.
  5. EXPANSION JOINT SHALL HAVE #4 x 2 FEET LONG DOWELS AT 12 INCHES SPACING PLACED AT THE CENTER OF SECTIONS WITH 12 INCHES WRAPPED TO PREVENT BOND. A COMPLETE CURTAIN OF TRANSVERSE STEEL SHALL BE PLACED 3 INCHES FROM EACH FACE OF THE JOINT AND LONGITUDINAL STEEL WILL NOT BE CONTINUOUS THROUGH THE JOINT.
  6. SPLICES SHALL CONFORM TO THE PROVISIONS OF ACI STANDARD 318-71.
  - ⑦ THREE WEEPHOLES SHALL BE FORMED AS SHOWN, SPACED EVENLY ALONG EACH WALL WITH ONE CUBIC FOOT OF FILTER MATERIAL PLACED AT EACH HOLE.

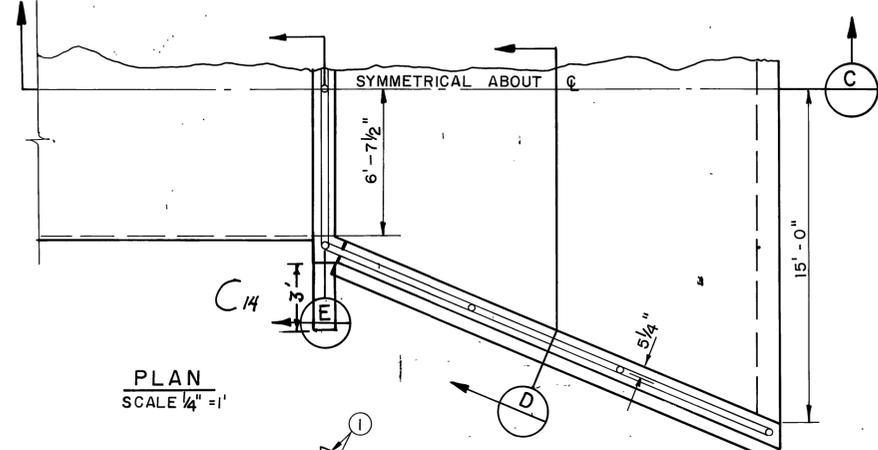

SIZE SCHEDULE

TYPE	LENGTH	WIDTH	DEPTH
A	6	3	3
D	6	3	1 1/2

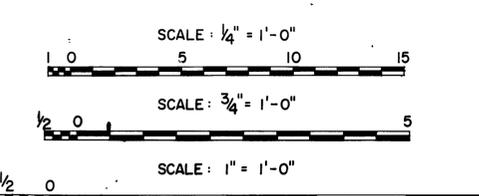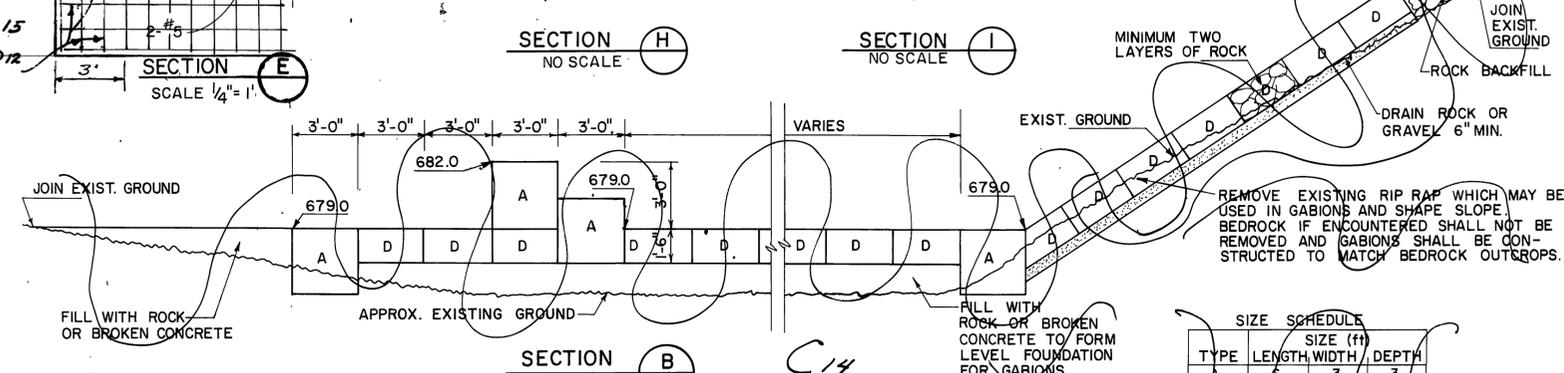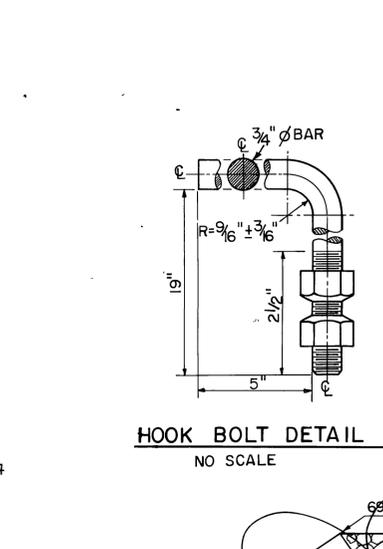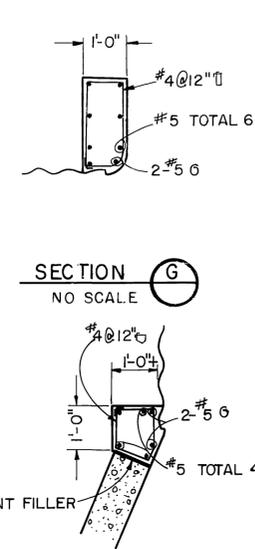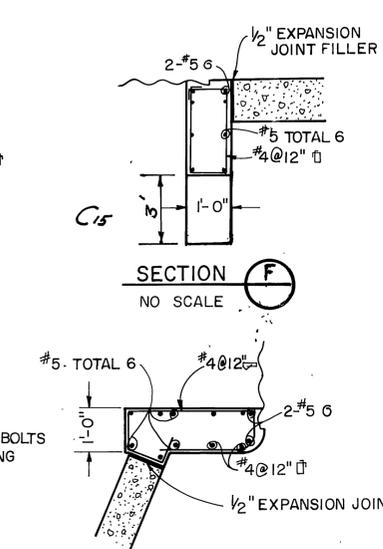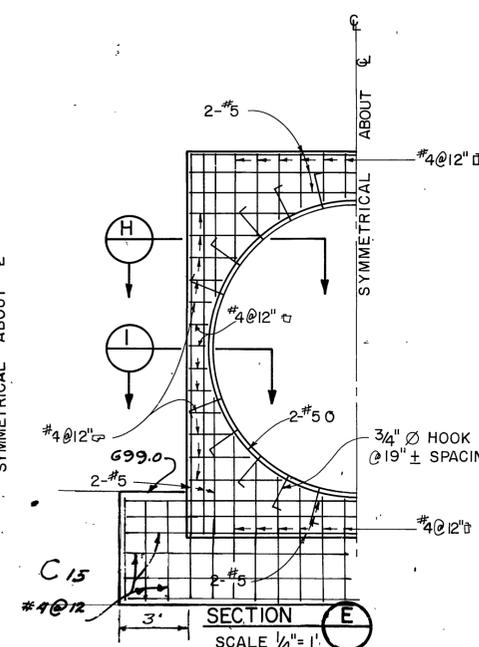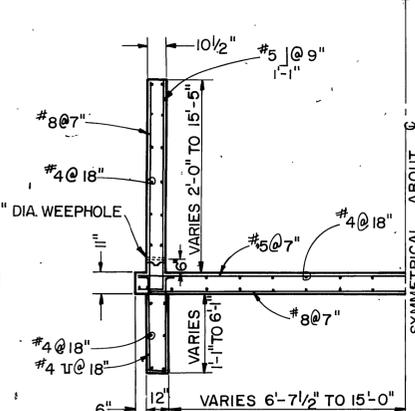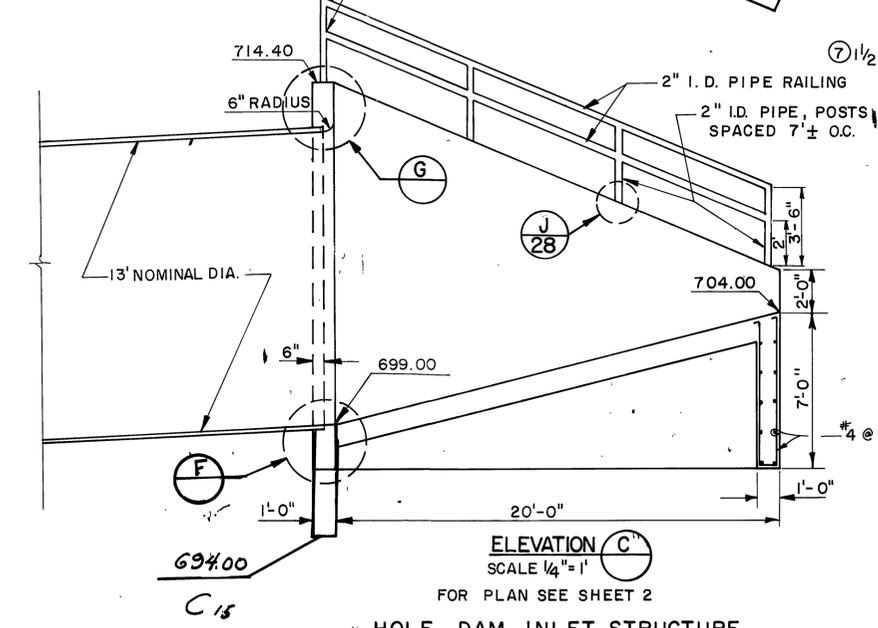


AS PER C.C.O. #2

Deleted as per C.C.O. #4

BENCH MARK	<p>APPROVED BY DATE: April 24, 1974</p>	<p>REVISIONS</p>	<p>RIVERSIDE COUNTY FLOOD CONTROL AND WATER CONSERVATION DISTRICT</p>		<p>PROJECT NO. 1-0-150</p>
			<p>SCALE:</p>	<p>DESIGNED BY: T.P. DRAWN BY: E.H. &amp; P.T. DATE DRAWN: APRIL, 1974</p>	
<p>DATE:</p>	<p>REGISTERED CIVIL ENGINEER NO. 11543</p>	<p>C15 Change as per C.C.O. #2 C14 Change as per C.C.O. #4</p>	<p>CHECKED BY: G.L.H.</p>	<p>DATE: 3-4-75</p>	<p>SHEET NO. 27 OF 78</p>


AS BUILT

D-294

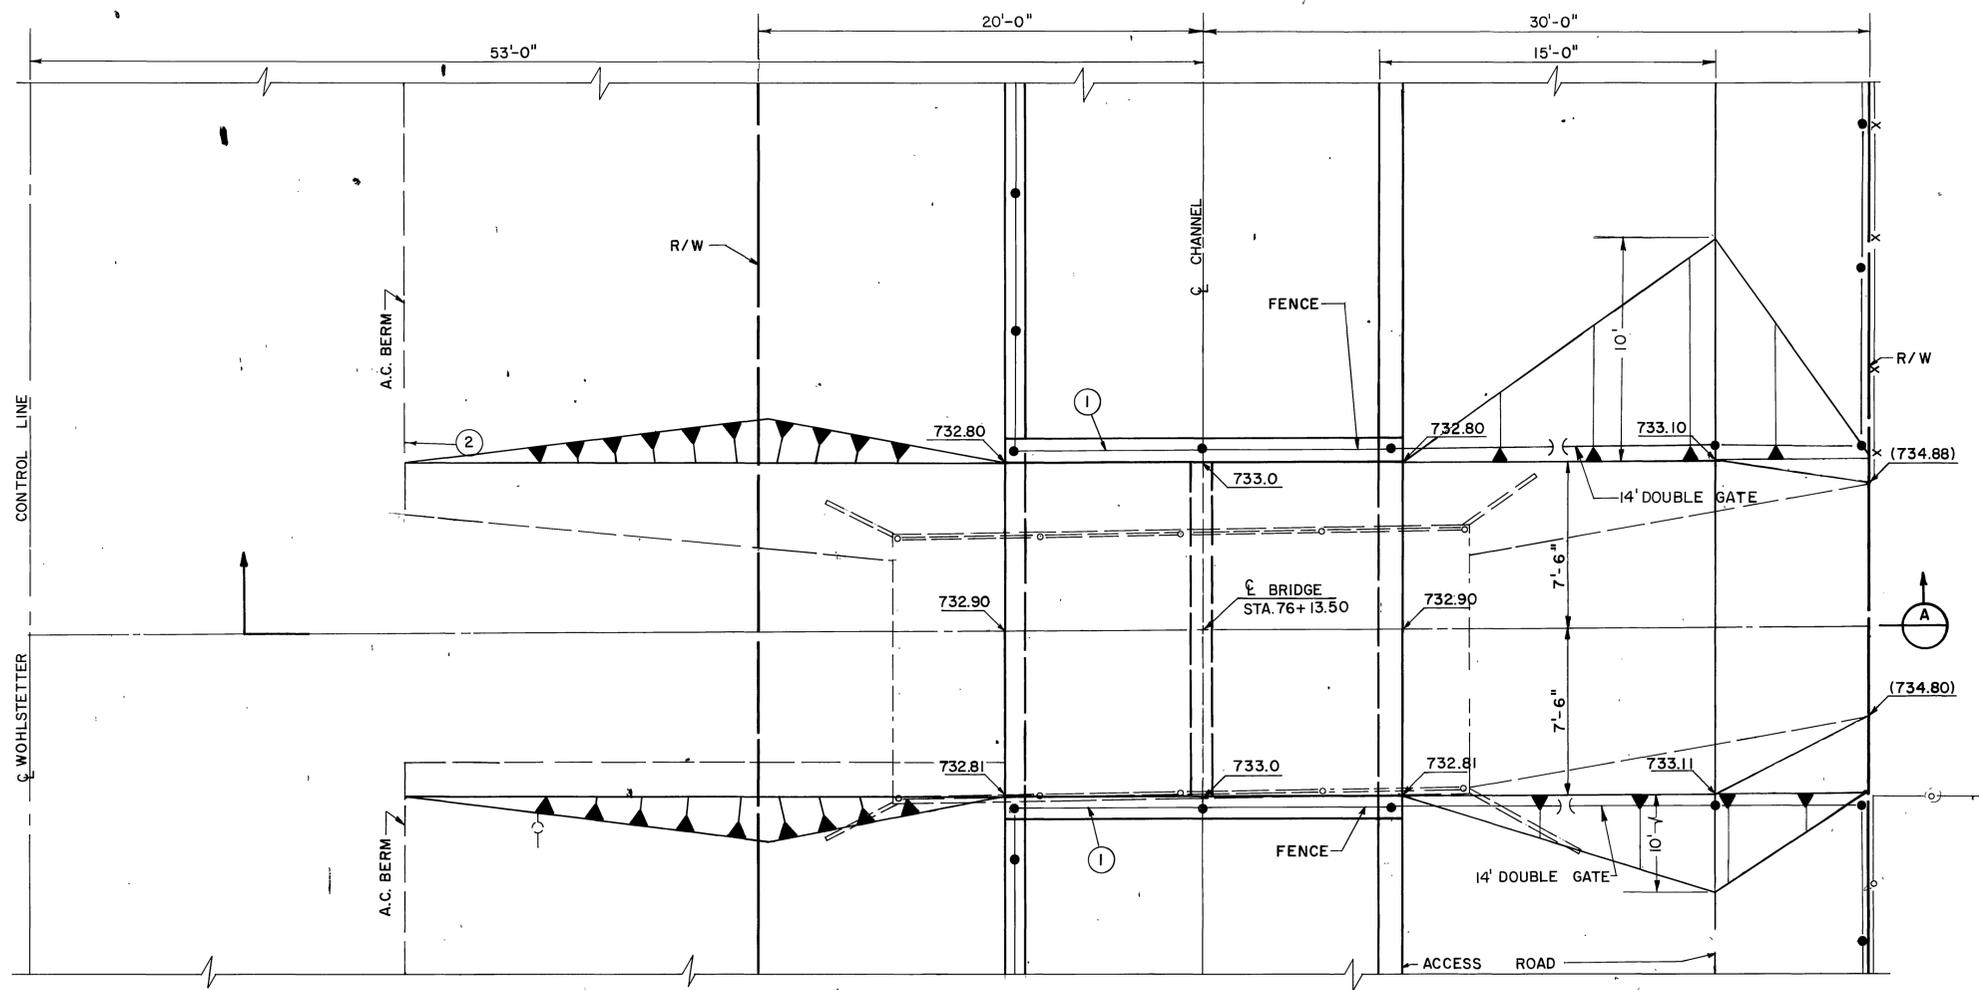


PLAN

SCALE: 1/4"=1'-0"

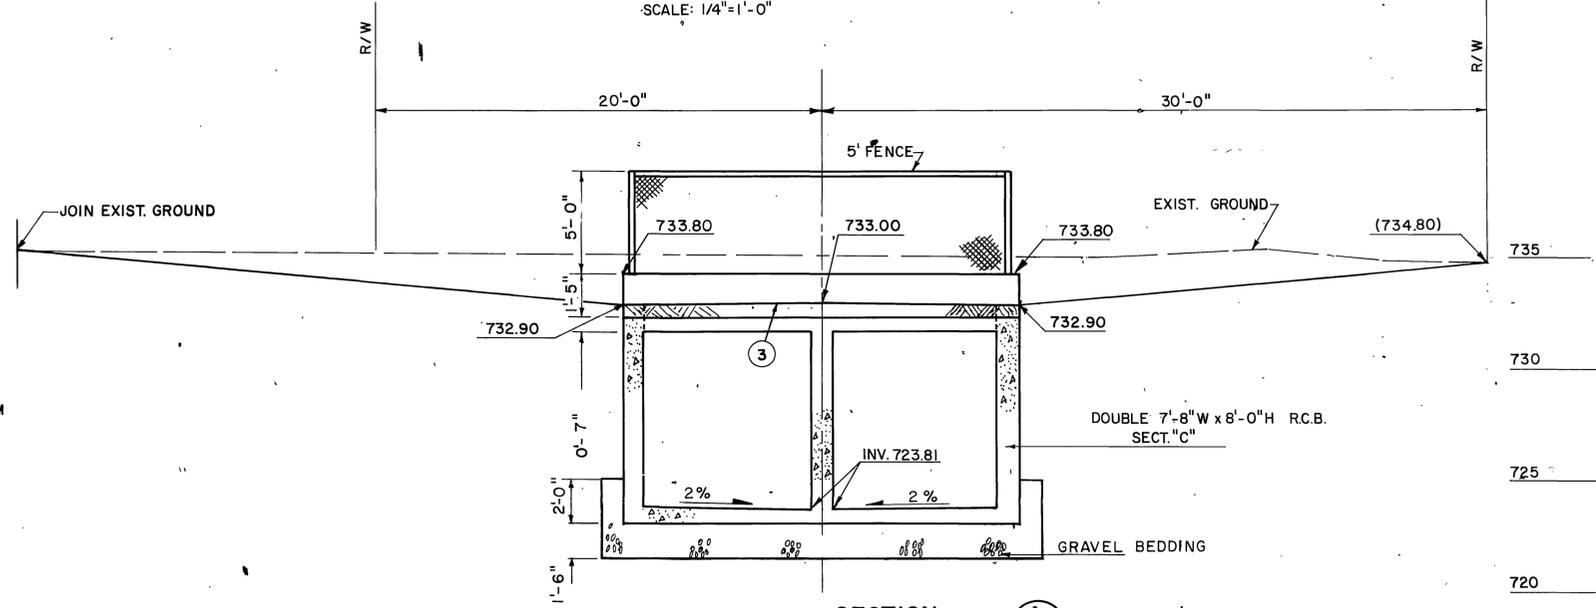


SECTION

SCALE: 1/4"=1'-0"

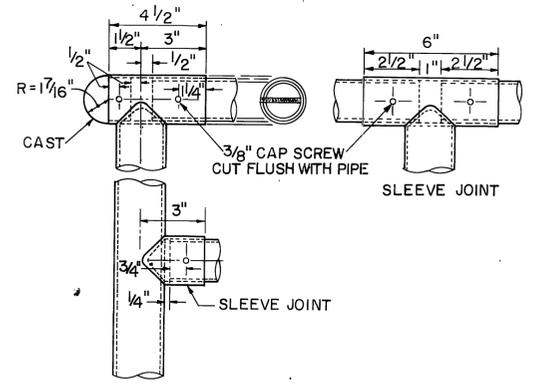

PIPE RAILING DETAILS

NO SCALE

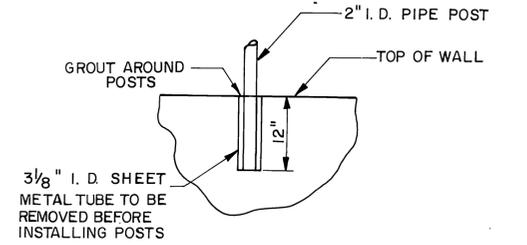


TYPICAL POST INSTALLATION

NO SCALE

- NOTES:
1. ALL PIPE SHALL BE "STANDARD WEIGHT."
  2. INLET STRUCTURE, SEE SHEET NO. 27.


- 1 HEADWALL, H=2', SEE DETAIL SHEET NO. 26.
- 2 REMOVE INTERFERING PORTIONS OF A.C. BERM
- 3 COMPACTED FILL
- 4 FOR OVERALL PLAN AND PROFILE SEE SHEET NO. 19.

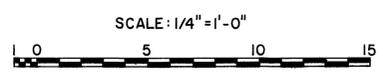


BENCH MARK	APPROVED BY <b>AS</b> ALDERMAN SWIFT & LEWIS CONSULTING ENGINEERS REGISTERED CIVIL ENGINEER NO. 11543	DATE April 22, 1974	REVISIONS	RIVERSIDE COUNTY FLOOD CONTROL AND WATER CONSERVATION DISTRICT	DESIGNED BY: R.D.C. DRAWN BY: E.H. DATE DRAWN: APRIL, 1974 CHECKED BY: R.D.C., G.L.H.	APPROVED BY: <i>John W. Bryant</i> CHIEF ENGINEER R.E. NO. 8822 DATE: 3-4-75	PROJECT NO. 1-0-150	DRAWING NO. 1-302	SHEET NO. 28 OF 78
SCALE:	DATE:		DESCRIPTION No Change	APPR. DATE		ACCESS BRIDGE STA. 76+13.50		1970 STORM DRAIN BOND ISSUE PROJECT NO. 18.	

**AS BUILT**

D-294

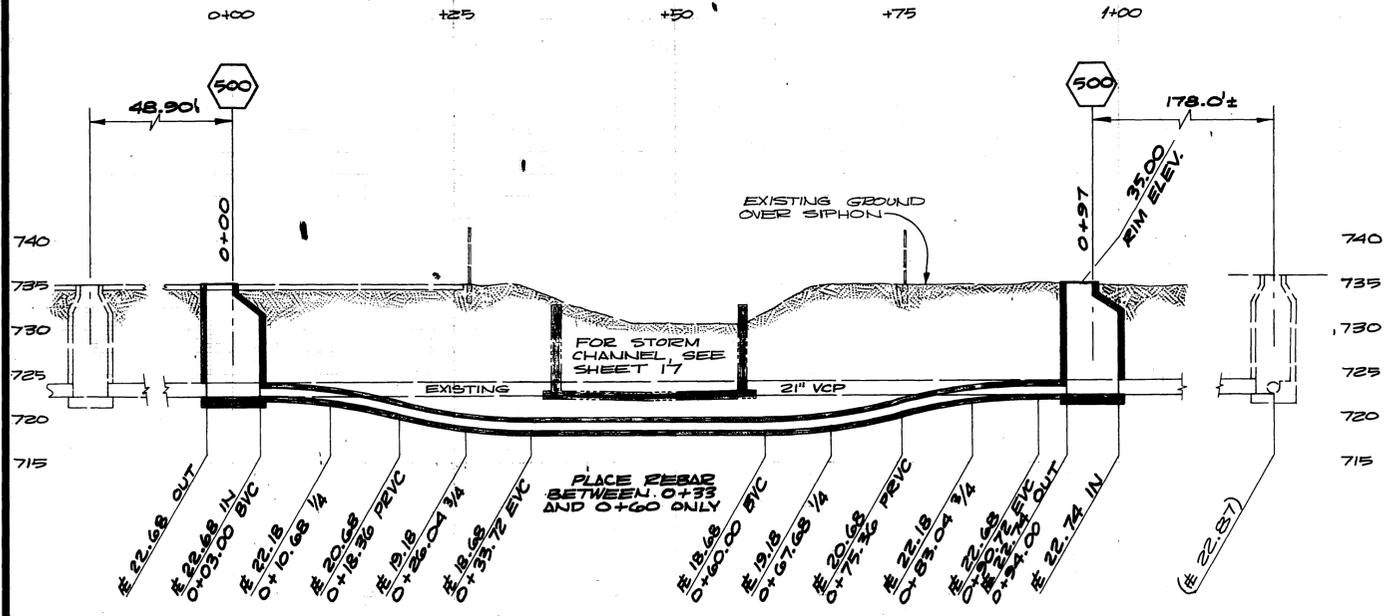


**SIPHON PROFILE**  
SCALE: HORIZ. 1"=10'  
VERT. 1"=10'

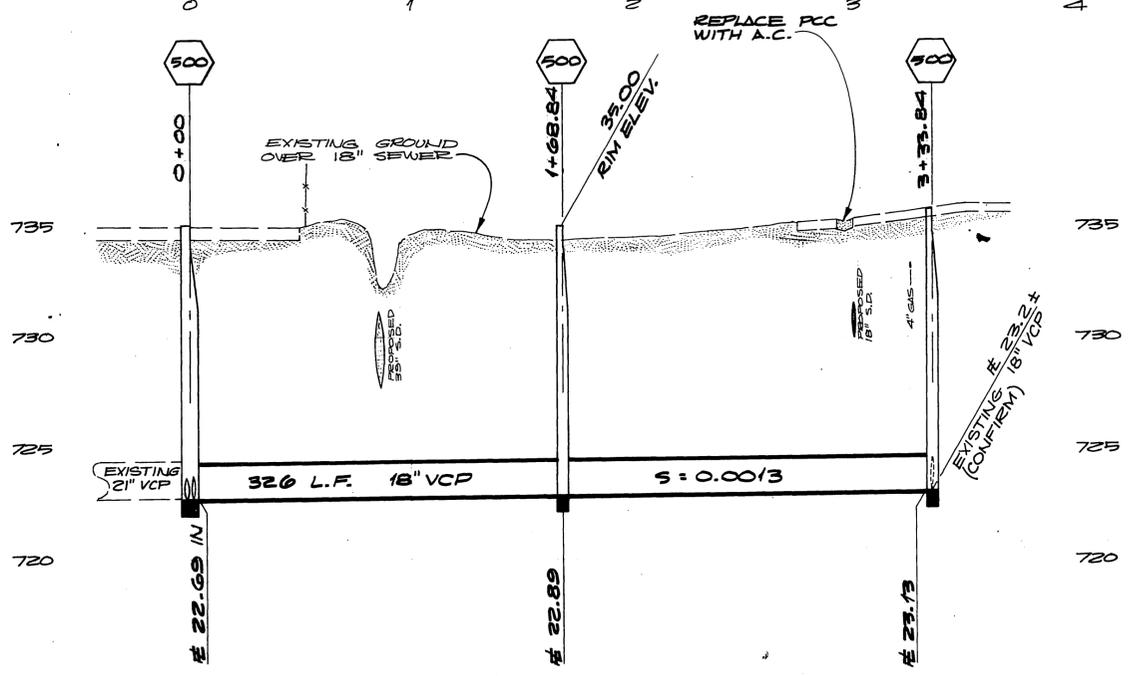


**18" VCP PROFILE**  
SCALE: HORIZ. 1"=40'  
VERT. 1"=4'

BENCH MARK: C.P. 37  
BRASS DISK DOWN 0.25' AT  
THE INTERSECTION OF  
WOHLSTETTER ST. SOUTH, AND  
CYPRESS AVENUE  
ELEV. 735.35

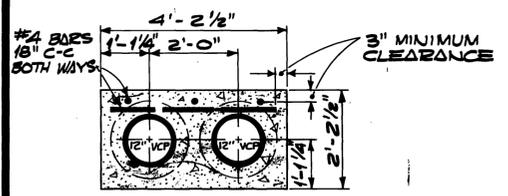

**SECTION A-A**

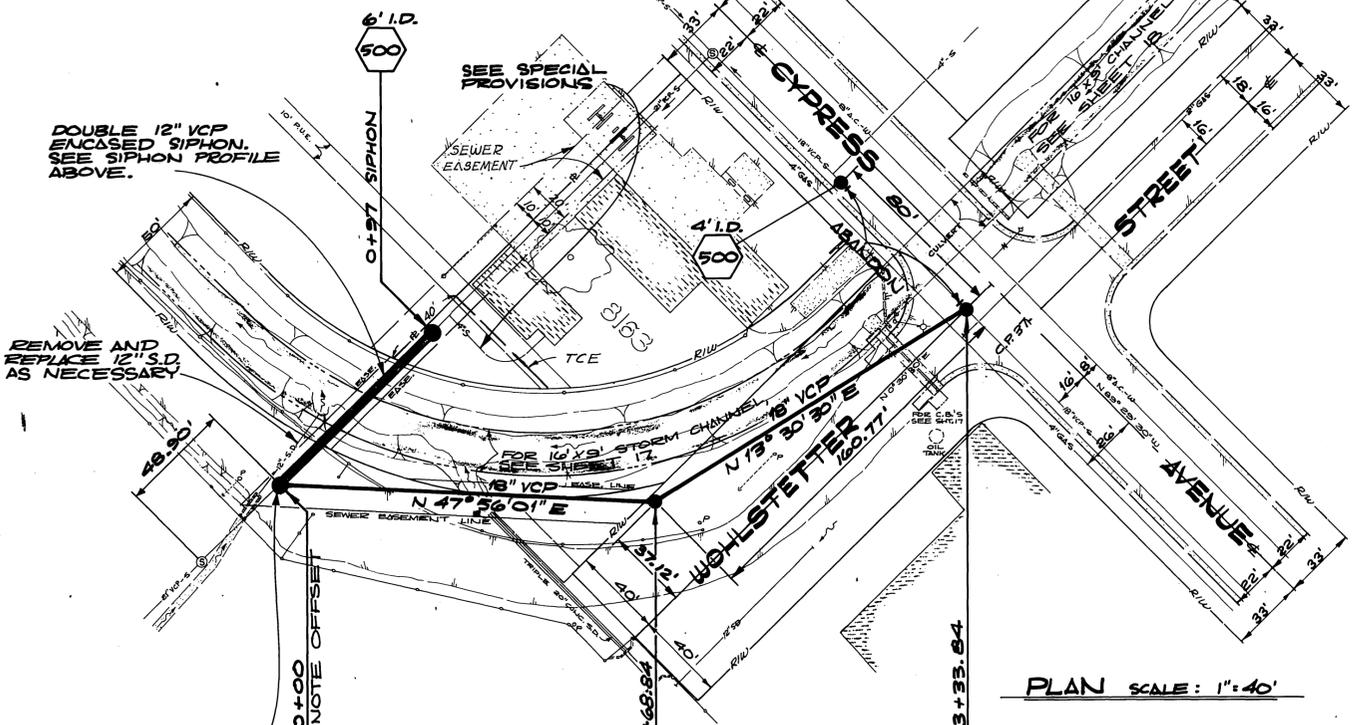



**PLAN SCALE: 1"=40'**

- 500 CONSTRUCT MANHOLE PER CITY/RIVERSIDE STANDARD DRAWING 500.
- ① VERTICAL CURVES FOR SIPHON ARE 60' RADIUS. USE 2' LENGTHS OF 12" VCP.

**DETAIL OF 6' I.D. MANHOLE AT STATION 0+00**  
SCALE: 1"=2'

<b>CITY OF RIVERSIDE</b> PUBLIC WORKS DEPARTMENT		<b>Anza Channel Sewer Relocations</b>		ACCOUNT NO. 32-577-539
APPROVED BY: [Signature]	DATE: 12-5-74	APPROVED BY: [Signature]	DATE: 12-5-74	PROJECT NO. 1-0-150
PRINCIPAL ENGINEER	DATE: 11-25	PUBLIC WORKS DIRECTOR	DATE: 11-25	DRAWING NO. 1-302
SEWER SYSTEMS	DATE: 11-25	CHIEF ENGINEER R.E. NO. 8822	DATE: 3-4-75	SHEET 1 OF 1
CHIEF P.W. ENGINEER				FILE NO.

RIVERSIDE COUNTY FLOOD CONTROL AND WATER CONSERVATION DISTRICT		ANZA CHANNEL		PROJECT NO. 1-0-150
DESIGNED BY: [Signature]	DATE: [ ]	APPROVED BY: [Signature]	DATE: [ ]	DRAWING NO. 1-302
DRAWN BY: [Signature]	DATE: [ ]	CHIEF ENGINEER R.E. NO. 8822	DATE: [ ]	SHEET NO. 29 OF 78
DATE DRAWN: [ ]	DATE: [ ]			
DESIGNED BY: [ ]	DRAWN BY: [ ]	CHECKED BY: [ ]	CHECKED BY: [ ]	

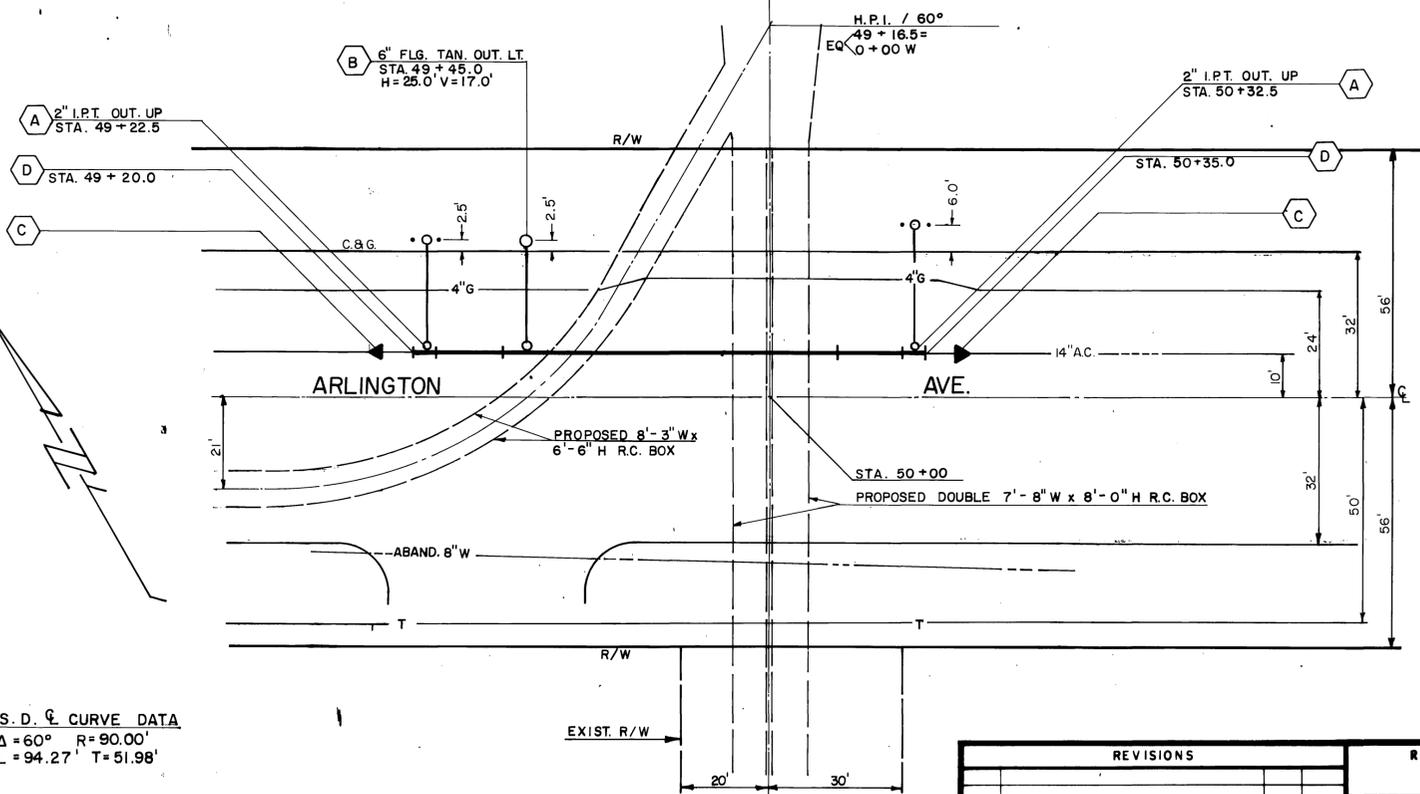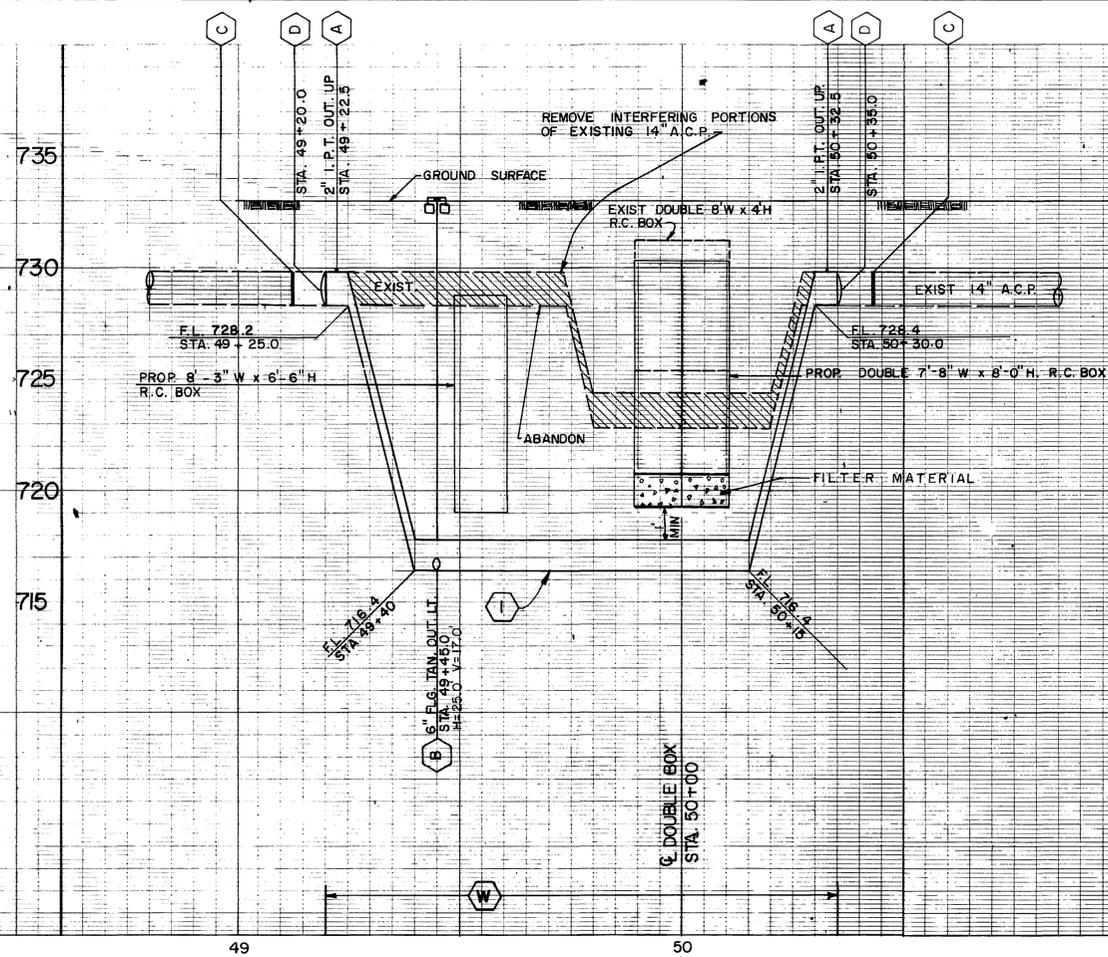

**GENERAL NOTES:**

- THE CONTRACTOR SHALL HYDROSTATICALLY TEST THE WATER LINE AT 150 P.S.I. FOR 1 HOUR. ALLOWABLE LEAKAGE = 0.0 GAL.
- THE CITY WILL FLUSH & CHLORINATE THE MAIN AFTER TESTING.
- MATERIALS:**  
 AIR VALVE - CRISPEN U-20 OR APCO NO. 145C  
 6" BUTTERFLY VALVE - DRESSER "450" OR PRATT "GROUNDHOG"  
 2" GATE VALVE - STOCKHAM B-115  
 BRASS OR BRONZE FITTINGS - MUELLER OR JONES  
 COPPER PIPE - ASTM B-88, TYPE K  
 TRANSITION COUPLING - DRESSER, BAKER, OR SMITH-BLAIR
- REFERENCE:**  
 ANZA CHANNEL STAGE I  
 PROJECT 1-0-150, SHEET 12

S. D. & CURVE DATA  
 $\Delta = 60^\circ$   $R = 90.00'$   
 $L = 94.27'$   $T = 51.98'$

**CONSTRUCTION NOTES:**

- (I) CONSTRUCTION CONTRACTOR FURNISH & INSTALL 14"  $\phi$  M.L.&C. STL. CYL. PIPE, CLASS 150 P.S.I., PER AWWA C-201 OR SS-P-385a. 12 GAGE (0.105 IN.) CYLINDER MIN.
- (A) CONSTRUCTION CONTRACTOR INSTALL 2" AIR VALVE PER CWD-340, CWD-451, CWD-900.
- (D) CONSTRUCTION CONTRACTOR FURNISH & INSTALL DISHED HEAD. FURNISH TRANSITION CPLG.(STL. TO A.C.P.) FOR TIE-IN BY CITY.
- (W) CONSTRUCTION CONTRACTOR WELD ALL JOINTS 360°.
- (C) CITY FORCES CUT & PLUG EXISTING 14"  $\phi$  A.C.P. COMPLETE TIE-IN AFTER TESTING.
- (B) CONSTRUCTION CONTRACTOR INSTALL 8" BLOW-OFF PER CWD-320 CWD-405, CWD-810.

D-294






**ANZA STORM DRAIN STAGE I  
 ARLINGTON AVE. 14" RELOCATION**

SCALE 1" = 20' H 1" = 4' V	DRAWN E. J. K.	CITY OF RIVERSIDE DEPARTMENT OF PUBLIC UTILITIES	
DATE OCT, 1974	CHECKED F. L. [Signature]	DRAWING NO. D5-3165-1	PROJECT NO. 1-0-150
JOB No 3165	APPROVED [Signature]	W. DIV.	DRAWING NO. 1-302
F. B. No	65-751-786		SHEET NO. 30 OF 78

REVISIONS			RIVERSIDE COUNTY FLOOD CONTROL AND WATER CONSERVATION DISTRICT	
DESIGNED BY:		APPROVED BY:	[Signature]	
DRAWN BY:		DATE:	3-4-75	
DATE DRAWN:		CHEF ENGINEER R.E. NO. 8822		
REF.	DESCRIPTION	APPR. DATE	CHECKED BY:	

**ANZA CHANNEL  
 STAGE I  
 WATER LINE RELOCATION**  
 1970 STORM DRAIN BOND ISSUE PROJECT NO. 18

AS BUILT

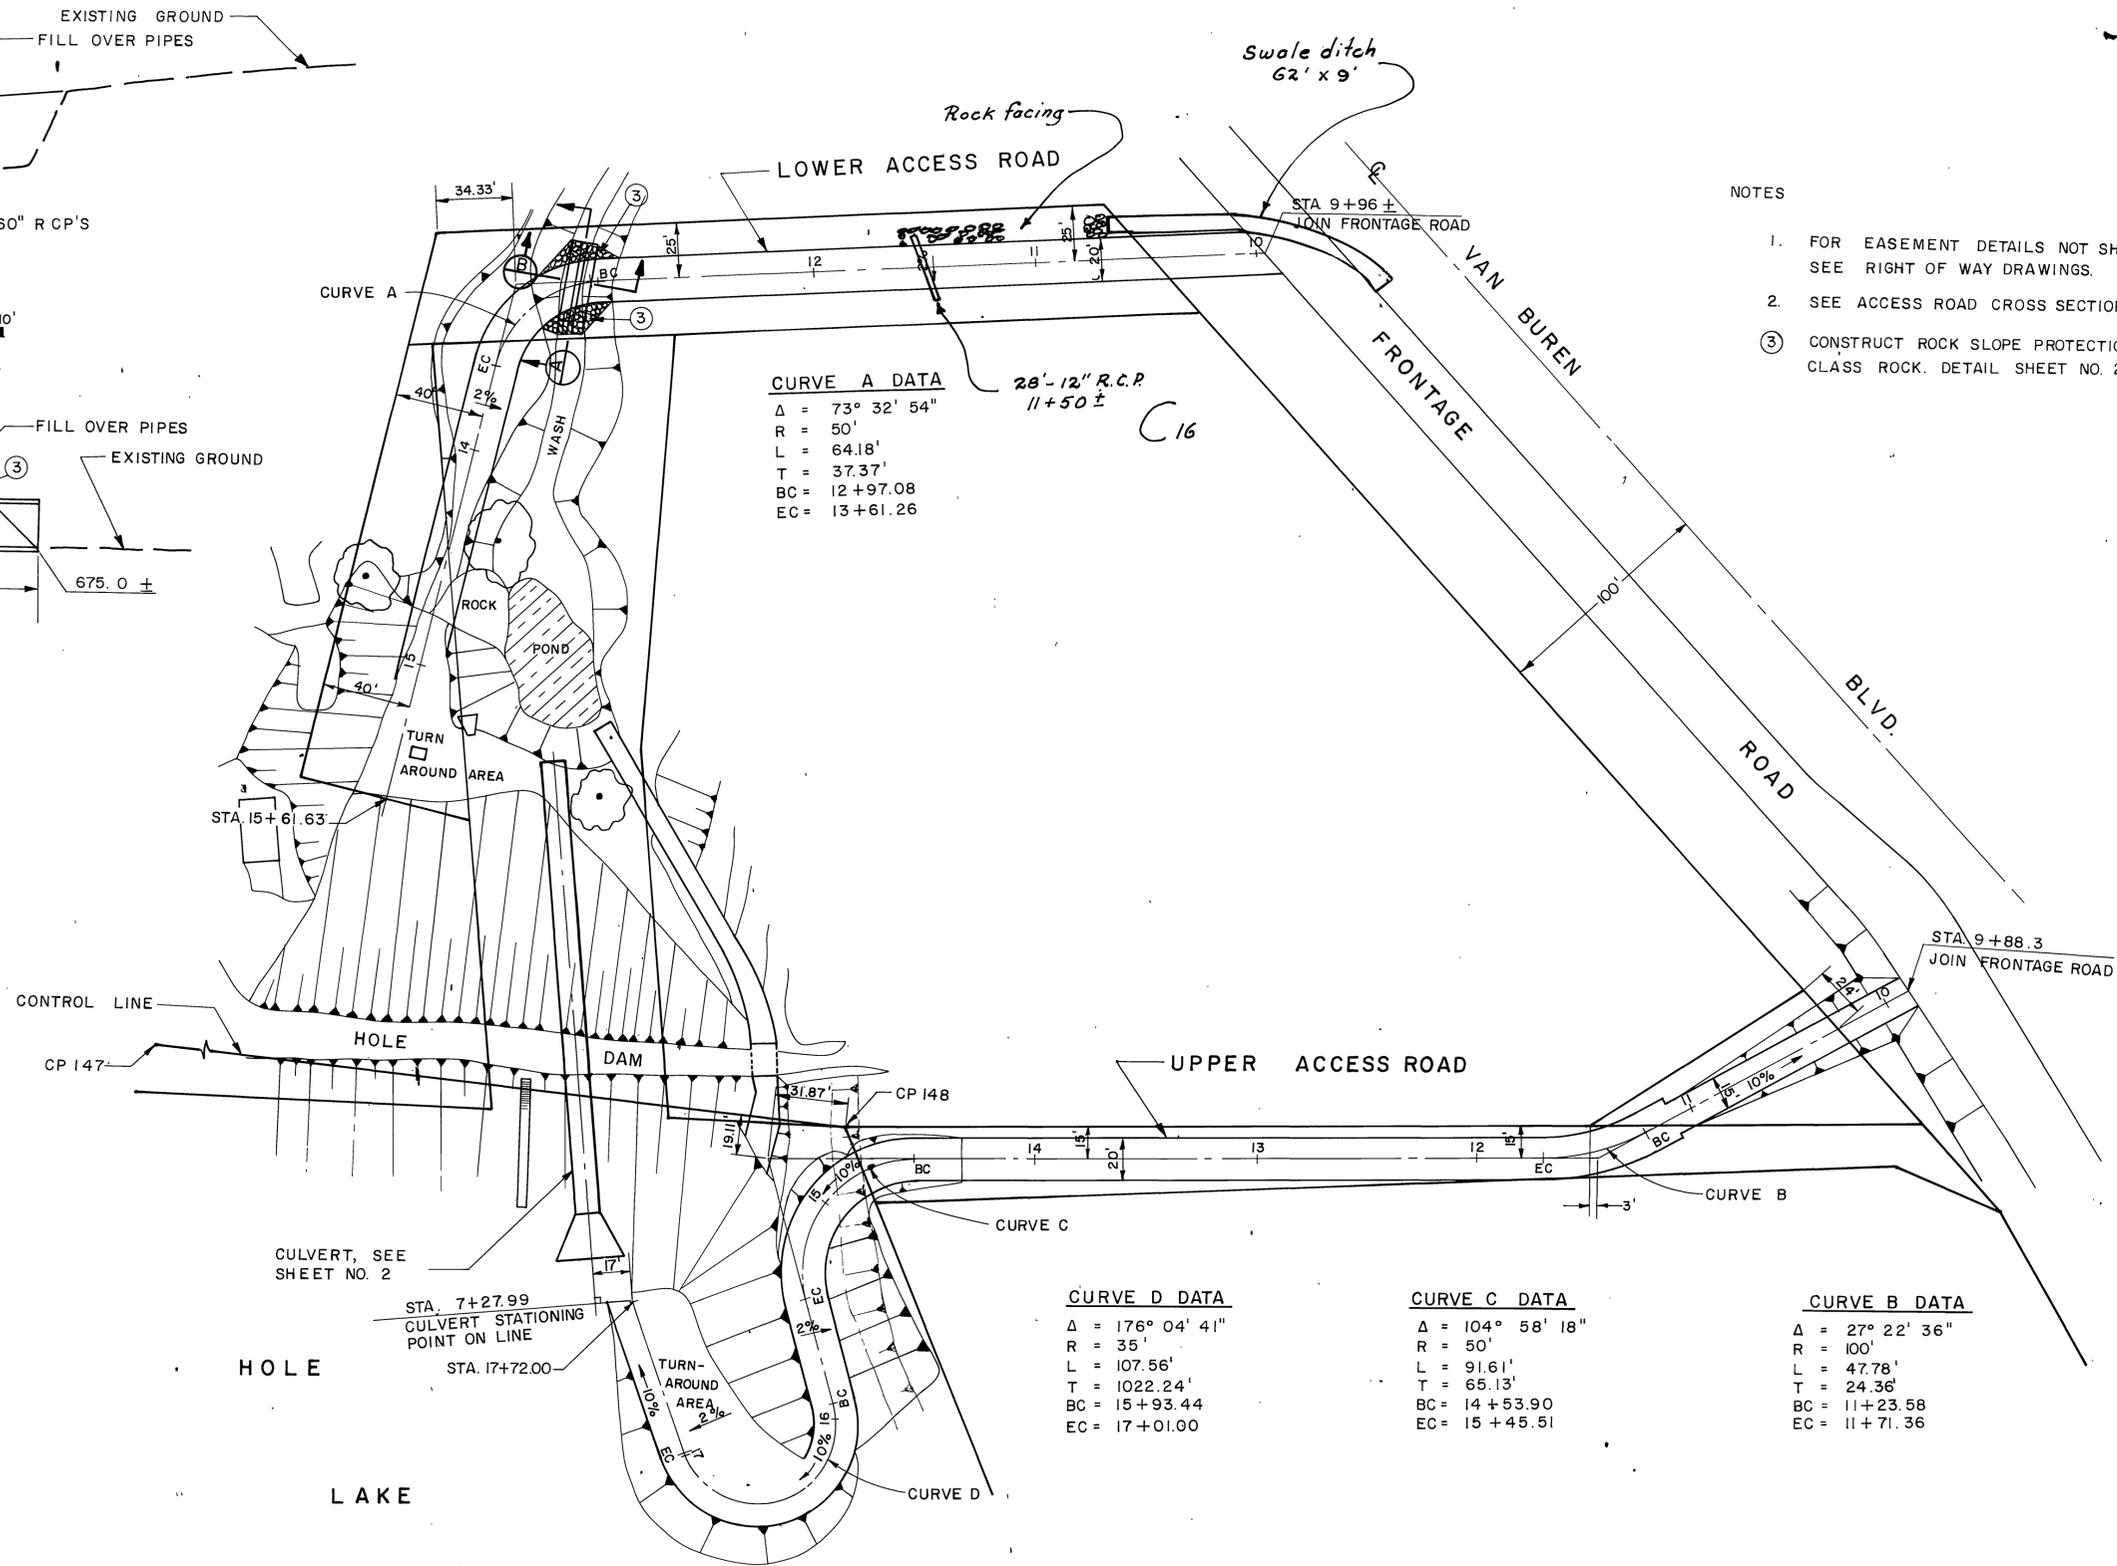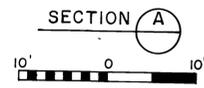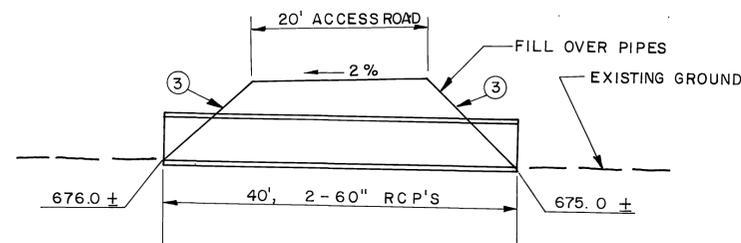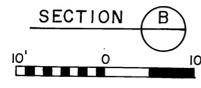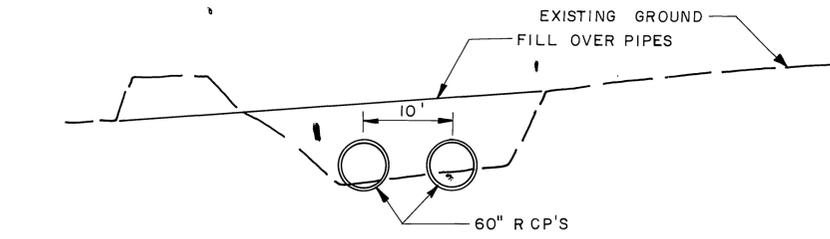

- NOTES
1. FOR EASEMENT DETAILS NOT SHOWN HEREON, SEE RIGHT OF WAY DRAWINGS.
  2. SEE ACCESS ROAD CROSS SECTIONS SHEET NO. 32.
  3. CONSTRUCT ROCK SLOPE PROTECTION, FACING CLASS ROCK. DETAIL SHEET NO. 26.


**CURVE A DATA**  
 $\Delta = 73^\circ 32' 54''$   
 $R = 50'$   
 $L = 64.18'$   
 $T = 37.37'$   
 $BC = 12+97.08$   
 $EC = 13+61.26$

**28'-12" R.C.P.**  
 $11+50 \pm$

**CURVE D DATA**  
 $\Delta = 176^\circ 04' 41''$   
 $R = 35'$   
 $L = 107.56'$   
 $T = 1022.24'$   
 $BC = 15+93.44$   
 $EC = 17+01.00$

**CURVE C DATA**  
 $\Delta = 104^\circ 58' 18''$   
 $R = 50'$   
 $L = 91.61'$   
 $T = 65.13'$   
 $BC = 14+53.90$   
 $EC = 15+45.51$


**CURVE B DATA**  
 $\Delta = 27^\circ 22' 36''$   
 $R = 100'$   
 $L = 47.78'$   
 $T = 24.36'$   
 $BC = 11+23.58$   
 $EC = 11+71.36$

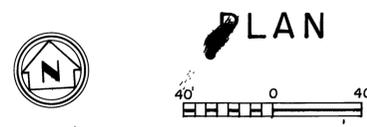



REVISIONS C16 Change as shown REF. DESCRIPTION APPR. DATE CHECKED BY:		RIVERSIDE COUNTY FLOOD CONTROL AND WATER CONSERVATION DISTRICT DESIGNED BY: A.G.K. DRAWN BY: S. Moody DATE DRAWN: 11/16/74 APPROVED BY: John W. Bassant CHIEF ENGINEER R.E. NO. 8822 DATE: 3-4-75		ANZA CHANNEL STAGE I HOLE DAM ACCESS ROADS 1970 STORM DRAIN BOND ISSUE PROJECT NO. 18		PROJECT NO. 1-0-150 DRAWING NO. 1-302 SHEET NO. 31 OF 78	
AS BUILT							

LOWER ACCESS ROAD

UPPER ACCESS ROAD

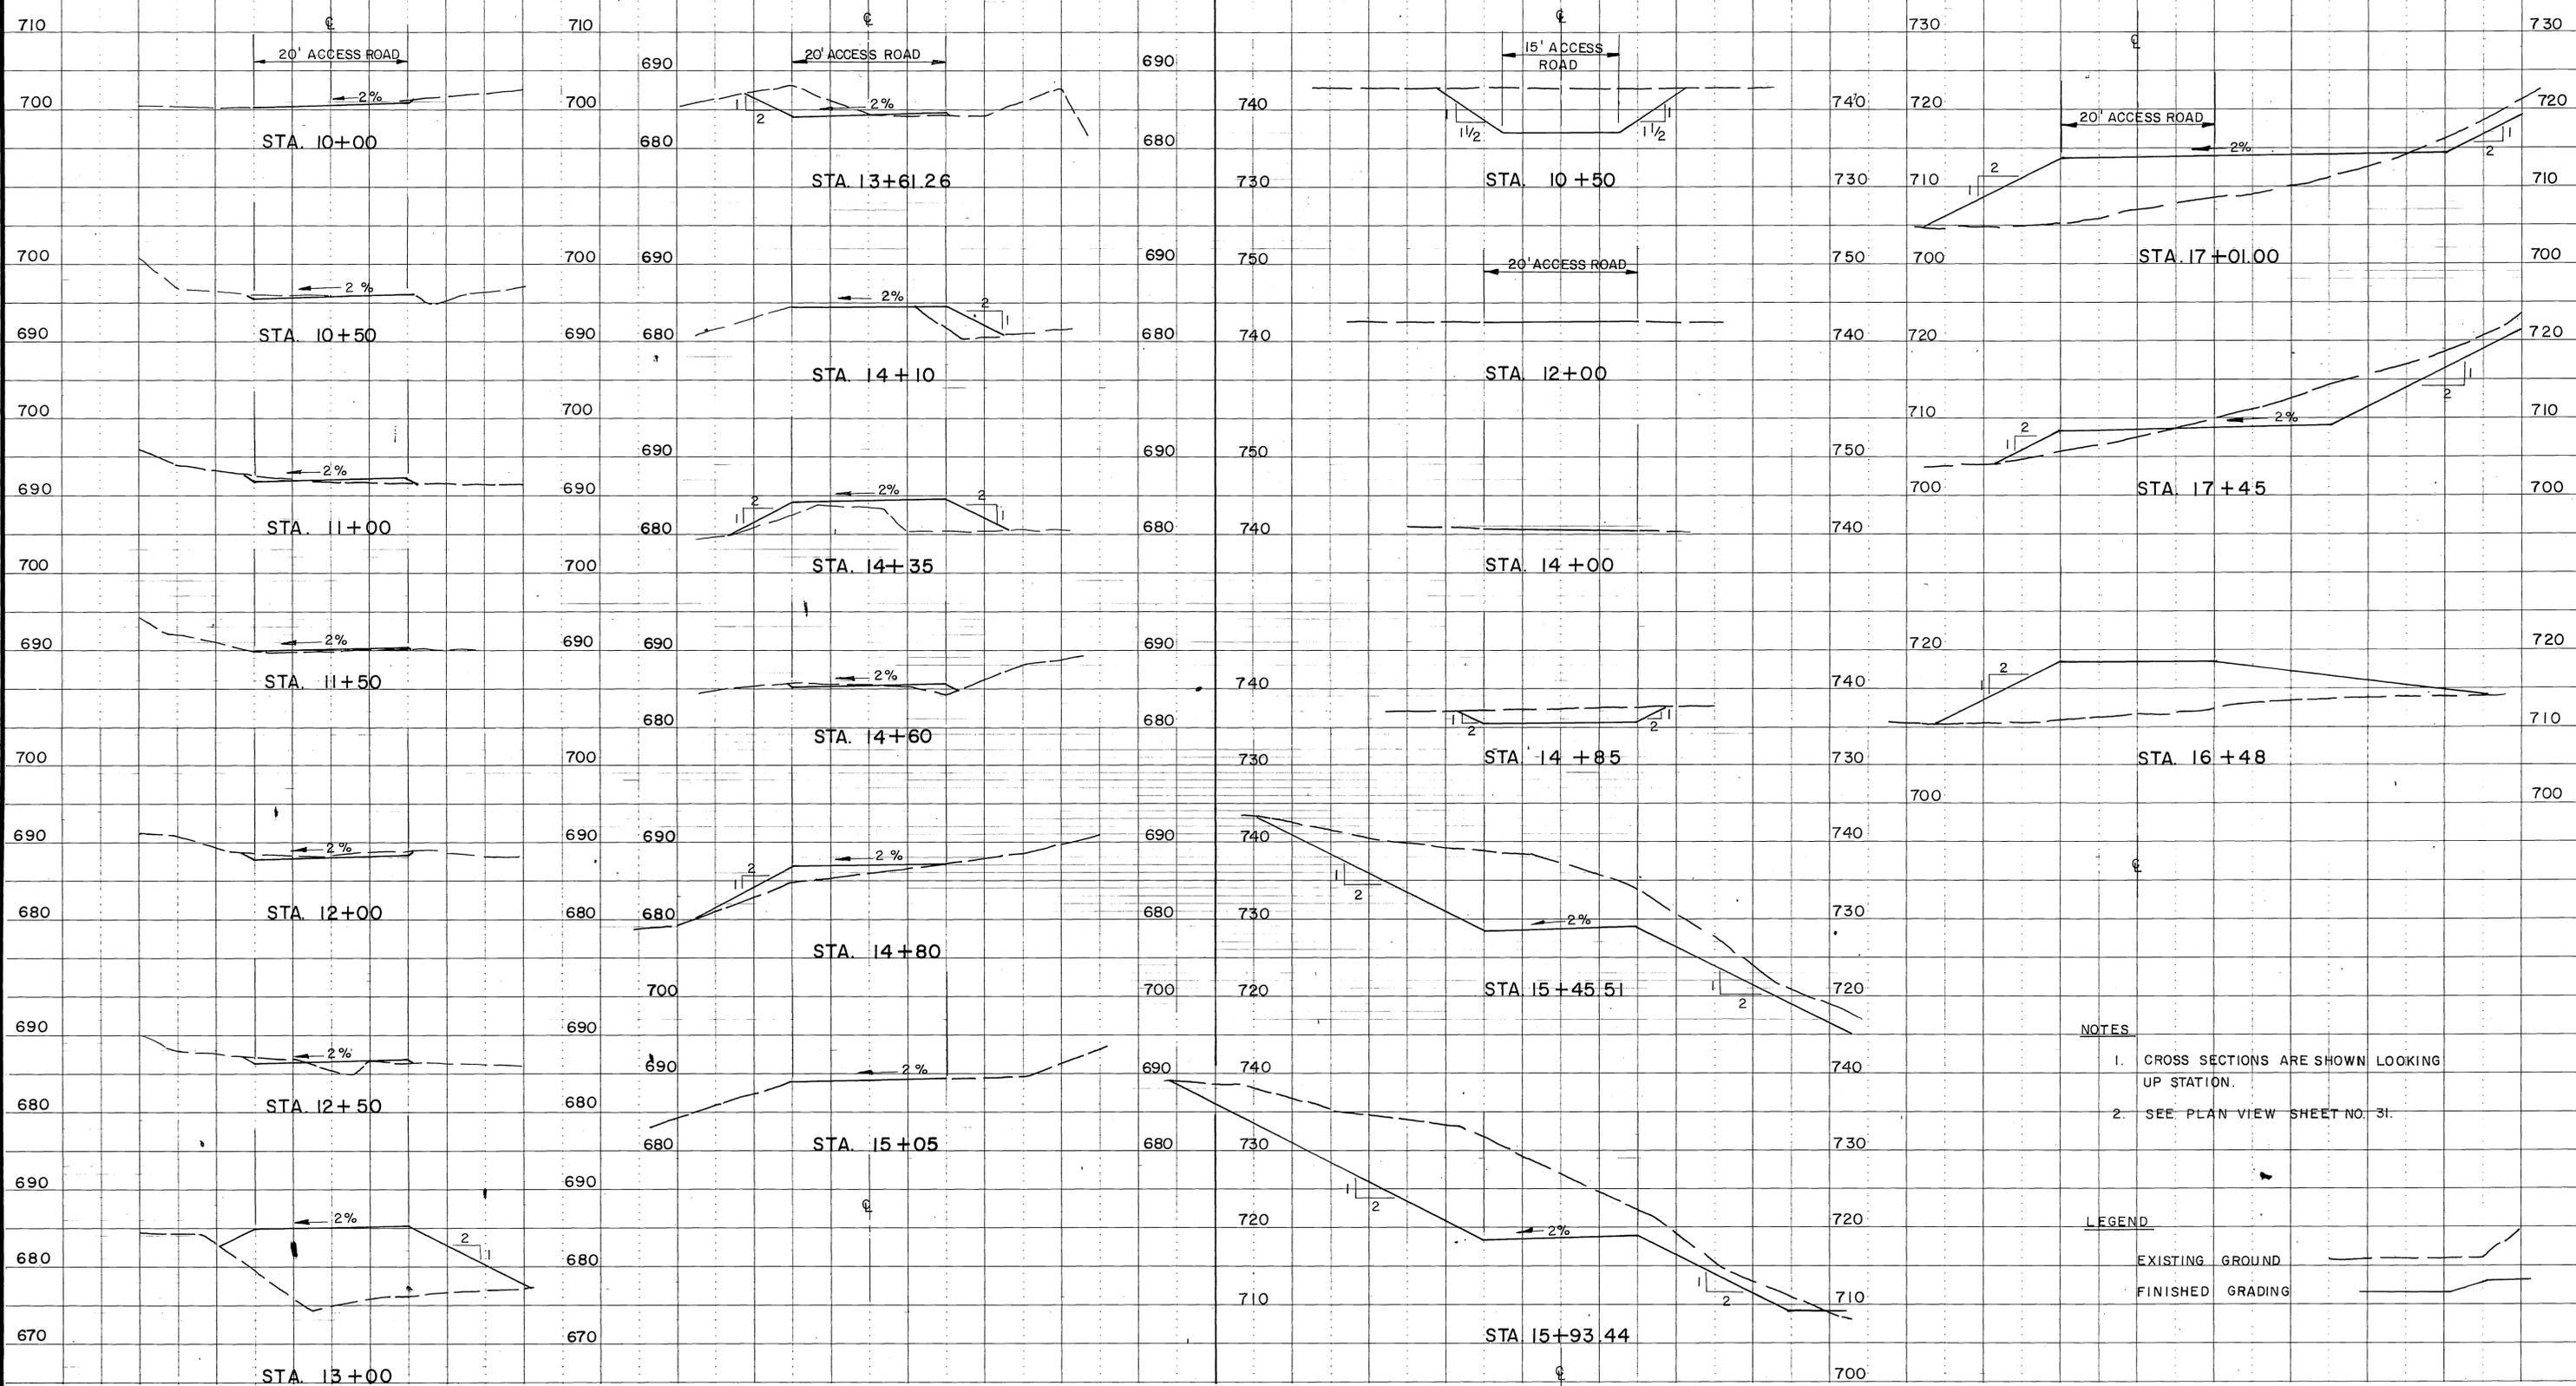


- NOTES**
- CROSS SECTIONS ARE SHOWN LOOKING UP STATION.
  - SEE PLAN VIEW SHEET NO. 31.

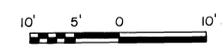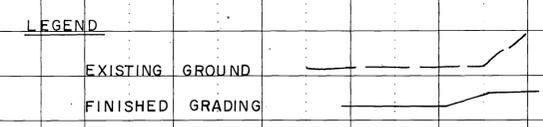

BENCH MARK	REVISIONS		RIVERSIDE COUNTY FLOOD CONTROL AND WATER CONSERVATION DISTRICT		PROJECT NO. 1-0-150
	SCALE:	No Change	DESIGNED BY: AGK	APPROVED BY:	
DATE:	DESCRIPTION		DATE DRAWN:	DATE: 3-2-72	CHEF ENGINEER R.E. NO 8822
	AS BUILT	APPR. DATE	CHECKED BY:		

ANZA CHANNEL  
STAGE I  
ACCESS ROAD CROSS SECTIONS  
1970 STORM DRAIN BOND ISSUE PROJECT NO. 18

D-294

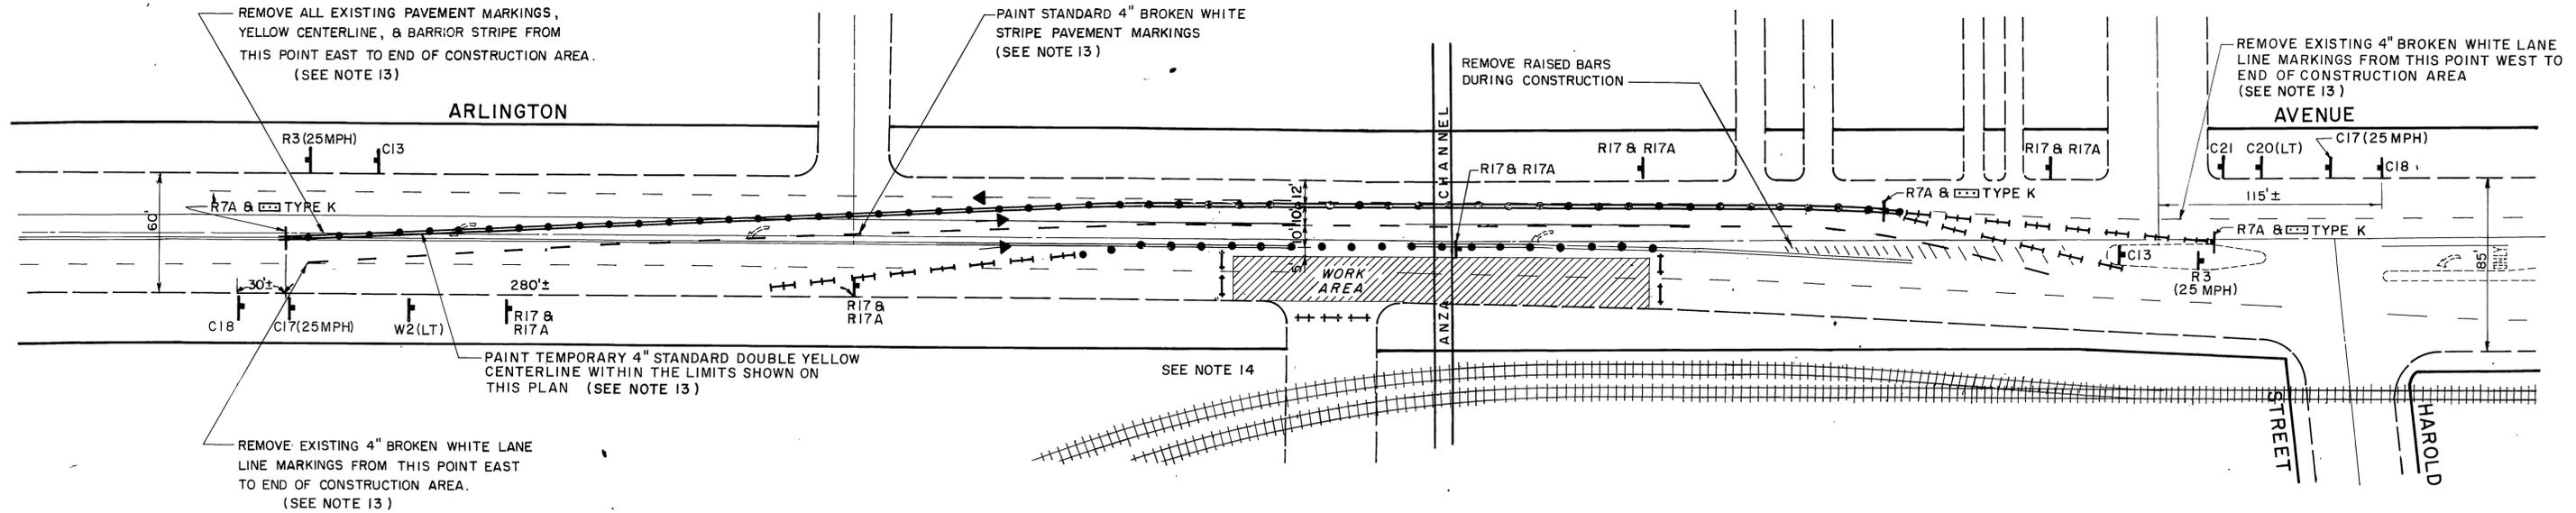

**PEAK TRAFFIC PERIODS (ARLINGTON AVE.)**


DIRECTION	PERIOD	TRAFFIC VOLUME (V.P.H.)
EB	7 <sup>15</sup> - 8 <sup>15</sup> AM	820
EB	3 <sup>30</sup> - 4 <sup>30</sup> PM	1100
WB	11 <sup>30</sup> - 12 <sup>30</sup> PM	620
WB	4 <sup>45</sup> - 5 <sup>45</sup> PM	910

**NOTES**

- ALL WARNING SIGNS, DELINEATORS AND BARRICADES USED DURING NIGHTTIME CONDITIONS SHALL BE REFLECTORIZED, INTERNALLY ILLUMINATED OR FLASHER EQUIPPED.
- ALL CONSTRUCTION SIGNS, DELINEATORS ETC., USED DURING CONSTRUCTION SHALL CONFORM TO THE "MANUAL OF WARNING SIGNS, LIGHTS AND DEVICES FOR USE IN PERFORMANCE OF WORK UPON HIGHWAYS" - ISSUED BY THE CALIFORNIA DEPT. OF TRANSPORTATION, 1973
- DELINEATORS, CONES OR FLASHER BARRICADES SHALL BE PLACED 15' APART UNLESS OTHERWISE SHOWN ON THIS PLAN
- ALL REGULATORY AND WARNING SIGNS HEREIN ARE AS REFERRED TO IN THE 1971 STATE OF CALIFORNIA TRAFFIC MANUAL, CHAPTER 4.
- TWO LANES OF EASTBOUND TRAFFIC AND ONE LANE OF WESTBOUND TRAFFIC MUST BE MAINTAINED BETWEEN THE HOURS OF 6:30 A.M. TO 8:30 A.M. AND 3:30 P.M. TO 6:00 P.M.
- ALL BARRICADES HEREIN ARE STANDARD TYPE II & III FLASHER EQUIPPED.
- TRAFFIC DELINEATORS SHALL NOT EXCEED 18" IN ANY HORIZONTAL DIMENSION (INCLUDING THE BASE).
- ON-STREET PARKING WITHIN THE CONSTRUCTION AREA SHALL BE PROHIBITED
- LEFT TURNS FROM ARLINGTON AVE., WITHIN THE CONSTRUCTION AREA, SHALL BE PROHIBITED AT ALL TIMES, EXCEPT WHERE NOTED ON THIS PLAN.
- THERE SHALL BE A MINIMUM OF 5 FEET OF CLEARANCE BETWEEN THE TRAVELWAY AND AN OPEN TRENCH.
- THE LOCATION OF THESE CONSTRUCTION SIGNS ARE ONLY APPROXIMATE AND, THE EXACT LOCATION WILL BE DETERMINED IN THE FIELD BY THE ENGINEER.
- FLASHERS ARE TO BE MAINTAINED IN WORKING ORDER.
- REMOVE ALL TEMPORARY STRIPING AT COMPLETION OF PROJECT COORDINATE WITH PUBLIC SERVICE, STREET MAINTENANCE DIVISION, (787-7251) FOR REPLACEMENT OF STRIPING.
- COORDINATE BLOCKING OF PARKING ENTRANCE WITH ROHR CORPORATION REGARDING POSSIBILITY OF OPENING WESTERLY ENTRANCE TEMPORARILY.

**LEGEND**

- ● ● TRAFFIC DELINEATORS OR CONES.
- ⊥ STANDARD TYPE III BARRICADES WITH FLASHERS
- ⊥ STANDARD TYPE II BARRICADES WITH FLASHERS
- NEW STRIPING
- - - EXISTING STRIPING
- ⊥ SIGN & POST

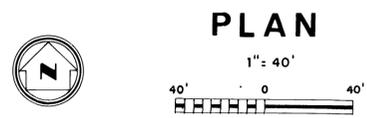

BENCH MARK SCALE: DATE:		APPROVED BY: _____ DATE: _____ REGISTERED CIVIL ENGINEER NO. 11643	REVISIONS <table border="1" style="width: 100%; border-collapse: collapse;"> <thead> <tr> <th>REF</th> <th>DESCRIPTION</th> <th>APPR</th> <th>DATE</th> </tr> </thead> <tbody> <tr> <td> </td> <td> </td> <td> </td> <td> </td> </tr> </tbody> </table>	REF	DESCRIPTION	APPR	DATE					<b>RIVERSIDE COUNTY FLOOD CONTROL AND WATER CONSERVATION DISTRICT</b> DESIGNED BY: I.L.C. DRAWN BY: A.W.S. DATE DRAWN: OCT. 1973 CHECKED BY: W.D.L. I.L.C.	APPROVED BY: _____ CHIEF ENGINEER P.E. NO. 8822 DATE: 3 7 75	<b>ANZA CHANNEL STAGE I ARLINGTON AVENUE TRAFFIC PLAN</b> 1970 STORM DRAIN BOND ISSUE PROJECT NO. 18	PROJECT NO. 1-0-150 DRAWING NO. 1-302 SHEET NO. 33 OF 78
REF	DESCRIPTION	APPR	DATE												

AS BUILT

D-294