


SWING TIES

X-STREET CASTLE WAY

OFFICE USE ONLY

STREET LYNDHURST DRIVE

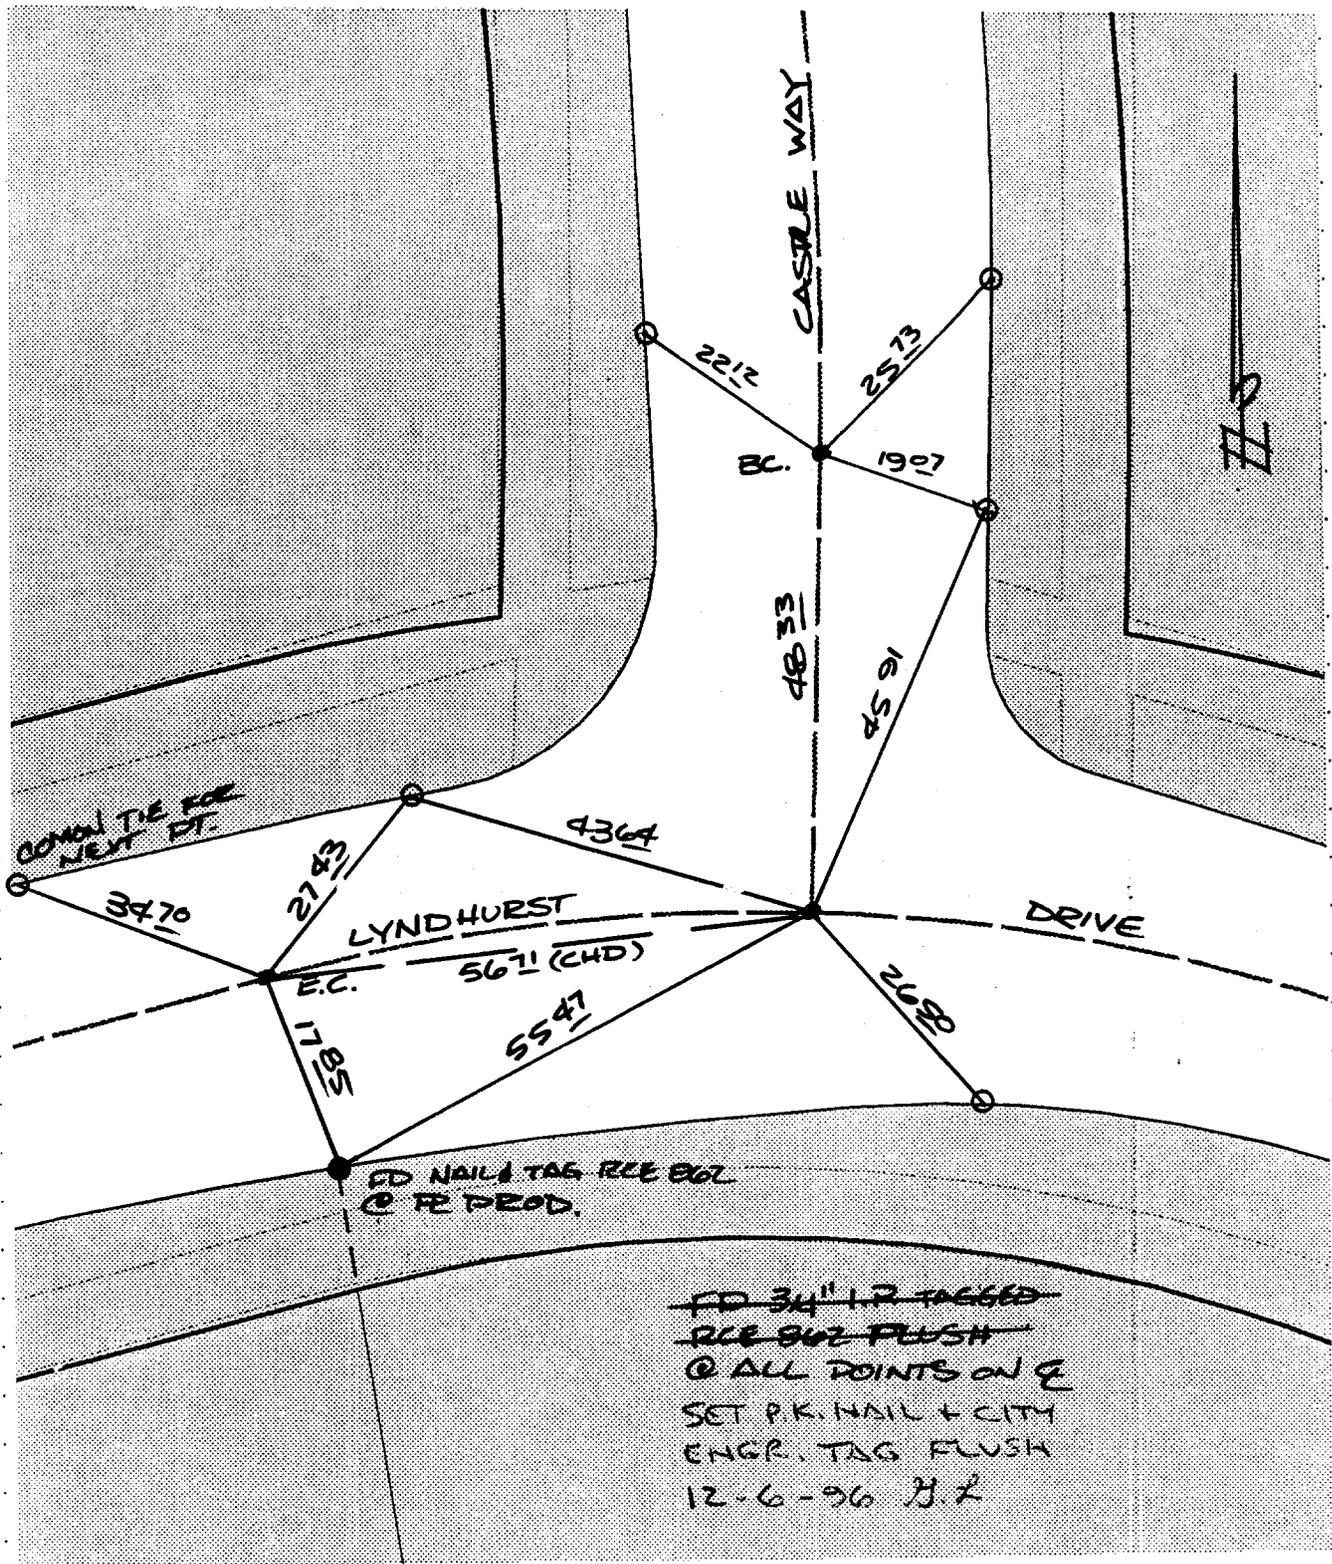

- ✕ FD. Ramset Nail on T/C
- FD. LD. & TK. on T/C
- FD. "C" Nail on T/C
- SET LD. & TK. On T/C

~~FD 3/4" I.P. TAGGED~~
~~REC 862 FLUSH~~
 @ ALL POINTS ON E
 SET P.K. NAIL + CITY
 ENGR. TAG FLUSH
 12-6-96 H.Z

1238.TIF

SCALE: 1" = 20'
DATE: 7/11/96
DR. BY: CURT
W.O.:
F.B.:

OFFICIAL TIE PLAT
 CITY OF RIVERSIDE

These ties are for the purpose of perpetuating the found monumentation. No claim is made as to the relationship of the points or lines shown hereon to true boundary locations.

SHEET
OF SHEETS
FILE NO.: