


SWING TIES

HISTORICAL DATA

-STATE HWY TIES ~~DATED~~  
 -CRFB 206/4

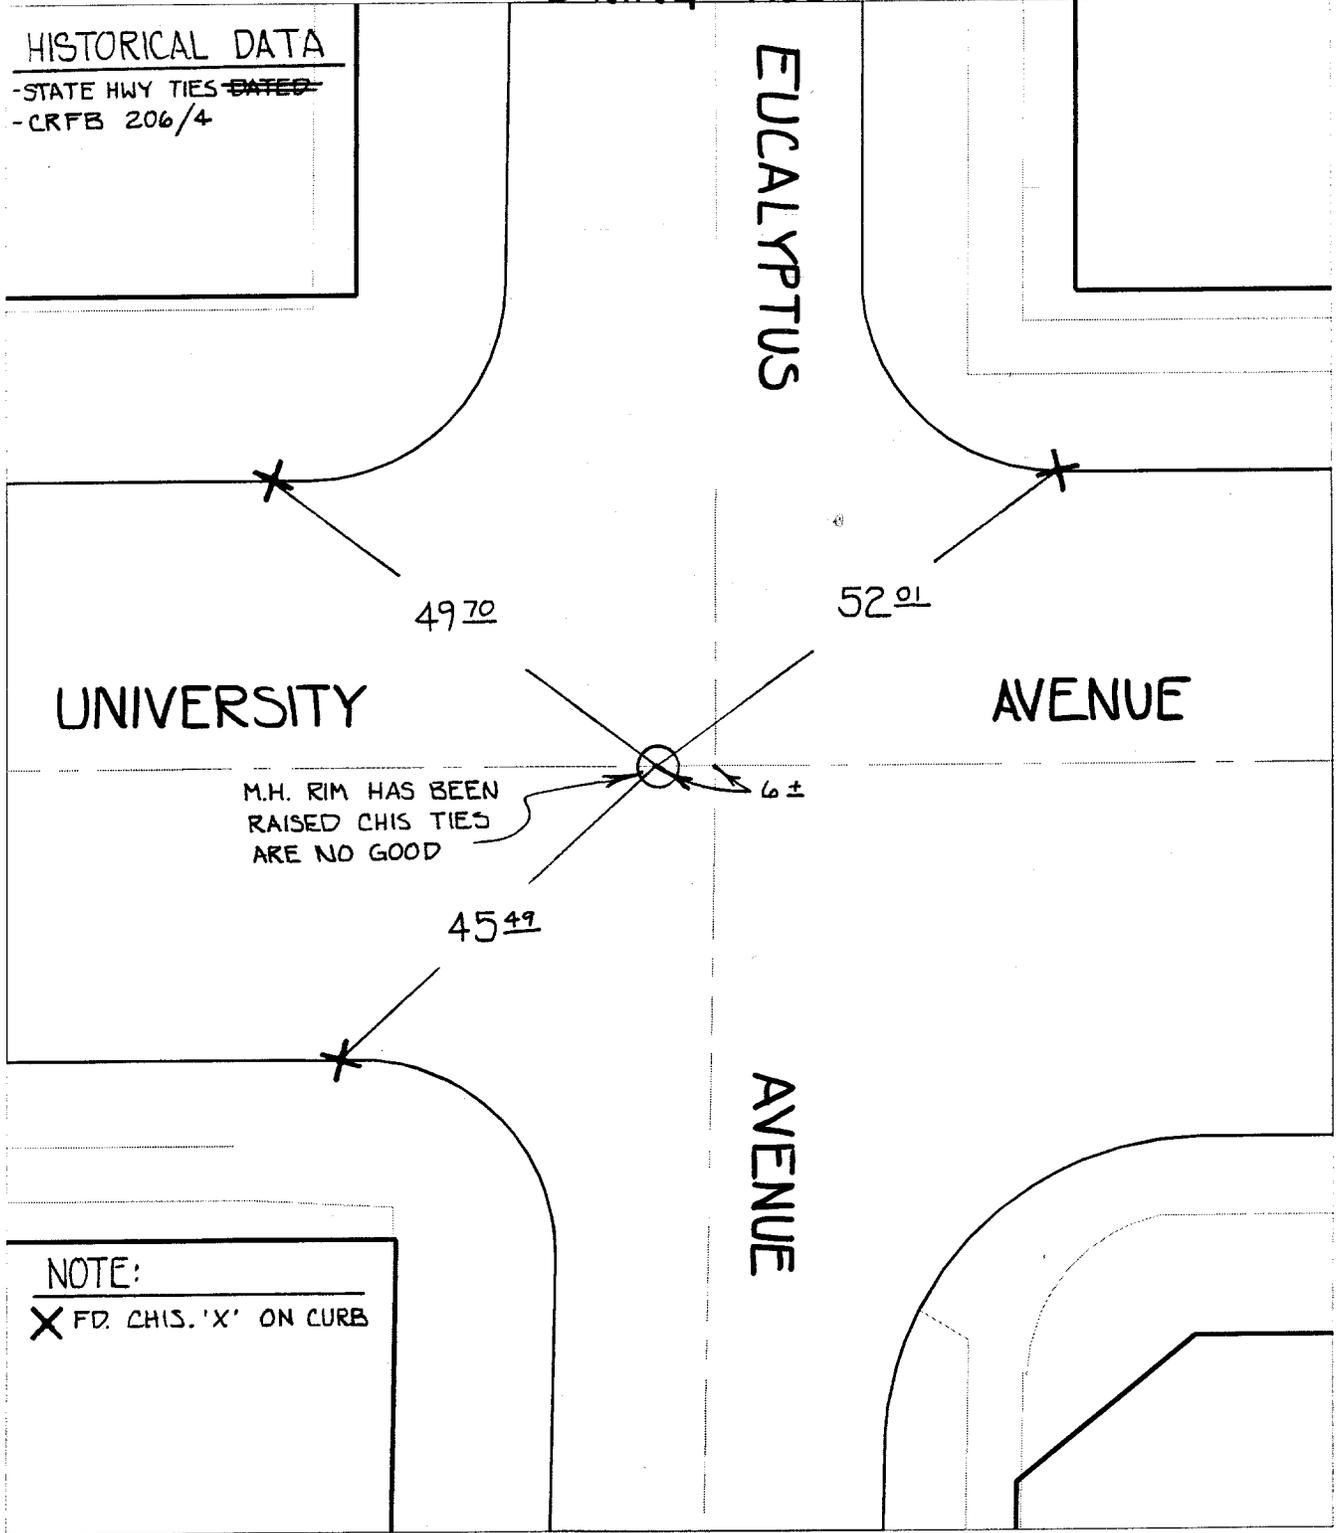

M.H. RIM HAS BEEN RAISED CHIS TIES ARE NO GOOD

NOTE:

X FD. CHIS. 'X' ON CURB

X ~~FD. Ramset Nail on T/C~~  
 ■ FD. "C" Nail on T/C

● FD. LD. & TK. on T/C  
 ○ Set LD. & TK. on T/C

Street: 7994.71E UNIVERSITY AVENUE  
 X-Street: EUCALYPTUS AVENUE  
 OFFICIAL USE ONLY

10

Scale: 1" = 20'

Date: 10/08/98

Drawn by: SURVEY

W.O.:

F.B.:

OFFICIAL TIE PLAT  
 CITY OF RIVERSIDE

*These ties are for the purpose of perpetuating the found monumentation. No claim is made as to the relationship of the points or lines shown hereon to true boundary locations.*



Sheet 1 of 1

File No.: 10