


SWING TIES

Street: **C 98th**

RAMBLING CT.

OFFICIAL USE ONLY
X-Street:

CUL-DE-SAC

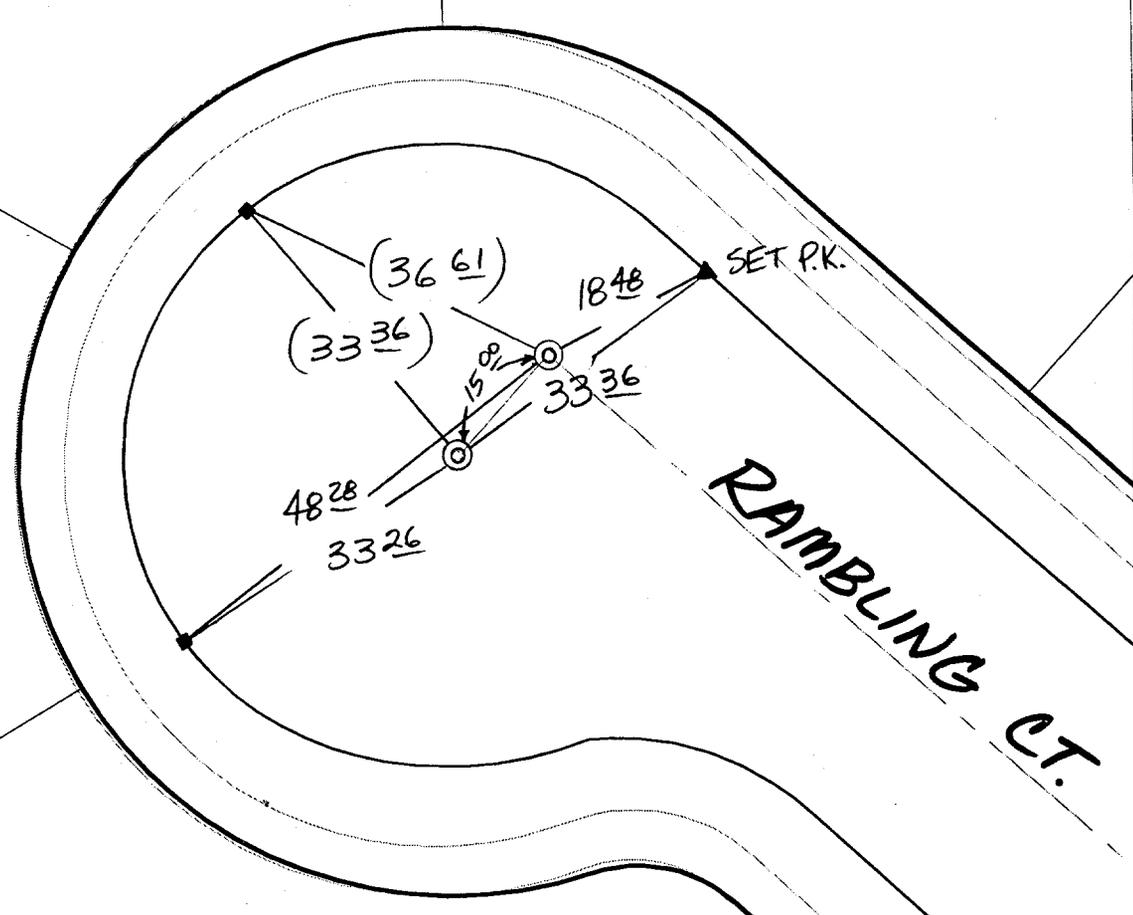

() - INDICATES RECORD DISTANCE
 * ALL DISTANCES FLAT CHAINED *
 © - ~~3/4" I.P. SET PER MB. 56/75, 76, 177~~
~~W/ L.S. TAG 3163 2x2' N&TK TIES~~
 RESET W/ P.K. NL & CITY ENGR TAG FLUSH

- ✕ FD. Ramset Nail on T/C ● FD. LD. & TK. on T/C P.K. and City Engineer tag to be set @ surface after street construction is complete. (If possible)
- FD. "C" Nail on T/C ○ Set LD. & TK. on T/C

Scale: 1" = 20'
 Date: 02/16/01
 Drawn by: survey
 W.O.:
 F.B.:

OFFICIAL TIE PLAT CITY OF RIVERSIDE

These ties are for the purpose of perpetuating the found monumentation. No claim is made as to the relationship of the points or lines shown hereon to true boundary locations.



Sheet 1 of 1
 File No.: