


SWING TIES

Street: **9815** SPRUCE ST. (TRACT BDY.)
 X-Street: E'LY OF FLANDERS RD.
 OFFICIAL USE ONLY

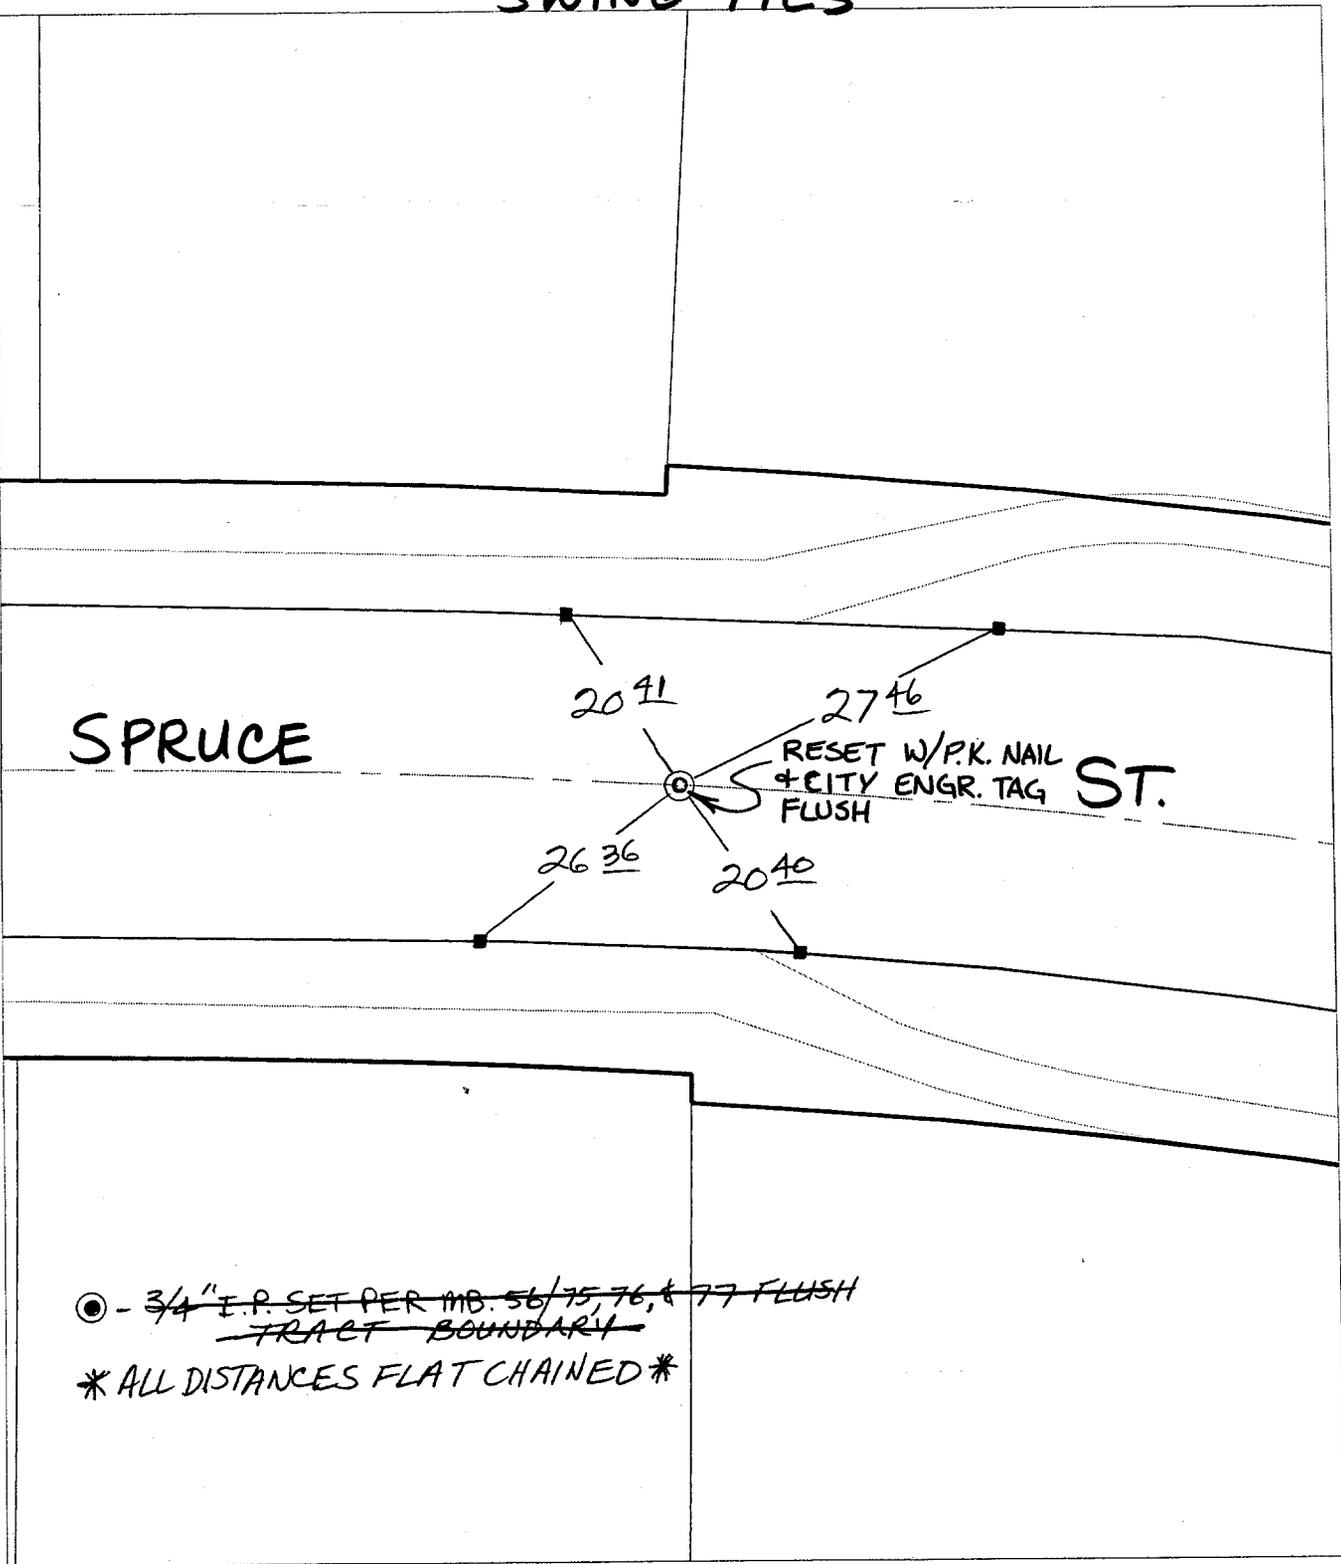

⊙ - ~~3/4" I.P. SET PER MB. 56/75, 76, & 77 FLUSH~~
~~TRACT BOUNDARY~~
 * ALL DISTANCES FLAT CHAINED *

- ✕ FD. Ramset Nail on T/C ● FD. LD. & TK. on T/C P.K. and City Engineer tag to be set @ surface after street construction is complete. (If possible)
- FD. "C" Nail on T/C ○ Set LD. & TK. on T/C

Scale: 1" = 20'
 Date: 02/16/01
 Drawn by: survey
 W.O.:
 F.B.:

OFFICIAL TIE PLAT
 CITY OF RIVERSIDE

These ties are for the purpose of perpetuating the found monumentation. No claim is made as to the relationship of the points or lines shown hereon to true boundary locations.

Sheet 1 of 1
 File No.: