


SWING TIES

Street: **C 9828** NINTH ST.

OFFICIAL USE ONLY

X-Street: **PARK AVE.**

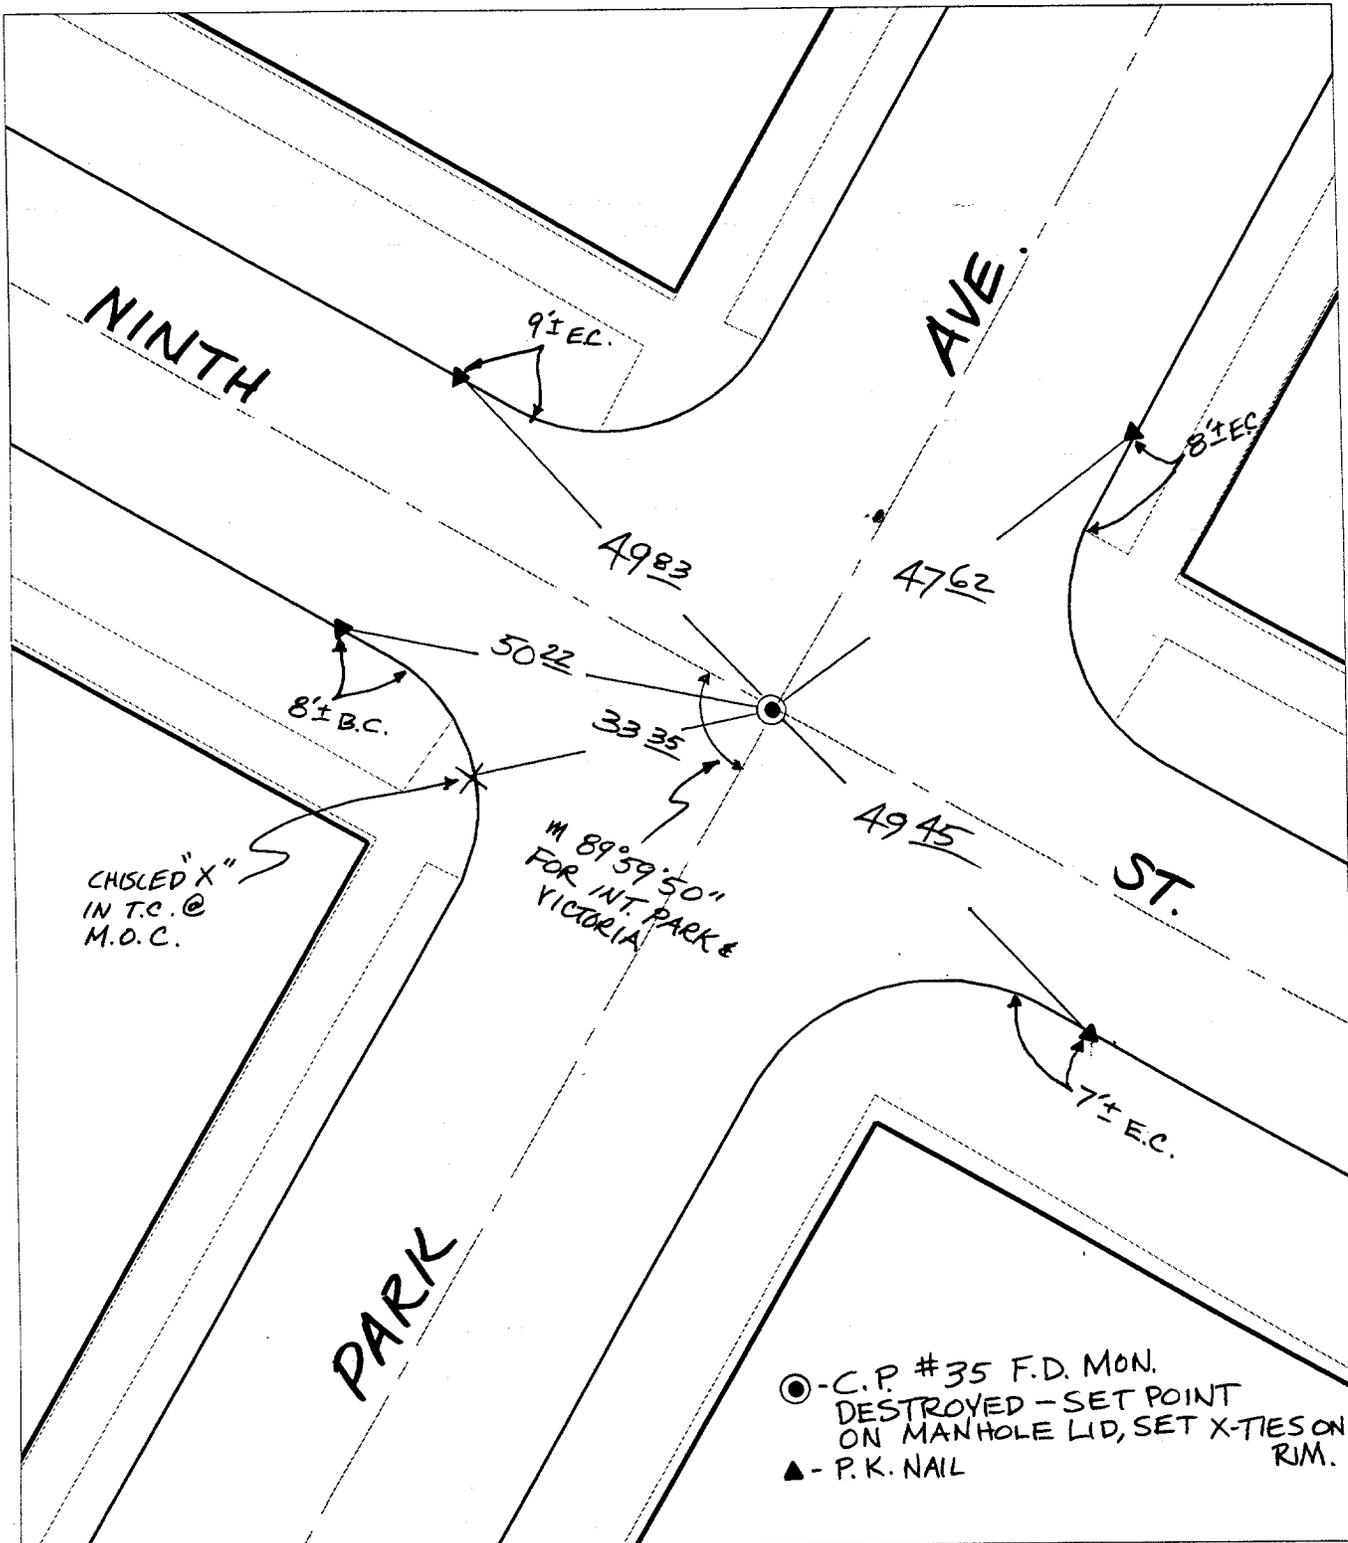

CHISELED "X"
IN T.C. @
M.O.C.

● - C.P. #35 F.D. MON.
DESTROYED - SET POINT
ON MANHOLE LID, SET X-TIES ON
R.I.M.
▲ - P.K. NAIL

- ✕ FD. Ramset Nail on T/C ● FD. LD. & TK. on T/C
- FD. "C" Nail on T/C ○ Set LD. & TK. on T/C

P.K. and City Engineer tag to be set @
surface after street construction is
complete. (If possible)

Scale: 1" = 20'
Date: 02/08/01
Drawn by: scurtis
W.O.:
F.B.:

OFFICIAL TIE PLAT CITY OF RIVERSIDE

*These ties are for the purpose of perpetuating the found
monumentation. No claim is made as to the relationship of
the points or lines shown hereon to true boundary locations.*



Sheet 1 of 1
File No.: