


# TRANSIT TIES

**NOTE:**

~~FD. 3/4" I.P. DN.~~  
~~IN A WELL MON.~~  
~~W/X-TIES~~  
 RESET P.K. & CITY  
 ENGR. TAG

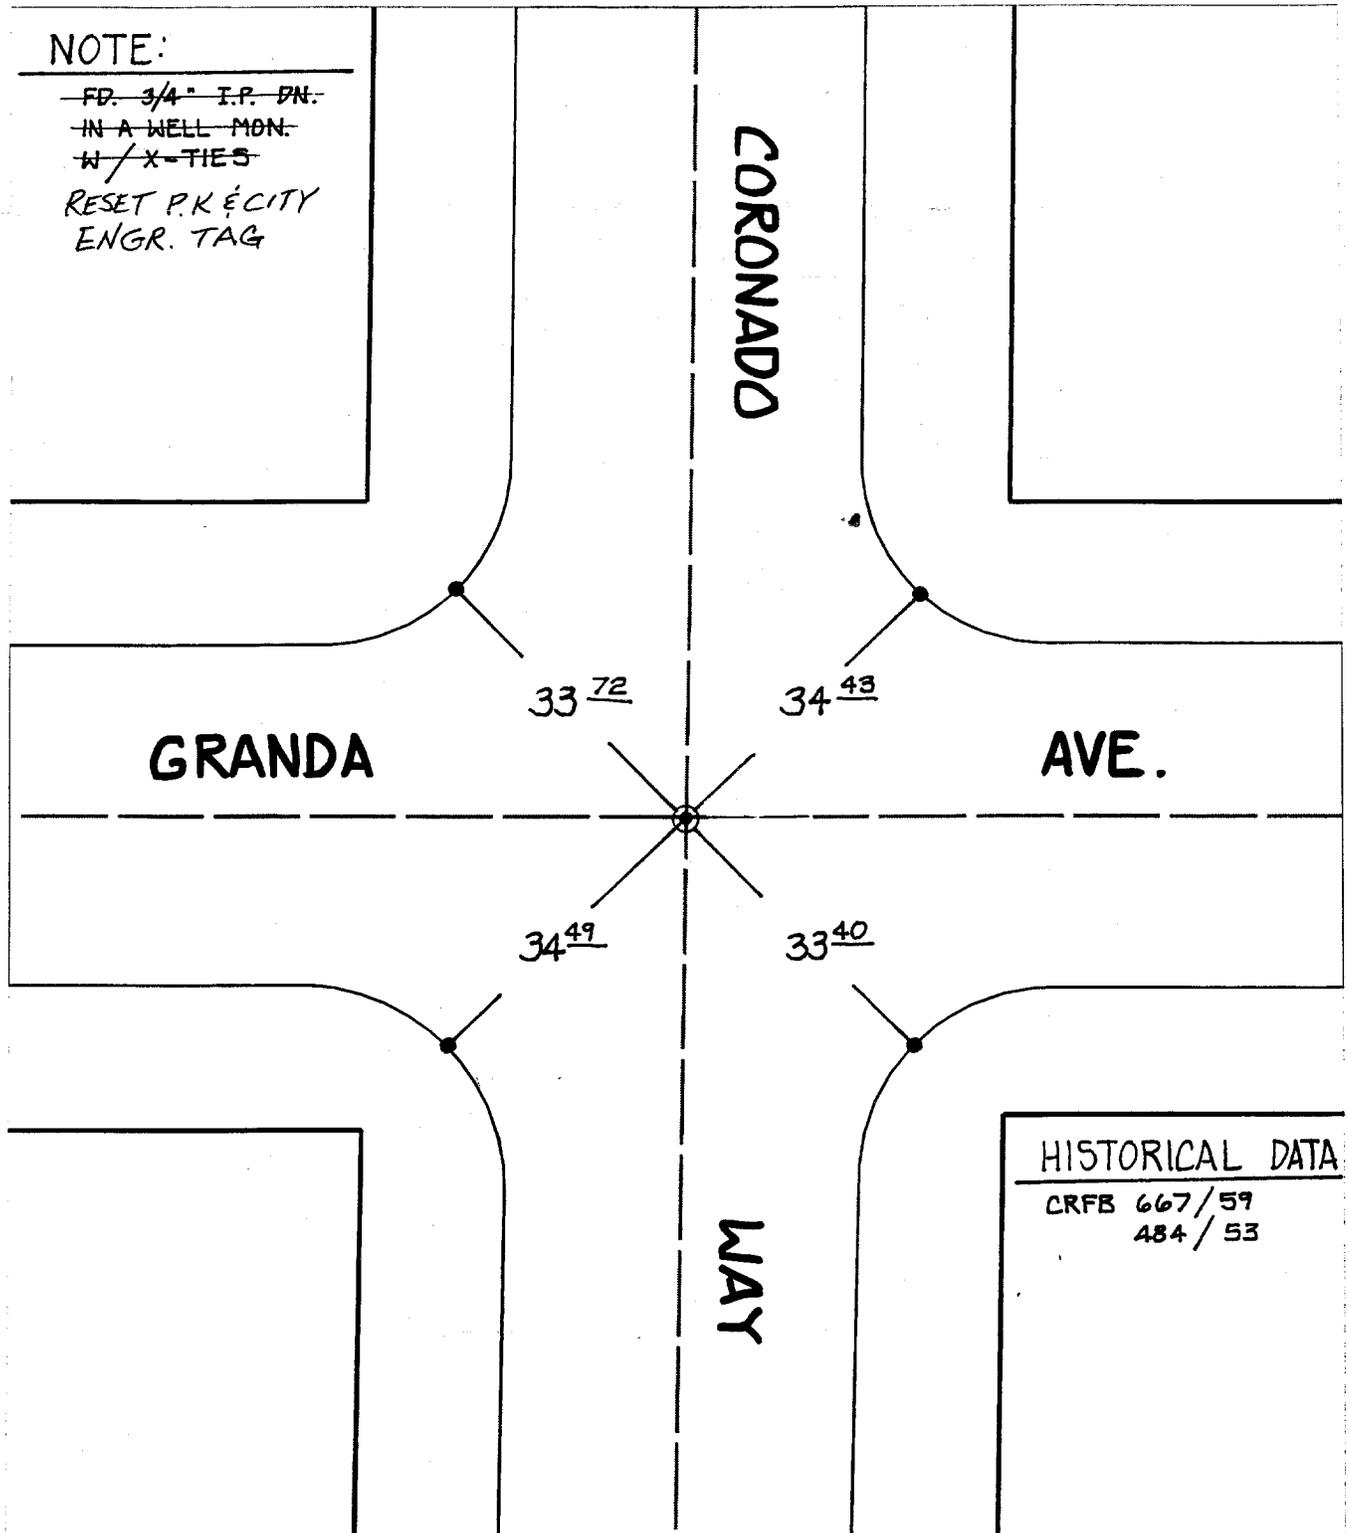

Street:

9845 CORONADO WAY

X-Street: OFFICIAL USE ONLY


GRANADA AVE

- ✕ FD. Ramset Nail on T/C
- FD. LD. & TK. on T/C
- FD. "C" Nail on T/C
- Set LD. & TK. on T/C

Scale: 1" = 20'  
 Date: 11/23/99  
 Drawn by: scurtis  
 W.O.:  
 F.B.:

## OFFICIAL TIE PLAT CITY OF RIVERSIDE

*These ties are for the purpose of perpetuating the found monumentation. No claim is made as to the relationship of the points or lines shown hereon to true boundary locations.*

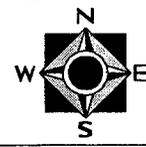

Sheet 1 of 1  
 File No.: