



SCALE: 1" = 400'

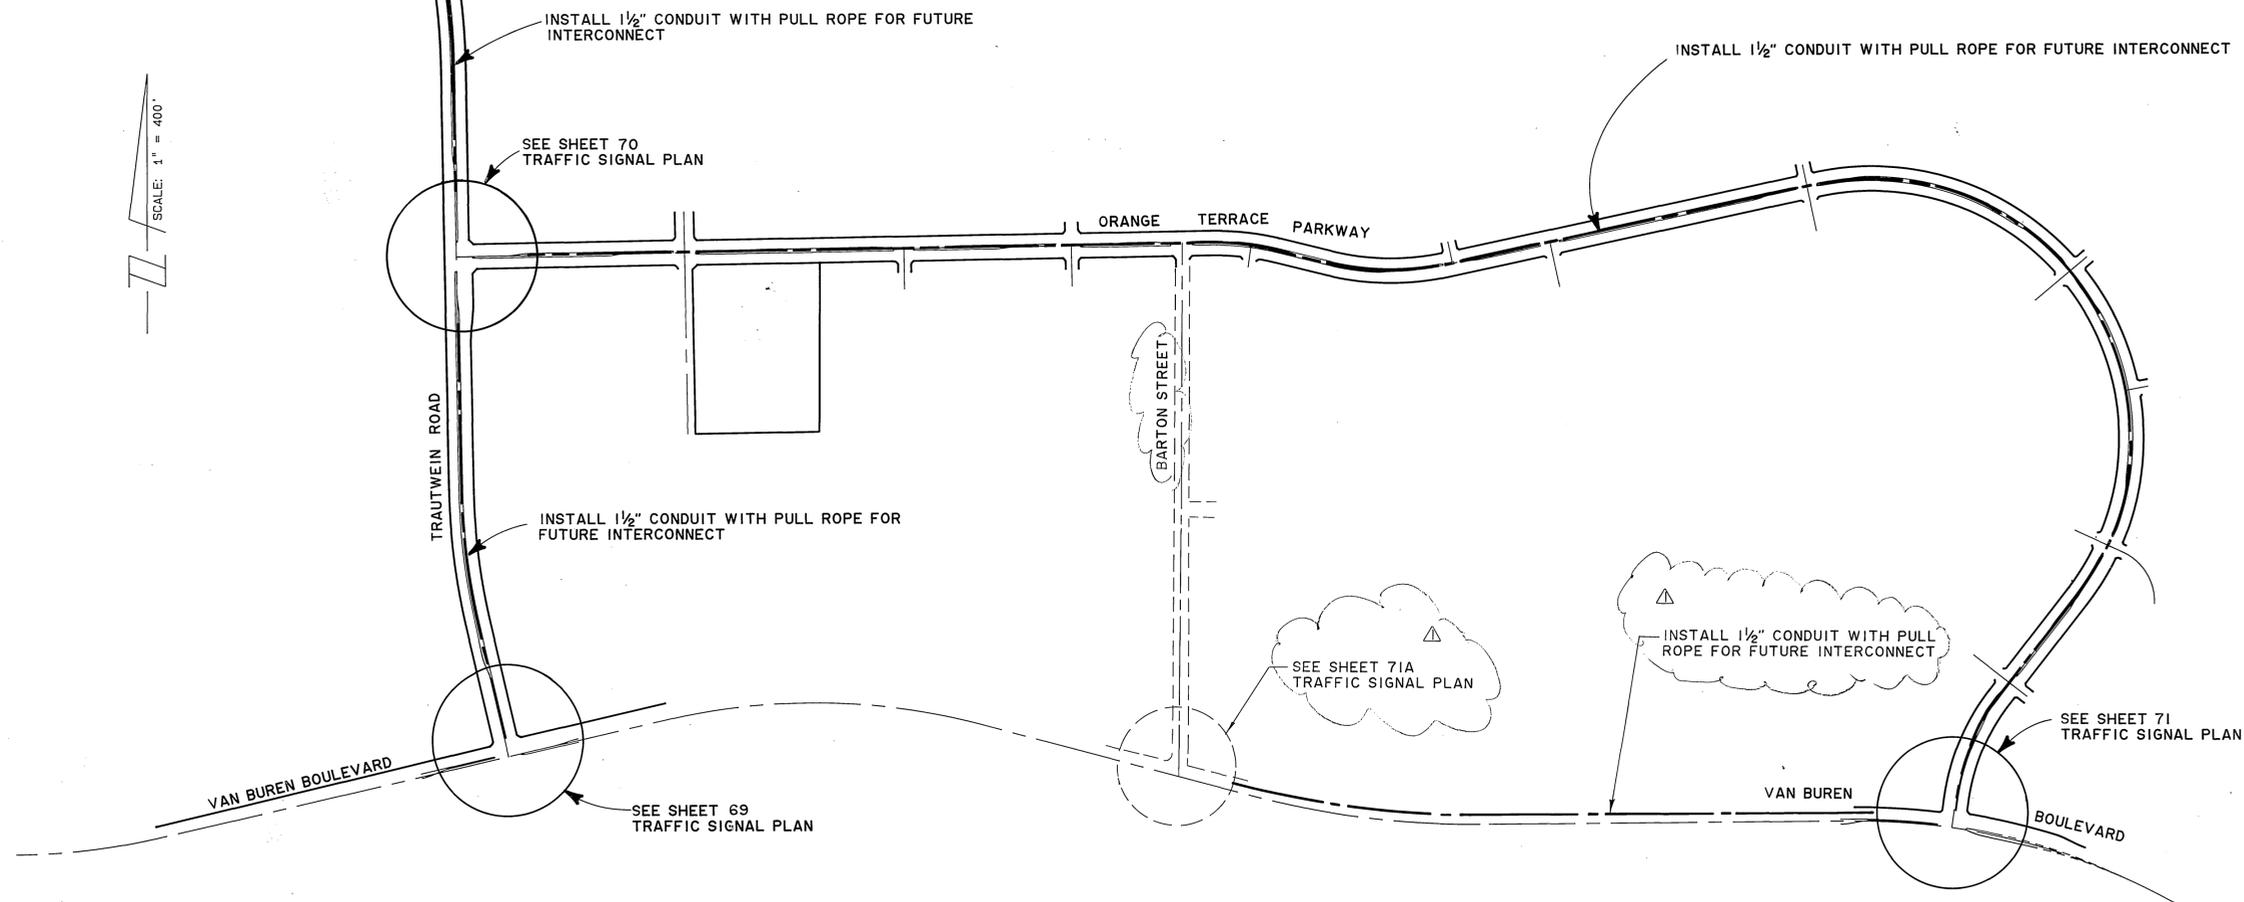

NOTES:

1. ALL WORK AND MATERIAL SHALL CONFORM TO THE STATE OF CALIFORNIA STANDARD PLANS AND SPECIFICATIONS DATED 1988 AND THE SPECIAL PROVISIONS FOR THIS PROJECT.
2. PULL BOXES SHALL BE No. 5 UNLESS OTHERWISE INDICATED.
3. AT MEDIAN BREAKS A PULL BOX SHALL BE INSTALLED IN EACH MEDIAN NOSE ALONG THE SYSTEM.
4. CONDUIT SHALL BE PROVIDED WITH PULL ROPE THROUGHOUT THE SYSTEM AS SPECIFIED IN THE STANDARD SPECIFICATIONS.

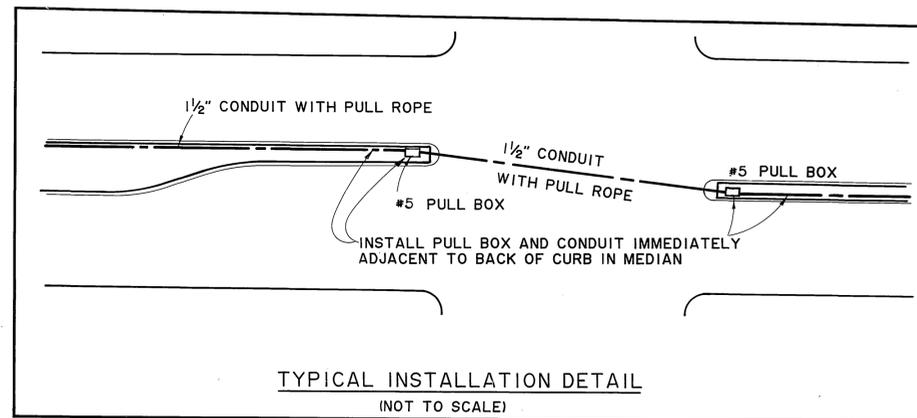

AS BUILT  
 APPROVED BY: \_\_\_\_\_  
 DATE: \_\_\_\_\_



FILE WITH R-2971

Underground Service Alert  
 Call: TOLL FREE  
 1 - 800  
 422 - 4133  
 TWO WORKING DAYS BEFORE YOU DIG

**PRIVATE ENGINEERING NOTE**  
 (NOT REQUIRED BY GOVERNING AGENCY)  
 CONSTRUCTION CONTRACTOR AGREES THAT IN ACCORDANCE WITH GENERALLY ACCEPTED CONSTRUCTION PRACTICES, CONSTRUCTION CONTRACTOR WILL BE RESPONSIBLE TO ASSUME SOLE AND COMPLETE RESPONSIBILITY FOR ALL SITE CONDITIONS ARISING DURING THE COURSE OF CONSTRUCTION OF THE PROJECT, INCLUDING SAFETY OF ALL PERSONS AND PROPERTY. THAT THIS REQUIREMENT SHALL BE MADE TO APPLY CONTINUOUSLY AND NOT BE LIMITED TO NORMAL WORKING HOURS, AND CONSTRUCTION CONTRACTOR FURTHER AGREES TO DEFEND, INDEMNIFY AND HOLD DESIGN PROFESSIONAL HARMLESS FROM ANY AND ALL LIABILITY, REAL OR ALLEGED, IN CONNECTION WITH THE PERFORMANCE OF WORK ON THIS PROJECT, EXCEPTING LIABILITY ARISING FROM THE SOLE NEGLIGENCE OF DESIGN PROFESSIONAL.

PREPARED UNDER THE DIRECTION OF:  
*[Signature]*  
 REGISTERED CIVIL ENGINEER NO. 35458  
 EXPIRATION DATE 9/30/91 DATE 7/22/88  
 APPROVED BY:  
 \_\_\_\_\_

**J F DAVIDSON ASSOCIATES, INC.**  
 CIVIL ENGINEERS • SURVEYORS • PLANNERS  
**JFD ASSOCIATES**  
 P.O. BOX 493 11200 SO. MT. VERNON AVE. #D 73-080 EL PASO, #103  
 □ RIVERSIDE, CA 92502 □ COLTON, CA 92324 □ PALM DESERT, CA 92260  
 (714) 686-0844 (714) 825-1082 (619) 346-5671  
 SCALE NONE BENCH MARK  
 DATE JAN. 1988

MARK	AS-BUILT.	REVISIONS	APPR.	DATE
DESIGNED BY	V.L.	DRAWN BY	R.H.	CHECKED BY


**CITY OF RIVERSIDE, CALIFORNIA**  
**DEPARTMENT OF PUBLIC WORKS**  
 APPROVED BY: *[Signature]*  
 DATE: 3/23/89  
 TRAFFIC DIVISION  
 CHIEF P. W. ENGR. *[Signature]*  
 PUBLIC UTILITIES

CFD 86-1  
**SIGNAL INTERCONNECT PLANS**  
**TRAUTWEIN ROAD**  
 &  
**ORANGE TERRACE PARKWAY**  
 HORIZ. SCALE: 1" = \_\_\_\_\_ VERT. SCALE: 1" = \_\_\_\_\_

PROJECT NO. \_\_\_\_\_  
**X-47**  
 SHEET **72** OF **106**  
 FILE NO. 87-10058


INDEXED 12-9-92 FH

SCALE 1"=200'

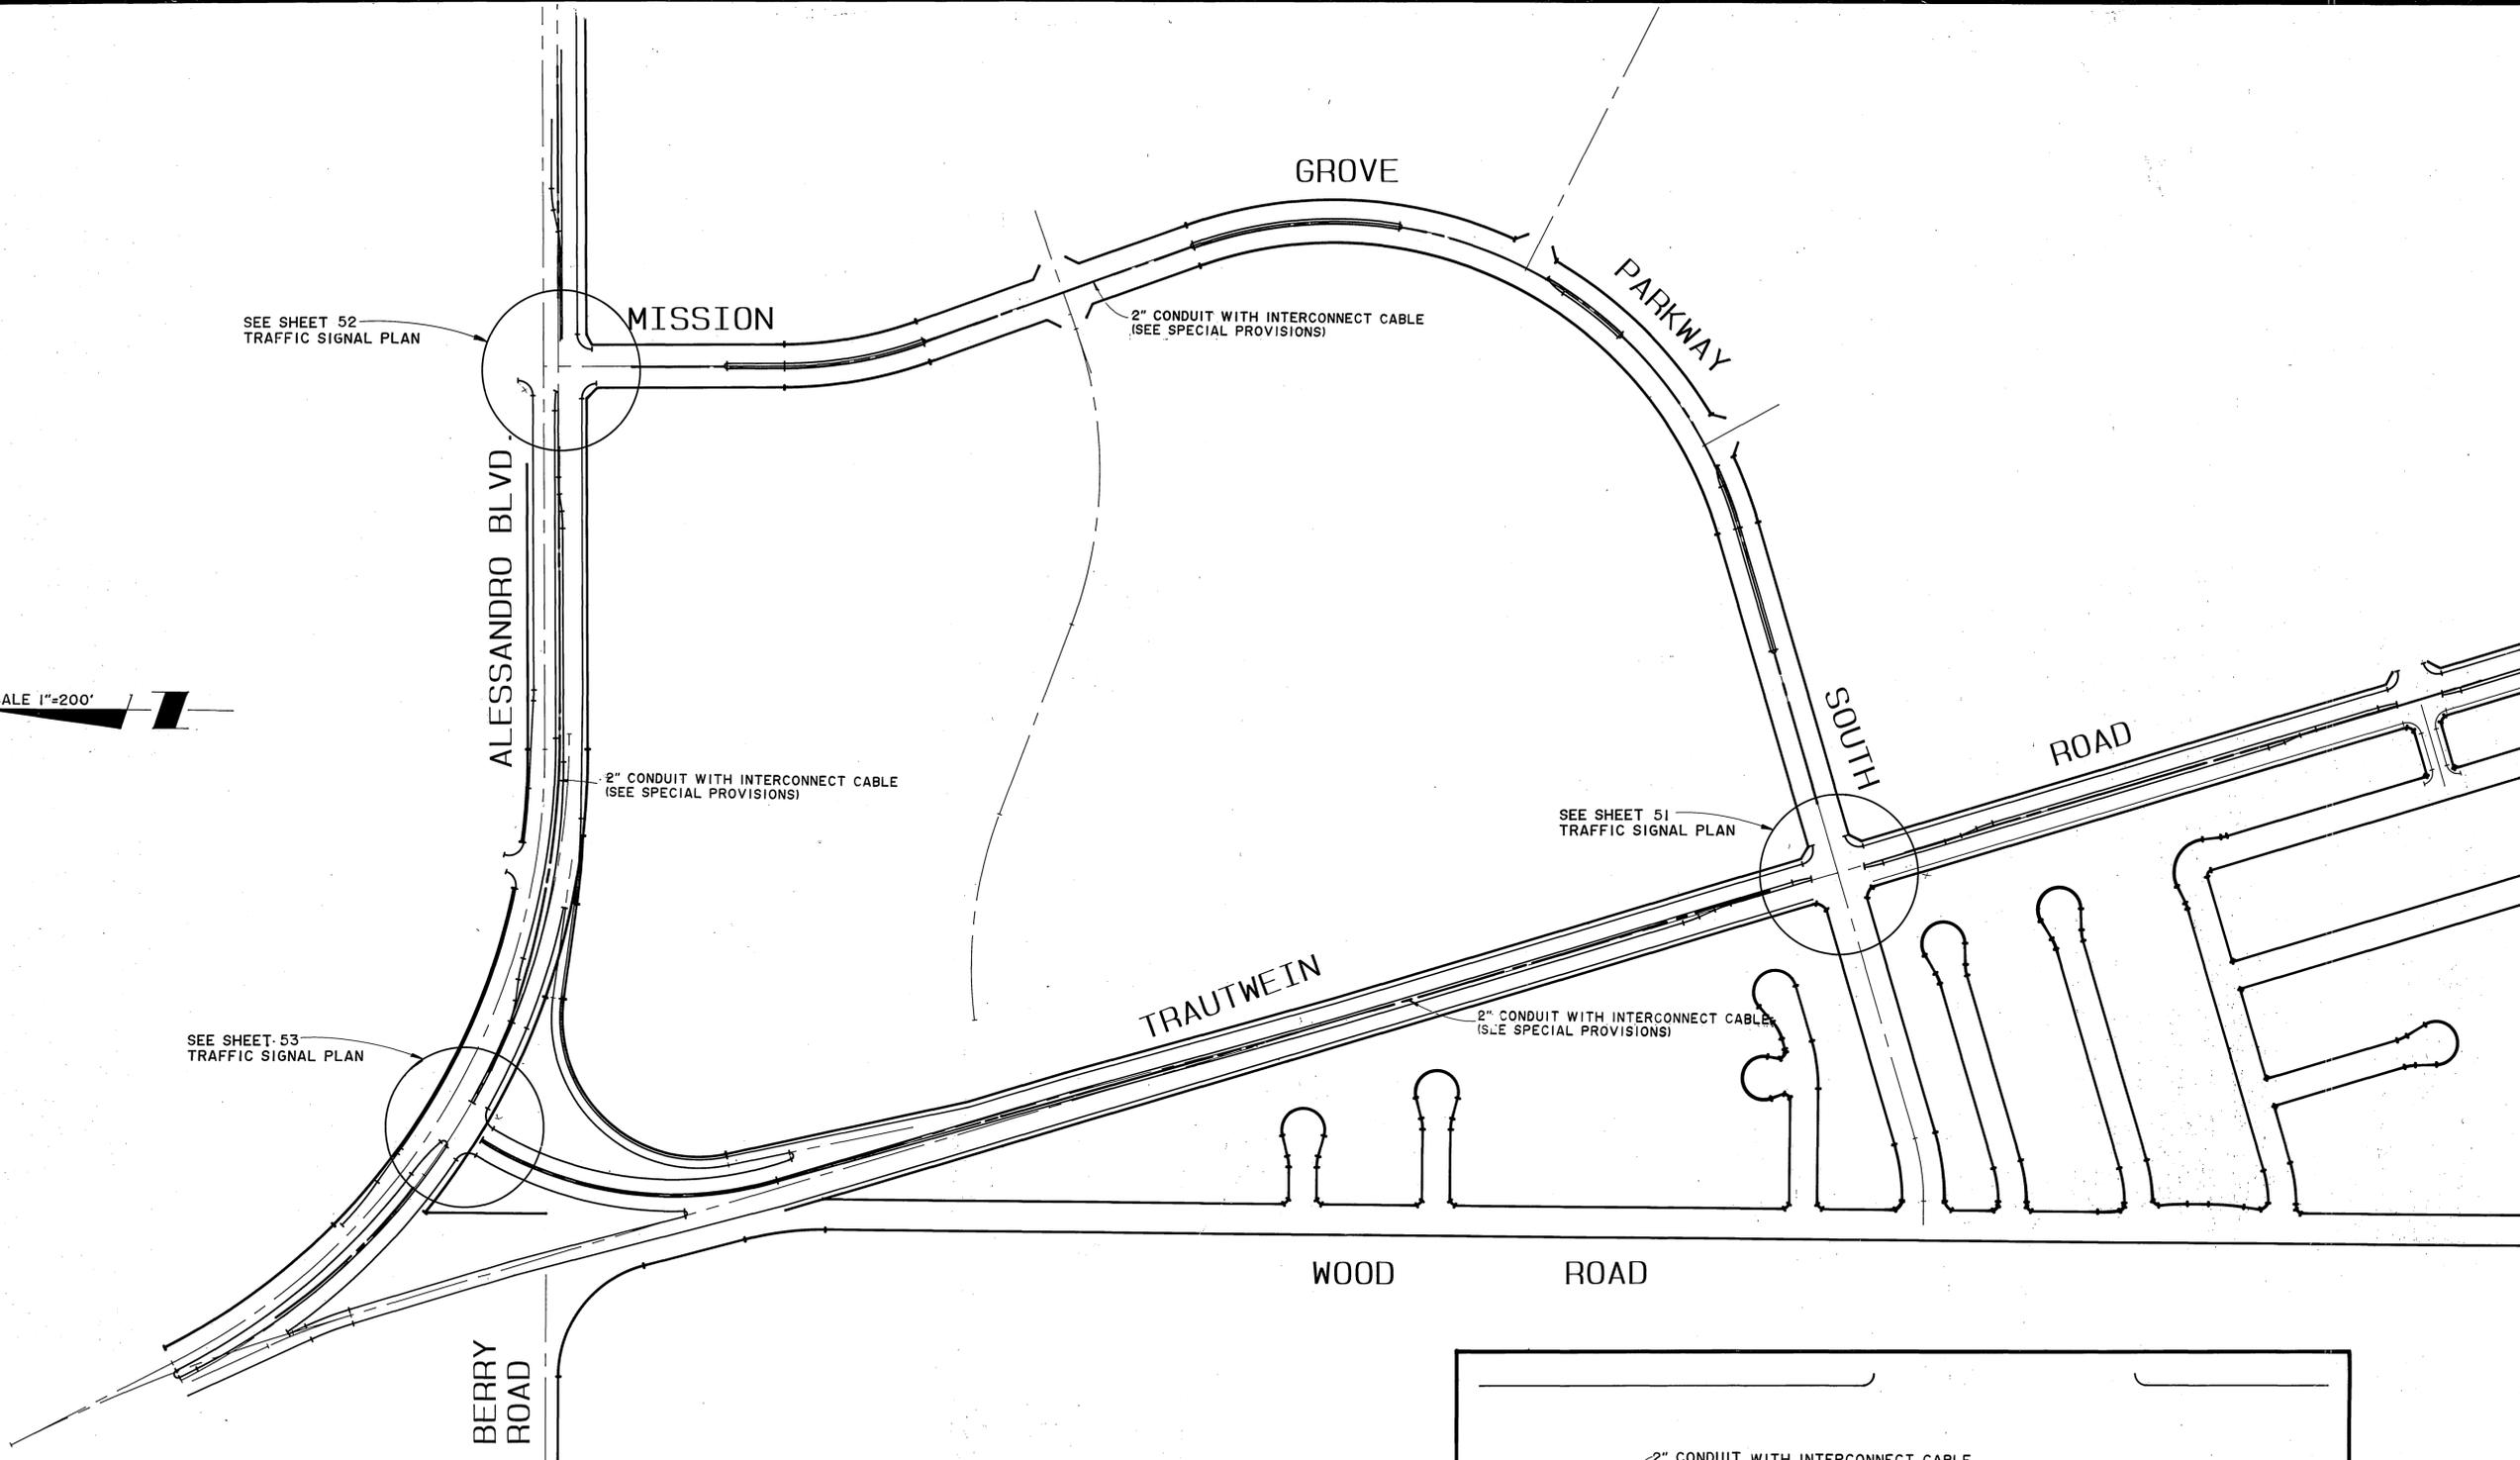

NOTES:

1. ALL WORK AND MATERIAL SHALL CONFORM TO THE STATE OF CALIFORNIA STANDARD PLANS AND SPECIFICATIONS DATED 1988 AND THE SPECIAL PROVISIONS FOR THIS PROJECT
2. PULL BOXES SHALL BE No. 6 UNLESS OTHERWISE INDICATED.
3. AT MEDIAN BREAKS A PULL BOX SHALL BE INSTALLED IN EACH MEDIAN NOSE ALONG THE SYSTEM.
4. CONDUIT SHALL BE PROVIDED WITH PULL ROPE THROUGHOUT THE SYSTEM AS SPECIFIED IN THE STANDARD SPECIFICATIONS.

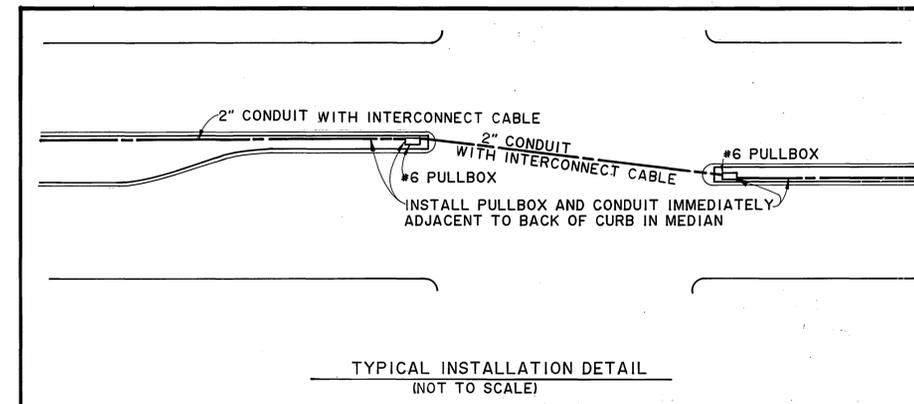

**Underground Service Alert**  
 Call: TOLL FREE  
**1-800-422-4133**  
 TWO WORKING DAYS BEFORE YOU DIG

PRIVATE ENGINEERING NOTE  
 CONSTRUCTION CONTRACTOR AGREES THAT IN ACCORDANCE WITH GENERALLY ACCEPTED CONSTRUCTION PRACTICES CONSTRUCTION CONTRACTOR WILL BE REQUIRED TO ASSUME SOLE AND COMPLETE RESPONSIBILITY FOR JOB SITE CONDITIONS DURING THE COURSE OF CONSTRUCTION OF THE PROJECT, INCLUDING SAFETY OF ALL PERSONS AND PROPERTY; THAT THIS REQUIREMENT SHALL BE MADE TO APPLY CONTINUOUSLY AND NOT BE LIMITED TO NORMAL WORKING HOURS AND CONSTRUCTION CONTRACTOR FURTHER AGREES TO DEFEND, INDEMNIFY AND HOLD DESIGN PROFESSIONAL HARMLESS FROM ANY AND ALL LIABILITY REAL OR ALLEGED, IN CONNECTION WITH THE PERFORMANCE OF WORK ON THIS PROJECT, EXCEPTING LIABILITY ARISING FROM THE SOLE NEGLIGENCE OF DESIGN PROFESSIONAL.



PREPARED UNDER THE DIRECTION OF:  
**Jimmy W. Sims**  
 JIMMY W. SIMS R.C.E. 35458  
 EXPIRATION DATE: 9-31-91 DATE: 10/10/89  
 APPROVED BY:

**J.F. Davidson Associates, Inc.**  
 ENGINEERING PLANNING SURVEYING ARCHITECTURE LANDSCAPE ARCHITECTURE  
 3880 Lemon Street, Suite 300 P.O. Box 493 Riverside, CA 92502 (714) 686-0844 FAX 714-686-9954  
 11200 S. Mt. Vernon Ave., Suite "D" Corona, CA 92624 (919) 248-9991 FAX 619-340-0529

MARK	REVISIONS	APPR.	DATE

DESIGNED BY **B.D.** DRAWN BY **C.M.M.** CHECKED BY **R.C.H.**

CITY OF RIVERSIDE, CALIFORNIA  
 DEPARTMENT OF PUBLIC WORKS  
 APPROVED BY: **[Signature]** DATE: 12/15/89  
 PRINCIPAL ENGINEER  
 PARK DEPARTMENT  
 TRAFFIC DIVISION  
 CHIEF P.W. ENGR.

SIGNAL INTERCONNECT PLANS  
 MISSION GROVE PARKWAY  
 TRAUTWEIN ROAD  
 HORIZ. SCALE: 1" VERT. SCALE: 1"

PROJECT NO. **R-3056**  
 SHEET **54** OF **88**  
 FILE NO.: 8710164