


INDIANA AV.

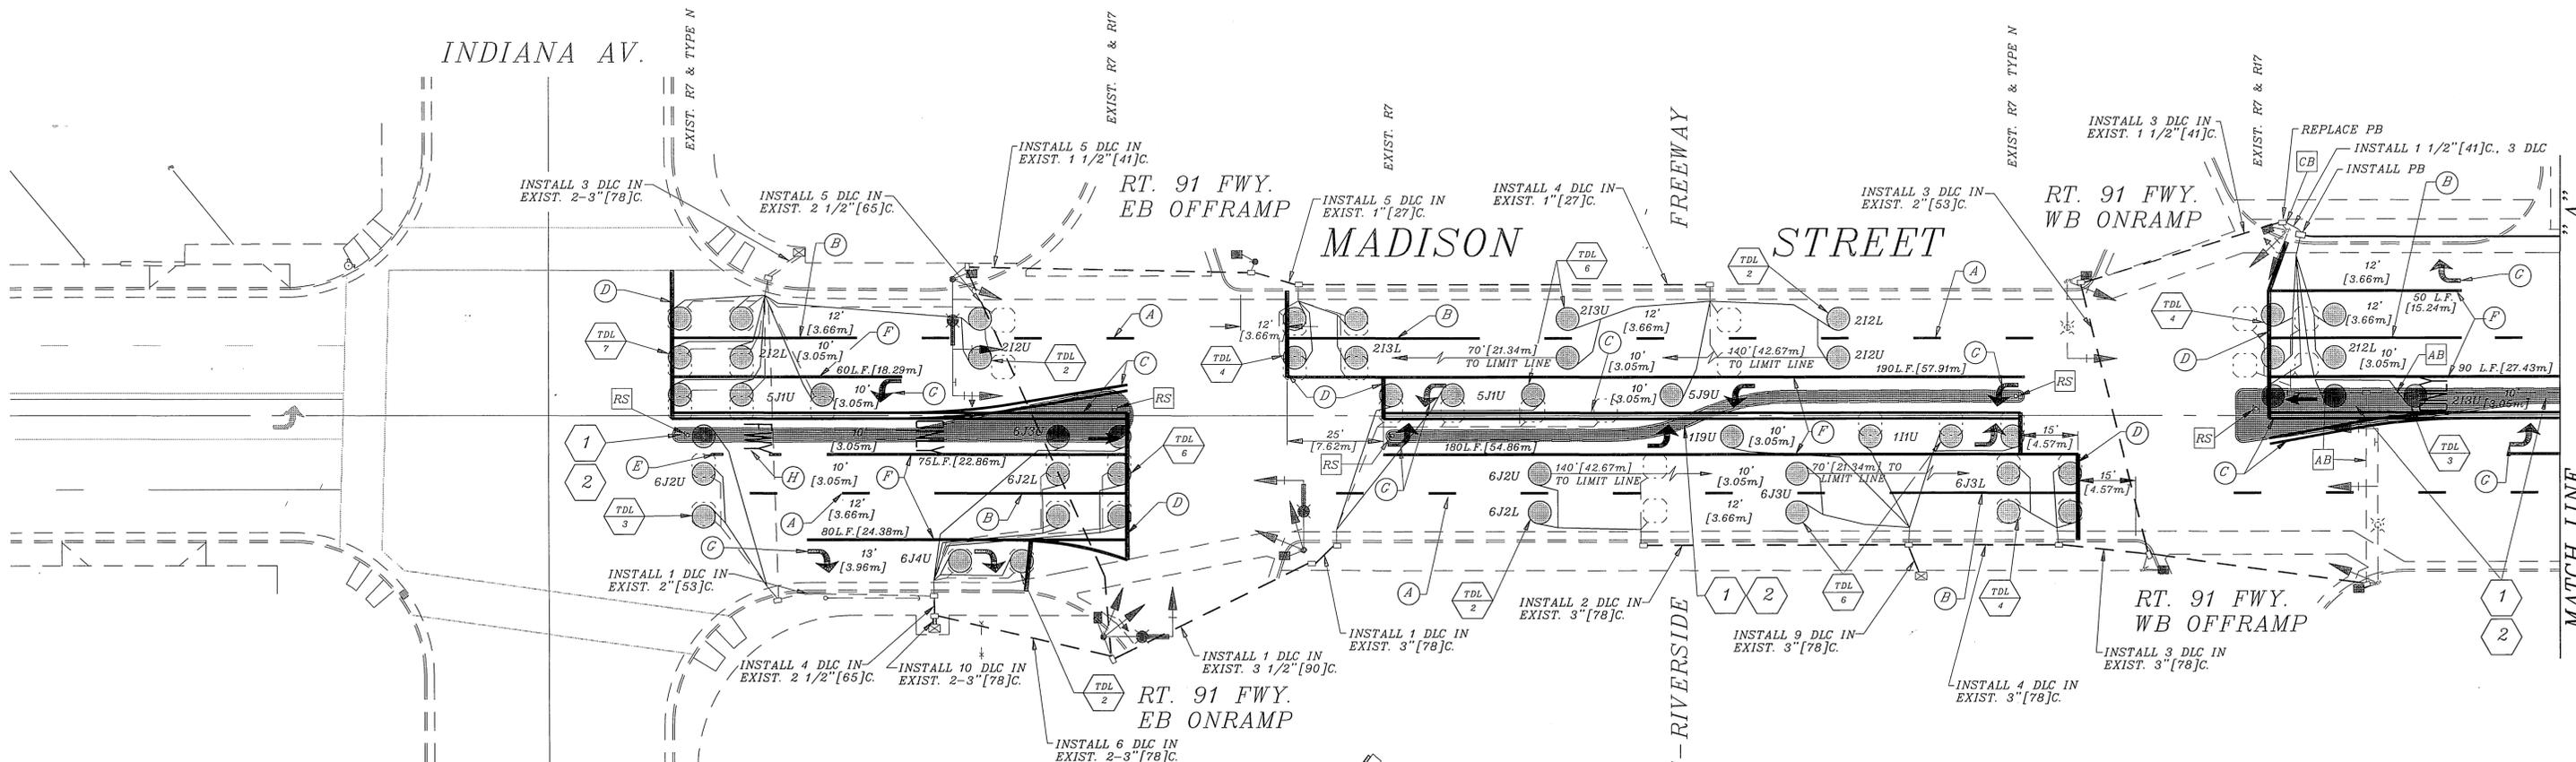

STRIPING & MARKING LEGEND


- (A) 4" [100mm] DASHED WHITE STRIPE [7' (2.14m) STRIPE, 17' (5.18m) CAP] PER CALTRANS STD. PLAN A20A, DETAIL 2.
- (B) 4" [100mm] SOLID WHITE STRIPE [50 L.F. (15.24m)]
- (C) 4" [100mm] SOLID DOUBLE YELLOW STRIPE PER CALTRANS STD. PLAN A20A, DETAIL 21.
- (D) 12" [300mm] SOLID WHITE MARKING
- (E) 8" [200mm] DASHED WHITE STRIPE [3' (0.92m) STRIPE, 12' (3.66m) CAP]
- (F) 8" [200mm] SOLID WHITE STRIPE PER CALTRANS STD. PLAN A20D, DETAIL 38A.
- (G) SOLID WHITE TYPE IV ARROW PER CALTRANS STD. PLAN A24A.
- (H) SOLID WHITE "FWY. ONLY, →" MARKING.

GENERAL CONSTRUCTION NOTES

1. DETECTOR LOOPS SHALL BE INSTALLED IN THE PRESENCE OF THE TRAFFIC ENGINEER OR HIS REPRESENTATIVE.
2. TYPICAL DETECTOR LOOP SPACING: 10' [3.05m], 15' [4.57m] & 30' [9.14m] WHERE APPLICABLE, STARTING FROM LIMIT LINE.
3. IT SHALL BE THE RESPONSIBILITY OF THE CONTRACTOR TO CLEAR THE RIGHT OF WAY IN ACCORDANCE WITH THE PROVISIONS OF LAW AS IT AFFECTS EACH UTILITY INCLUDING IRRIGATION LINES AND APPURTENANCES AND AT NO COST TO THE CITY.
4. TRIM EDGE OF EXISTING PAVEMENT WHERE NEW PAVEMENT JOINS TO A SMOOTH, STRAIGHT LINE. CONSTRUCT MATCH-UP PAVING AS SHOWN ON PLAN AND OVERLAY PAVING AS DIRECTED IN THE FIELD TO PRODUCE A SMOOTH SECTION.
5. THE CONTRACTOR SHALL CALL IN A LOCATION REQUEST TO UNDERGROUND SERVICE ALERT (USA), PHONE NO. 1-800-227-2600, TWO WORKING DAYS BEFORE DIGGING. NO CONSTRUCTION PERMIT WILL BE ISSUED BY THE PUBLIC WORKS DEPARTMENT UNLESS THE APPLICANT HAS BEEN PROVIDED AN INQUIRY IDENTIFICATION NUMBER BY U.S.A.
6. ANY TRAFFIC CONTROL STRIPING OBLITERATED AND/OR BADLY WORN DURING CONSTRUCTION SHALL BE RESTORED BY THE CONTRACTOR WITHIN FIVE DAYS AFTER NOTIFICATION FROM THE CITY INSPECTORS.

CONSTRUCTION NOTES

- (TDL) → TRAFFIC DETECTOR LOOP INSTALLATION
- (4) → NUMBER OF DETECTOR LOOPS
- (1) REMOVE EXISTING RAISED MEDIAN.
- (2) CONSTRUCT 0.94 [290mm] FULL DEPTH A.C. PAVING.

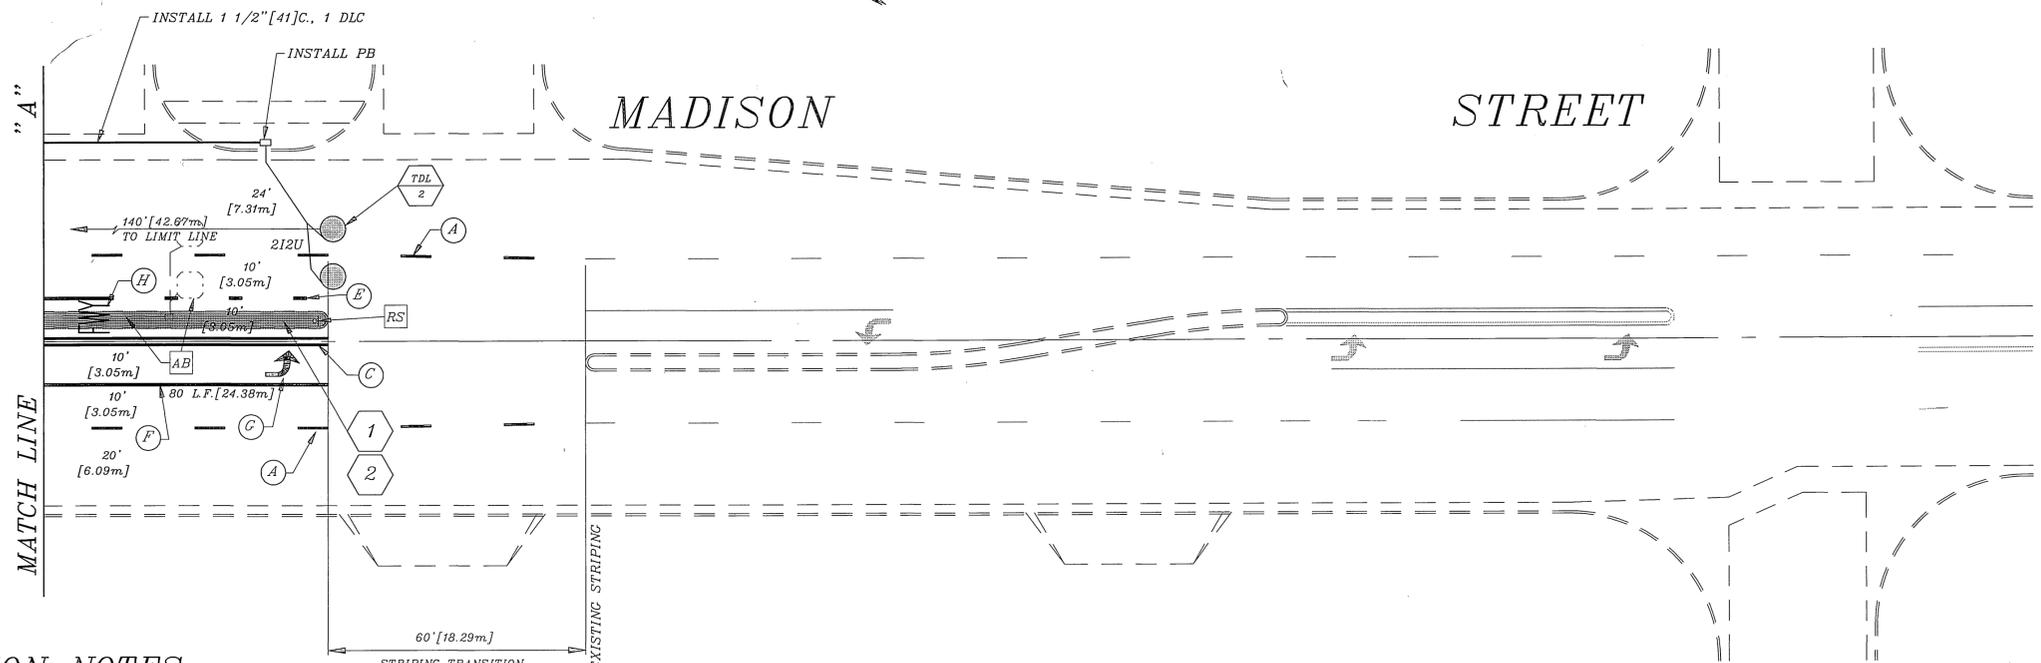

NOTE: REMOVE ANY CONFLICTING EXISTING STRIPING AND MARKINGS.

ENGINEER IN RESPONSIBLE CHARGE
 Richard D. McGrath
 RICHARD D. McGRATH
 R.C.E. No. 31952
 DATE 3/6/97



MARK	REVISIONS	APPR.	DATE
DESIGNED BY	R.C.C.	DRAWN BY	R.C.C.
CHECKED BY			

CITY OF RIVERSIDE, CALIFORNIA
 DEPARTMENT OF PUBLIC WORKS
 APPROVED BY: [Signature]
 PRINCIPAL ENGINEER: [Signature]
 P.W. INSPECTION: [Signature]
 TRAFFIC DIVISION: [Signature]
 CHIEF P.W. ENGR. [Signature]
 PUBLIC UTILITIES: [Signature]
 DATE: 3-6-97

PAVEMENT DELINEATION & SIGN PLAN
MADISON STREET
 AT RT. 91 FWY. & INDIANA AV.
 SCALE: 1" = 20'

AS BUILT CD 3/4/98
 ACCT. NO. 230-541500-440223-30276
XL-389A
 SHEET 1 OF 1
 FILE NAME: XL389A.DWG

ENCROACHMENT PERMIT #08-97-N-SN-0031