




PLAN No. 1493 SHEET 1
 INDEX SHEET & LOCATION PLAN
 SHOWING RELOCATION
 SANITARY SEWERS IN THE PATH OF
 ROAD VIII-RIV-43-RIV, STATE ROUTE 1
 IN RIVERSIDE CALIFORNIA
 SCALE: 1" = 200' NOVEMBER 1954
 E.B. 100 SCA
 APPROVED: *W. H. Smith*
 M.H. FRUIT-RESE. NO. 1
 CITY ENGINEER

AS BUILT REVISIONS
 APRIL 9/30/55
 2

- MANHOLES
- C.O.
- x ISOLATED PLUGS
- ▬ ENGAGED
- ▬ SLEEVES

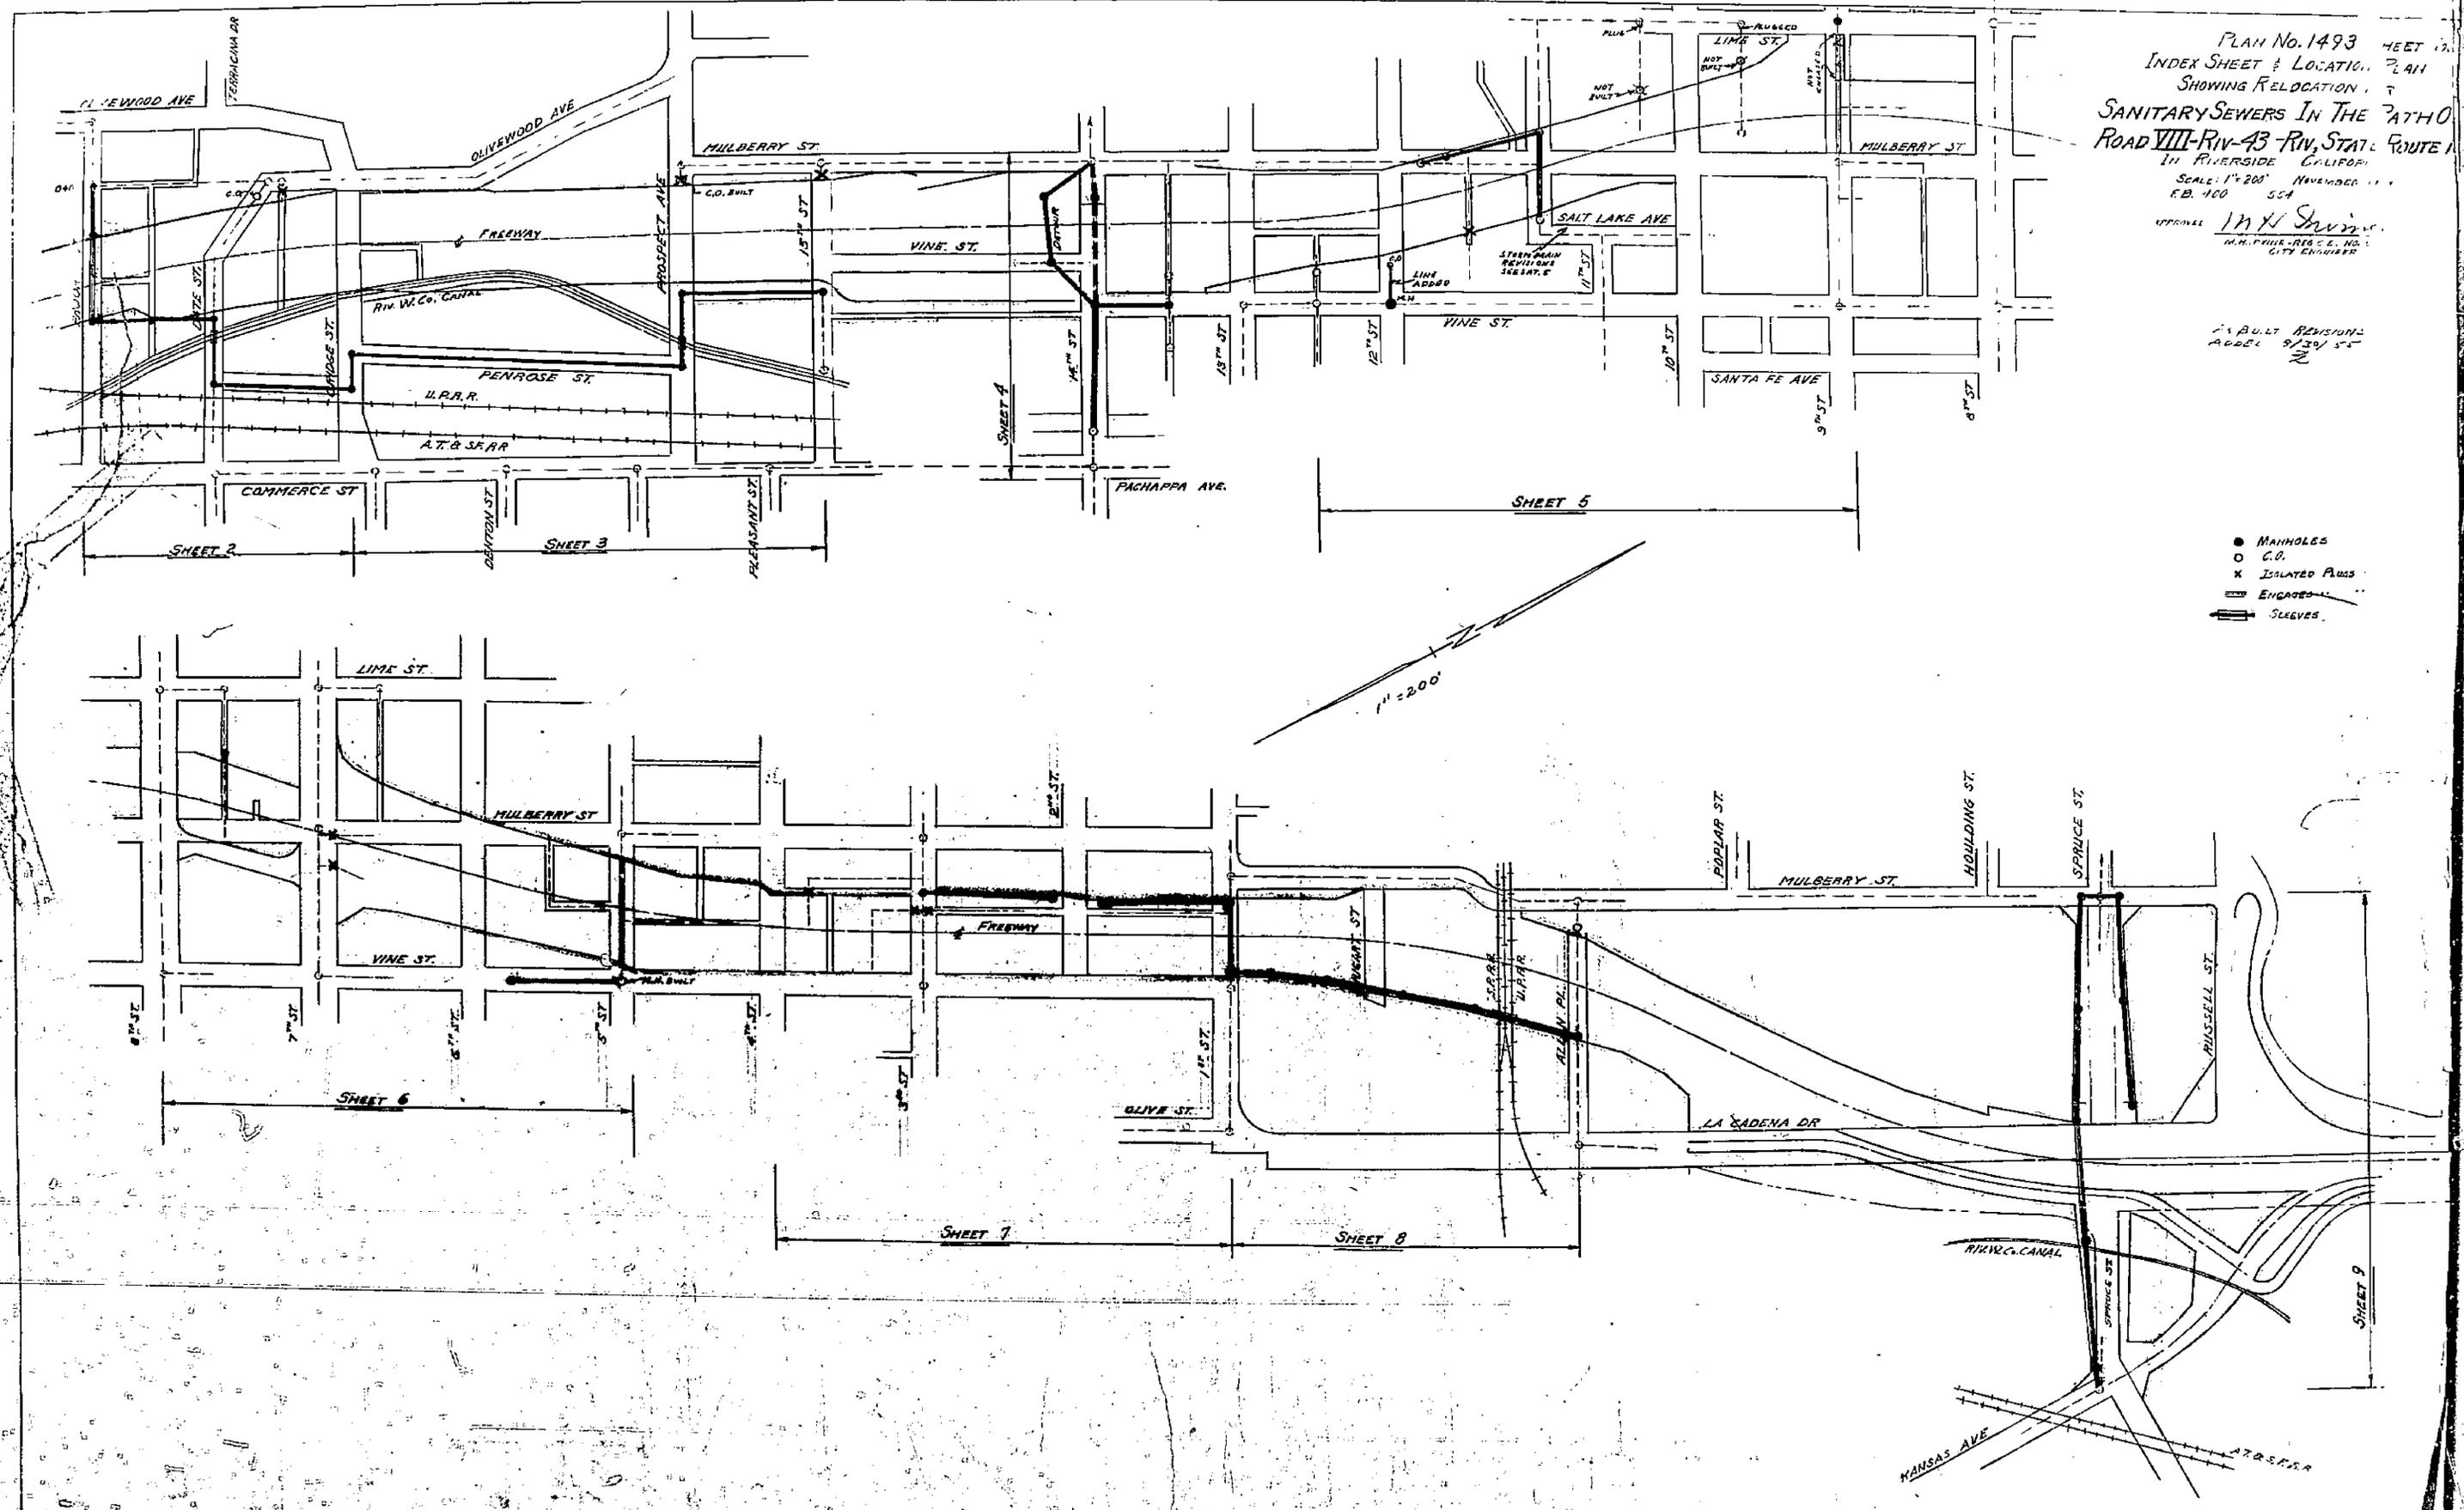

1493

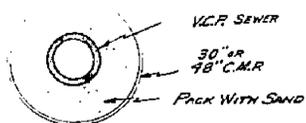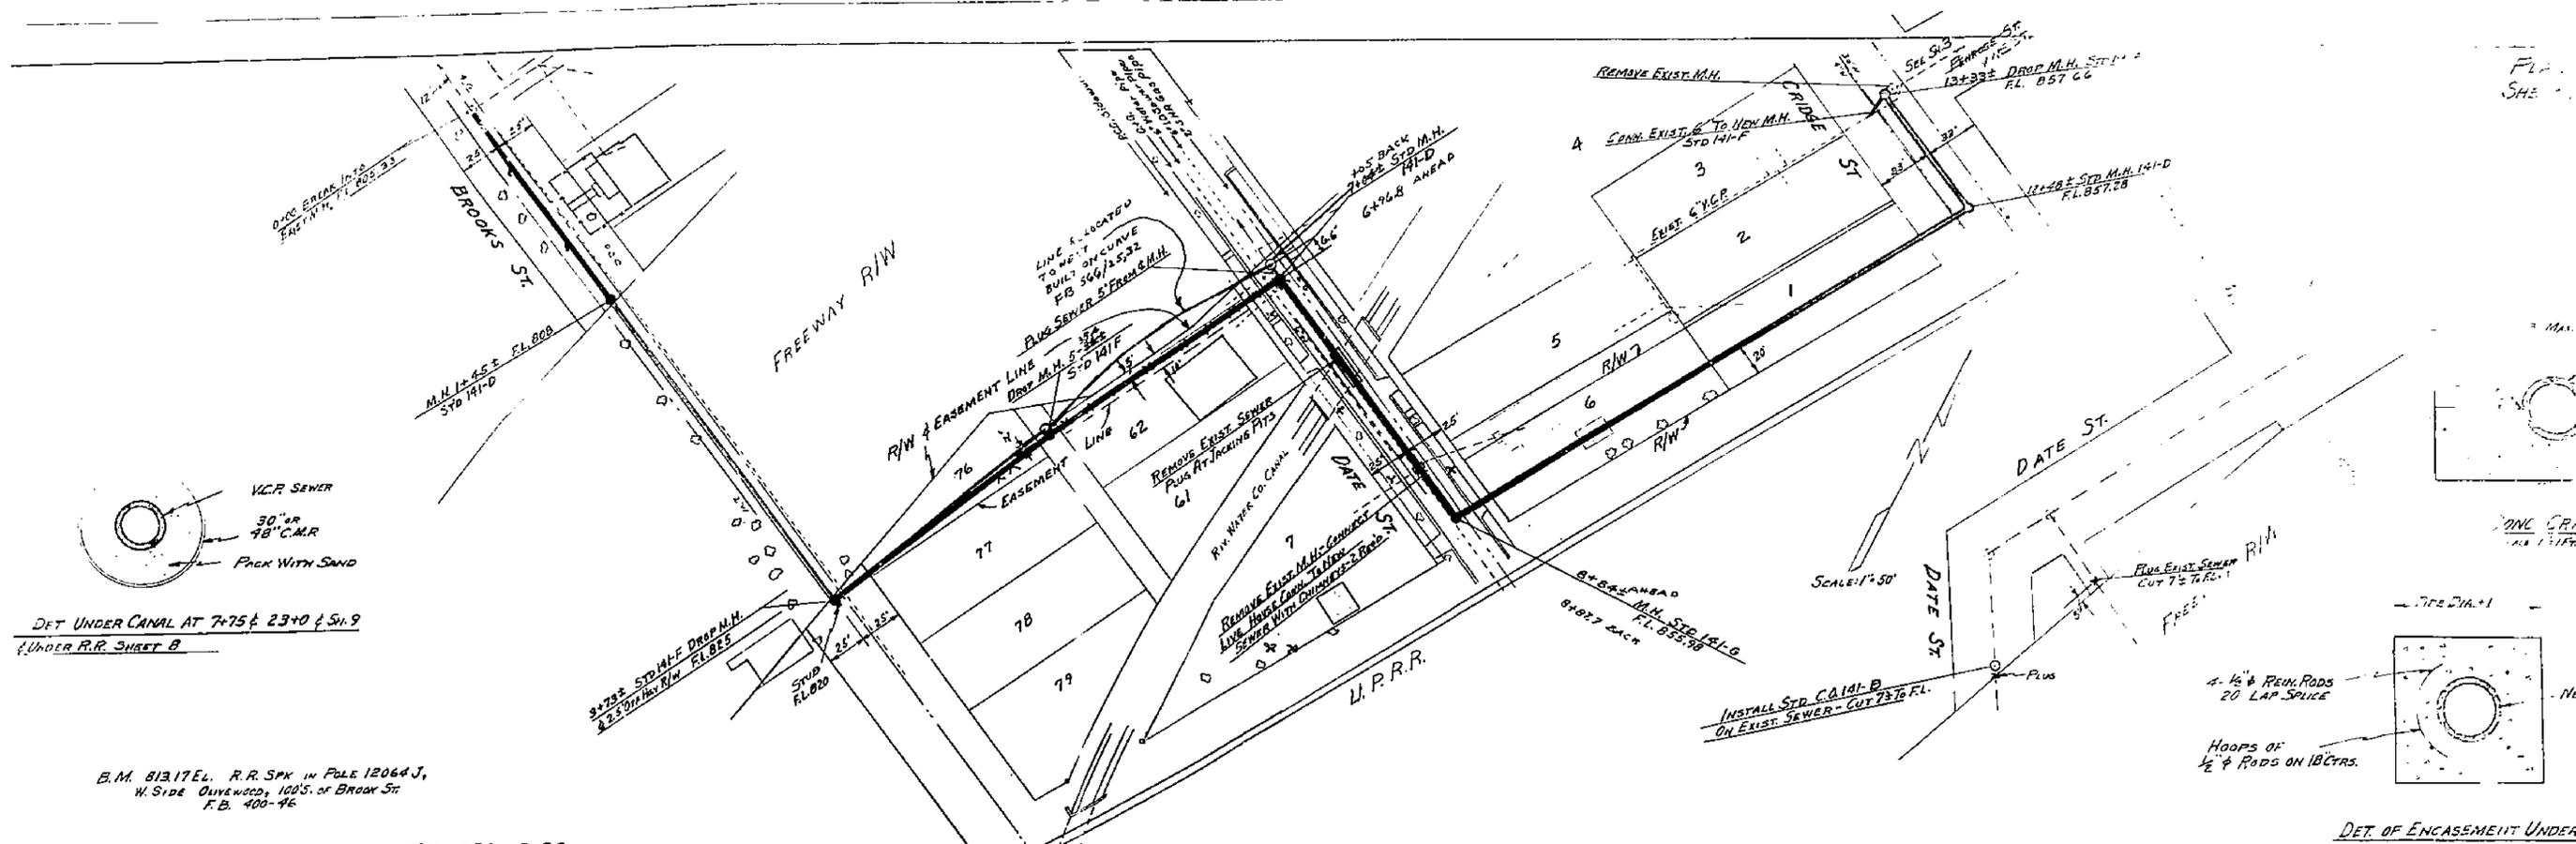


DET UNDER CANAL AT 7+75 & 23+0 & SH. 9
 UNDER R.R. SHEET B




B.M. 81317 EL. R.R. SPK IN POLE 12064 J,
 W. SIDE OLIVEWOOD, 100 S. OF BROOK ST.
 F.B. 400-46

F.B. 554-5, 38

DET. OF ENCASEMENT UNDER FREEWAY
 FOR NEW SEWER CONST. - SCALE 1"

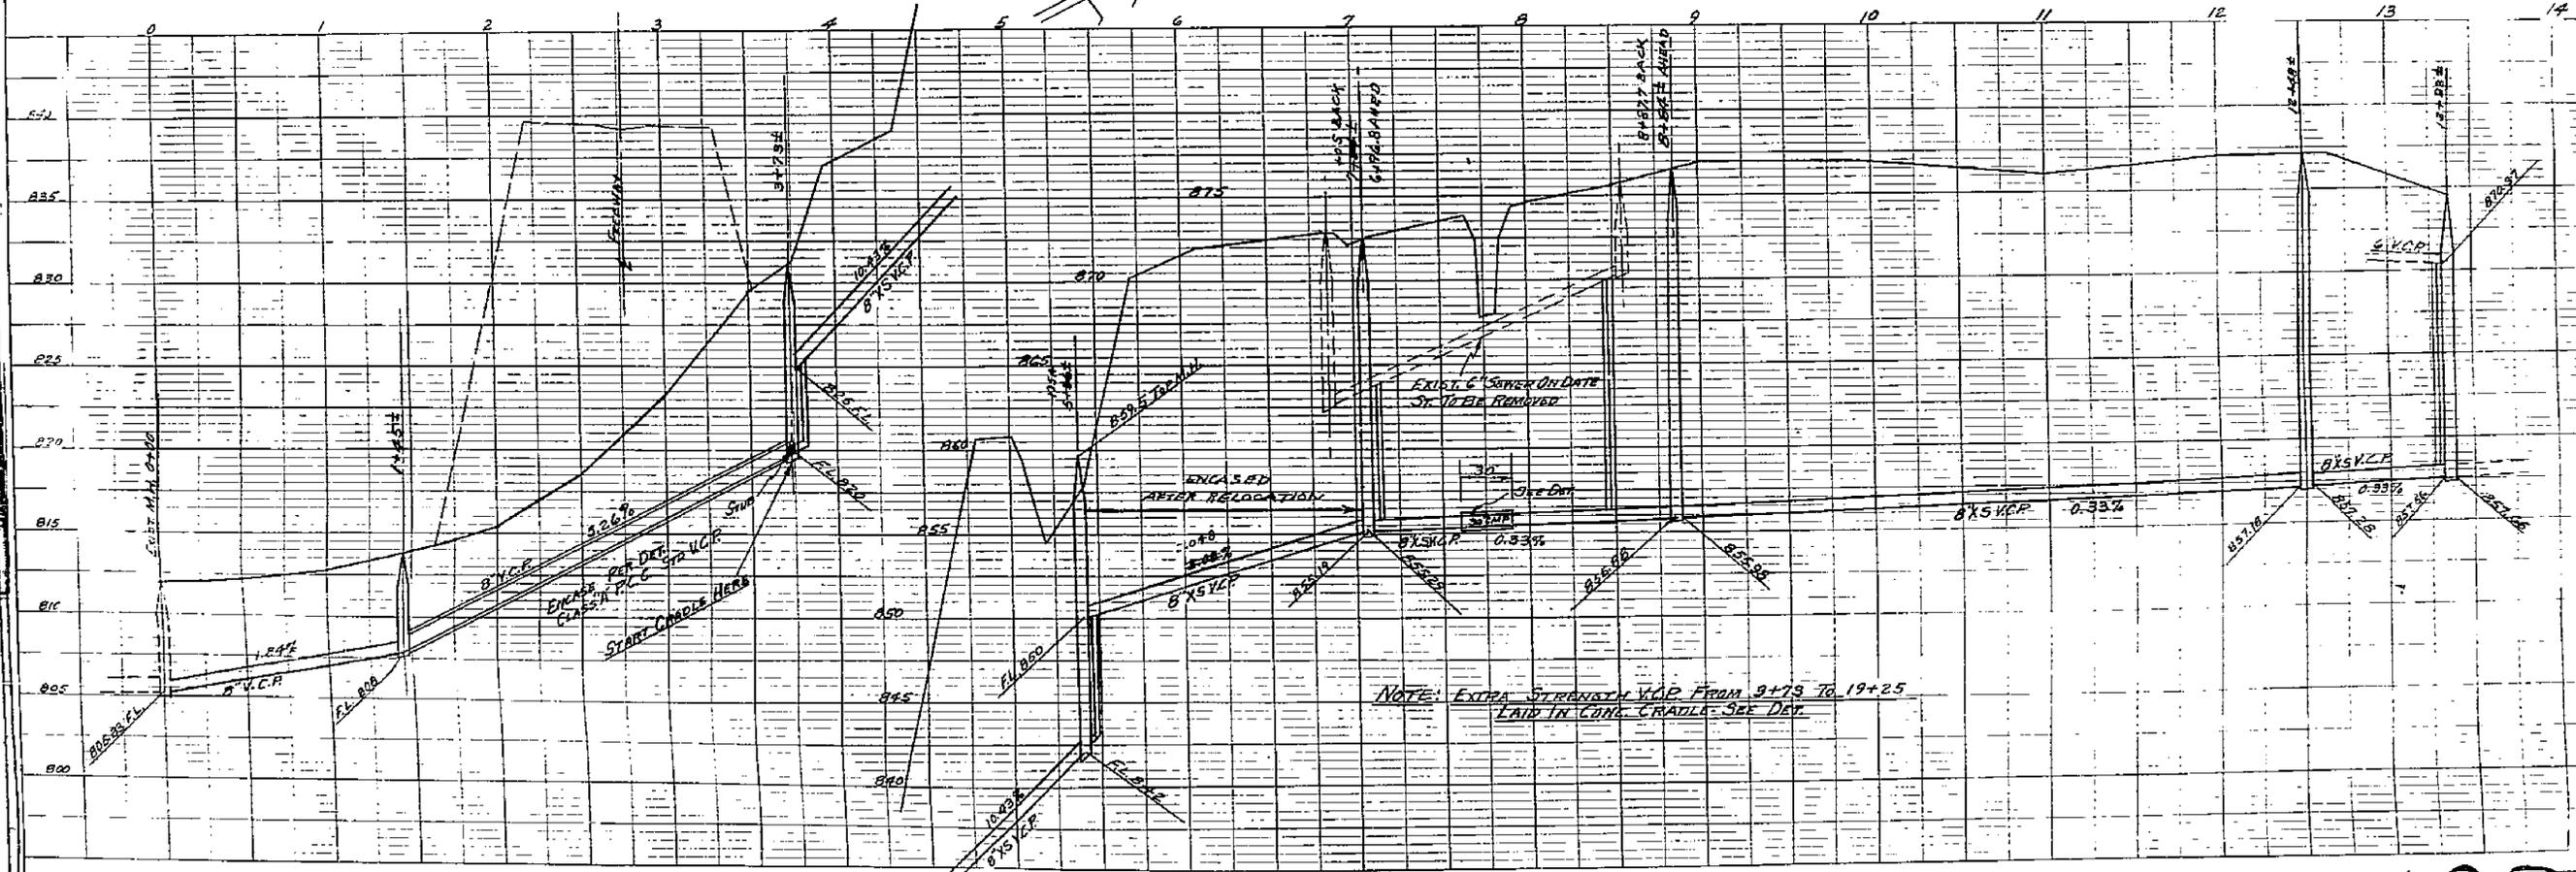

1493

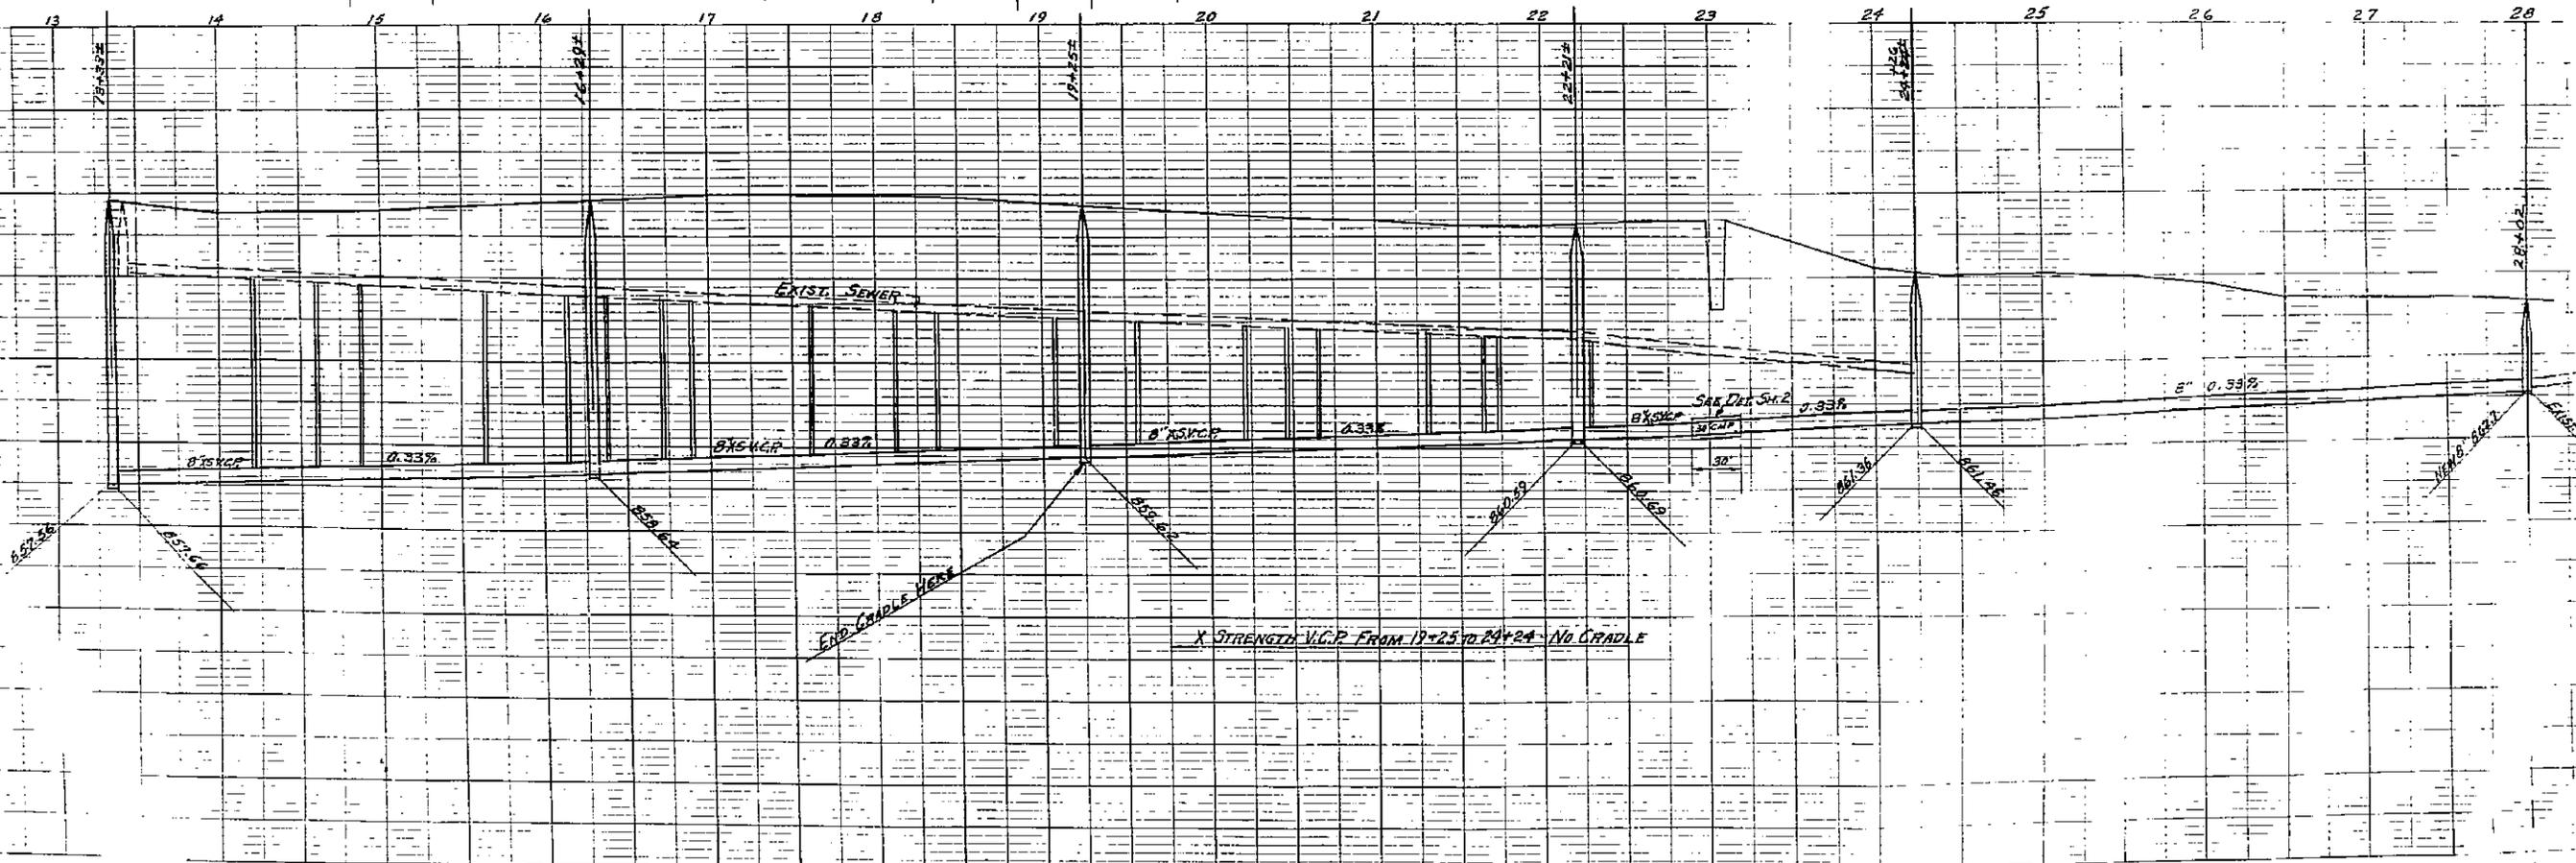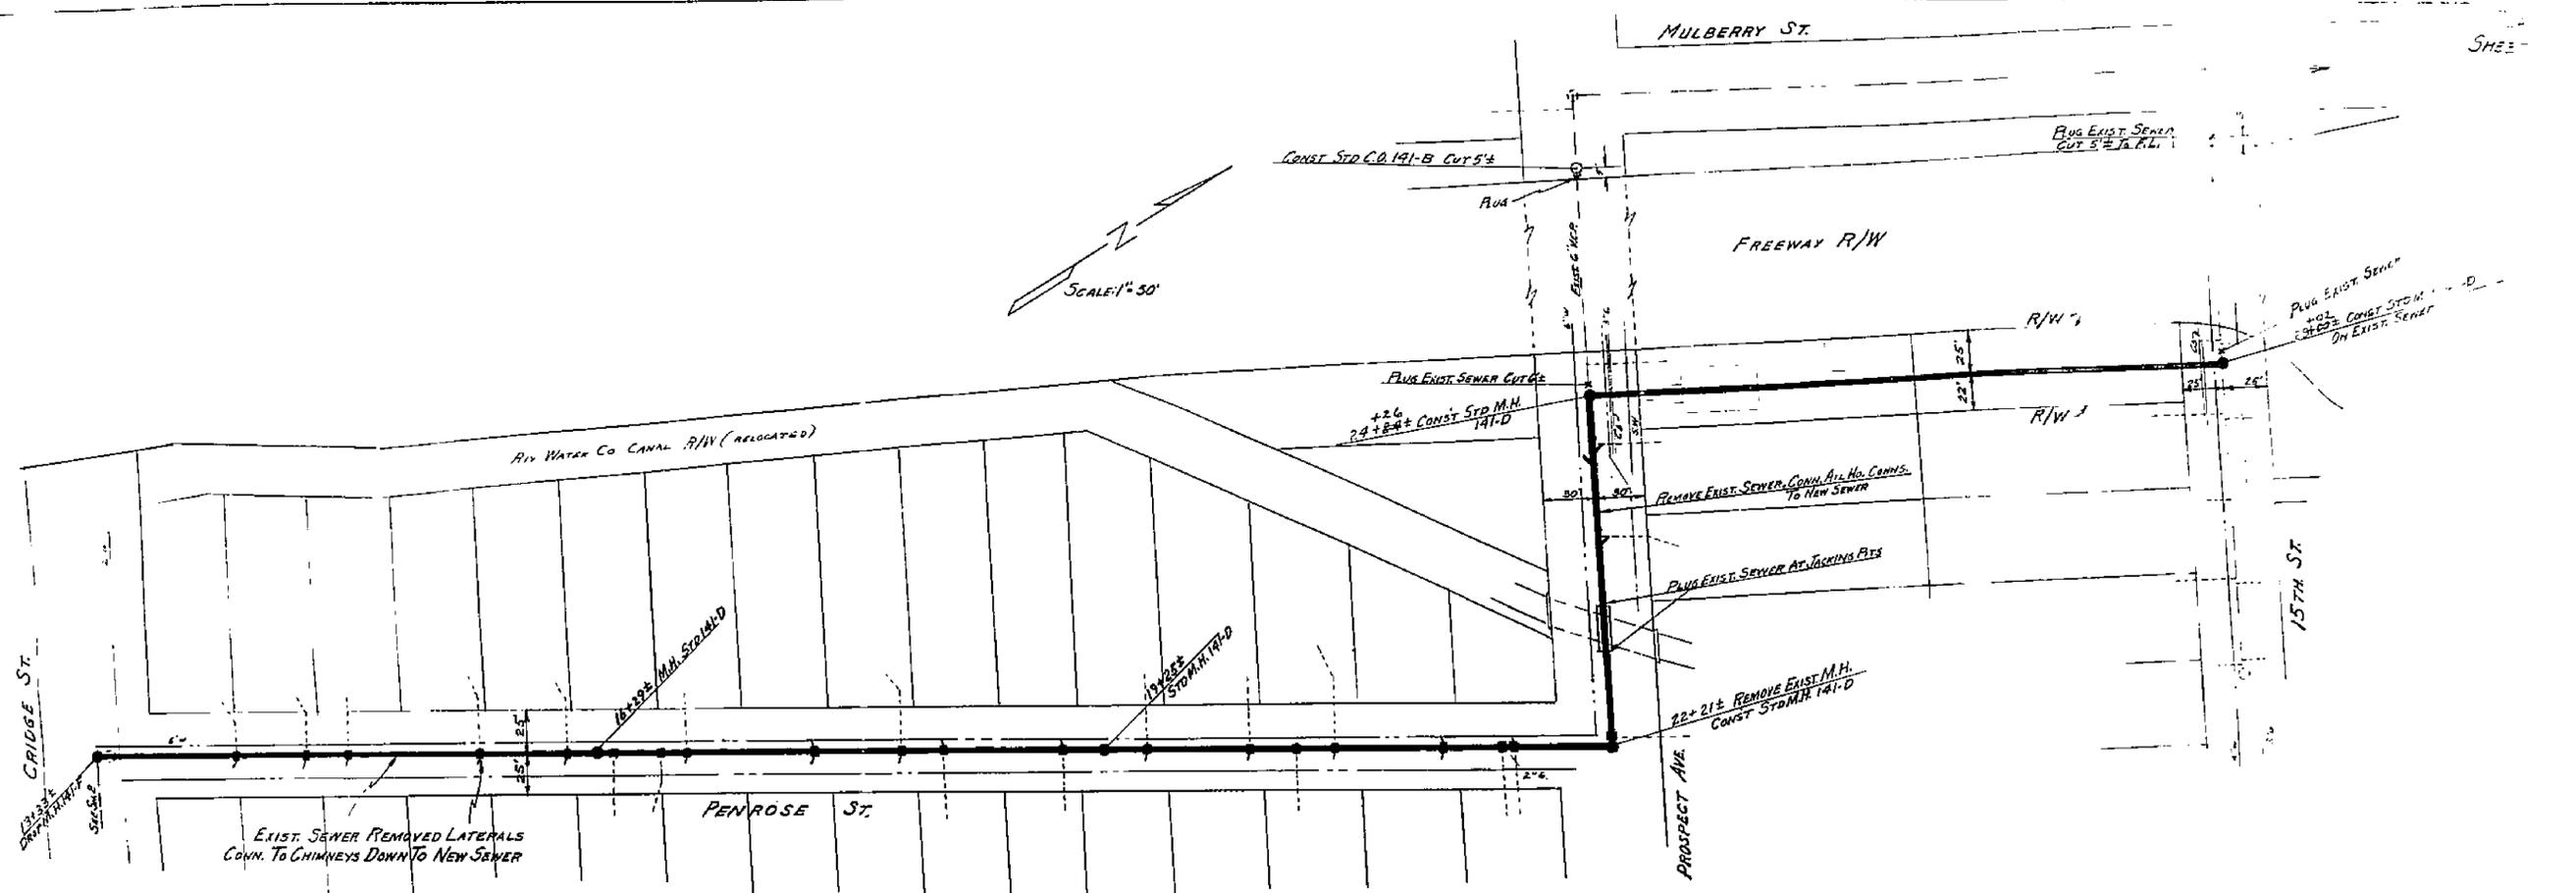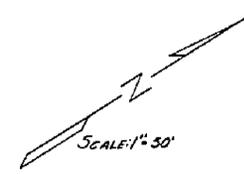


X STRENGTH V.C.P. FROM 19+25 TO 24+24 - NO CRADLE

1493

PLAN
NOTED
DATE

NO. 1
DATE

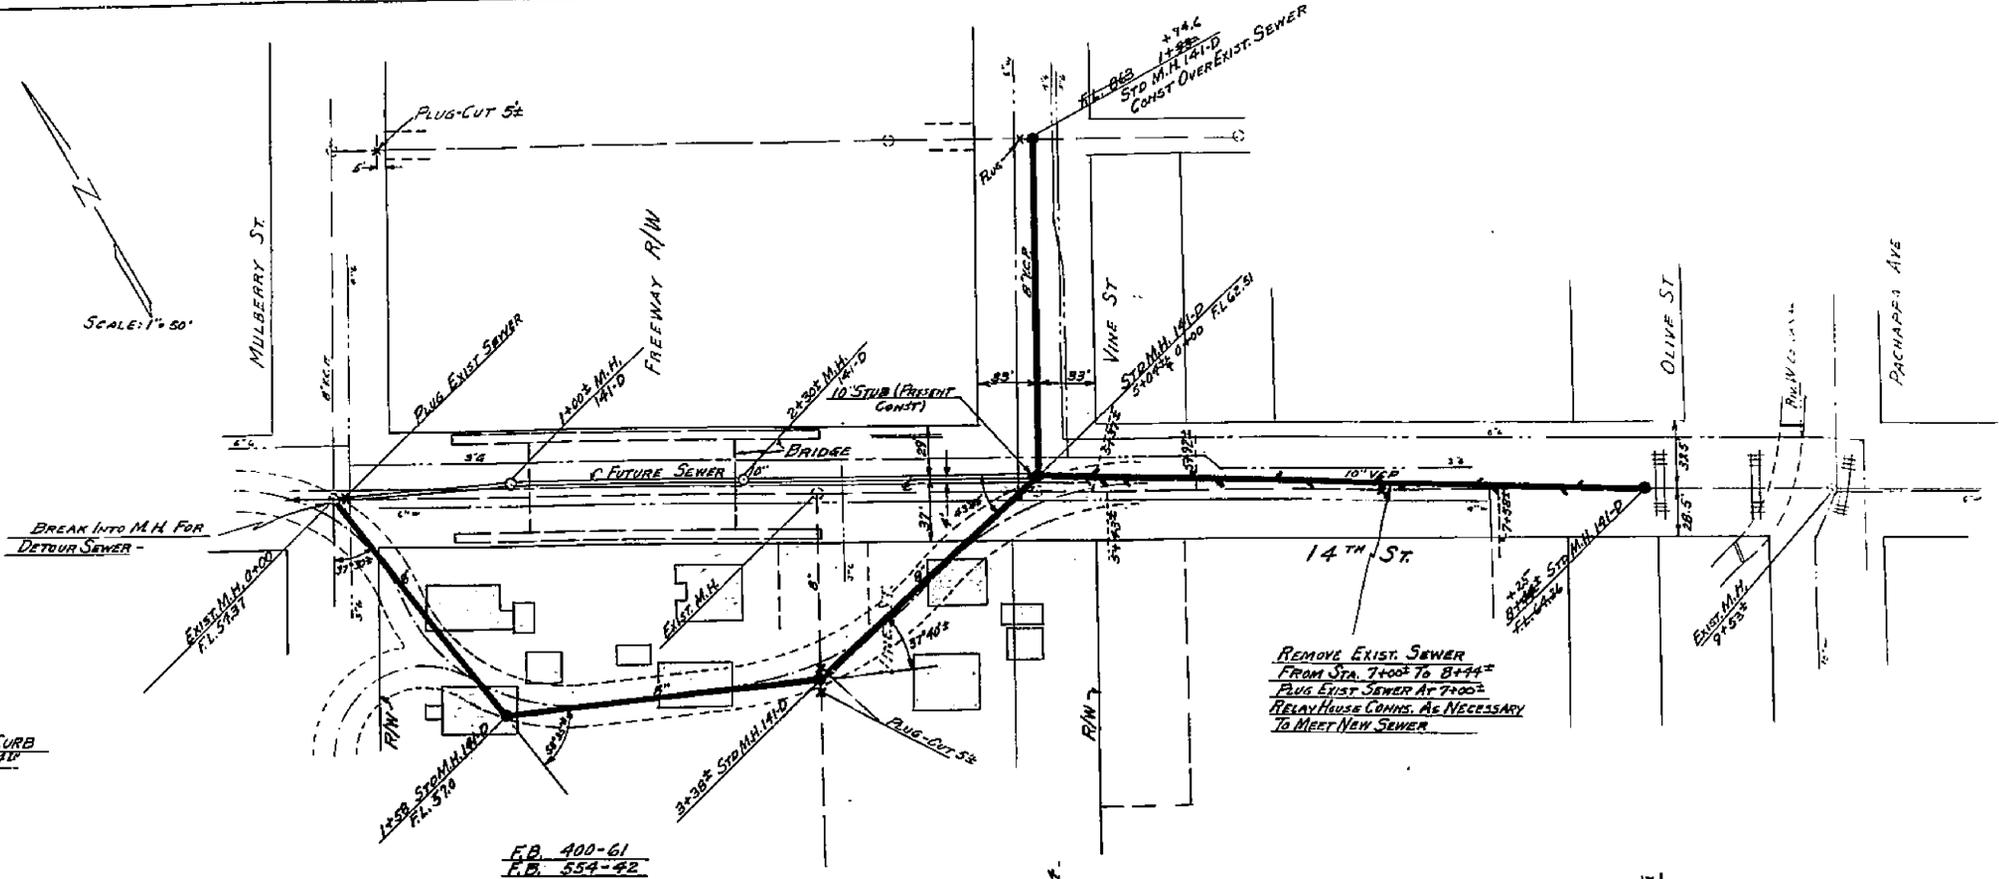

B.M. - FL 86154 STEEL PIN IN N. CURB
14' 20\"/>

FB 400-61
FB 554-42

REMOVE EXIST. SEWER
FROM STA. 7+00 TO 8+44'
PLUS EXIST. SEWER AT 7+00'
RELAY HOUSES & CONDS. AS NECESSARY
TO BLEET NEW SEWER


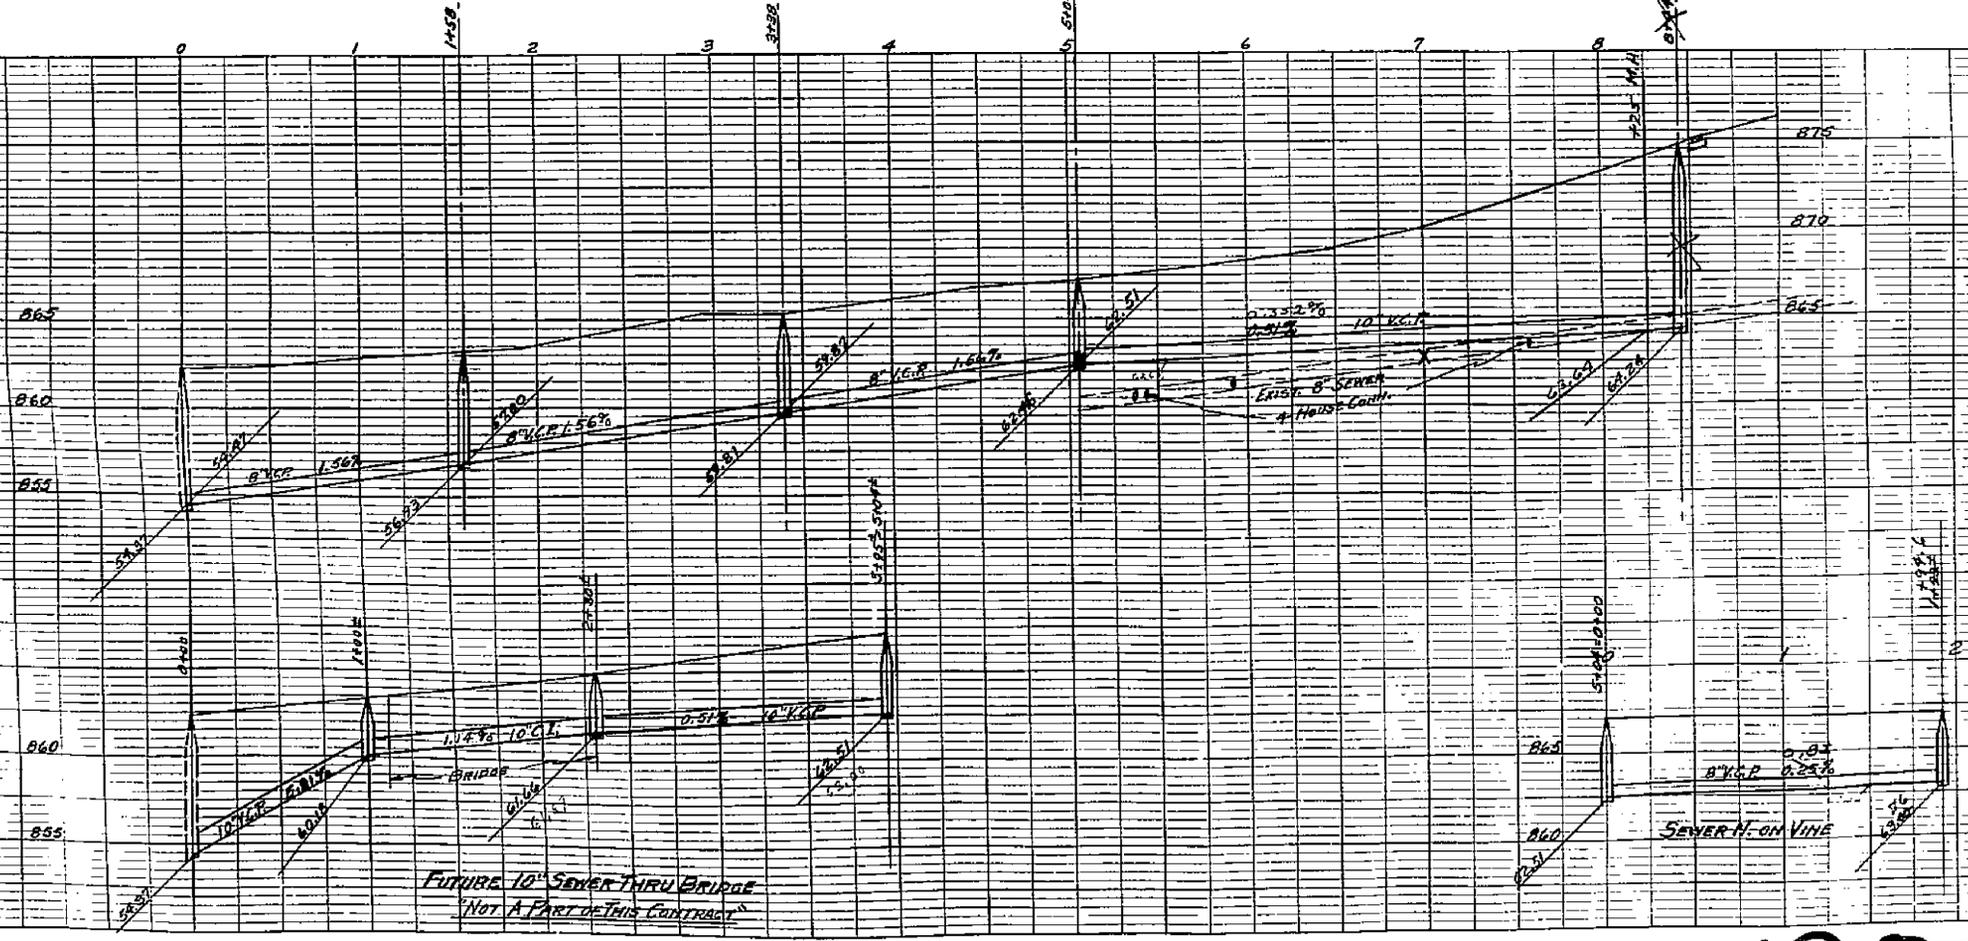


FIGURE 10 SEWER THRU BRIDGE
NOT A PART OF THIS CONTRACT

26% 10' 02 1/2" 32'
33'
165'
142'
61.89'
62.31'

1493

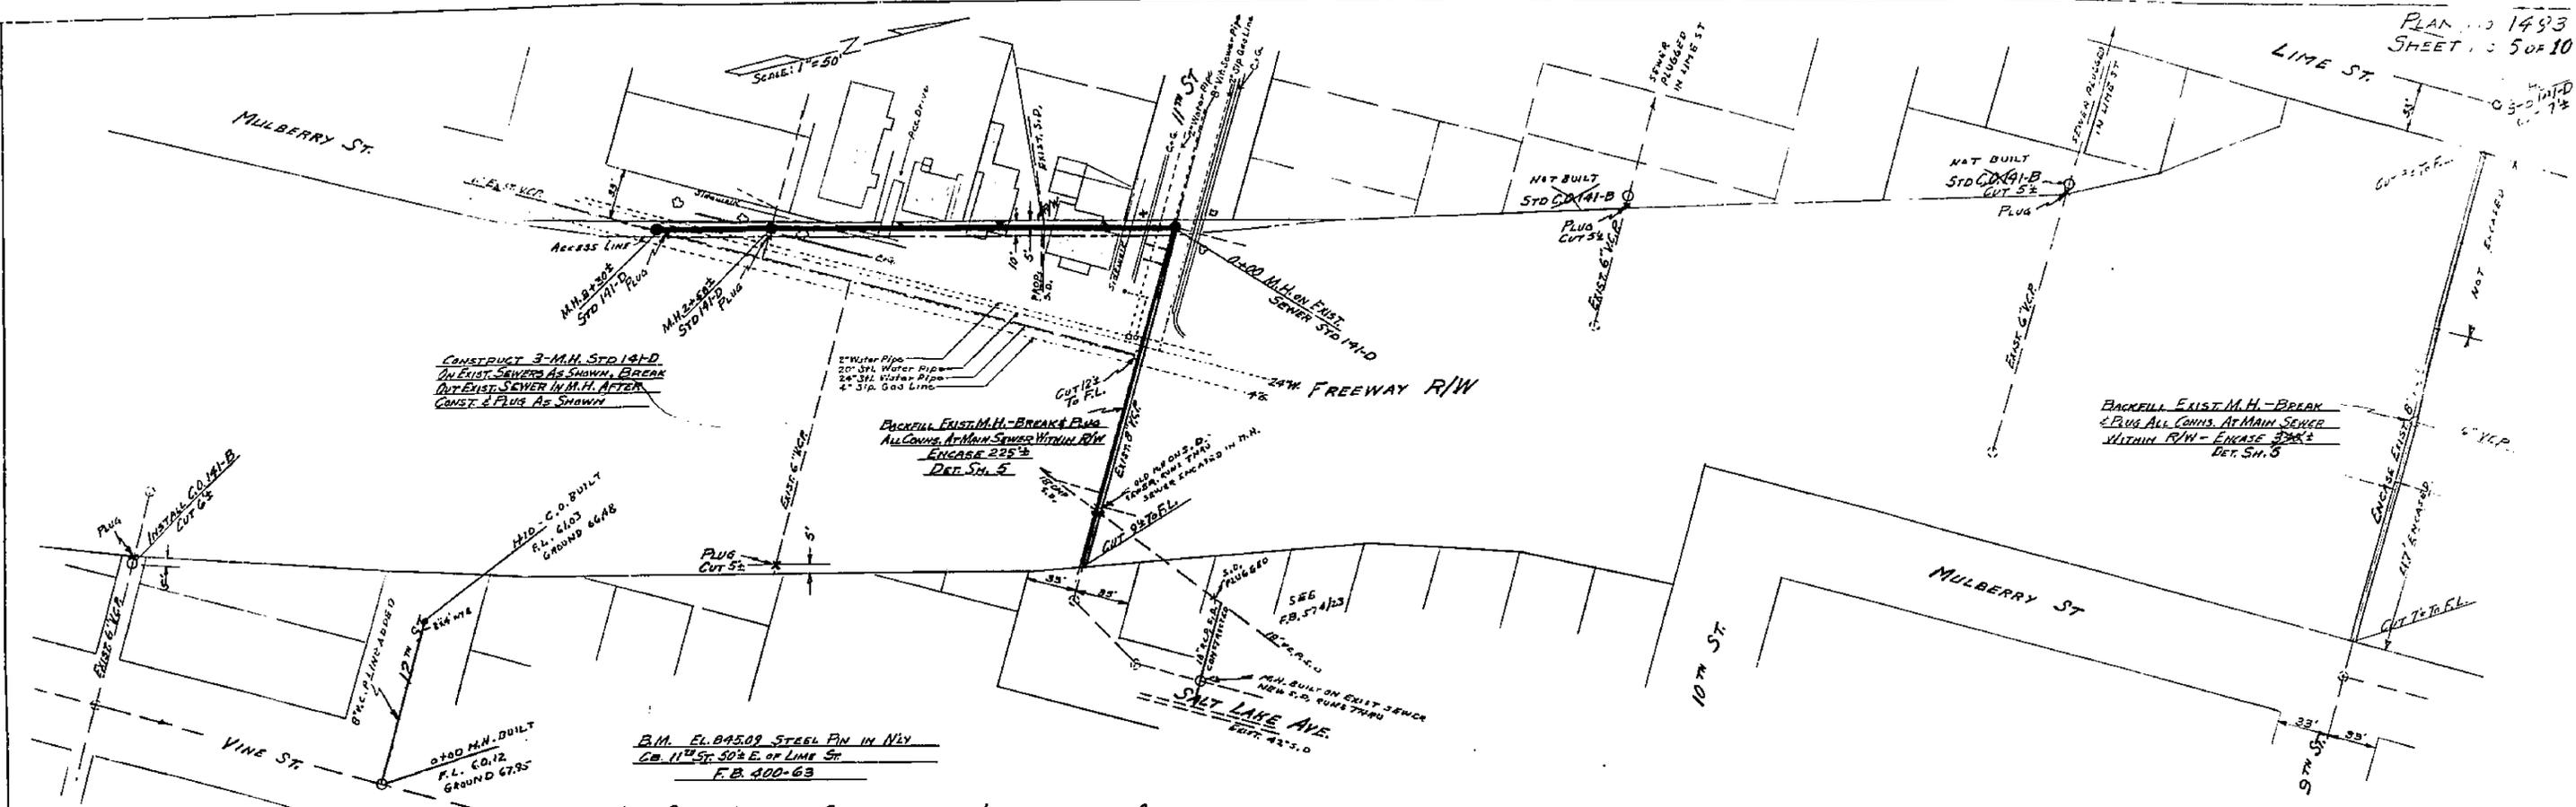


B.M. EL. 845.09 STEEL PIN IN NLY
CORNER 11TH ST. 50TH E. OF LIME ST.
F.B. 400-63


0 700 M.H. BUILT
F.L. 60.12
GROUND 67.85

H.I.D. C.O. BUILT
F.L. 61.03
GROUND 66.48

APPROXIMATE
LOCATION OF EXIST.
S.D.
NOTE:
UNCOVER EXIST. S.D.
BEFORE STARTING
CONSTRUCTION OF
THIS LINE

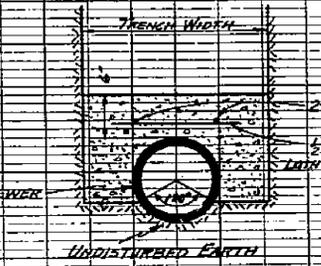


DETAIL OF ENCASMENT UNDER
FREEWAY FOR EXISTING SEWERS

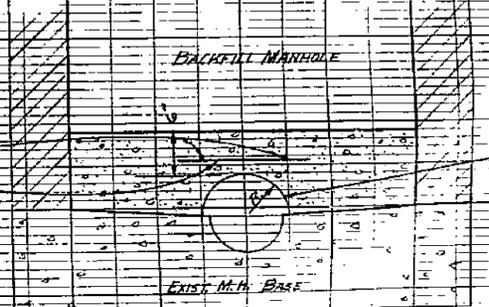

DETAIL OF CONTINUATION OF ENCASMENT
THRU EXISTING MANHOLE
SCALE: 1" = 1' 0"


1493

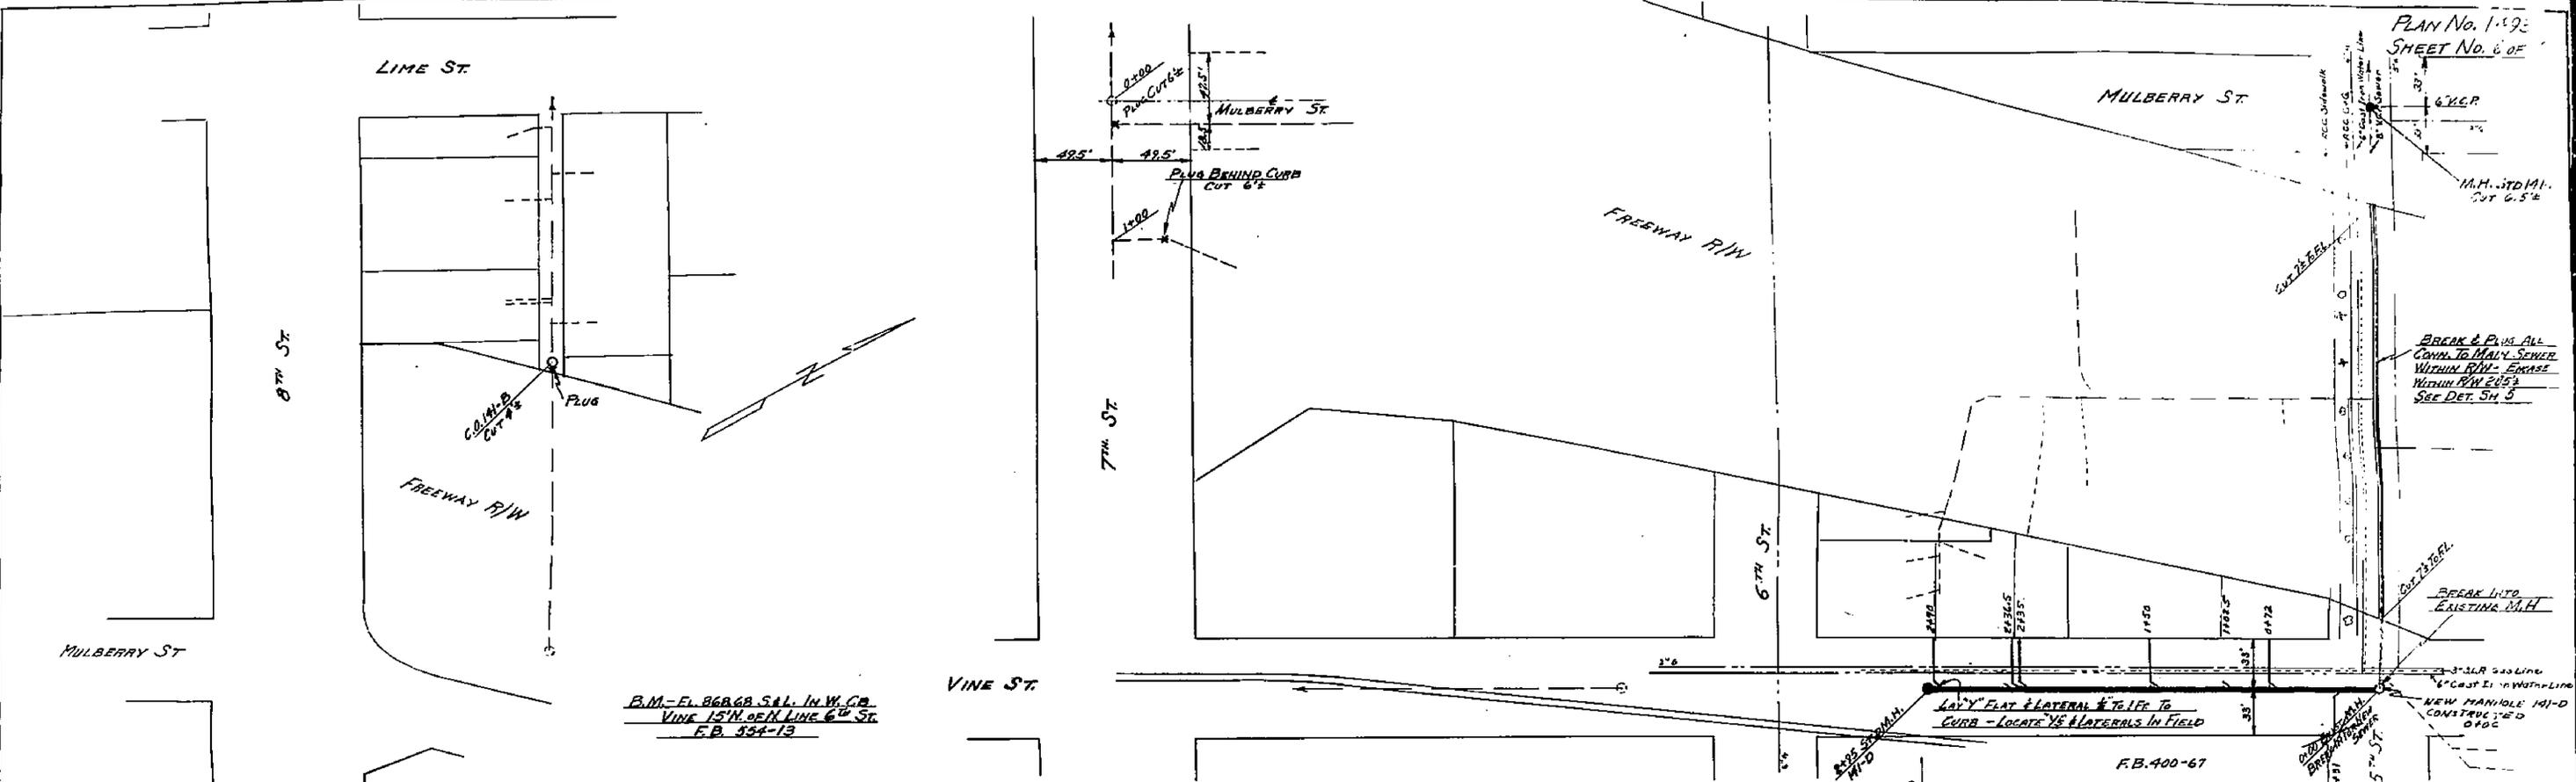



B.M. - E.L. 868.68 S&L. IN W. COR.
VINE 15' N. OF N. LINE 6TH ST.
F.B. 534-13

LAY FLAT & LATERAL & TIE TO CURB - LOCATE VE & LATERALS IN FIELD

F.B. 400-67

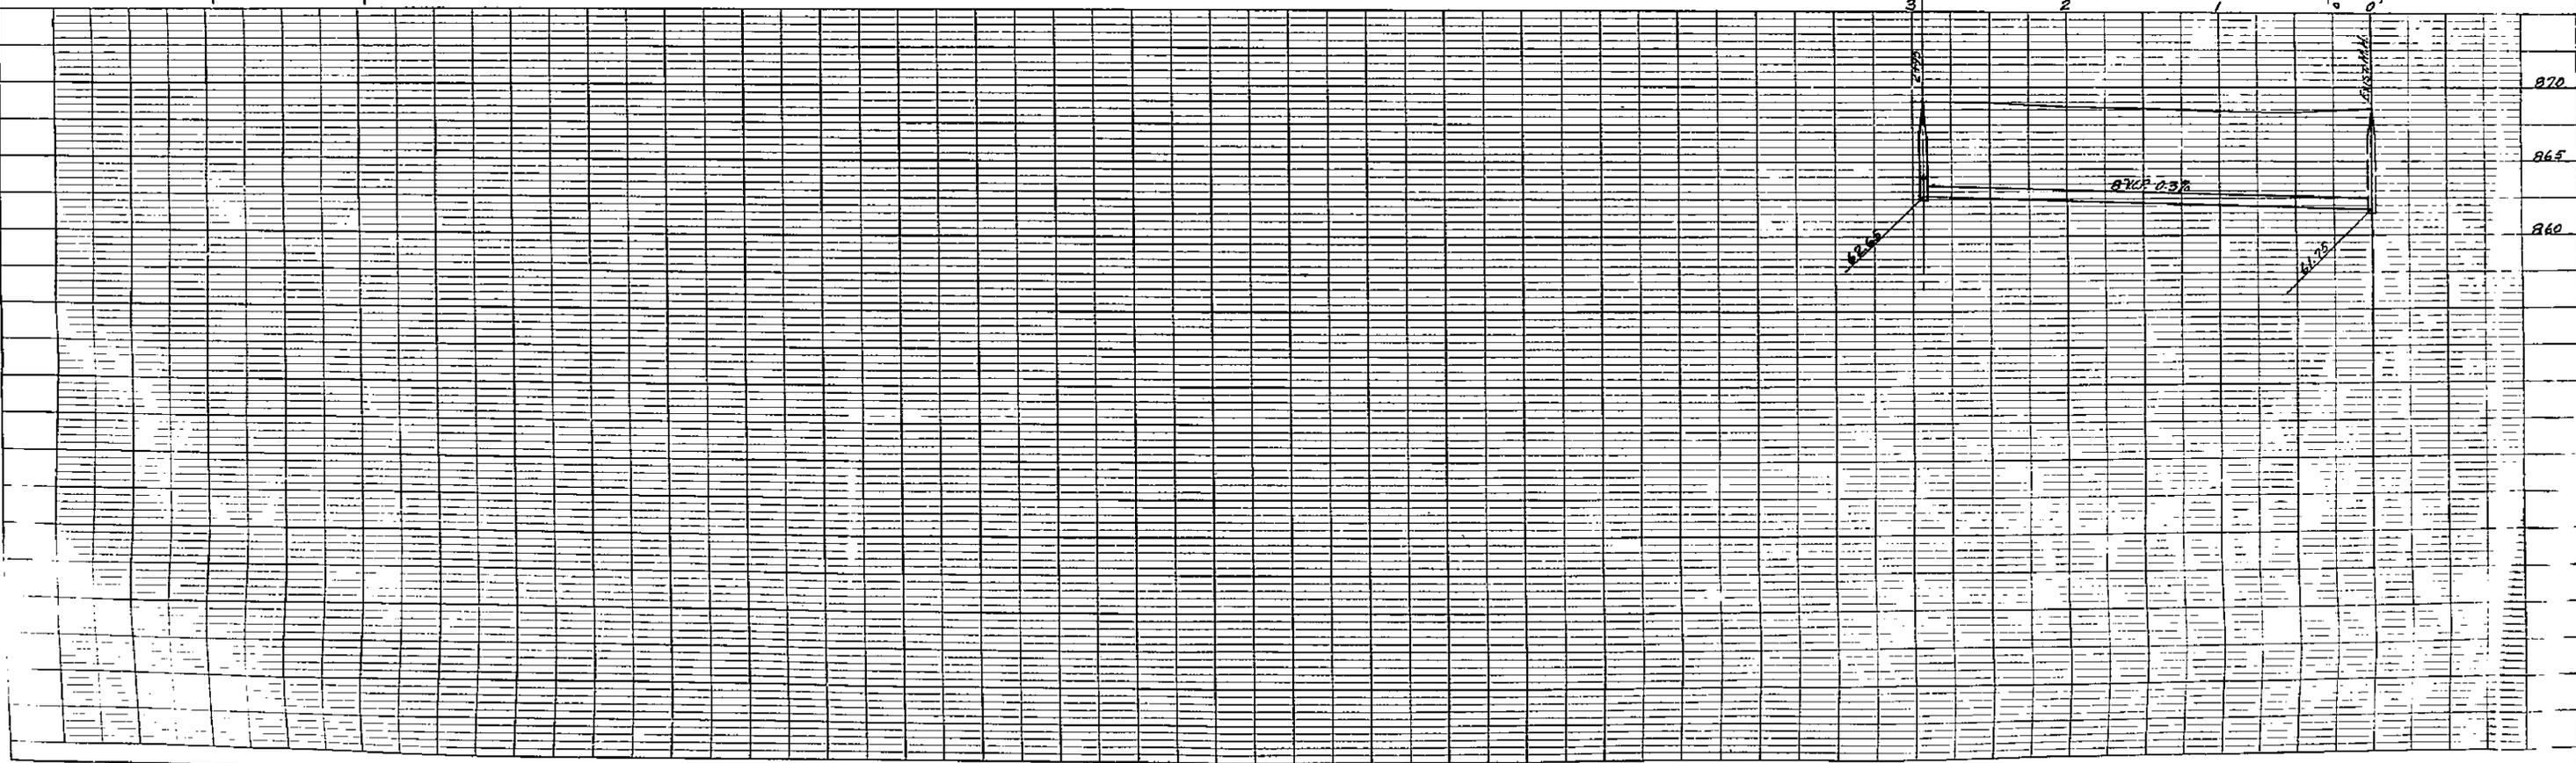








1493

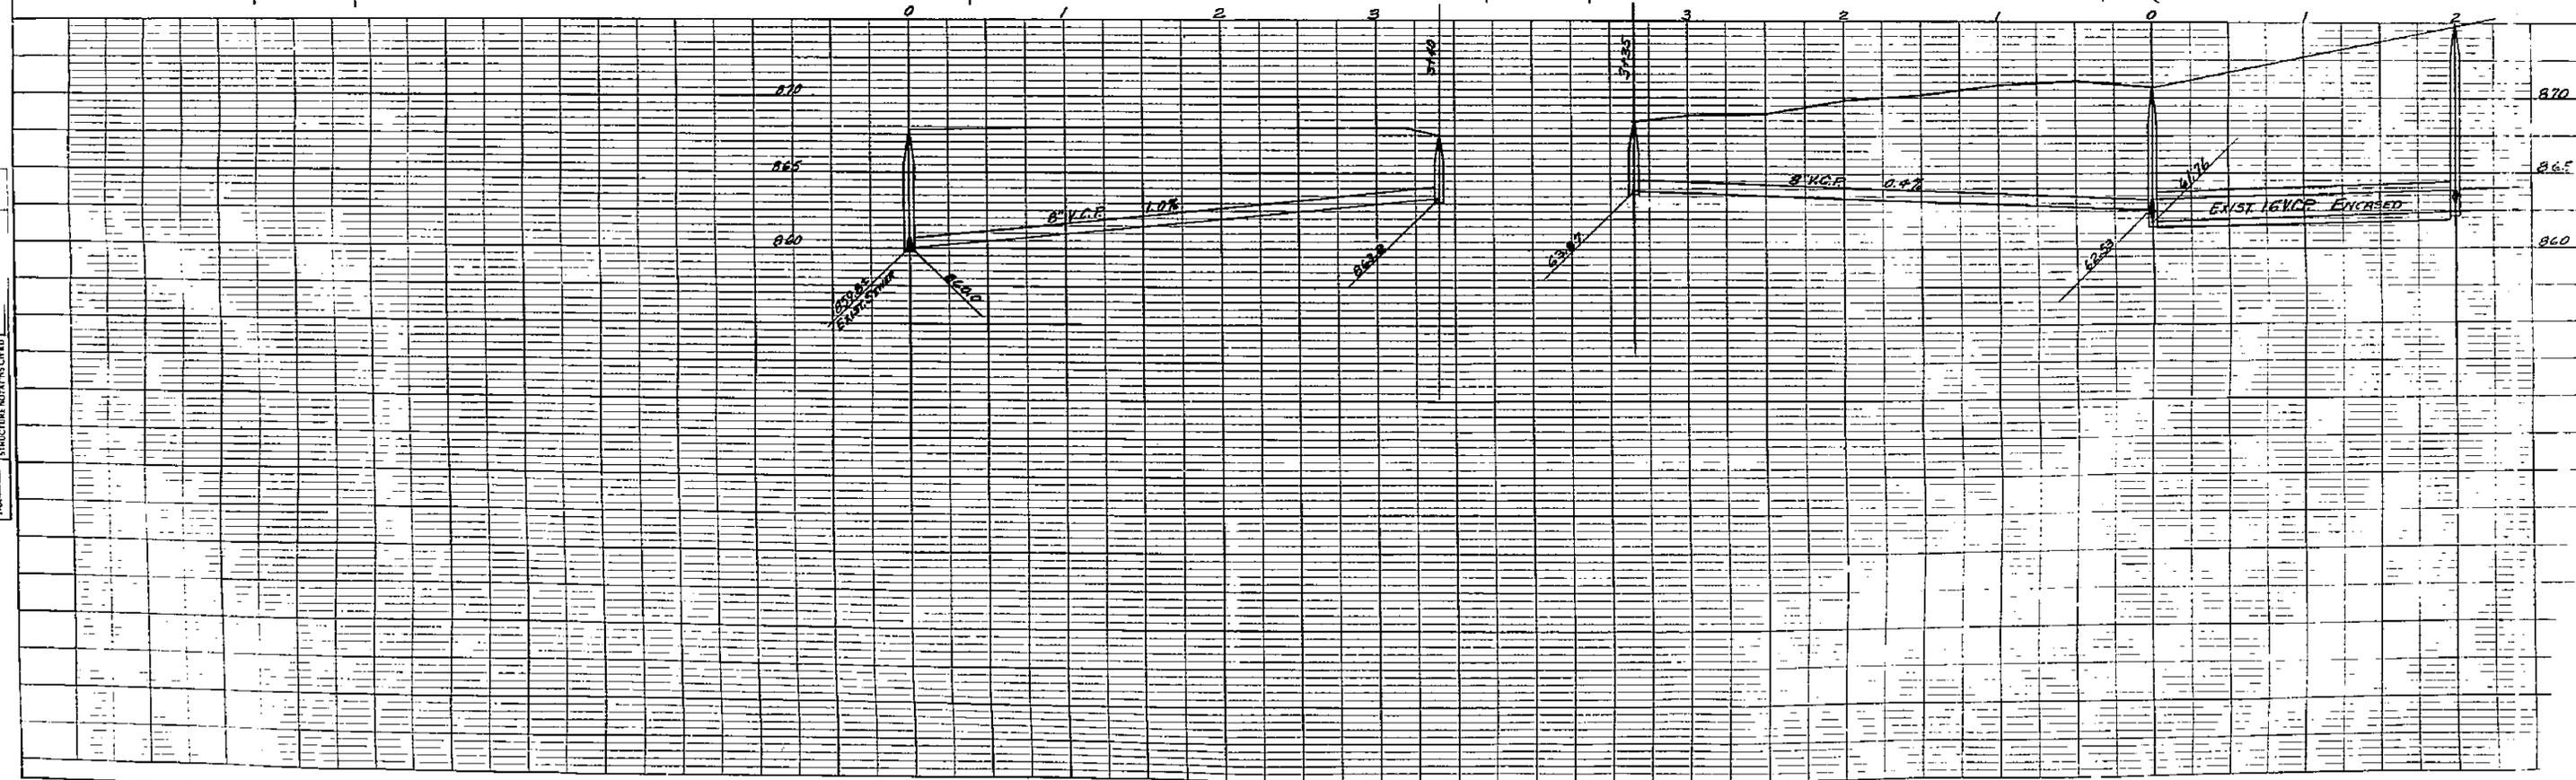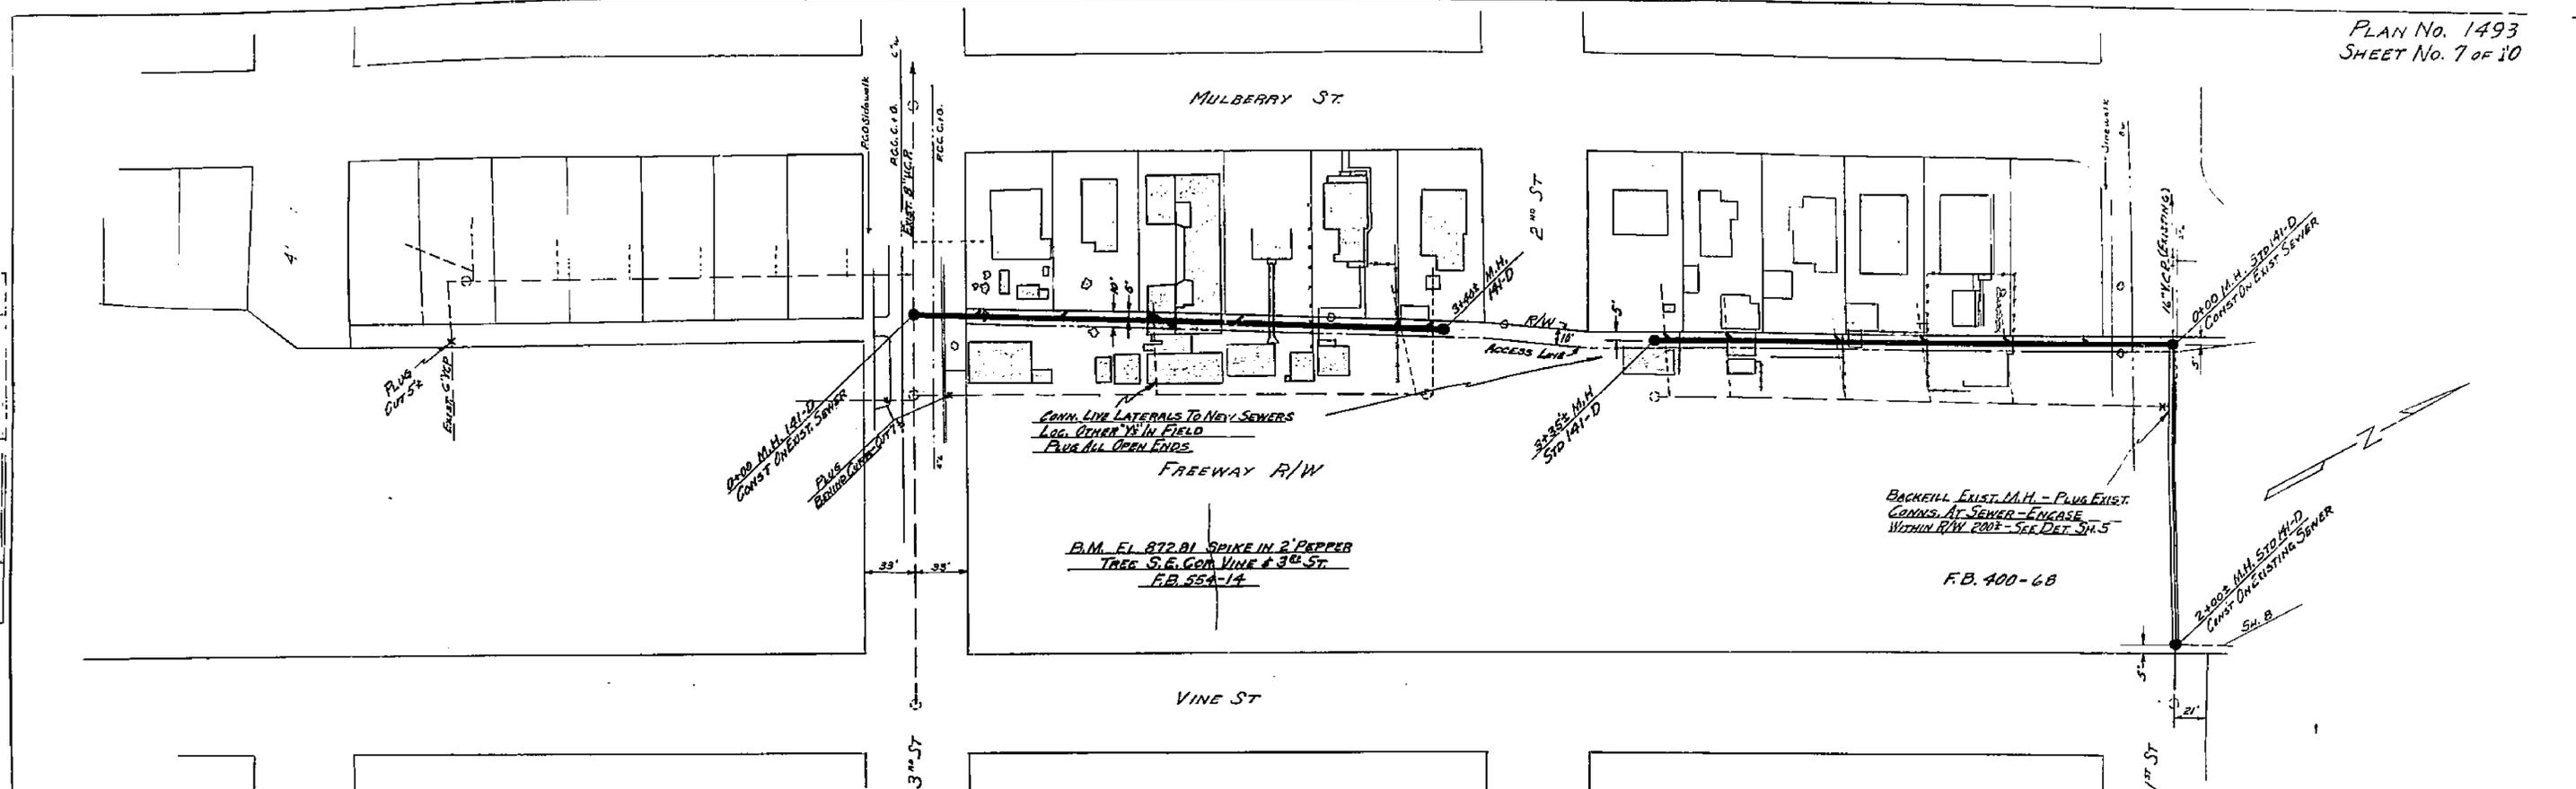

PLAN
SUBMITTED
NOTED
NOTE BOOK
DATE
STRUCTURE NOTATION

PLAN
SUBMITTED
NOTED
NOTE BOOK
DATE
STRUCTURE NOTATION

1493

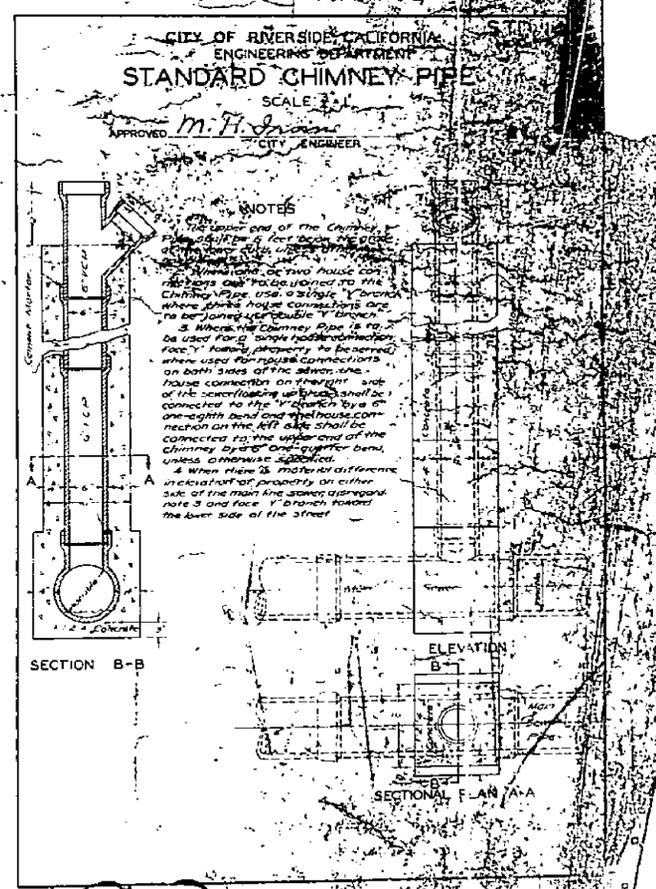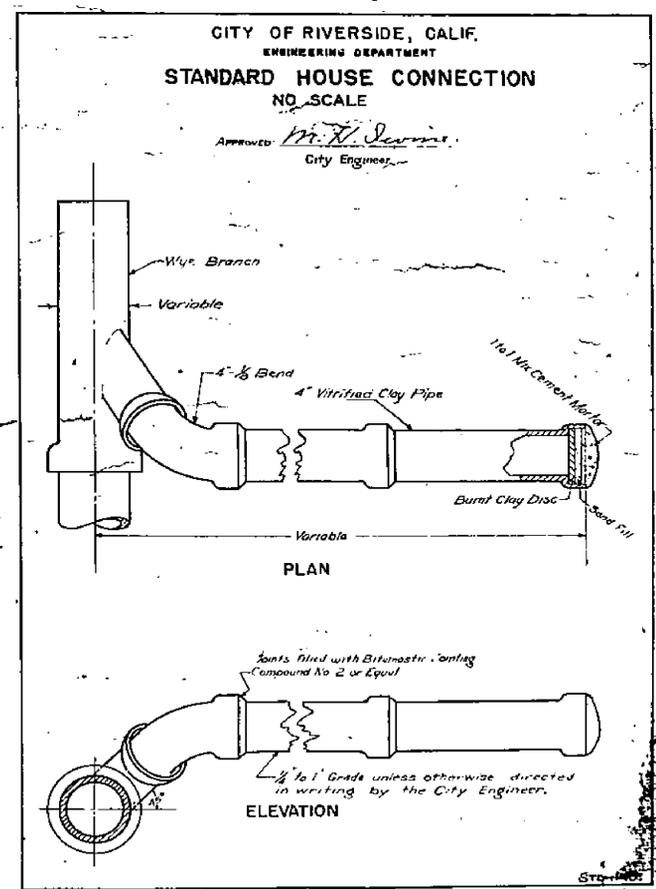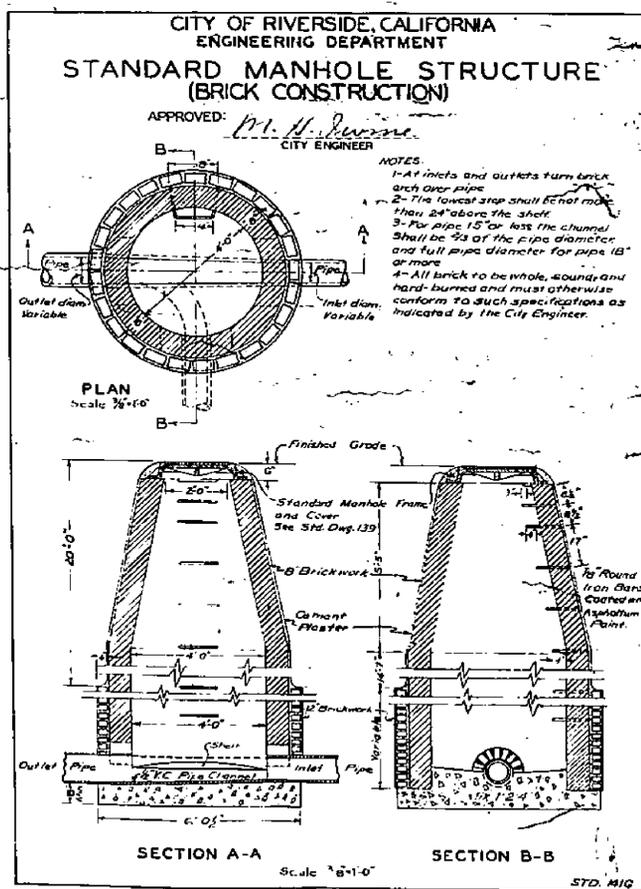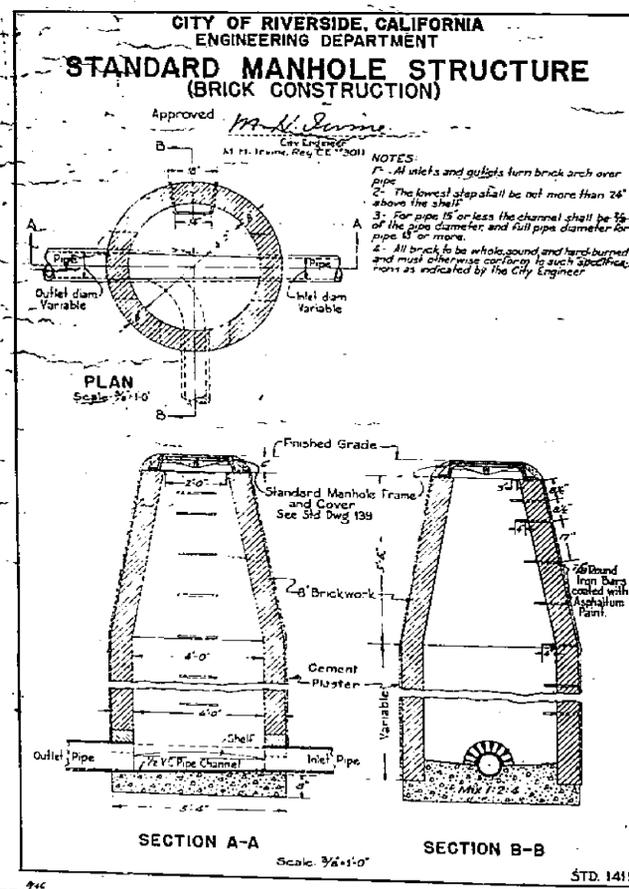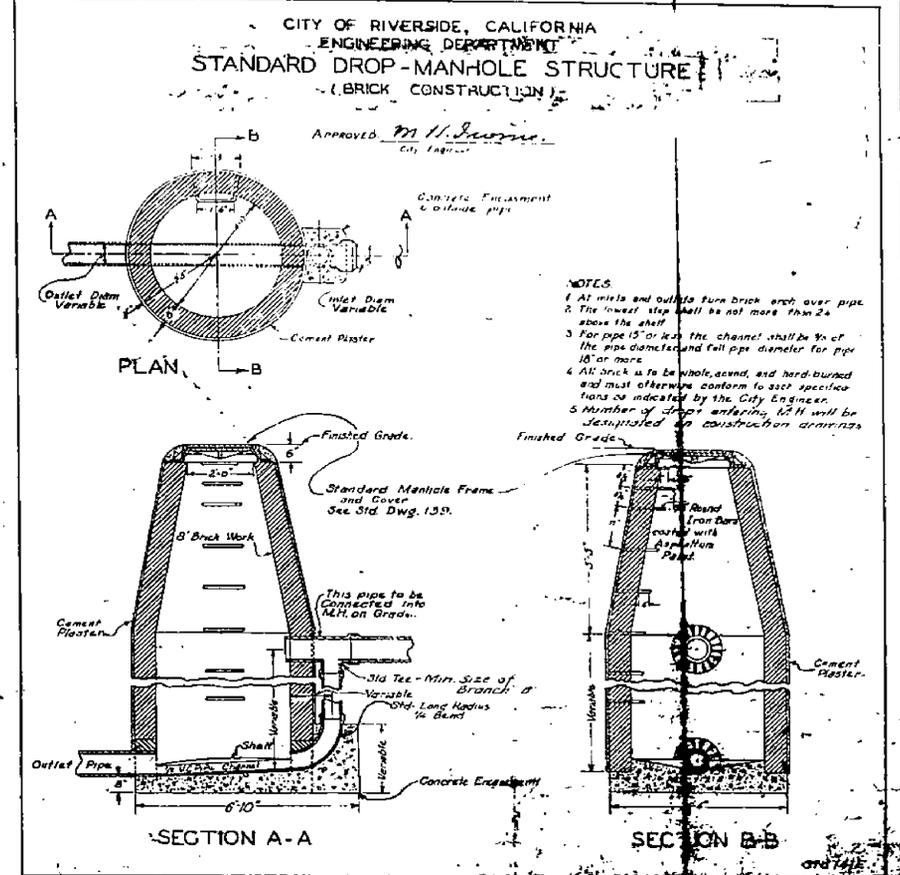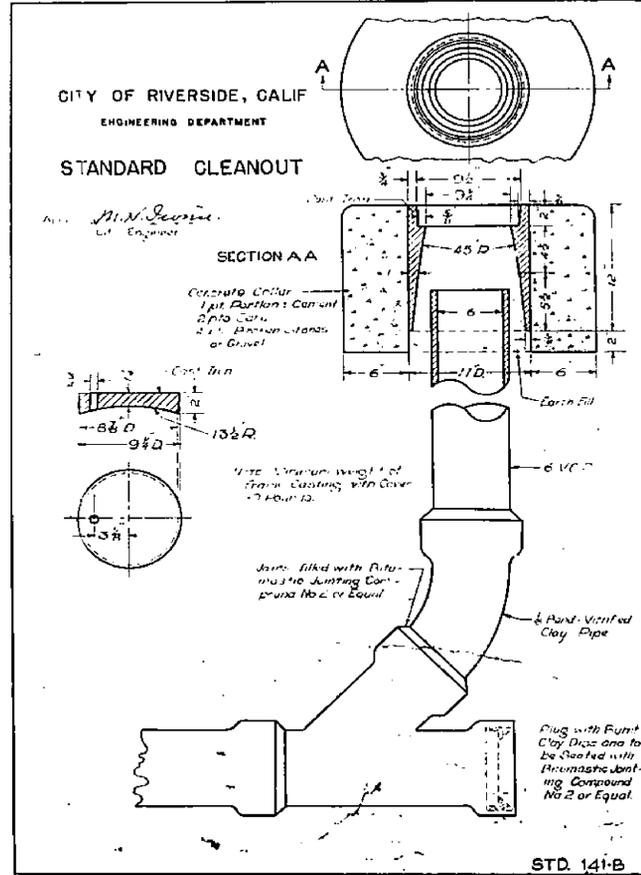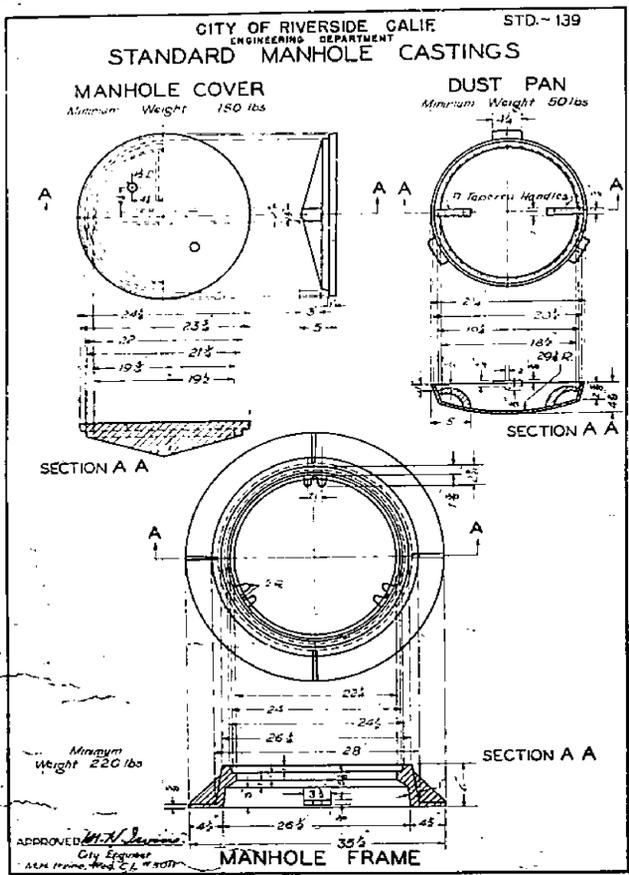

1493