


**FILED**  
 JUL 29 1926  
 Jack A. Ross  
 COUNTY RECORDER  
 Francis B. Ross  
 DEPUTY  
 By H. A. Bradley

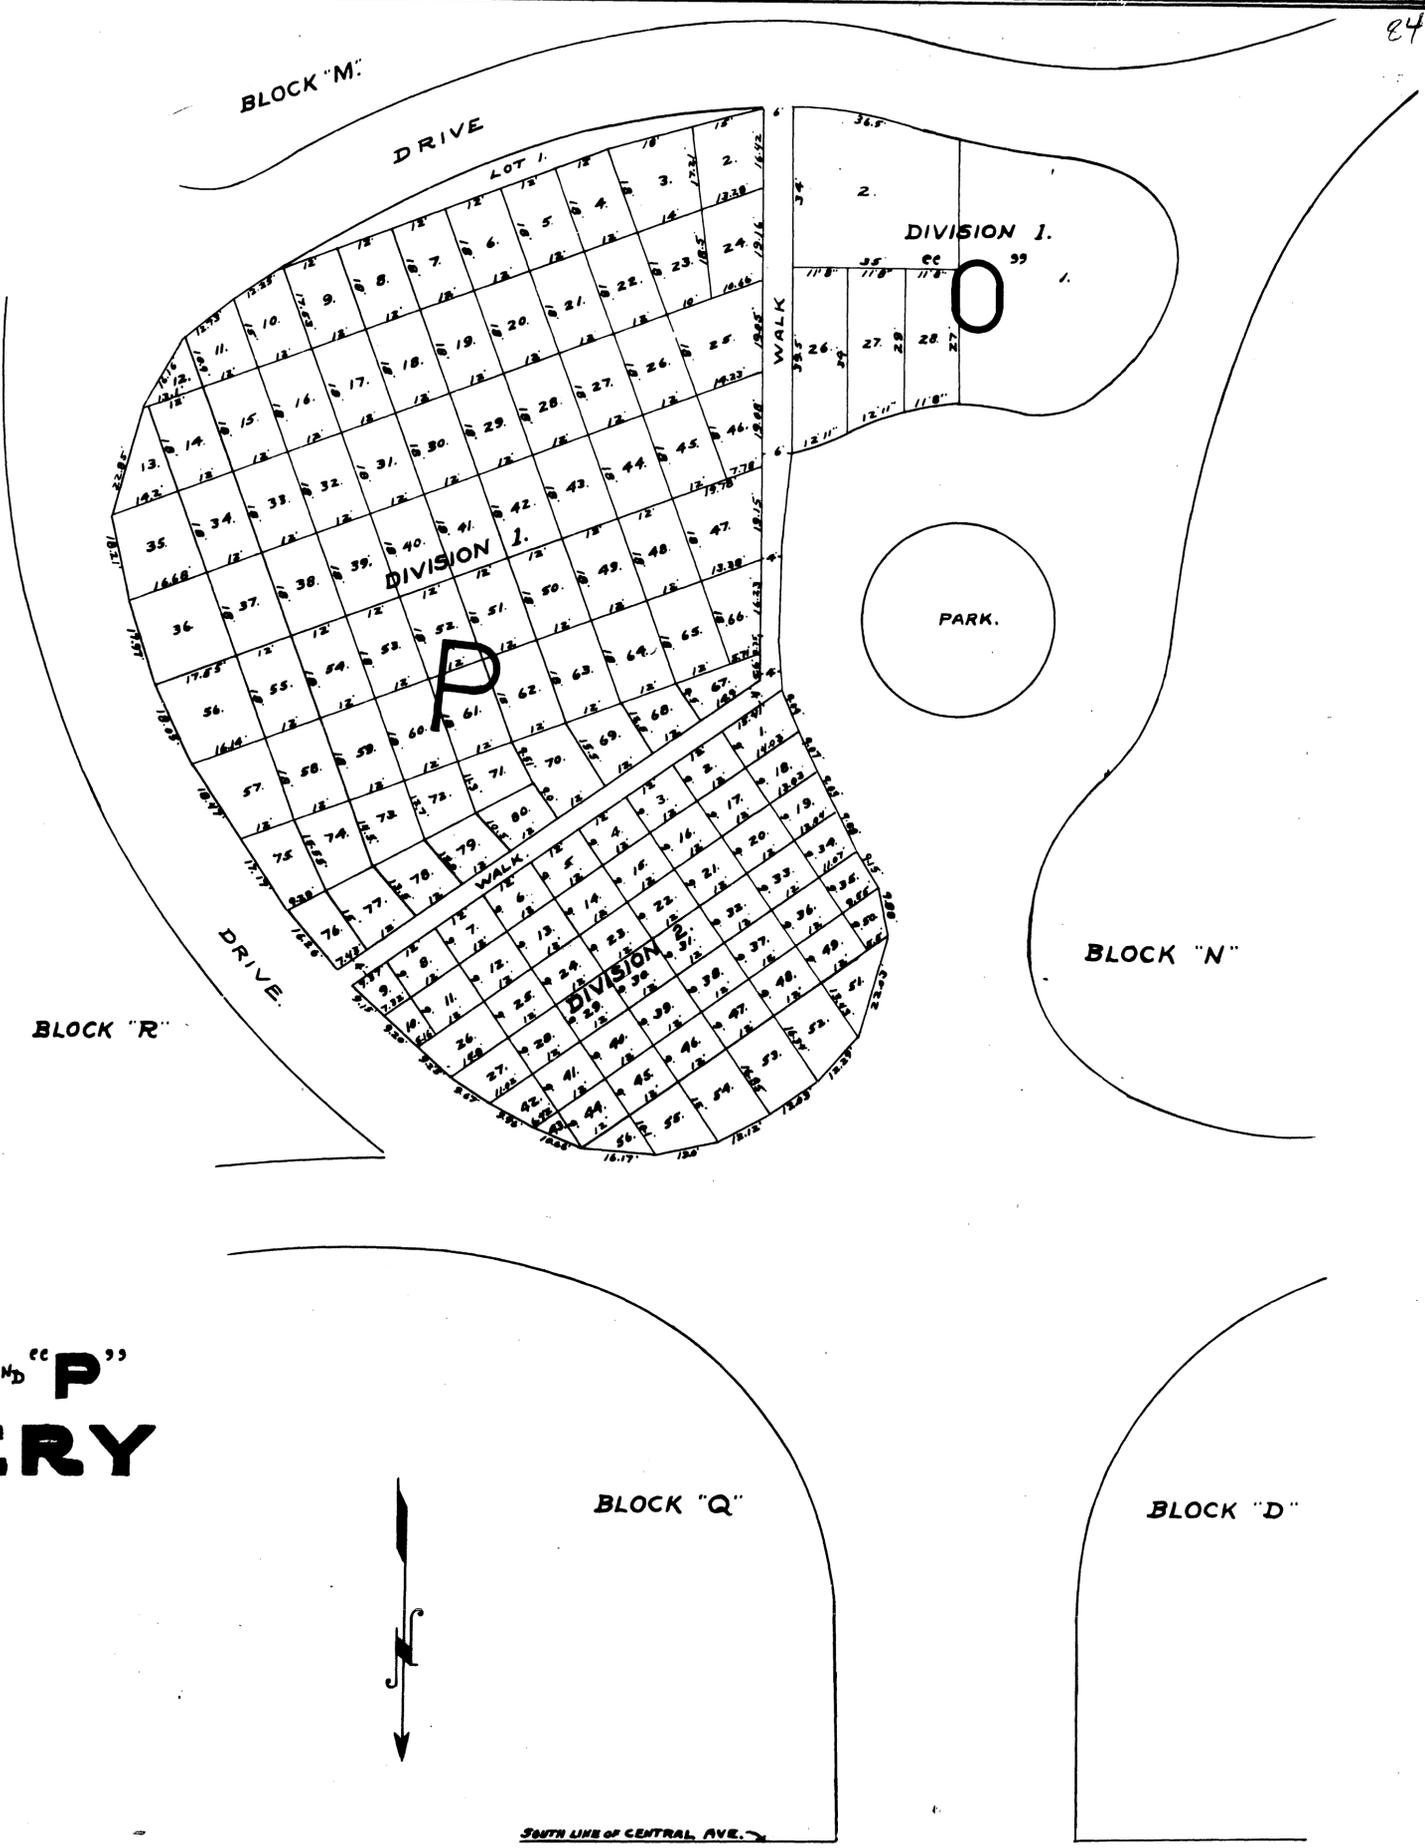

**PLAT "P"**  
**RECORD SURVEY**  
**SUBDIVISION OF PLAT "O" AND "P"**  
**OLIVEWOOD CEMETERY**

SURVEYED BY H.D. BRADLEY - JUNE, 1926 - SCALE 1 INCH = 20 FEET.

I HEREBY CERTIFY THAT THIS MAP  
 CORRECTLY REPRESENTS A SURVEY AS  
 MADE BY ME IN JUNE, 1926.  
*H. D. Bradley*  
 LICENSED SURVEYOR.

RS 7 / 84

RS 7/84

24

84