



# DIAGRAM

## EXHIBITING

IN THE CITY OF RIVERSIDE ON WHICH WORK HAS BEEN DONE UNDER THE OFFICIAL CONTRACT OF THE SUPERINTENDENT OF STREETS OF SAID CITY WITH DATED

FOR THE CONSTRUCTION OF

AS IS MORE PARTICULARLY DESCRIBED IN SAID CONTRACT TO WHICH REFERENCE IS HEREBY MADE FOR FURTHER PARTICULARS; SAID DIAGRAM ALSO SHOWS THE RELATIVE LOCATION OF EACH LOT PORTION OF LOT PIECE OR PARCEL OF LAND ASSESSED FOR THE WORK DONE NUMBERED IN RED INK TO CORRESPOND TO THE RED INK NUMBERS IN THE ASSESSMENT

HEREIN FIGURES NEXT TO PROPERTY LINES SHOW LENGTH OF SAID LINES IN FEET. THE MARK (') MEANS FEET. PROPERTY LINES THAT DIFFER FROM THE RECORDED SUBDIVISIONS ARE SHOWN BY BROKEN LINES. THE DISTRICT BENEFITED IS BOUNDED BY A HEAVY DASHED LINE

PROPERTY COVERED BY THIS ASSESSMENT IS SHOWN ON THE FOLLOWING RECORDED MAPS:

HEREIN THE LEGEND OF THE DIFFERENT KINDS OF WORK PERFORMED IS SHOWN AS FOLLOWS:

CITY ENGINEER OF THE CITY OF RIVERSIDE  
THE FOLLOWING IS A STATEMENT OF AMOUNTS OF DIFFERENT KINDS OF WORK DONE BY UNDER CONTRACT DATED 19 PURSUANT TO RESOLUTION OF INTENTION NO. ADOPTED BY THE CITY COUNCIL OF THE CITY OF RIVERSIDE ON THE DAY OF 19

AT SAID CITY OF RIVERSIDE THIS DAY OF

-----  
STREET SUPERINTENDENT  
OF THE CITY OF RIVERSIDE

I HEREBY CERTIFY THAT THE ABOVE WORK WAS DONE IN ACCORDANCE WITH LINES AND GRADES FURNISHED BY ME AND THAT THE DIAGRAM OF THE ASSESSMENT DISTRICT FOR THE SAME IS CORRECT.

-----  
CITY ENGINEER  
OF THE CITY OF RIVERSIDE

RECORDED AT O'CLOCK M  
THIS DAY OF 19

-----  
SUPERINTENDENT OF STREETS  
OF THE CITY OF RIVERSIDE

PROPERTY OF  
CITY OF MONROE  
DEPT. OF PUBLIC WORKS  
ENGINEERING DIVISION



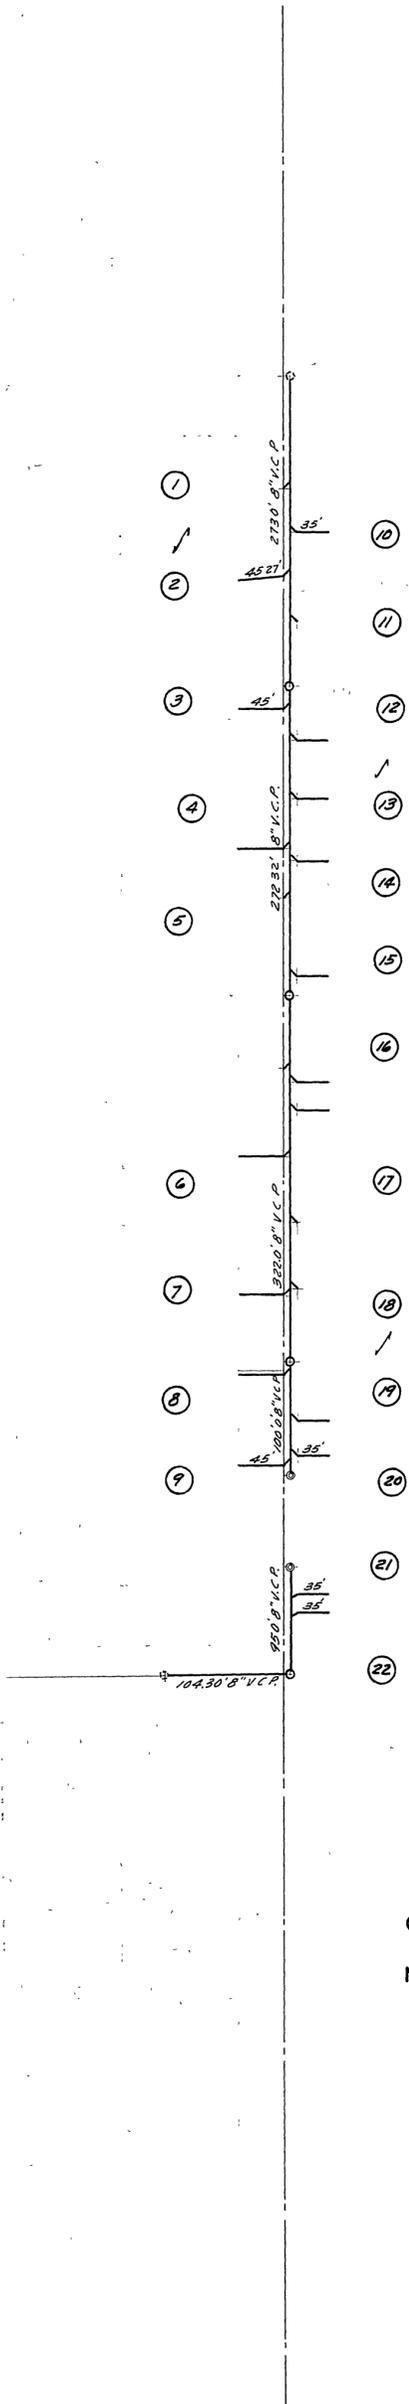


DIAGRAM  
OF THE PROPERTY AFFECTED OR BENEFITED  
BY THE WORK IN THE  
MONROE STREET SANITARY SEWER DISTRICT

PROPERTY OF  
CITY OF MONROE  
DEPT. OF PUBLIC WORKS  
ENGINEERING DIVISION

S-106B

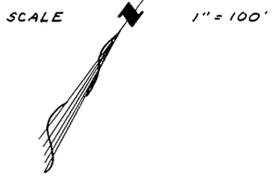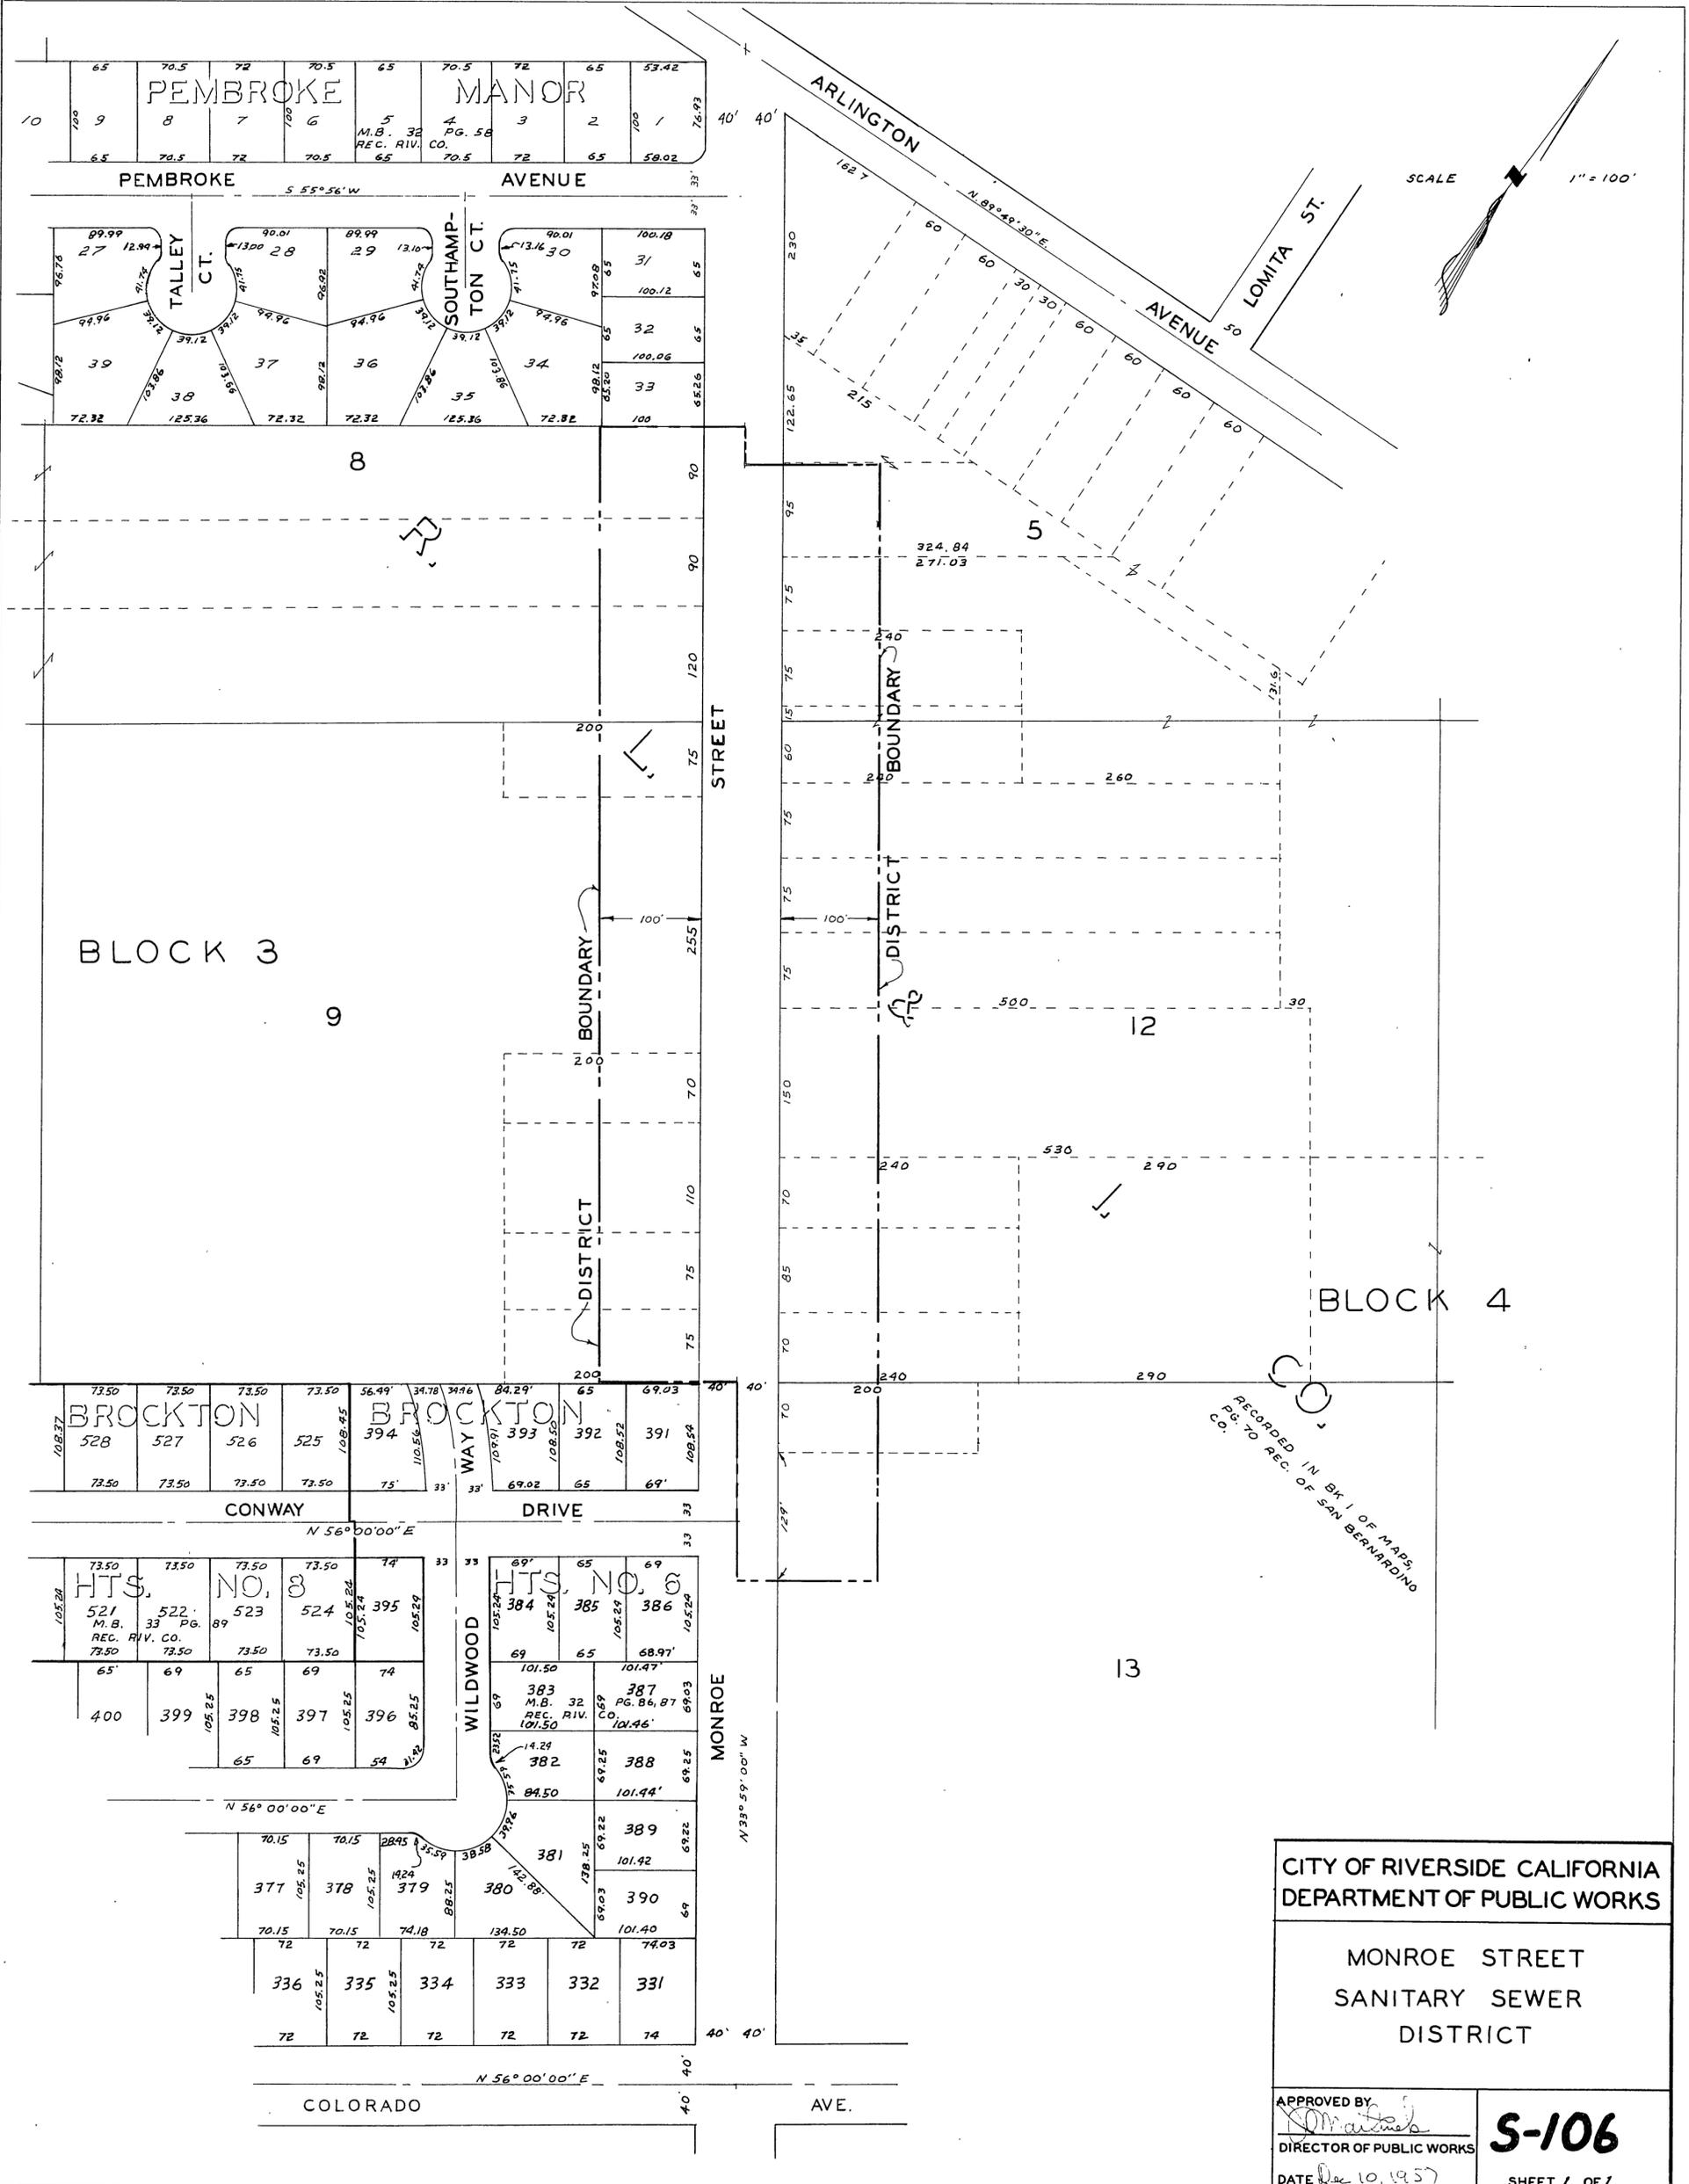

RECORDED IN BK 1 OF MAPS  
PG. 70 TO REC. OF SAN BERNARDINO  
CO.

CITY OF RIVERSIDE CALIFORNIA  
DEPARTMENT OF PUBLIC WORKS

MONROE STREET  
SANITARY SEWER  
DISTRICT

APPROVED BY  
*[Signature]*  
DIRECTOR OF PUBLIC WORKS  
DATE Dec 10, 1957

**S-106**  
SHEET 1 OF 1