

**CONSTRUCTION NOTES**


1. CONSTRUCTION SHALL BE IN ACCORDANCE WITH STANDARD SPECIFICATIONS FOR PUBLIC WORKS CONSTRUCTION, 1976 EDITION AND CITY OF RIVERSIDE, DEPT. OF PUBLIC WORKS STANDARD DRAWS.
  2. WHERE THE PROPOSED SEWER CROSSES A WATER MAIN, THE CONTRACTOR SHALL ENCASE THE SEWER OR WATER MAIN PER P.U.D. WATER DIVISION STD. DRAWING NO. CWD-023.
  3. ALL STATIONING ON SEWER CENTERLINE.
  4. THE CONTRACTOR SHALL BE RESPONSIBLE TO REPAIR OR REPLACE IN KIND AT HIS OWN EXPENSE ANY IMPROVEMENTS DAMAGED BY HIS OPERATION DURING CONSTRUCTION.
  5. BACKFILL SHALL BE IN ACCORDANCE WITH CITY OF RIVERSIDE STD. DRAWING NO. 453.
  6. PIPE SHALL BE BEDDED PER CASE I, CITY OF RIVERSIDE STD. DRAWING NO. 452.
  7. IT SHALL BE THE RESPONSIBILITY OF THE CONTRACTOR TO CLEAR THE RIGHT-OF-WAY IN ACCORDANCE WITH THE PROVISIONS OF LAWS IF AFFECTS EACH UTILITY INCLUDING IRRIGATION LINES AND APPURTENANCES AND AT NO COST TO THE CITY.
- CONSTRUCTION LEGEND**
- 500 CONSTRUCT MANHOLE PER CITY OF RIVERSIDE STD. DWG. NO. 500.
  - 560 CONSTRUCT CLEAN OUT PER CITY OF RIVERSIDE STD. DWG. NO. 560.
  - 562 CONSTRUCT SEWER LATERAL PER CITY OF RIVERSIDE STD. DWG. NO. 562.

**NOTICE TO CONTRACTOR**

THE EXISTENCE AND LOCATION OF ANY UNDERGROUND UTILITY PIPES OR STRUCTURES SHOWN ON THIS PLAN ARE OBTAINED BY A SEARCH OF THE AVAILABLE RECORDS. TO THE BEST OF OUR KNOWLEDGE THERE ARE NO EXISTING UTILITIES EXCEPT AS SHOWN ON THESE PLANS. THE CONTRACTOR IS REQUIRED TO TAKE DUE PRECAUTIONARY MEASURES TO PROTECT THE UTILITY LINES SHOWN AND ANY OTHER LINES NOT OF RECORD OR NOT SHOWN ON THIS PLAN.

- CONSTRUCTION NOTES CONT. D**
8. LOCATION OF LATERALS TO BE DETERMINED IN THE FIELD AT THE DIRECTION OF THE DIVISION.
  9. CONTRACTOR IS TO VERIFY EXIST. SEWER ELEVATION PRIOR TO CONSTRUCTION.
  10. THE SEWER CONTRACTOR SHALL ACQUIST MANHOLES TO FINAL GRADE AFTER FINISH IS COMPLETED.
  11. A PUG SHALL BE INSTALLED AND WILL REMAIN IN PLACE WHERE THE NEW SEWER CONNECTS WITH THE EXIST. SEWER UNTIL THE NEW SEWER IS ACCEPTED BY THE CITY.

**NOTE:**  
THESE PLANS ARE FOR SEWER CONSTRUCTION ONLY.

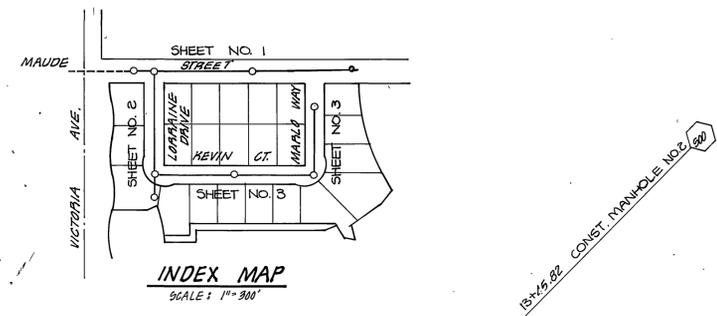

**NOTE:**  
EXISTING 8" SEWER TO BE ABANDONED AFTER TRACT SEWER MAIN IS COMPLETED. CONTRACTOR MUST ASSURE SEWER FACILITIES TO THE TREES WILL REMAIN OPERATIONAL AT ALL TIMES.



SEE SHEET NO. 2  
LOARINE DRIVE

SEE SHEET NO. 3  
MARLO WAY

**MAUDE STREET**

**NOTE:**  
THE PRIVATE ENGINEER SIGNING THESE PLANS IS RESPONSIBLE FOR THE ACCURACY AND ACCEPTABILITY OF THE WORK HEREON. IN THE EVENT OF DISCREPANCIES ARISING DURING CONSTRUCTION, THE PRIVATE ENGINEER SIGNING THESE PLANS SHALL BE RESPONSIBLE FOR DETERMINING AN ACCEPTABLE SOLUTION AND REVISING THE PLANS FOR APPROVAL BY THE CITY.



APPROVED BY: <i>Wally Hylen</i> CHIEF UTILITIES ENGINEER, WATER	DATE: 3-21-77	<b>HAWKINS, ROBERTSON &amp; ASSOCIATES</b> ENGINEERS • SURVEYORS DATE: 11/1/76 <i>Charles E. Robertson</i> P.O.E. 15016	BENCH MARK: PG-A FOUND BRASS DISC STAMPED (PG-A) CAPPED AT INTERSECTION OF VICTORIA AVE. & WASHINGTON STREET. F.B. 795-3 ELEV. 927.993	MARK: _____ DESIGNED BY: <i>Ed</i> DRAWN BY: <i>Ray</i> CHECKED BY: <i>BM</i>	CITY OF RIVERSIDE, CALIFORNIA DEPARTMENT OF PUBLIC WORKS APPROVED BY: _____ OFFICE ENGINEER PARK DEPARTMENT TRAFFIC DIVISION ASSISTANT CITY ENG.	APPROVED BY: <i>William D. Hardin</i> DIRECTOR OF PUBLIC WORKS DATE: 4/21/77	<b>TRACT NO. 8327</b> INDEXED 7A PROJECT NO. _____ <b>MAUDE STREET</b> SEWER PLAN AND PROFILE SHEET 1 OF 3 HORIZ. SCALE: 1" = 40' VERT. SCALE: 1" = 4'	5-1079 FILE NO. 76-2660
---	---------------	---	--	--	--	--	---	----------------------------

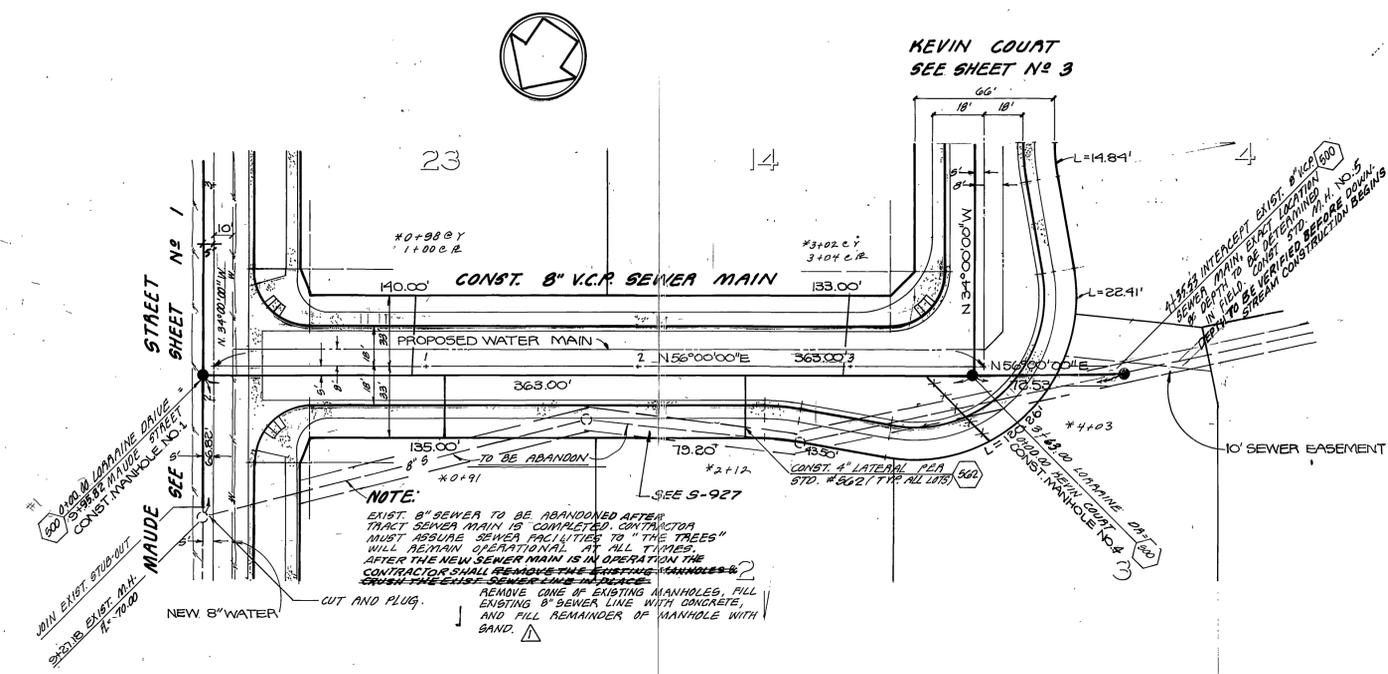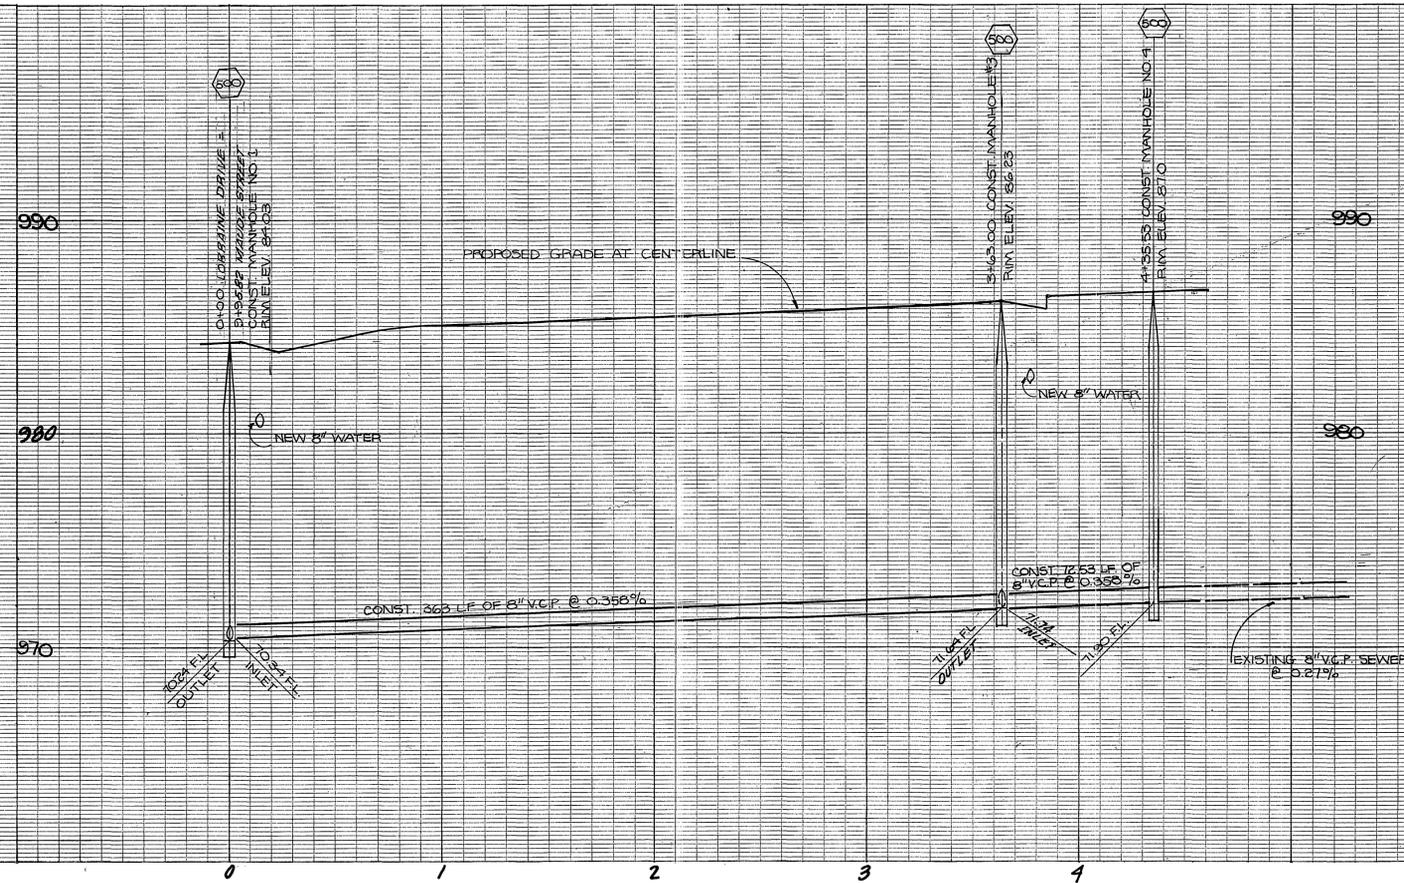

# LORRAINE DRIVE

NOTE: THESE PLANS ARE FOR SEWER CONST. ONLY!

APPROVED BY: <i>Wally Ayle</i> CHIEF UTILITIES ENGINEER, WATER	DATE: 3-21-77	<b>HAWKINS, ROBERTSON &amp; ASSOCIATES</b> ENGINEERS • SURVEYORS DATE: 11/1/76 Charles E. Robertson P.E. 15010	CITY OF RIVERSIDE, CALIFORNIA DEPARTMENT OF PUBLIC WORKS	<b>TRACT NO. 8327</b>	PROJECT NO.: S-1079
		BENCH MARK: PG-A FOUND BRASS DISC STAMPED (PG-A) CAPPED AT INTERSECTION OF VICTORIA AVE. & WASHINGTON STREET FB 795-3 ELEV. 921.993	APPROVED BY: <i>William D. Hardner</i> DIRECTOR OF PUBLIC WORKS DATE: 4/21/77	LORRAINE DRIVE SEWER PLAN AND PROFILE	SHEET 2 OF 3

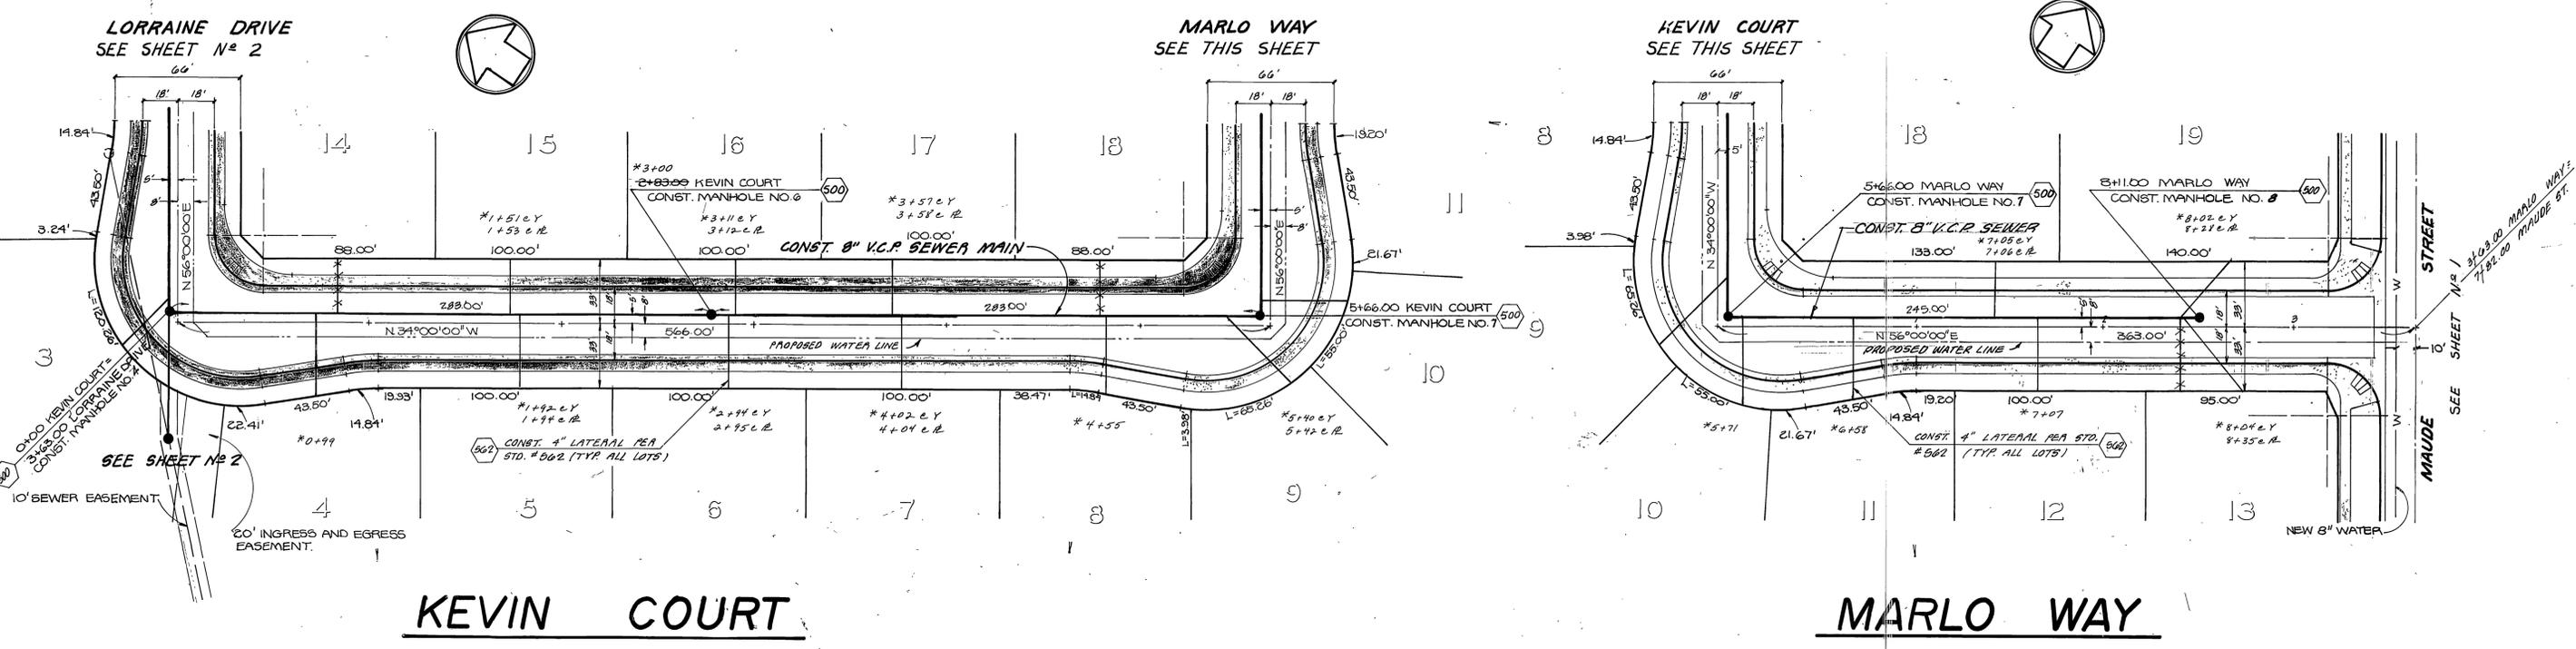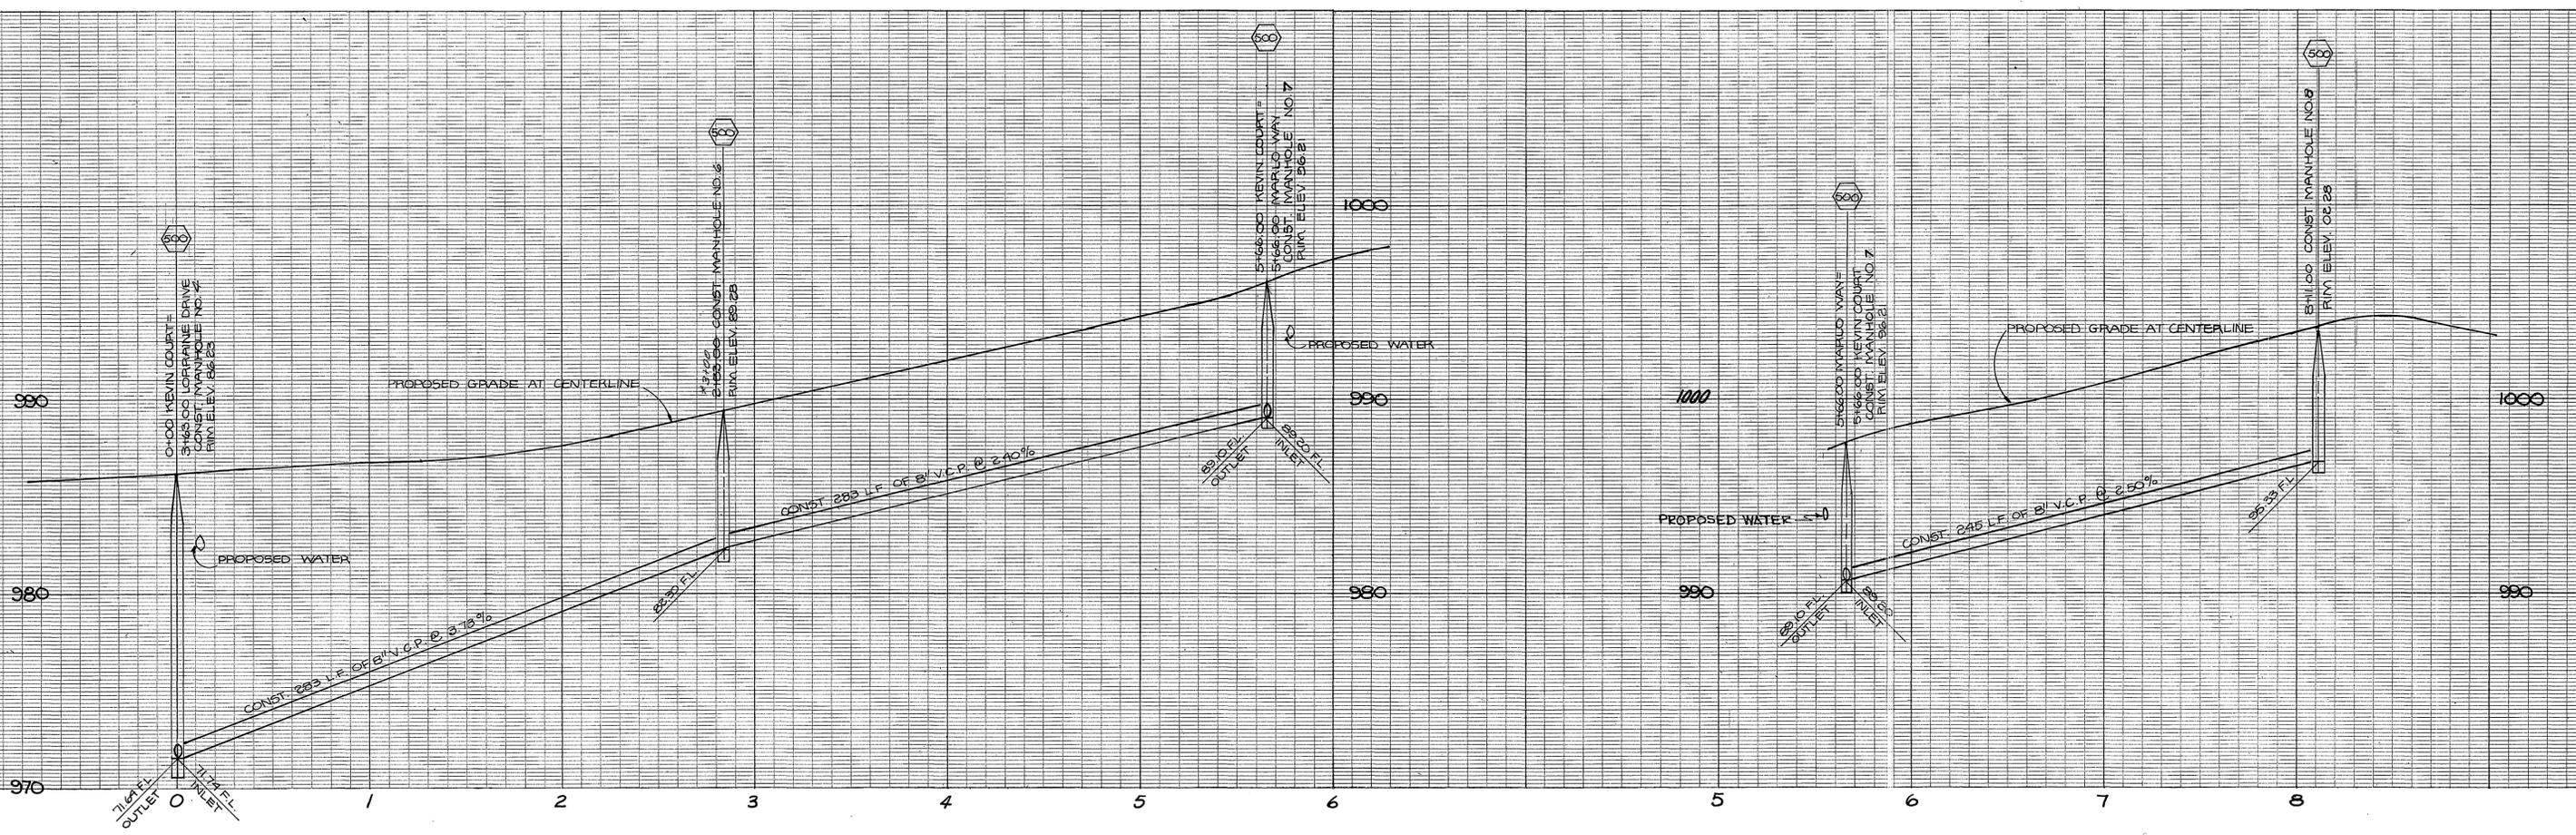

**KEVIN COURT**

**MARLO WAY**

NOTE: THESE PLANS FOR SEWER CONST. ONLY!

\* AS BUILT 8-78 KBT.

APPROVED BY: <i>Walter J. ...</i> CHIEF UTILITIES ENGINEER, WATER	DATE: 3-21-77	HAWKINS, ROBERTSON & ASSOCIATES ENGINEERS • SURVEYORS DATE: 11/1/76 Charles E. Robertson P.C.E. 15010	BENCH MARK: PA-A FOUND BRASS DISC STAMPED (76-A) CAPPED AT INTERSECTION OF VICTORIA AVE. & WASHINGTON STREET F.B. 785-3 ELEV. 927.939	CITY OF RIVERSIDE, CALIFORNIA DEPARTMENT OF PUBLIC WORKS	APPROVED BY: [Signature] DATE: 4/21/77	TRACT NO. 8327 KEVIN COURT - MARLO WAY SEWER PLAN AND PROFILE	PROJECT NO. S-1079 SHEET 3 OF 3 FILE NO. 76-2860
DESIGNED BY: [Signature]		DRAWN BY: [Signature]		CHECKED BY: [Signature]		HORIZ. SCALE: 1" = 40' VERT. SCALE: 1" = 4'	