



PROFILE SCALES
 HORIZ. 1" = 40'
 VERT. 1" = 4'

BENCHMARK:
 RR SPIKE IN PALM TREE
 NW CORNER LINCOLN &
 WASHINGTON 914.36

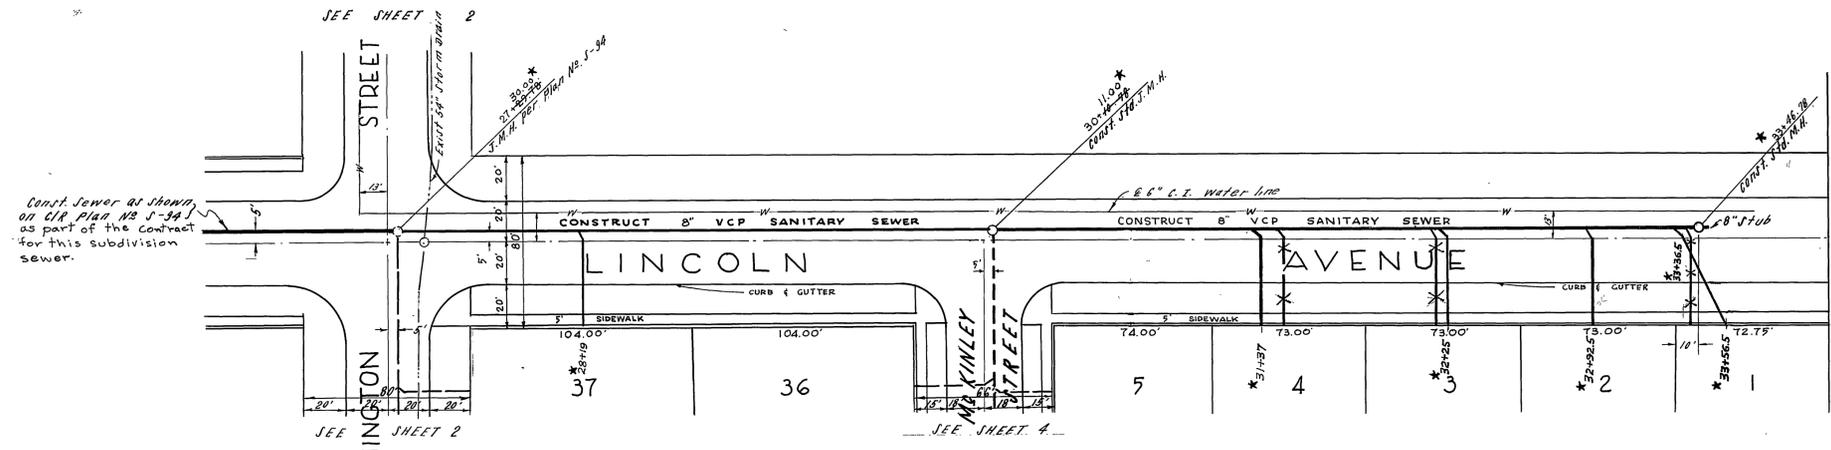

4" HOUSE CONNECTIONS
 TO BE LOCATED IN FIELD
 M.H.'s to be constructed as per
 City of Riverside Std. Drawing No. 500.

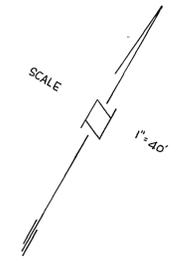

L. FREDERICK PACK
 P.E. 7448
 COVINA, CALIFORNIA
 APPROVED BY *L. Frederick Pack* DATE 12-3-58

CITY OF RIVERSIDE, CALIFORNIA
 DEPARTMENT OF PUBLIC WORKS
 SEWER PLAN & PROFILE
 PLAZA HOMES


LINCOLN AVENUE 27+29.78' - 33+86.78'

HOR. SCALE 1" = 40' VERT. SCALE 1" = 4'

APPROVED BY *Donald*
 DIRECTOR OF PUBLIC WORKS
 DATE 12-17-58


NO. S-155
 SHEET 1 OF 1

* = "As Built", 3-6-59, H.B. Ball

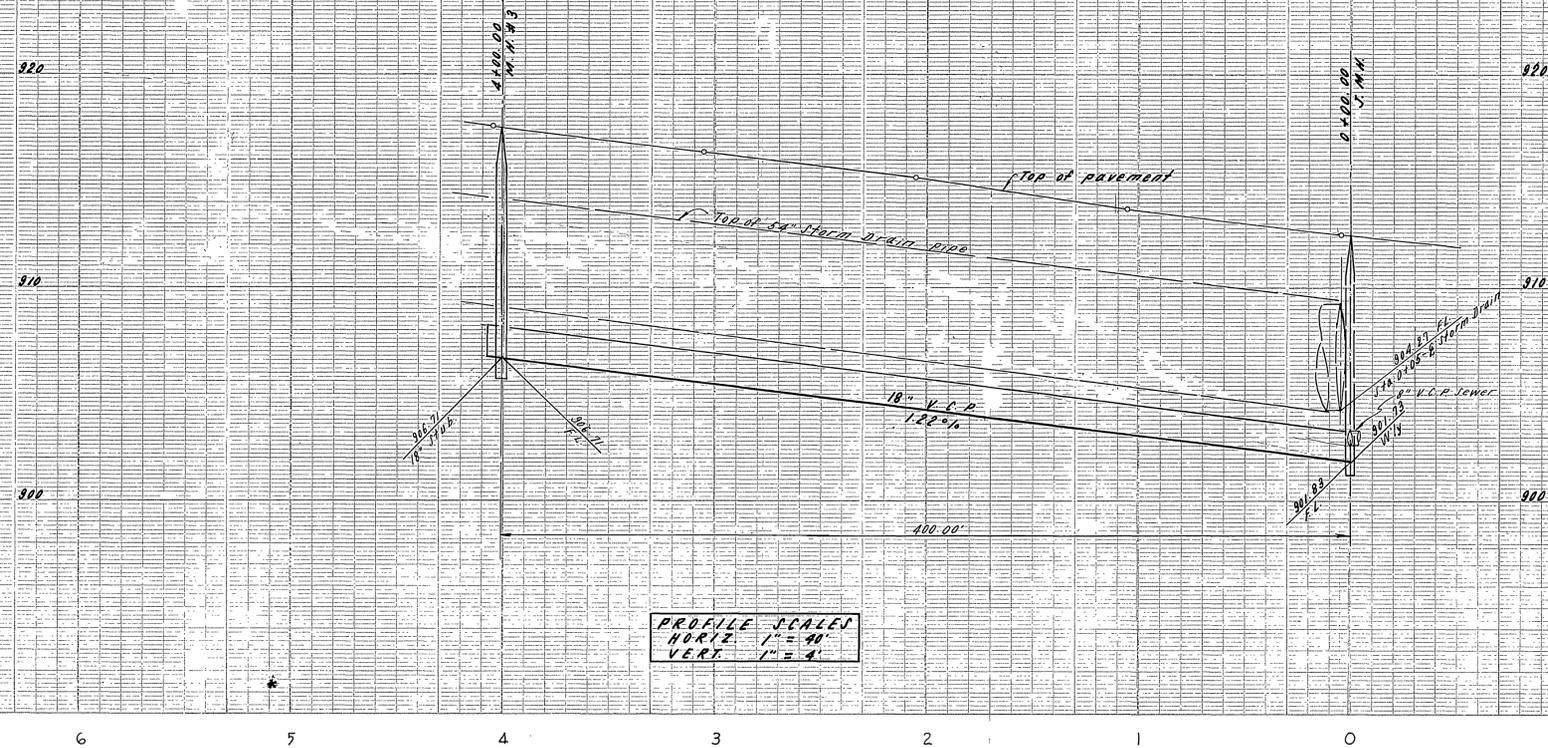


6 5 4 3 2 1 0

BENCHMARK:
 R.R. SPIKE IN PALM TREE
 NW CORNER LINCOLN &
 WASHINGTON 914.36

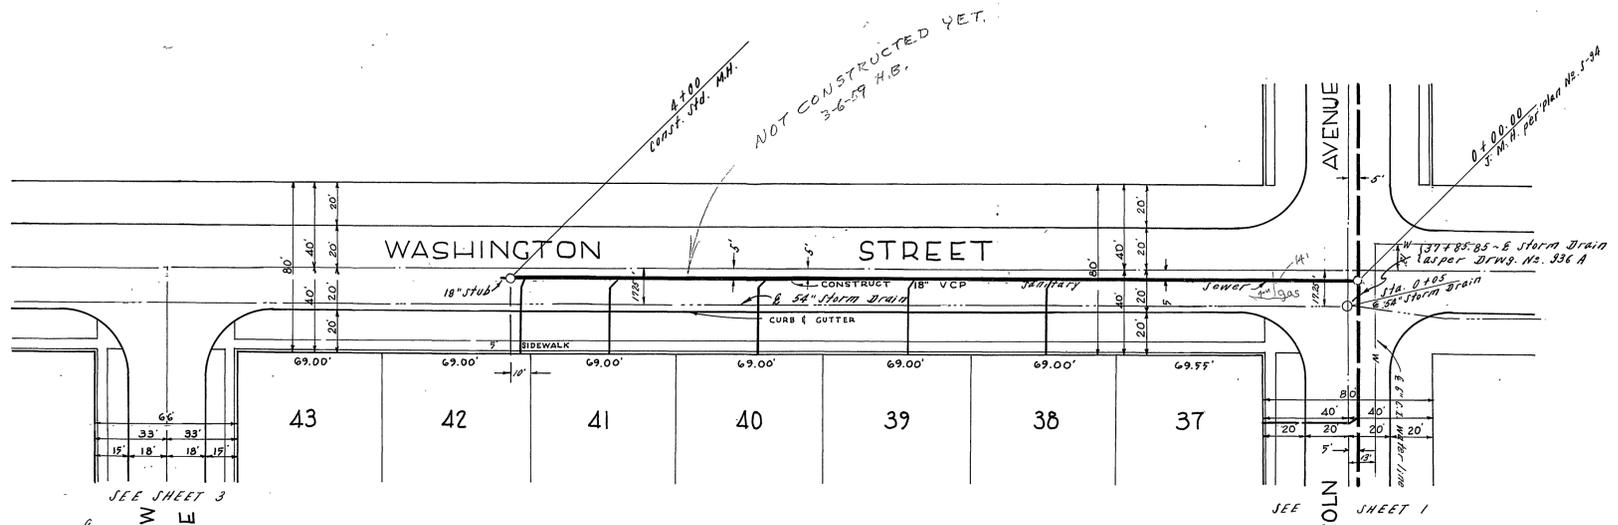

4" HOUSE CONNECTIONS
 TO BE LOCATED IN FIELD
 M.H.'s to be const. as per C.I.R.
 17th Drawing No. 50A.

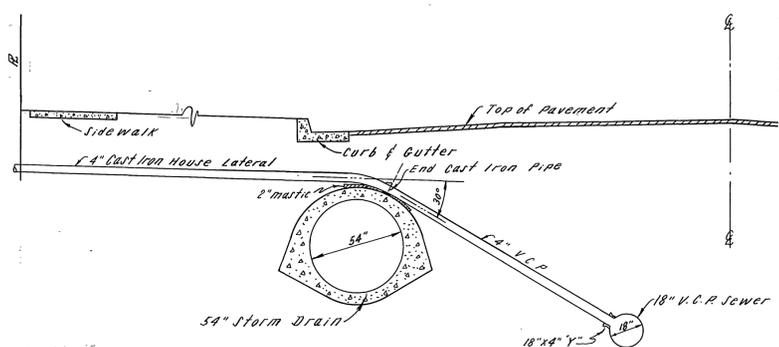

SCALE: 1" = 4'
TYPICAL HOUSE LATERALS
WASHINGTON STREET

L. FREDERICK PACK
 RE. 7448
 COVINA, CALIFORNIA
 APPROVED BY *L. Frederick Pack* DATE 12-3-58

CITY OF RIVERSIDE, CALIFORNIA
 DEPARTMENT OF PUBLIC WORKS
SEWER PLAN & PROFILE
PLAZA HOMES


WASHINGTON STREET 0+00 - 5+56.55'

HOR. SCALE 1" = 40' VERT. SCALE 1" = 4'

APPROVED BY *L. Frederick Pack*
 DIRECTOR OF PUBLIC WORKS
 DATE 12-17-58



NO. **S-155**
 SHEET 2 OF 4

Handwritten notes and calculations:
 201.20
 100.00
 101.20
 102.20
 103.20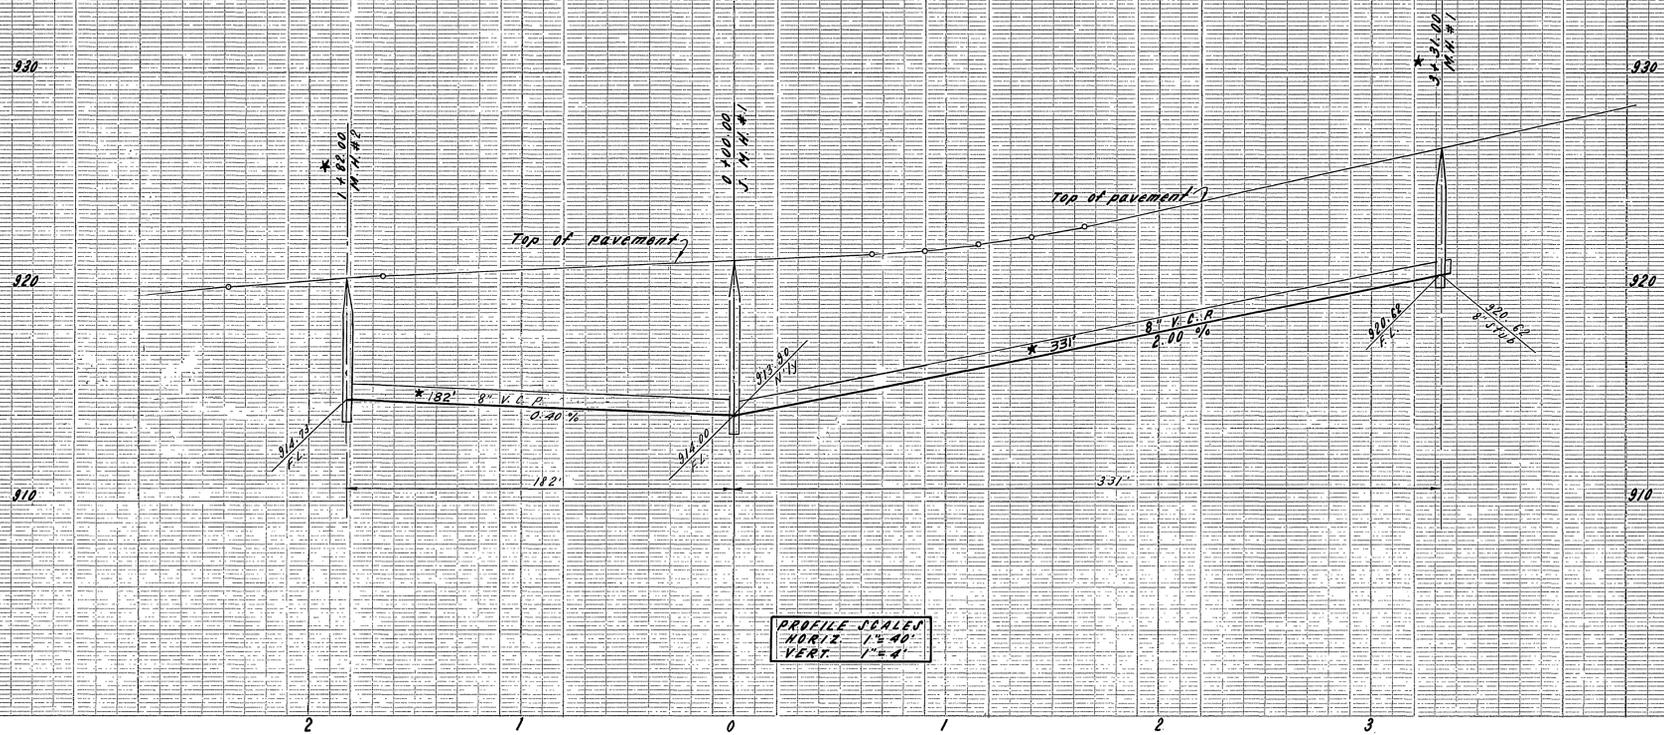
PROFILE SCALE
 HORIZ. 1" = 40'
 VERT. 1" = 4'

BENCHMARK:
 RR SPIKE IN PALM TREE
 NW CORNER LINCOLN &
 WASHINGTON 914.36

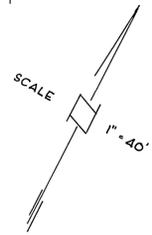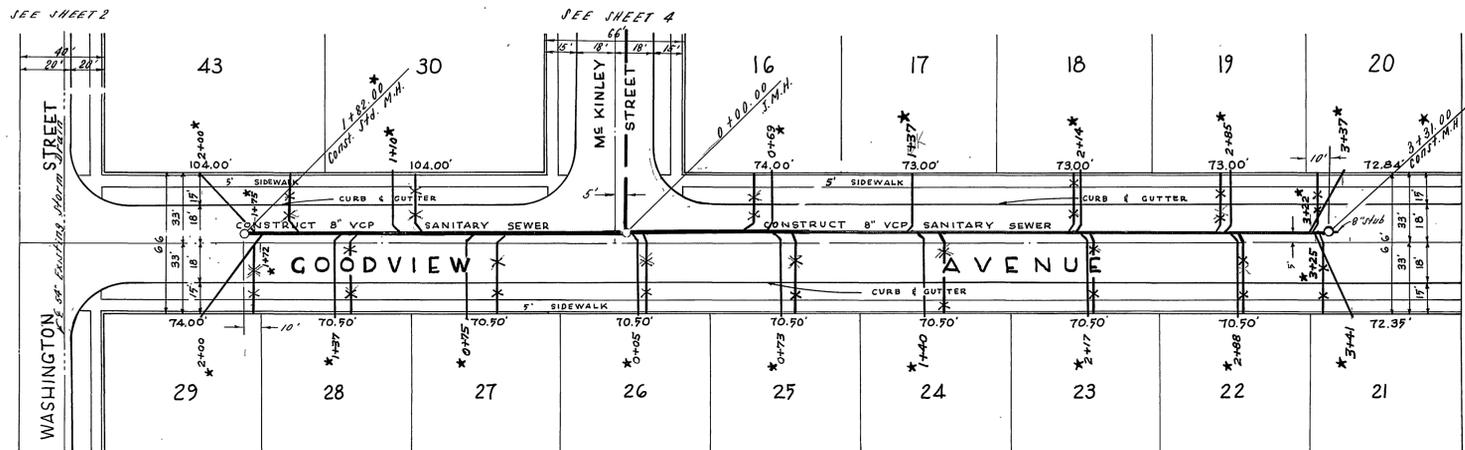

△ HOUSE CONNECTIONS
 TO BE LOCATED IN FIELD
 M.H.'s to be const. as per C/P
 Std. Drawing No. 500.

L. FREDERICK PACK
 R.E. 7448
 COVINA, CALIFORNIA

APPROVED BY *[Signature]* DATE 12-3-58

CITY OF RIVERSIDE, CALIFORNIA
 DEPARTMENT OF PUBLIC WORKS

SEWER PLAN & PROFILE
 PLAZA HOMES

GOODVIEW AVENUE 0+00 - 6+12.00'

HOR. SCALE 1" = 40' VERT. SCALE 1" = 4'


APPROVED BY *[Signature]*
 DIRECTOR OF PUBLIC WORKS

DATE Dec 17, 1958

NO. S-155



SHEET 2 OF 4

* "As Built", 3-6-59, 11.8.61

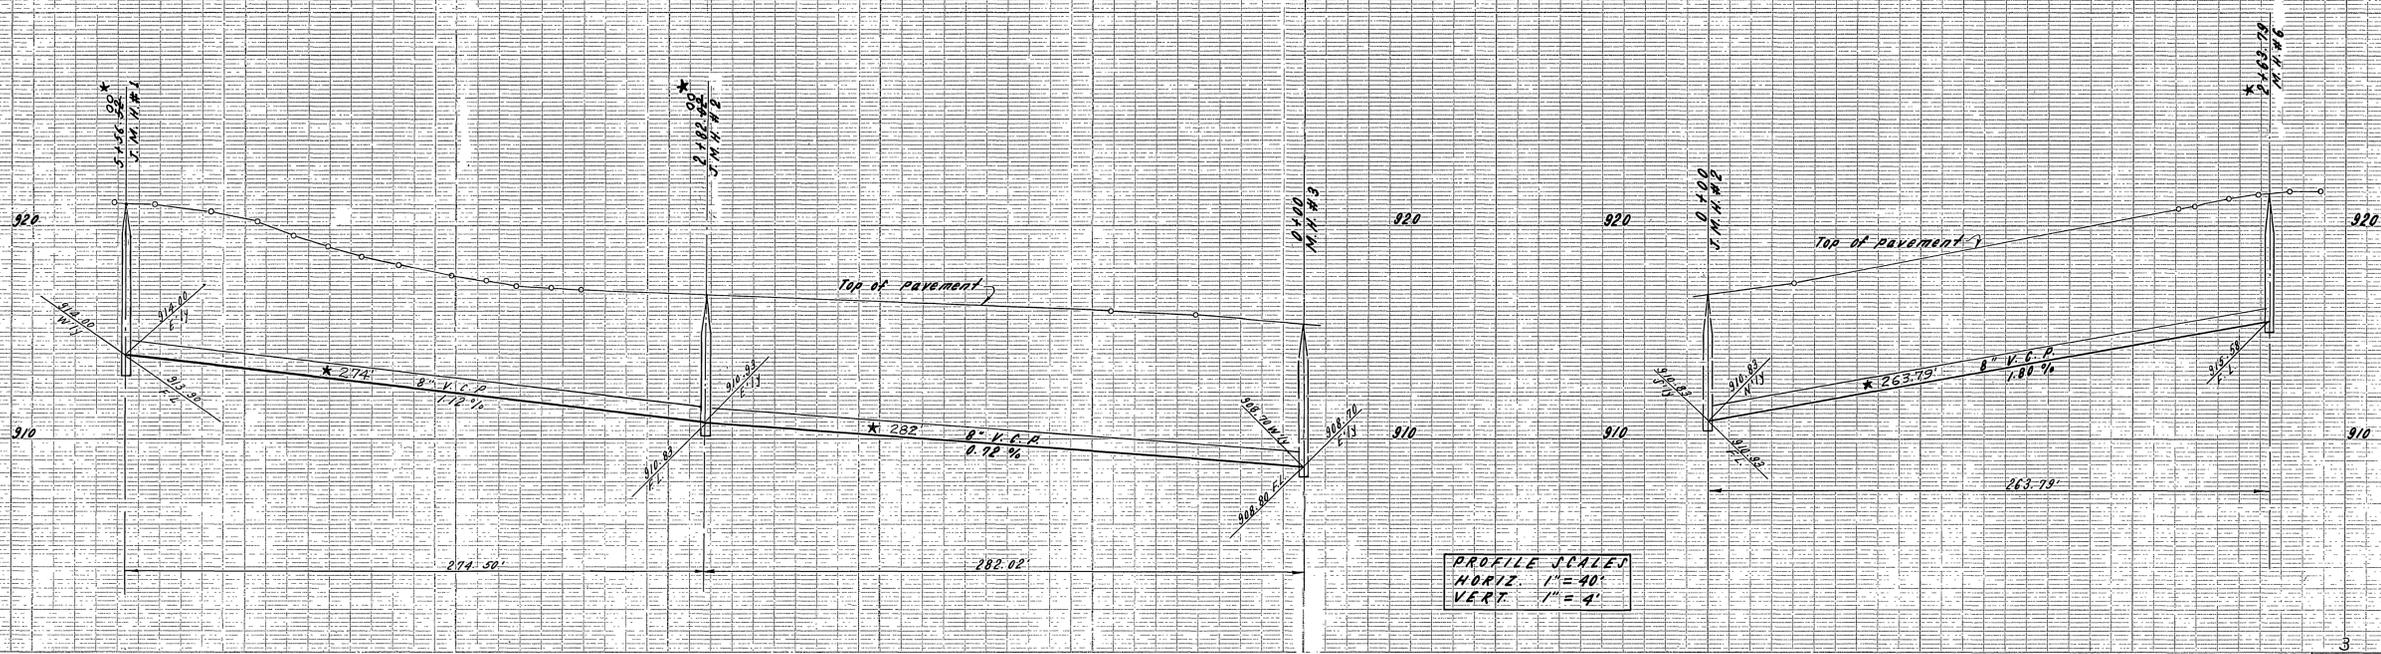

PROFILE SCALES
 HORIZ. 1" = 40'
 VERT. 1" = 4'

BENCHMARK
 RR SPIKE IN PALM TREE
 NW CORNER LINCOLN &
 WASHINGTON 914.36'

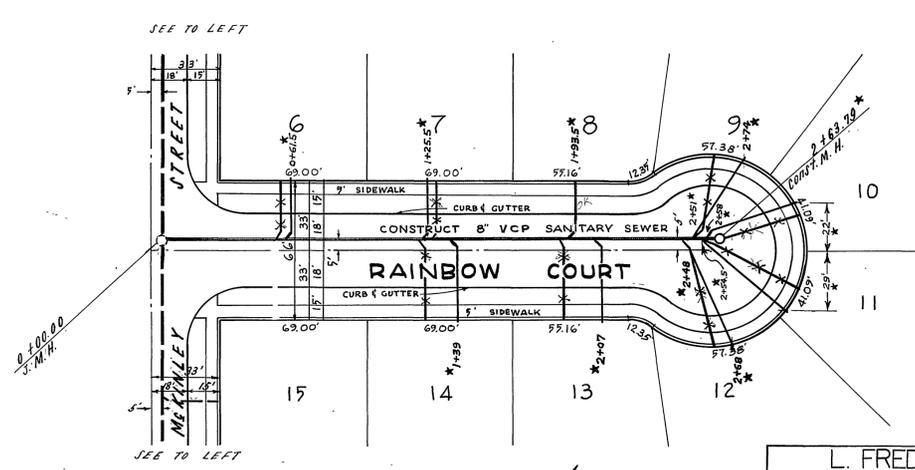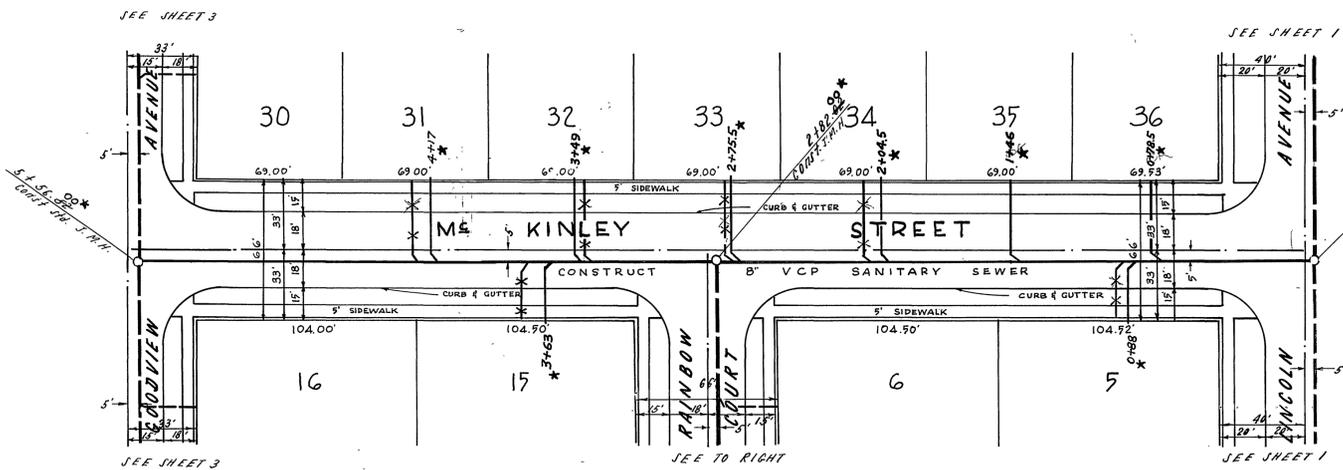

4" HOUSE CONNECTIONS
 TO BE LOCATED IN FIELD
 M.H.'s to be const. as per C/R
 Std. Drawing No. 500.

4" HOUSE CONNECTIONS
 TO BE LOCATED IN FIELD

L. FREDERICK PACK
 RE. 7448
 COVINA, CALIFORNIA
 APPROVED BY *[Signature]* DATE 12-3-58
 CITY OF RIVERSIDE, CALIFORNIA
 DEPARTMENT OF PUBLIC WORKS
 SEWER PLAN & PROFILE
 PLAZA HOMES
 M^c KINLEY STREET 0+00 - 4+00.53'
 RAINBOW COURT 0+00 - 2+63.79'
 HOR. SCALE 1" = 40' VERT. SCALE 1" = 4'
 APPROVED BY *[Signature]*
 DIRECTOR OF PUBLIC WORKS
 DATE Dec 17, 1958
 NO. S-155
 SHEET 4 OF 4

As Built 3-6-59, H.Ball

1907