
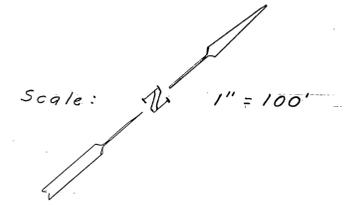


(SEE NOTES)

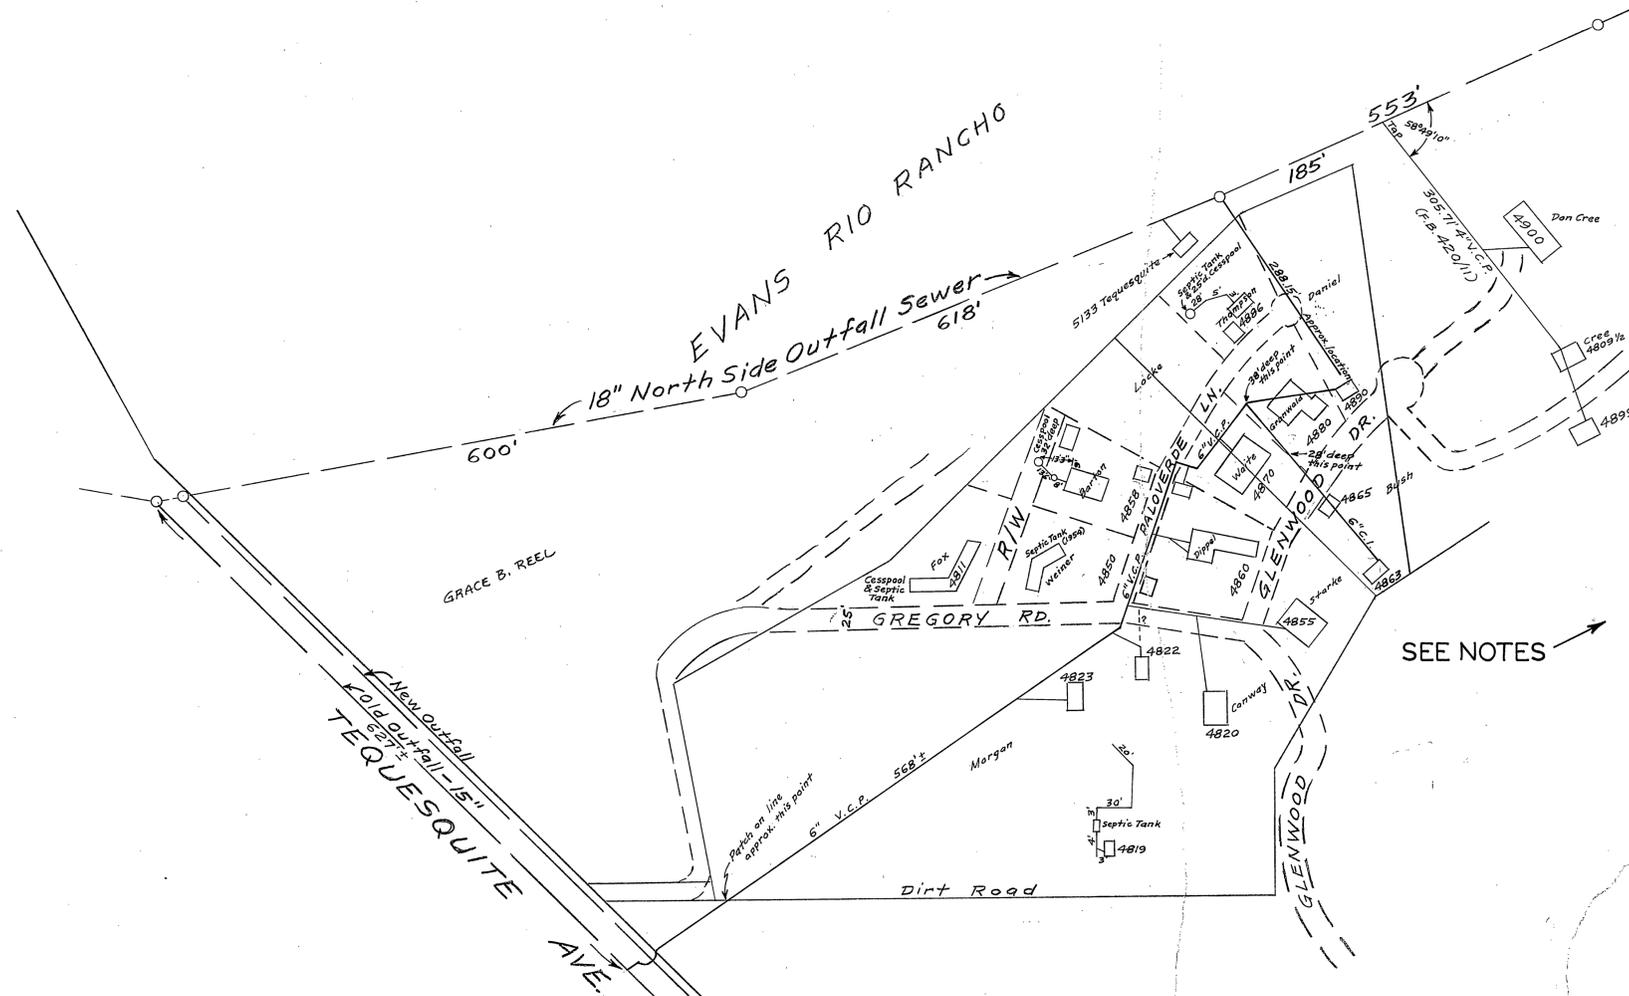

NOTES:
 (THIS DRAWING TRACED FROM SKETCH OBTAINED FROM J.F. SMITH, 7-3-62, H. Ball.)
 INFORMATION COMPILED IS APPROX. EXCEPT WHERE NOTED.
 ALL LINES (EXCEPT OUTFALLS) ARE PRIVATE LINES. CITY HAS
 NO RIGHT-OF-WAY AND HAS NEVER ACCEPTED LINES IN THIS AREA.
 J.F. SMITH, 12-27-60
 ST. FOREMAN, SEWER DIV.
 PUBLIC SERVICE DEPT.

SEE NOTES

REVISIONS		CITY OF INVERSIDE, CALIFORNIA	
DATE	DESCRIPTION	DEPARTMENT OF PUBLIC WORKS	
		PRIVATE SEWER LINES	
		DE NYSE TRACT (UNRECORDED)	
TRACED H. Ball		S-326	