


PROFILE	DATE
NO. 1000	
DATE	

Scale: Horiz 1" = 50'  
 Vert 1" = 5'

B.M. Elev. 756.51  
 PK nail in curb 1' East of East End of curb return NE cor. Sherman & Garfield

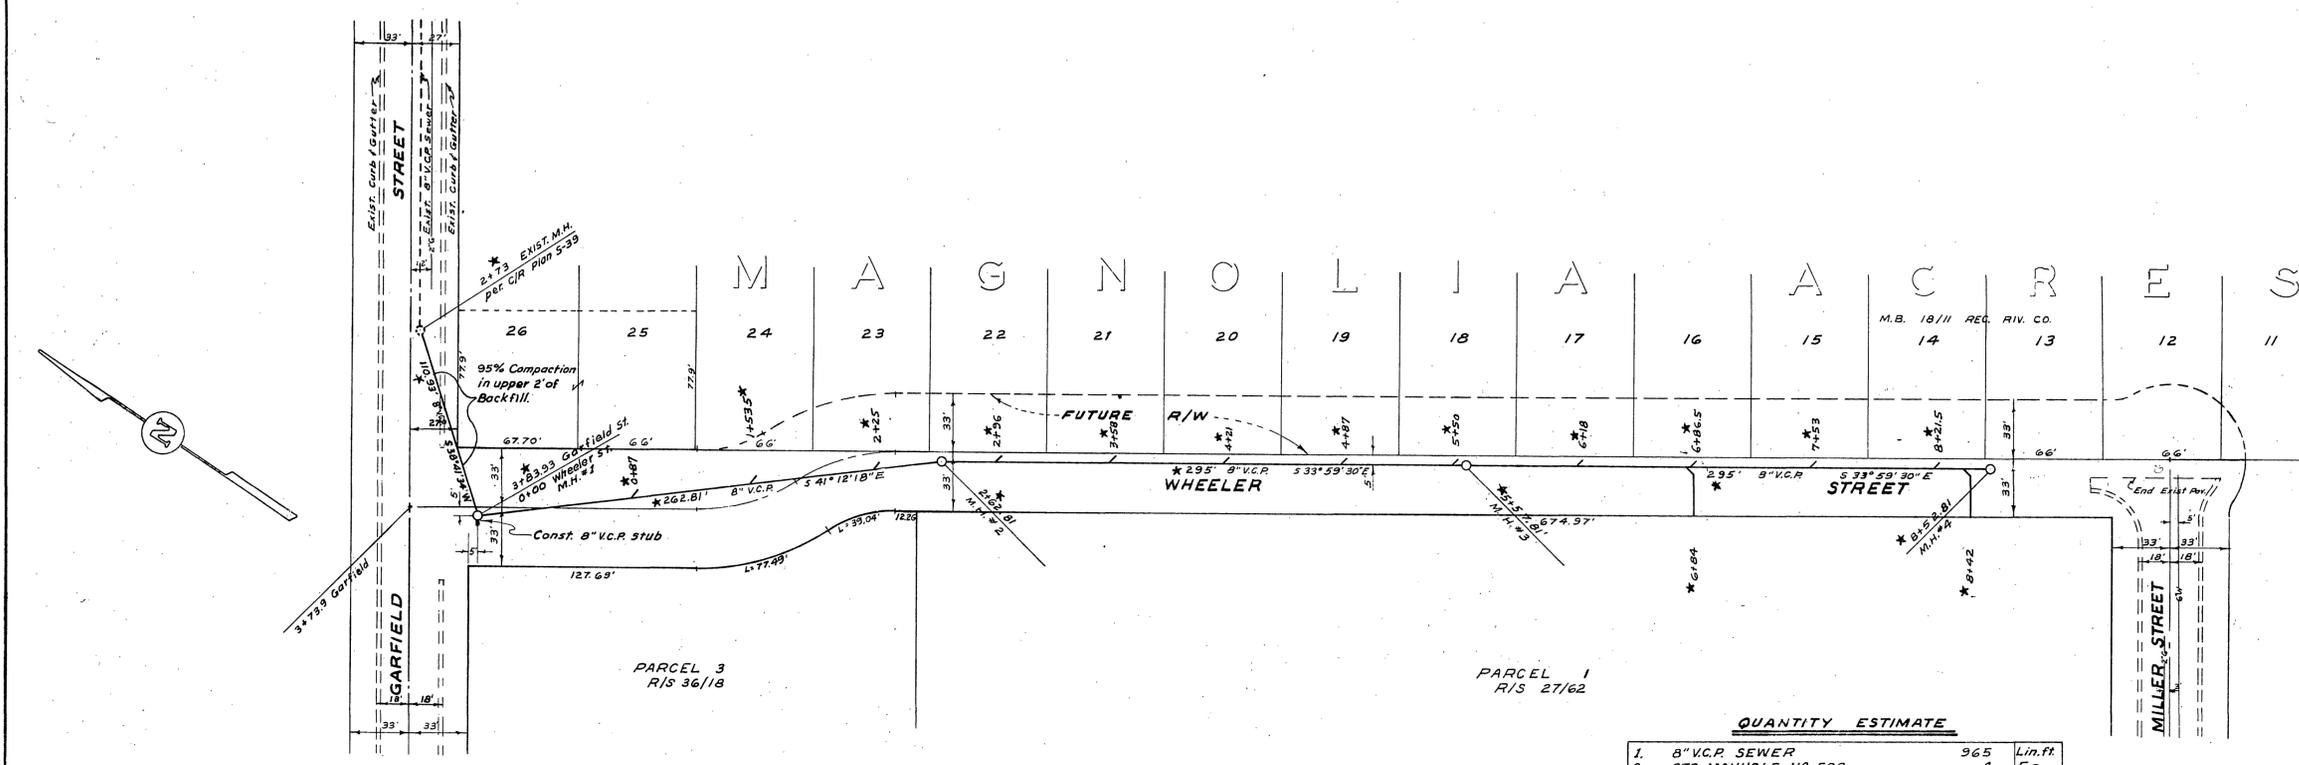

**GENERAL NOTES:**

1. It shall be the responsibility of the contractor to clear the right of way in accordance with provisions of law as it affects each utility including irrigation lines and appurtenances and at no cost to the City.
2. Construction shall be in accordance with the City of Riverside Department of Public Works Specifications No. 461 and Standard Drawings.
3. Location of house connection lateral & wyes to be determined in the field.
4. Pipe shall be bedded Case II Standard Drawing No. 452.

PLAN	DATE
NO. 1000	
DATE	

PARCEL 3  
 R/S 36/18

PARCEL 1  
 R/S 27/62

**QUANTITY ESTIMATE**

1. 8" V.C.P. SEWER	965	Lin. Ft.
2. STD. MANHOLE NO. 500	4	Ea.
3. PAVEMENT REPLACEMENT	120	Sq. Ft.
4. 4" V.C.P. LATERAL	56	Lin. Ft.
5. WYES	14	Ea.

REVISION	
MARK	DESCRIPTION
*	2-1-63 "As Built" H. Ball

**ALBERT A. WEBB ASSOCIATES**  
 CIVIL ENGINEERS - RIVERSIDE, CALIFORNIA  
 APPROVED: *Albert A. Webb* DATE 6/1/62

**CITY OF RIVERSIDE, CALIFORNIA**  
 DEPARTMENT OF PUBLIC WORKS

SEWER PLAN & PROFILE  
 WHEELER STREET  
 GARFIELD ST. TO MILLER ST.

DATE	May 1962	SCALE	1" = 50'
DRAWN	B.E.L.	NO.	62-136
CHECKED	W.C.S.	DATE	7-11-62

APPROVED BY: *W.C.S.*  
 DIRECTOR OF PUBLIC WORKS  
 SHEET 1 OF 1