


scale: HORIZ 1" = 20'
 VERT 1" = 5'

| PROFILE | |
|---------|------|
| NO. | DATE |
| BY | |
| CHECKED | |
| DATE | |

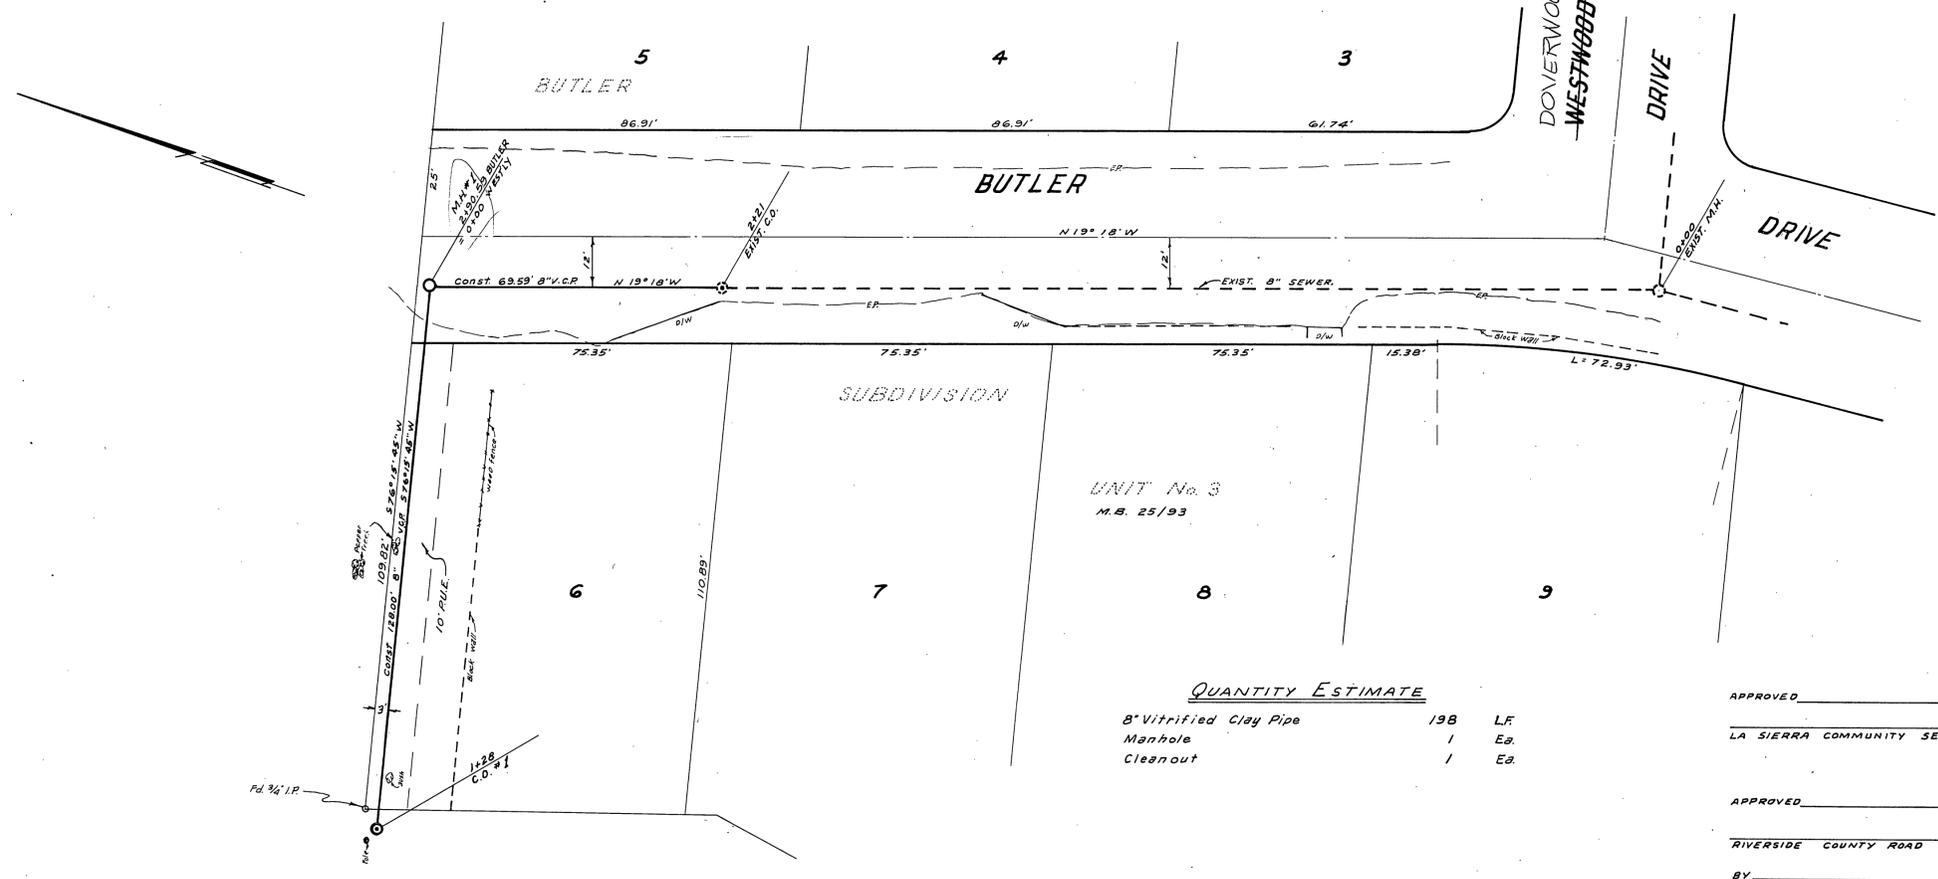

- GENERAL NOTES:**
1. Manhole frames and covers to be set to existing paving grades unless elevation is given in profile.
 2. It shall be the responsibility of the Contractor to apply to the County of Riverside Road Dept. Permit Section for an encroachment permit for all work adjoining existing County maintained road.
 3. **NOTE TO CONTRACTOR:** The existence and location of any underground utility pipes or structures shown on this plan are obtained by a search of the available records. To the best of our knowledge there are no existing utilities except as shown on these plans. The Contractor is required to take due precautionary measures to protect the utility lines shown and any other lines not of record or not shown on these plans.
 4. Prior to the construction of sewer, Contractor is to excavate and contact Engineer for verification of elevation of existing 8" sewer at existing Cleanout. This elevation to be determined before cut sheets are issued for this project.

QUANTITY ESTIMATE

| | | |
|------------------------|-----|-----|
| 8" Vitrified Clay Pipe | 198 | LF |
| Manhole | 1 | EA. |
| Cleanout | 1 | EA. |

APPROVED _____, 19____
 LA SIERRA COMMUNITY SERVICES DISTRICT

APPROVED _____, 19____
 RIVERSIDE COUNTY ROAD COMMISSIONER

BY _____ DEPUTY

| | | |
|---------------------------------------|----------------|------------------|
| REVISIONS | DATE | BY |
| LA SIERRA COMMUNITY SERVICES DISTRICT | | |
| SEWER PLAN AND PROFILE | | |
| BUTLER DRIVE | | |
| SCALE 1" = 20' | DATE Apr. 1963 | W.O. G2-GG |
| DRAWN B.E.L. | CHECKED | SHEET 1 |
| TRACED | BY | OF 1 SHEETS |
| CHECKED | BY | DWG. NO. G2-GG-B |
| F.B. | BY | |

| PLAN | |
|---------|------|
| NO. | DATE |
| BY | |
| CHECKED | |
| DATE | |