


B.M. ELEV. 824.46 IRON BAR IN CONC. SIDEWALK ON ELY LINE MAGNOLIA 30' N'LY OF ORIG  $\epsilon$  CENTRAL AVENUE.  
 F.B. M/69-72

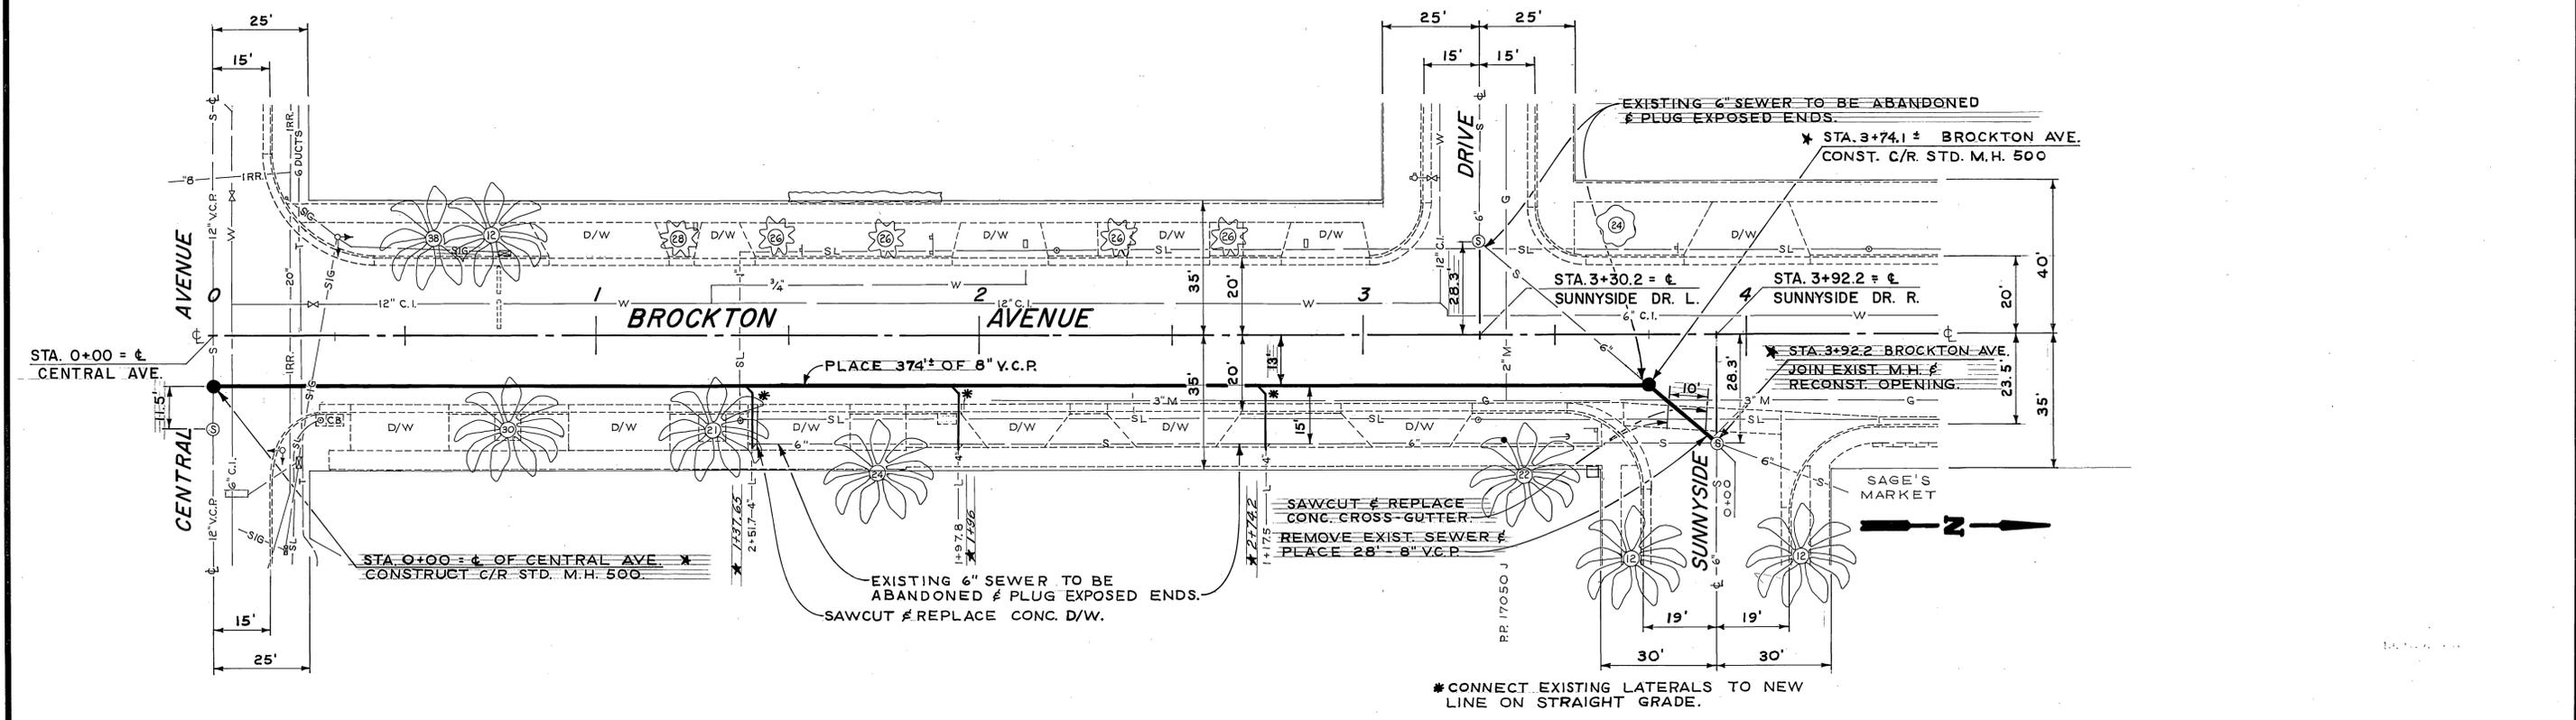

\* AS BUILT 3/23/66

CITY OF RIVERSIDE, CALIFORNIA DEPARTMENT OF PUBLIC WORKS		BROCKTON SEWER AT SAGE'S		PROJECT NO. 5086
APPROVED BY OFFICE ENGINEER PARK DEPARTMENT	BY DATE	APPROVED BY DIRECTOR OF PUBLIC WORKS	S-635	
TRAFFIC DIVISION	DATE	DATE	SHEET 1 OF 1	
DESIGNED BY	DRAWN BY	CHECKED BY	FILE NO.	

HORIZ. SCALE: 1" = 20' VERT. SCALE: 1" = 2'