

HARRISON DAM OUTLET

CONSTRUCTION DRAWINGS


BY

RIVERSIDE COUNTY FLOOD CONTROL
AND

WATER CONSERVATION DISTRICT

GENERAL NOTES

1. Reinforced concrete shall be Class A (6 sack) and shall have a minimum of 3,000 p.s.i. 28 day compressive strength.
2. Reinforced steel shall be deformed, intermediate grade, billet-steel bars conforming to the specifications of A.S.T.M. Designation A-15, latest revised, with deformations conforming to A.S.T.M. Designation A-305.
3. All reinforcing bar bends and hooks shall conform to the American Concrete Institute "MANUAL OF STANDARD PRACTICE" (ACI 315-57).
4. Lap all reinforcing steel a minimum of 30 bar diameters at splices. The location of all splices shall be subject to approval of the Engineer.
5. All reinforcing steel shall have a minimum cover of $1\frac{1}{2}$ " unless otherwise noted.
6. All exposed edges of concrete structures shall be chamfered $\frac{3}{4}$ " or rounded as directed.
7. Unreinforced concrete channel lining shall be Class B (5 sack), unless otherwise specified.
8. All concrete thickness dimensions are the minimum allowable.
9. The concrete pipe shall be placed in conformance with the case II bedding requirements; the pipe shall be reinforced concrete pipe of strength Class II (1000-D).
10. Transverse grooves 1" deep at 10' spacing shall be provided in all unreinforced concrete channel lining. Grooves shall be formed using $\frac{3}{16}$ " x 1" masonite strips.
11. All transverse construction joints in unreinforced concrete channel lining required at the end of a day's placing operation shall be located between the transverse grooves and No. 4x30" dowels at 24" spacing embedded 15" shall be provided.
12. Place $1\frac{1}{2}$ " dia. weep holes 6" above invert on 10' % Gravel filter material pocket of approximately one cu. ft. shall be placed behind each weep hole.
13. The weep hole filter material shall be Class I, Type B, as specified in paragraph 68-1.025 of the STANDARD SPECIFICATIONS.
14. The surface finish required for unreinforced concrete channel lining shall be a tight wood float finish. See Special Provisions.
15. For Right of Way data refer to Record of Survey Book 48 pages 50 and 51

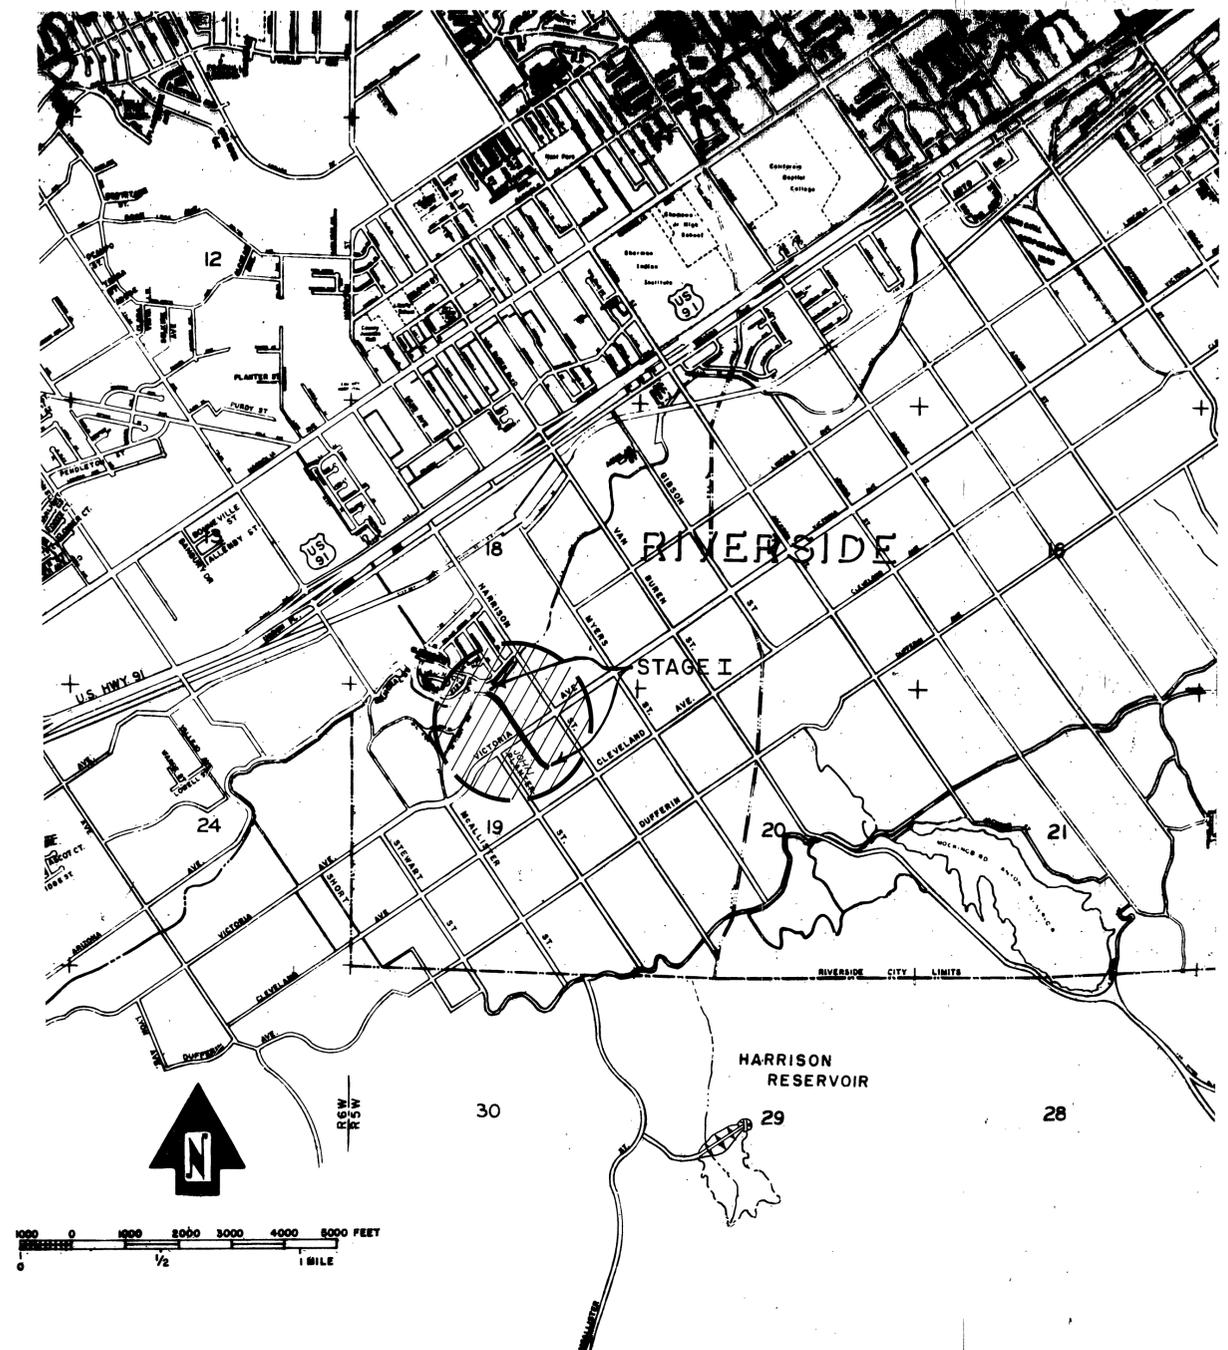

PROJECT NO. 1-0-200



RIVERSIDE COUNTY FLOOD CONTROL
AND
WATER CONSERVATION DISTRICT

HARRISON DAM OUTLET
STAGE I

APPROVED: <i>[Signature]</i>	DRAWN BY: Ken Blodeau	SHEET NO. 1 of 19
CHIEF ENGINEER R.E. NO. 2022	CHECKED BY:	DR. NO. 1-211
DATE:	DATE DRAWN:	

AS BUILT

D-158

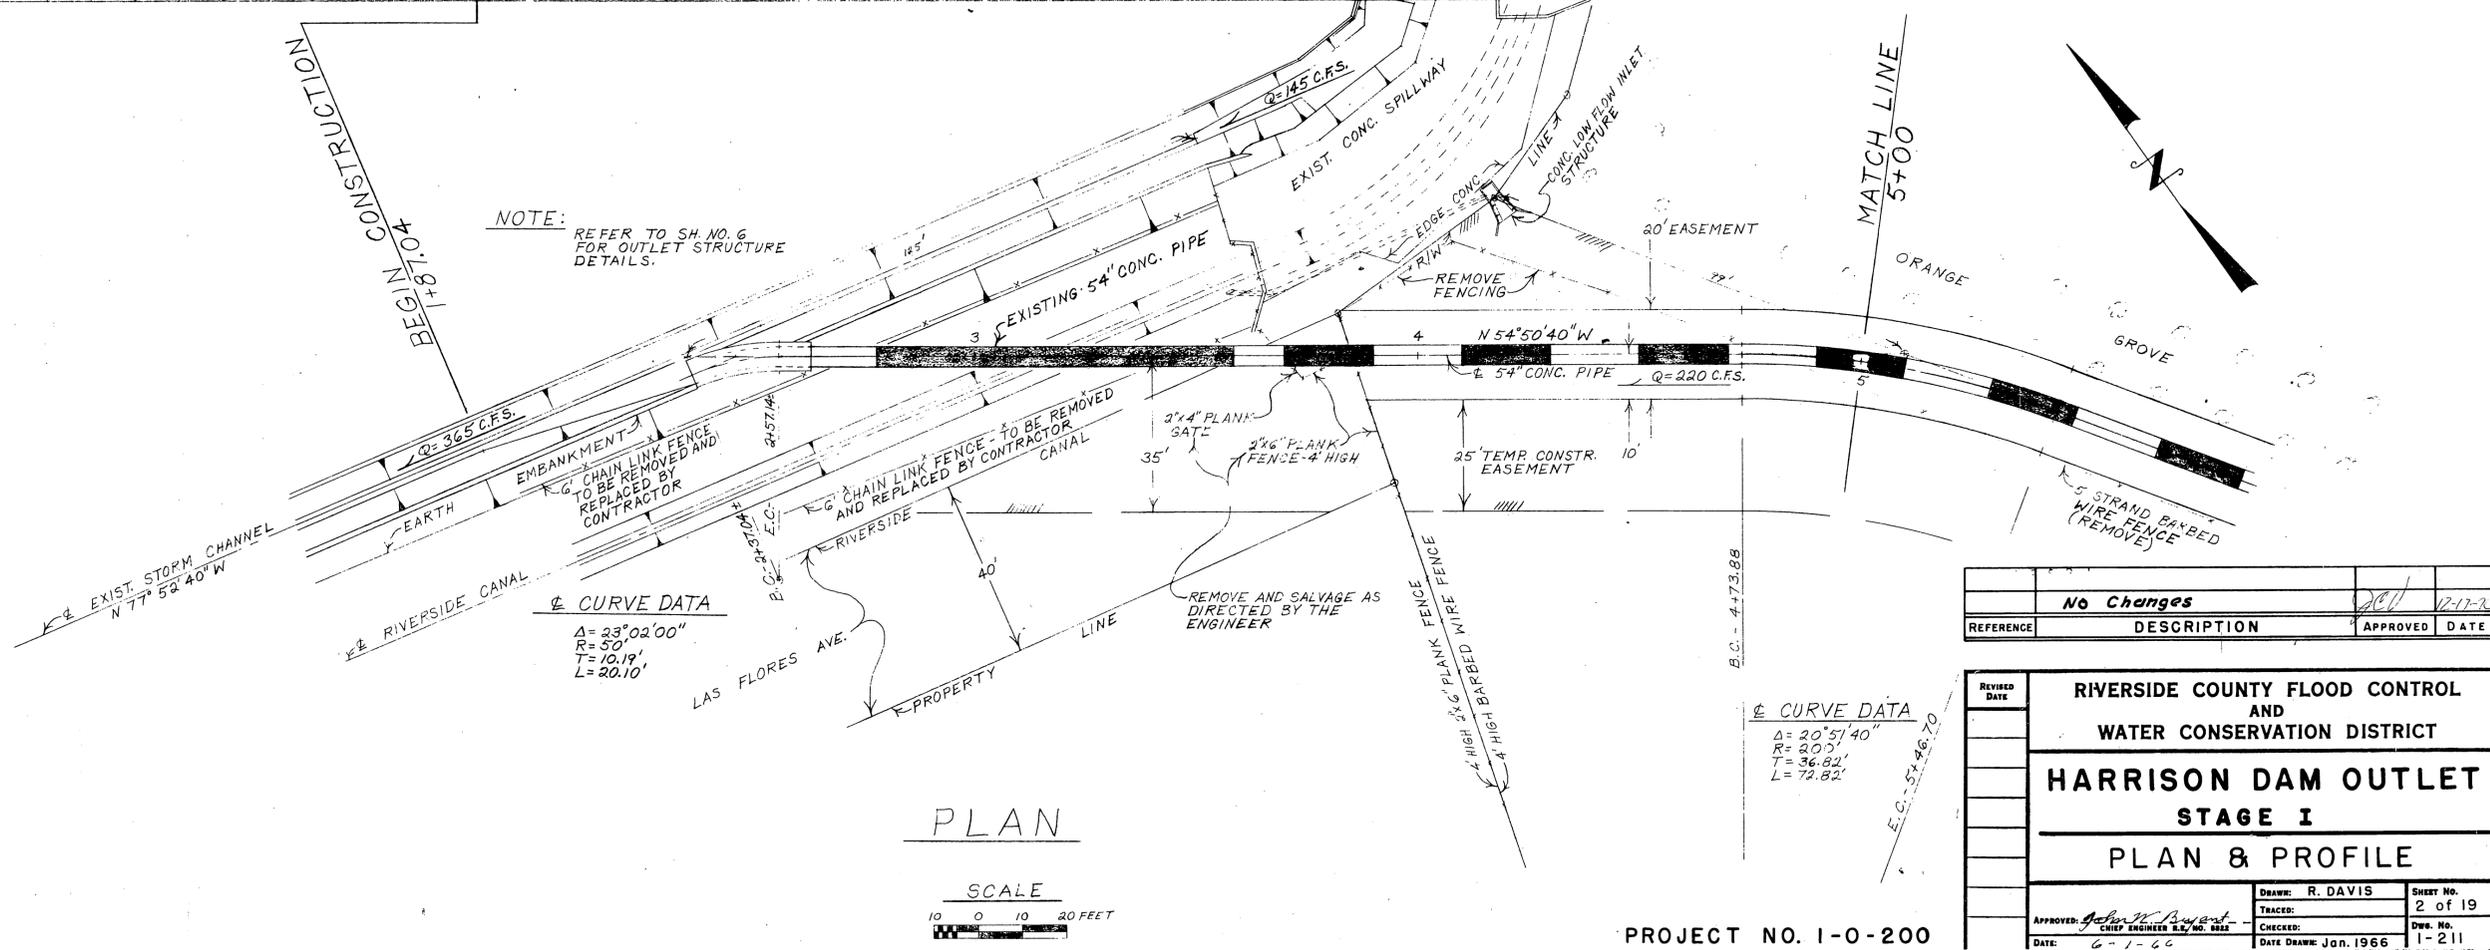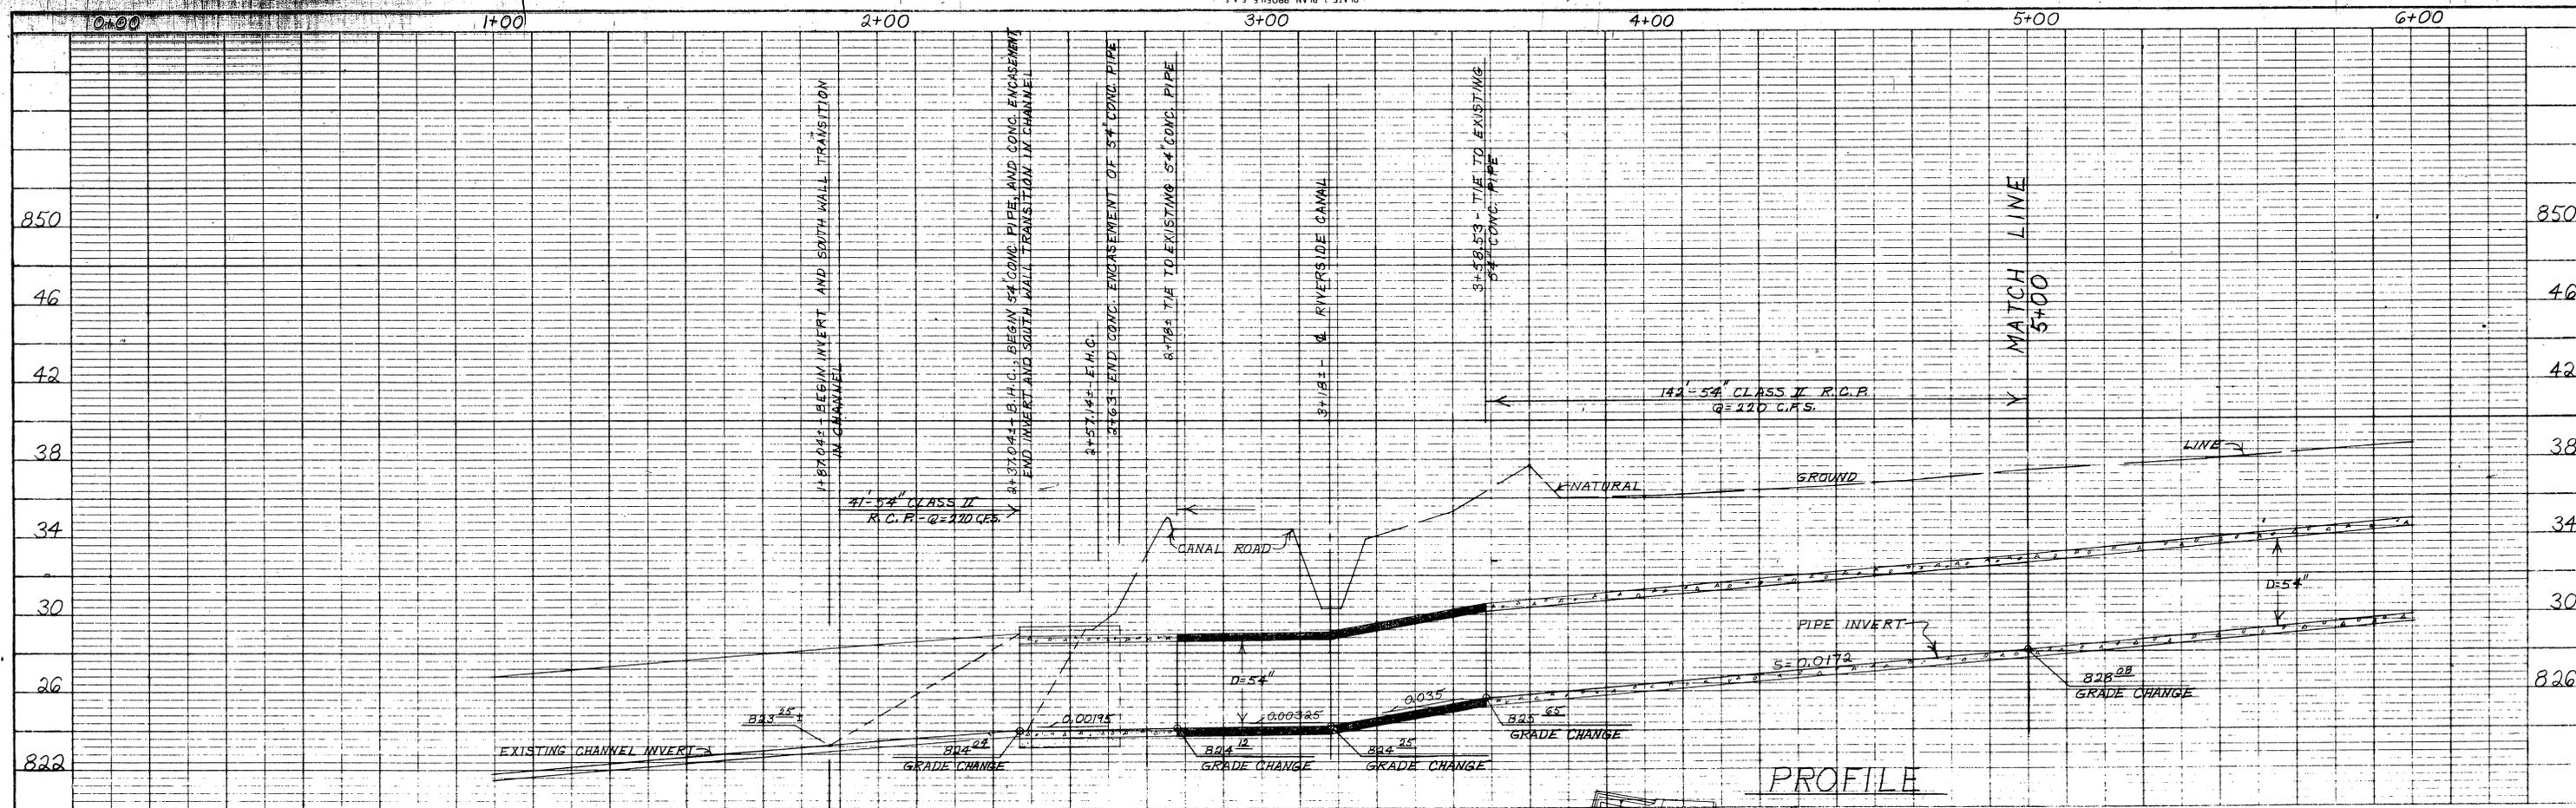

NOTE: REFER TO SH. NO. 6 FOR OUTLET STRUCTURE DETAILS.

△ = 23°02'00"
 R = 50'
 T = 10.19'
 L = 20.10'

△ = 20°51'40"
 R = 200'
 T = 36.82'
 L = 72.82'

REVISION	DATE	DESCRIPTION	APPROVED	DATE
		No Changes		

RIVERSIDE COUNTY FLOOD CONTROL AND WATER CONSERVATION DISTRICT

HARRISON DAM OUTLET STAGE I



PLAN & PROFILE

DRAWN: R. DAVIS
 CHECKED: [Signature]
 DATE DRAWN: Jan. 1966

SHEET NO. 2 of 19
 DWG. NO. 1-211

PROJECT NO. 1-0-200
 AS BUILT

D-158

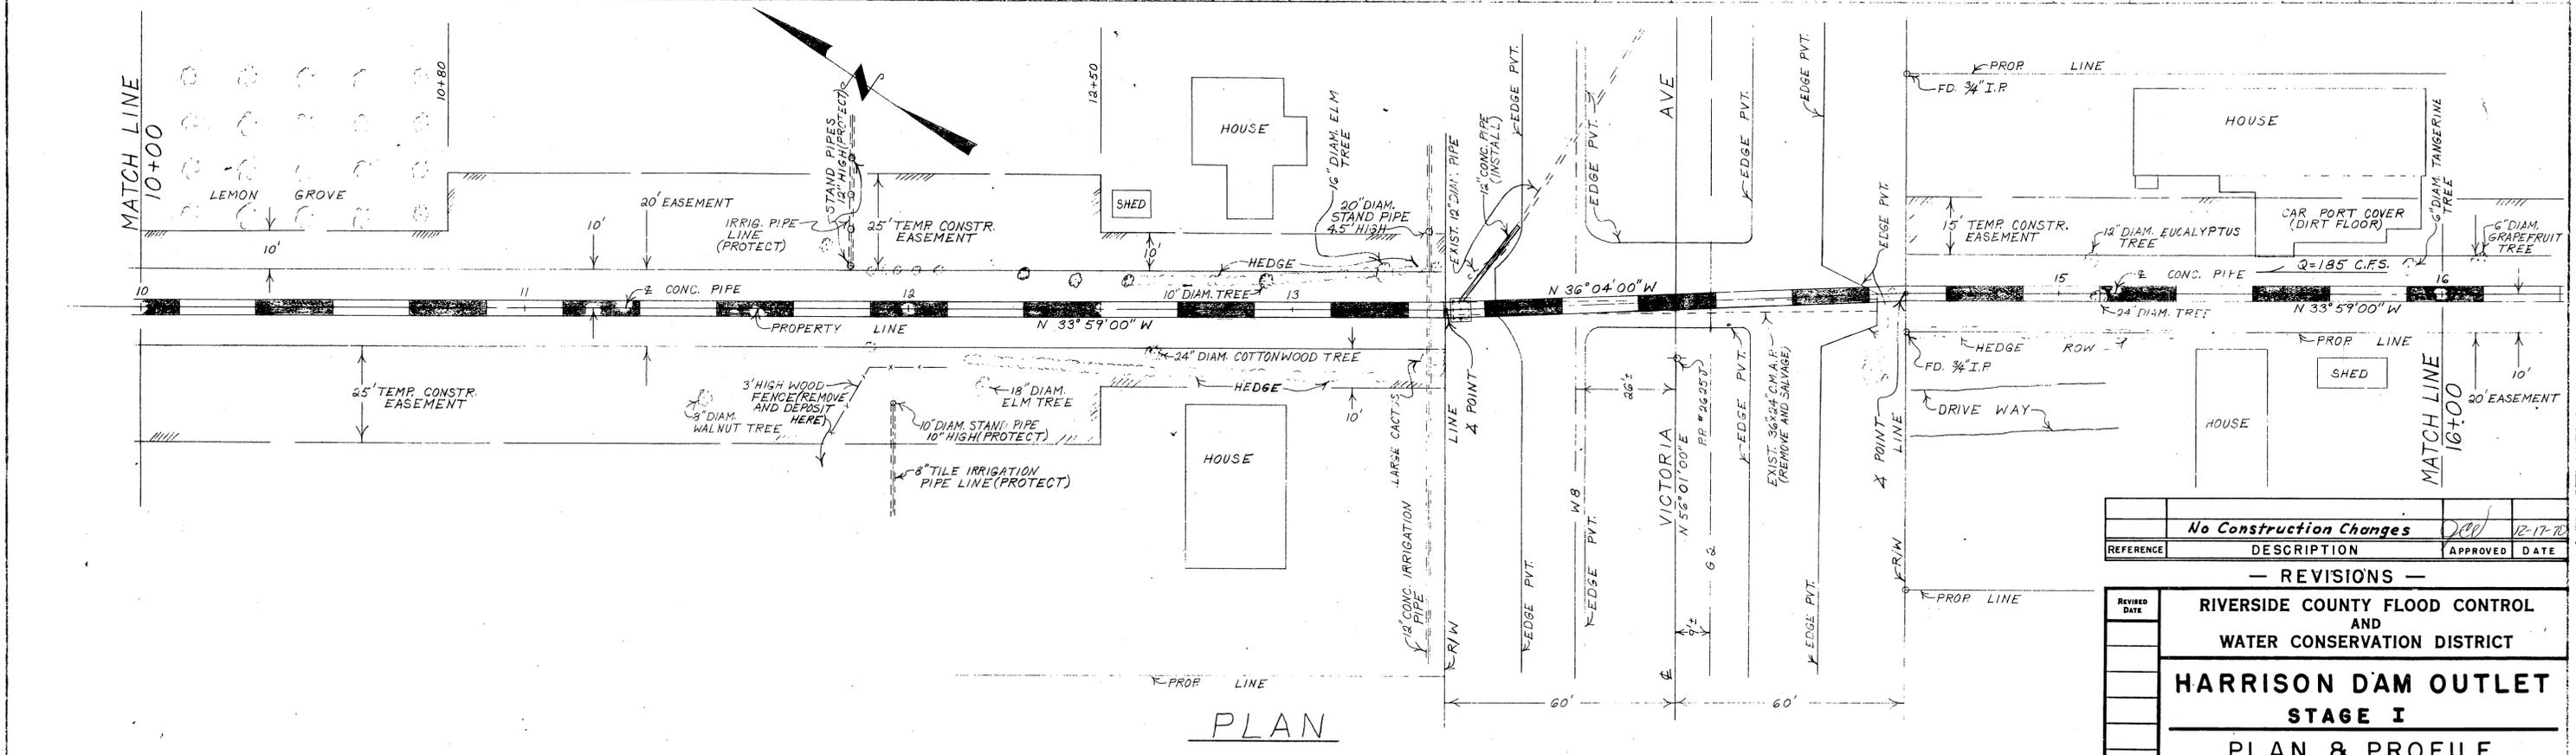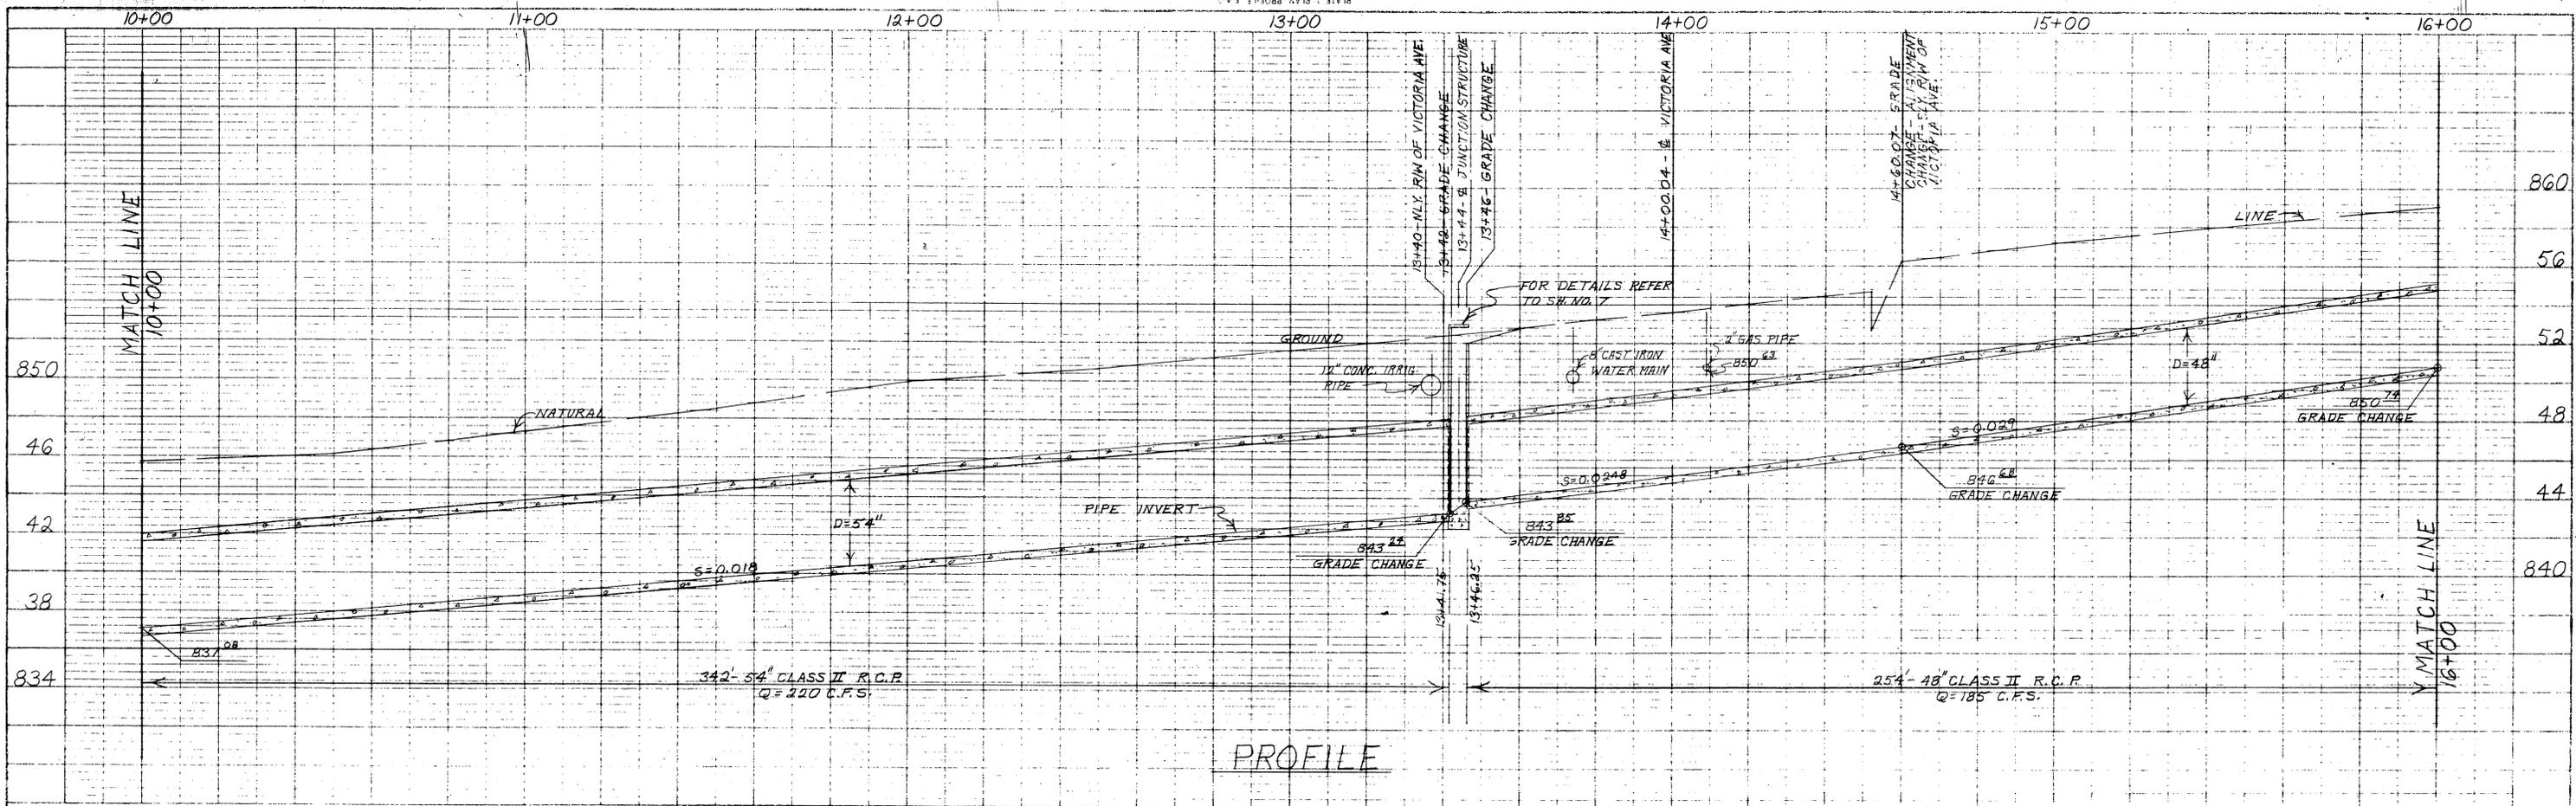

PLAN
SCALE
10 0 10 20 FEET

REFERENCE	DESCRIPTION	APPROVED	DATE
	No Construction Changes	<i>[Signature]</i>	12-17-70

— REVISIONS —



**RIVERSIDE COUNTY FLOOD CONTROL
AND
WATER CONSERVATION DISTRICT**

**HARRISON DAM OUTLET
STAGE I**

PLAN & PROFILE


APPROVED: <i>[Signature]</i> DATE: 6-1-66	CHIEF ENGINEER R.M. NO. 882	DRAWN: R. DAVIS	CHECKED:	SHEET No. 4 of 19
				DWG. No. 1-211
				DATE DRAWN: Jan. 1966

PROJECT NO. 1-0-200
AS BUILT

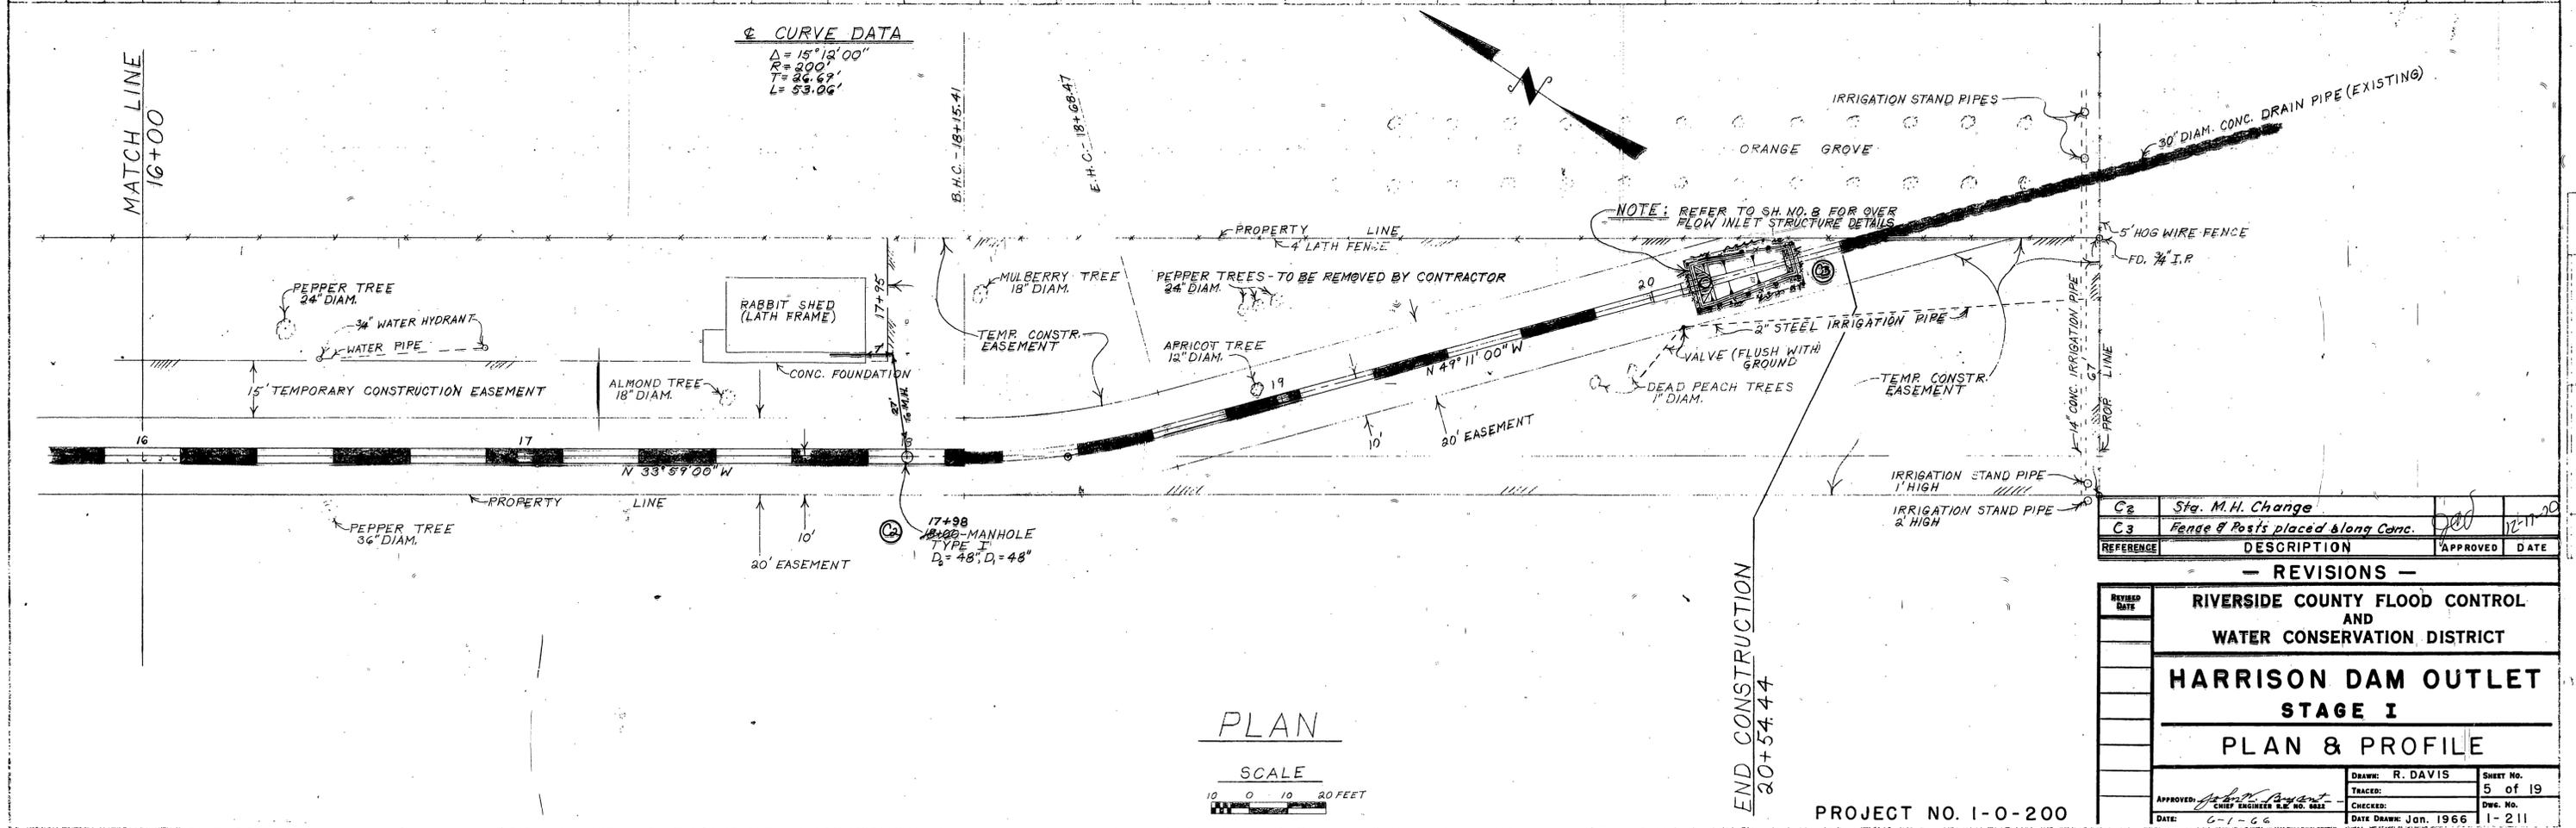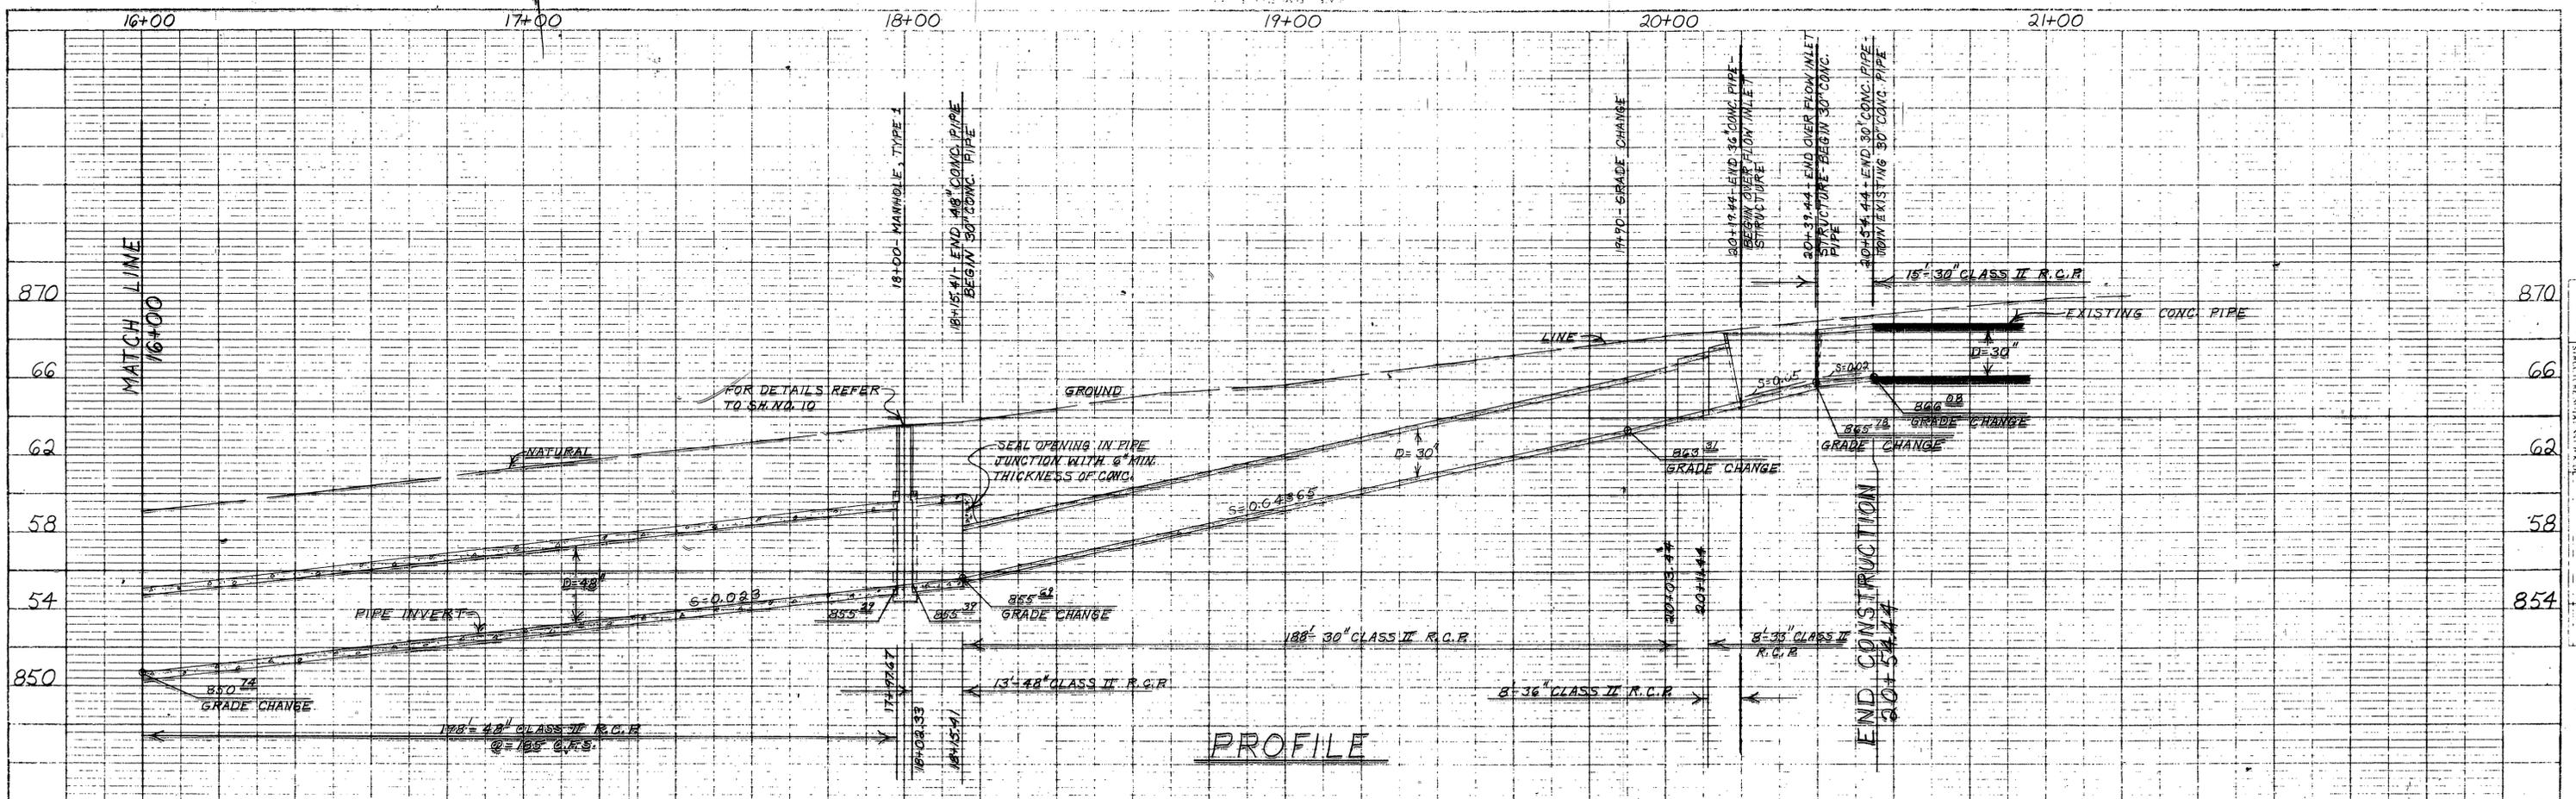

C2	Sta. M.H. Change		
C3	Fence & Posts placed along Conc.		
REFERENCE	DESCRIPTION	APPROVED	DATE
- REVISIONS -			
RIVERSIDE COUNTY FLOOD CONTROL AND WATER CONSERVATION DISTRICT			
HARRISON DAM OUTLET STAGE I			
PLAN & PROFILE			
APPROVED:	DATE:	DRAWN: R. DAVIS	SHEET No. 5 of 19
CHECKED:	DATE: 6-1-66	TRACED:	DWG. No. 1-211
DATE DRAWN: JAN. 1966		DATE DRAWN: JAN. 1966	

PROJECT NO. I-0-200
AS BUILT

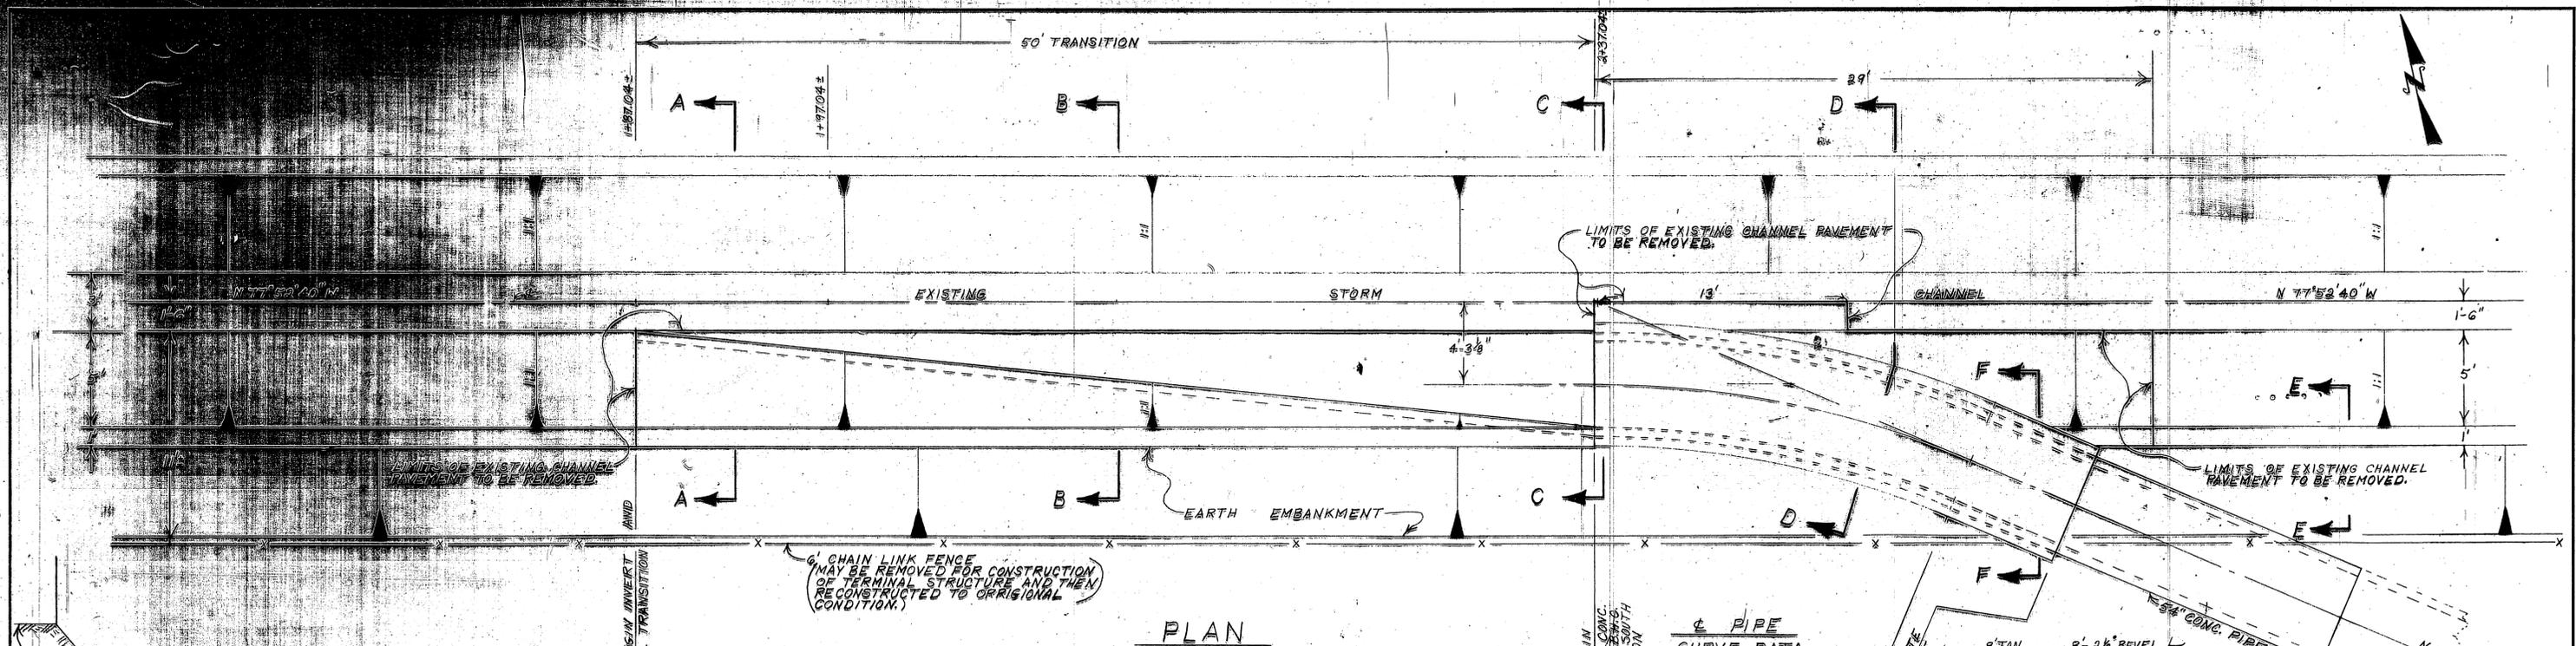


PLAN
2 1 0 1 2 3 4 FEET


PIPE CURVE DATA

Δ	33° 02' 00"
R	50'
L	10.19'
T	20.10'


PIPE PLACING DETAIL
2+370.4± TO 2+78

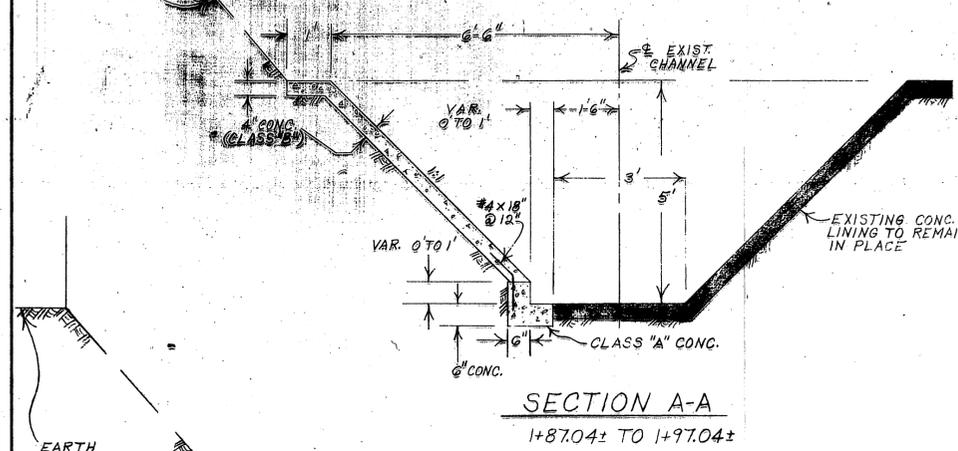

SECTION A-A
1+870.4± TO 1+970.4±

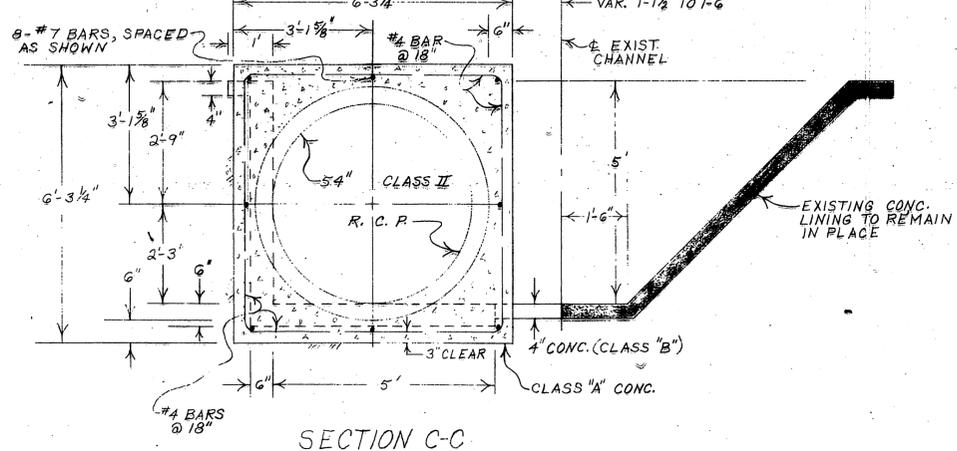


SECTION C-C
2+370.4± TO 2+430.2

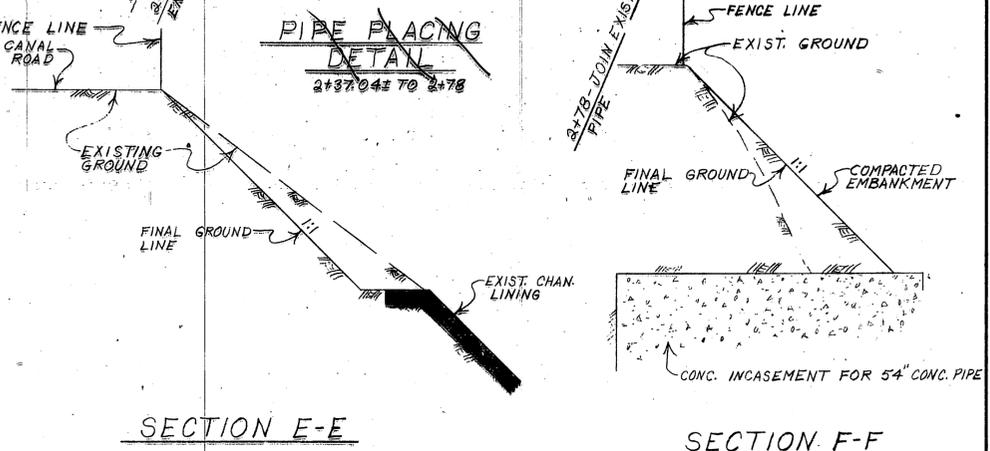


SECTION E-E

SECTION F-F

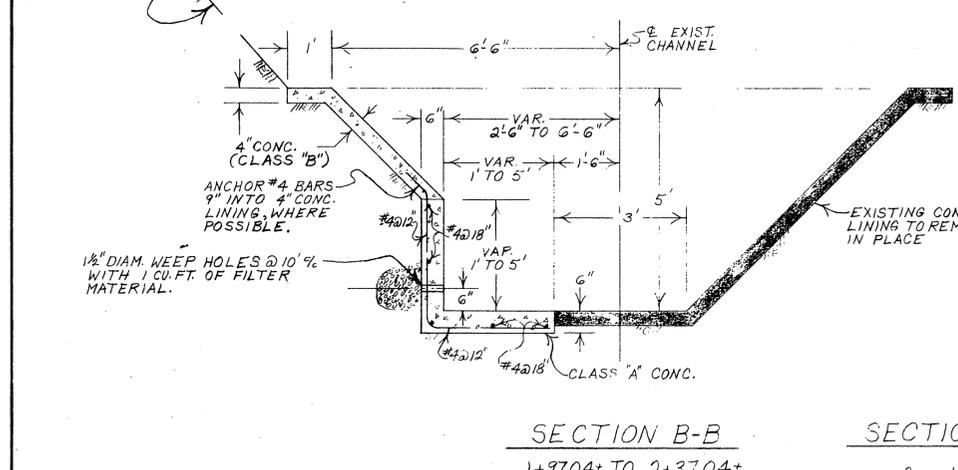

SECTION B-B
1+970.4± TO 2+370.4±

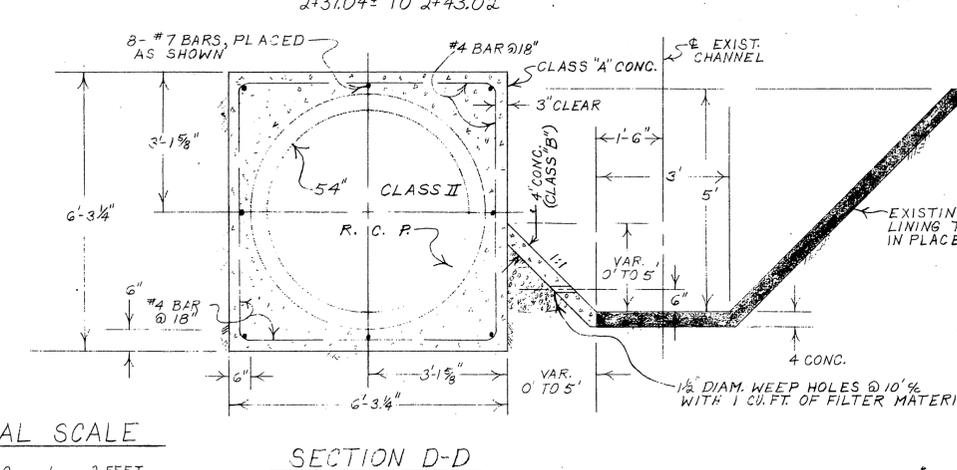


SECTION D-D
2+430.2 TO 2+597.3

SECTIONAL SCALE
2 1 0 3 FEET


REVISION	DESCRIPTION	APPROVED	DATE
1	No Construction Change	[Signature]	12-17-20
— REVISIONS —			
RIVERSIDE COUNTY FLOOD CONTROL AND WATER CONSERVATION DISTRICT			
HARRISON DAM OUTLET STAGE I			
OUTLET STRUCTURE			
APPROVED	DATE	DRAWN	SHEET No.
[Signature]	6-1-66	R. DAVIS	6 of 19
CHECKED	DATE DRAWN	DATE	DWG. No.
[Signature]	6-1-66	MARCH 1966	1-211

PROJECT NO. I-O-200
AS BUILT

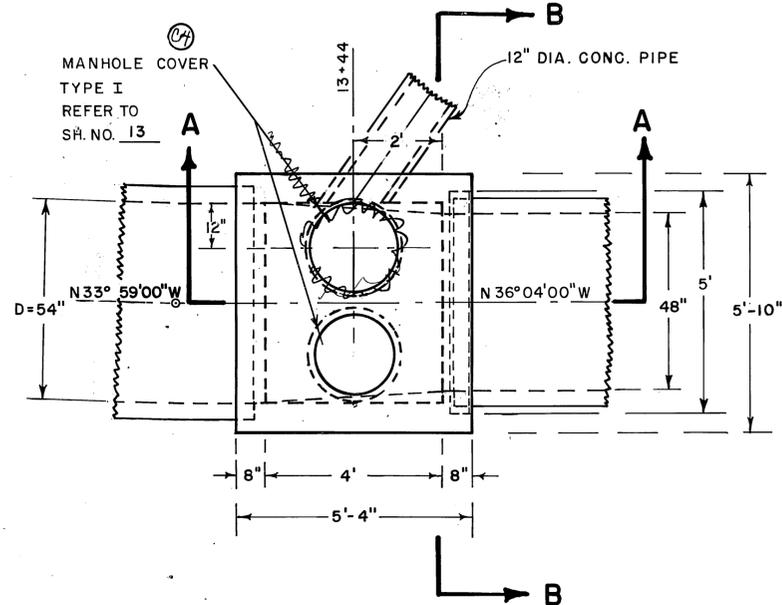


JUNCTION STRUCTURE PLAN

2 1 0 2 FEET

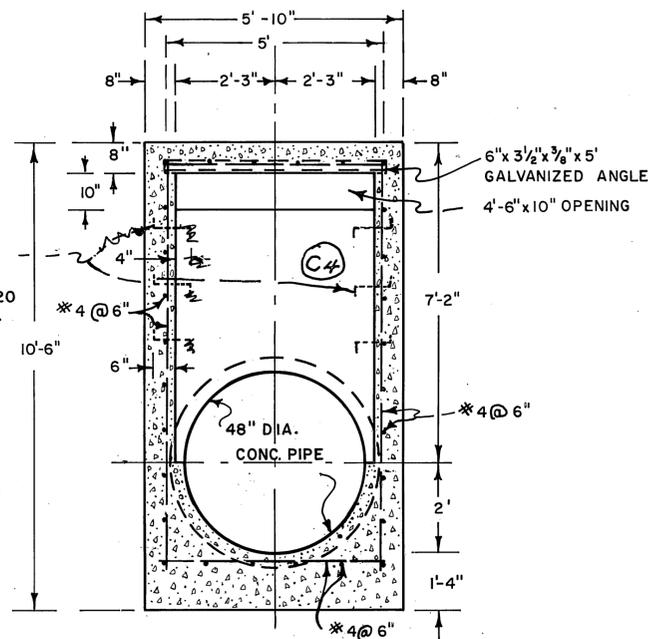


SECTION B-B

2 1 0 2 FEET

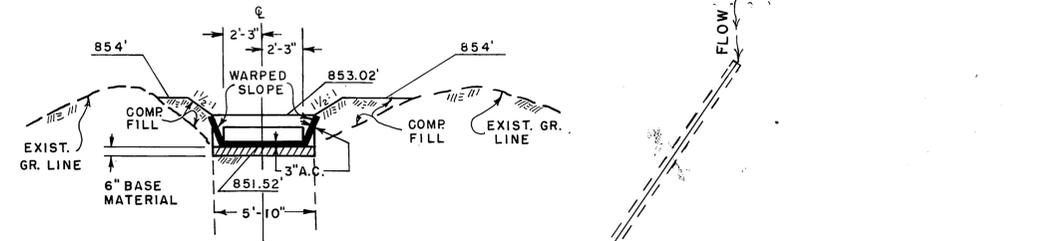


SECTION D-D

STA. 13+47
5 0 5 FT.

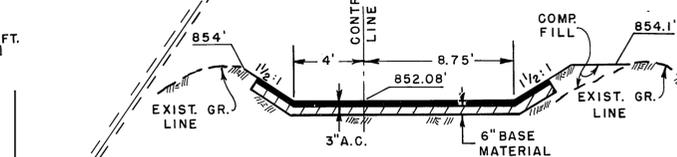


SECTION E-E

STA. 13+53
5 0 5 FT.

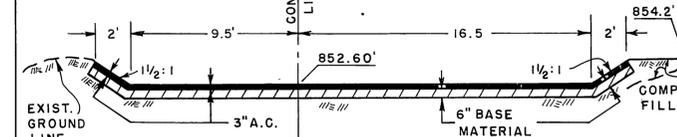


SECTION F-F

STA. 13+58
5 0 5 FT.

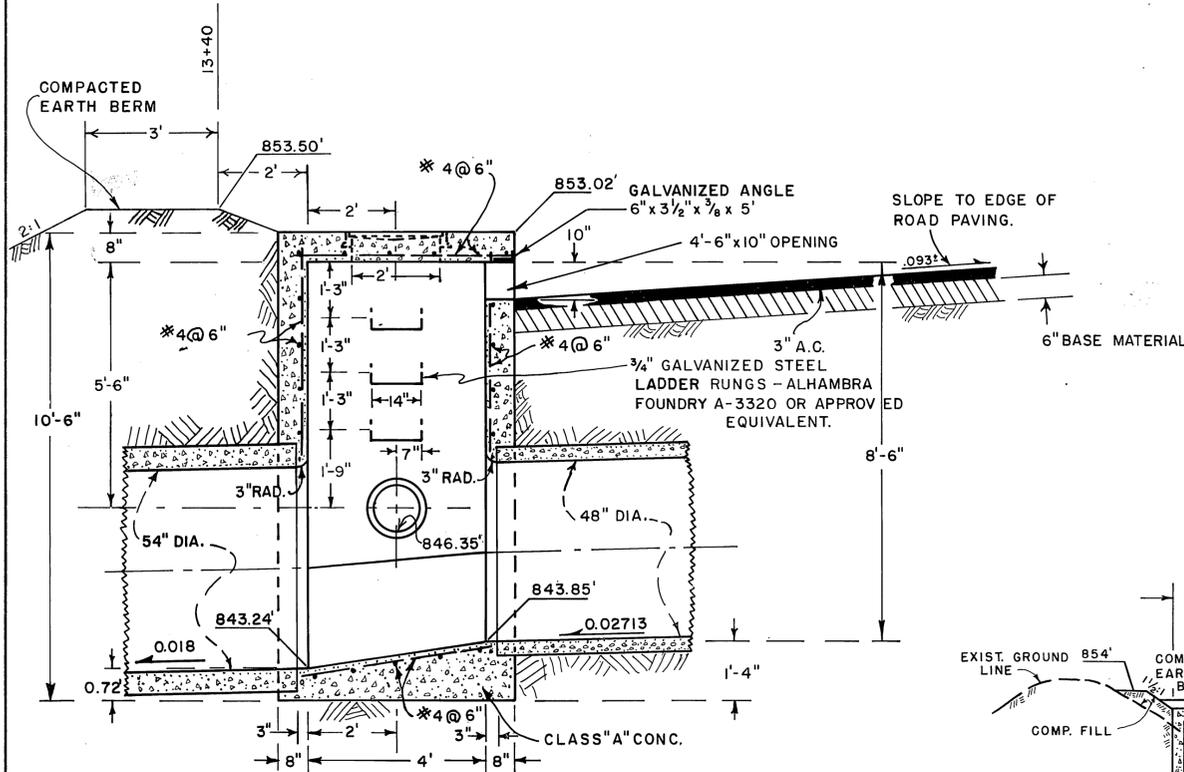


SECTION A-A

2 1 0 2 FEET

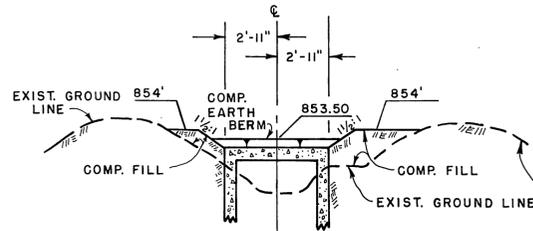


SECTION C-C

STA. 13+43
5 0 5 FT.

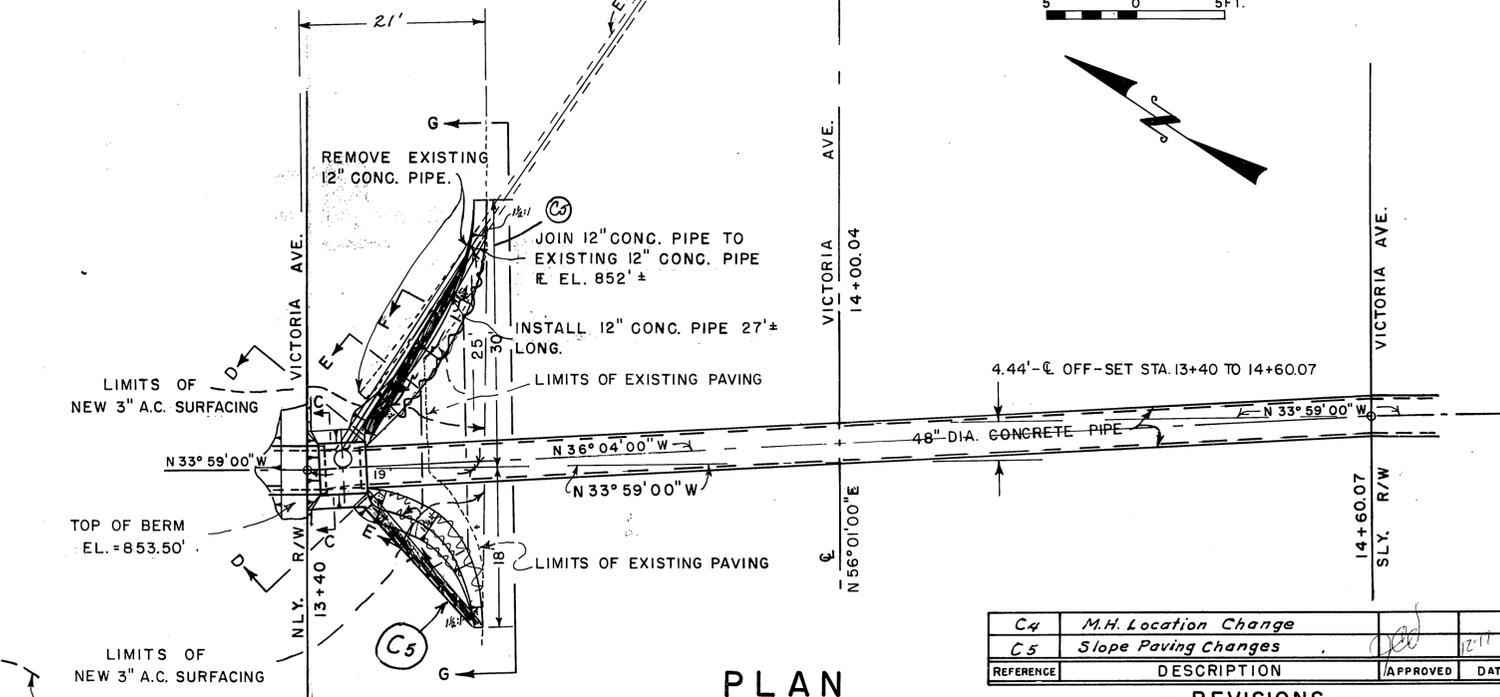

PLAN

10 5 0 10 FT.

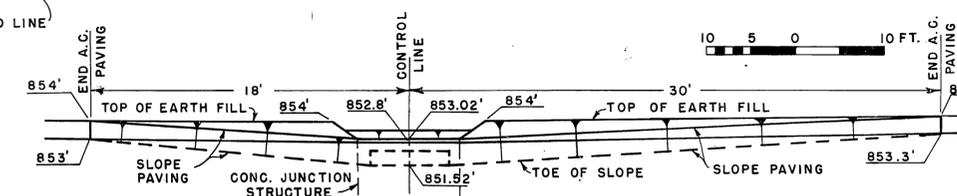

SECTION G-G


5 0 5 FT.

PROJECT NO. I-O-200
AS BUILT

REFERENCE	DESCRIPTION	APPROVED	DATE
C4	M.H. Location Change		12/11/90
C5	Slope Paving Changes		



— REVISIONS —

REVISED DATE	DESCRIPTION	APPROVED	DATE
	RIVERSIDE COUNTY FLOOD CONTROL AND WATER CONSERVATION DISTRICT		
	HARRISON DAM OUTLET STAGE I		
	VICTORIA AVE. DETAILS		
	DRAWN: R. DAVIS		SHEET NO. 7 of 19
	TRACED: K.R.B. & R.B.		DWG. NO. 1-211
	APPROVED: <i>John R. Bryant</i>		CHECKED: <i>John R. Bryant</i>
	DATE: 6-1-66		DATE DRAWN: MARCH 1966

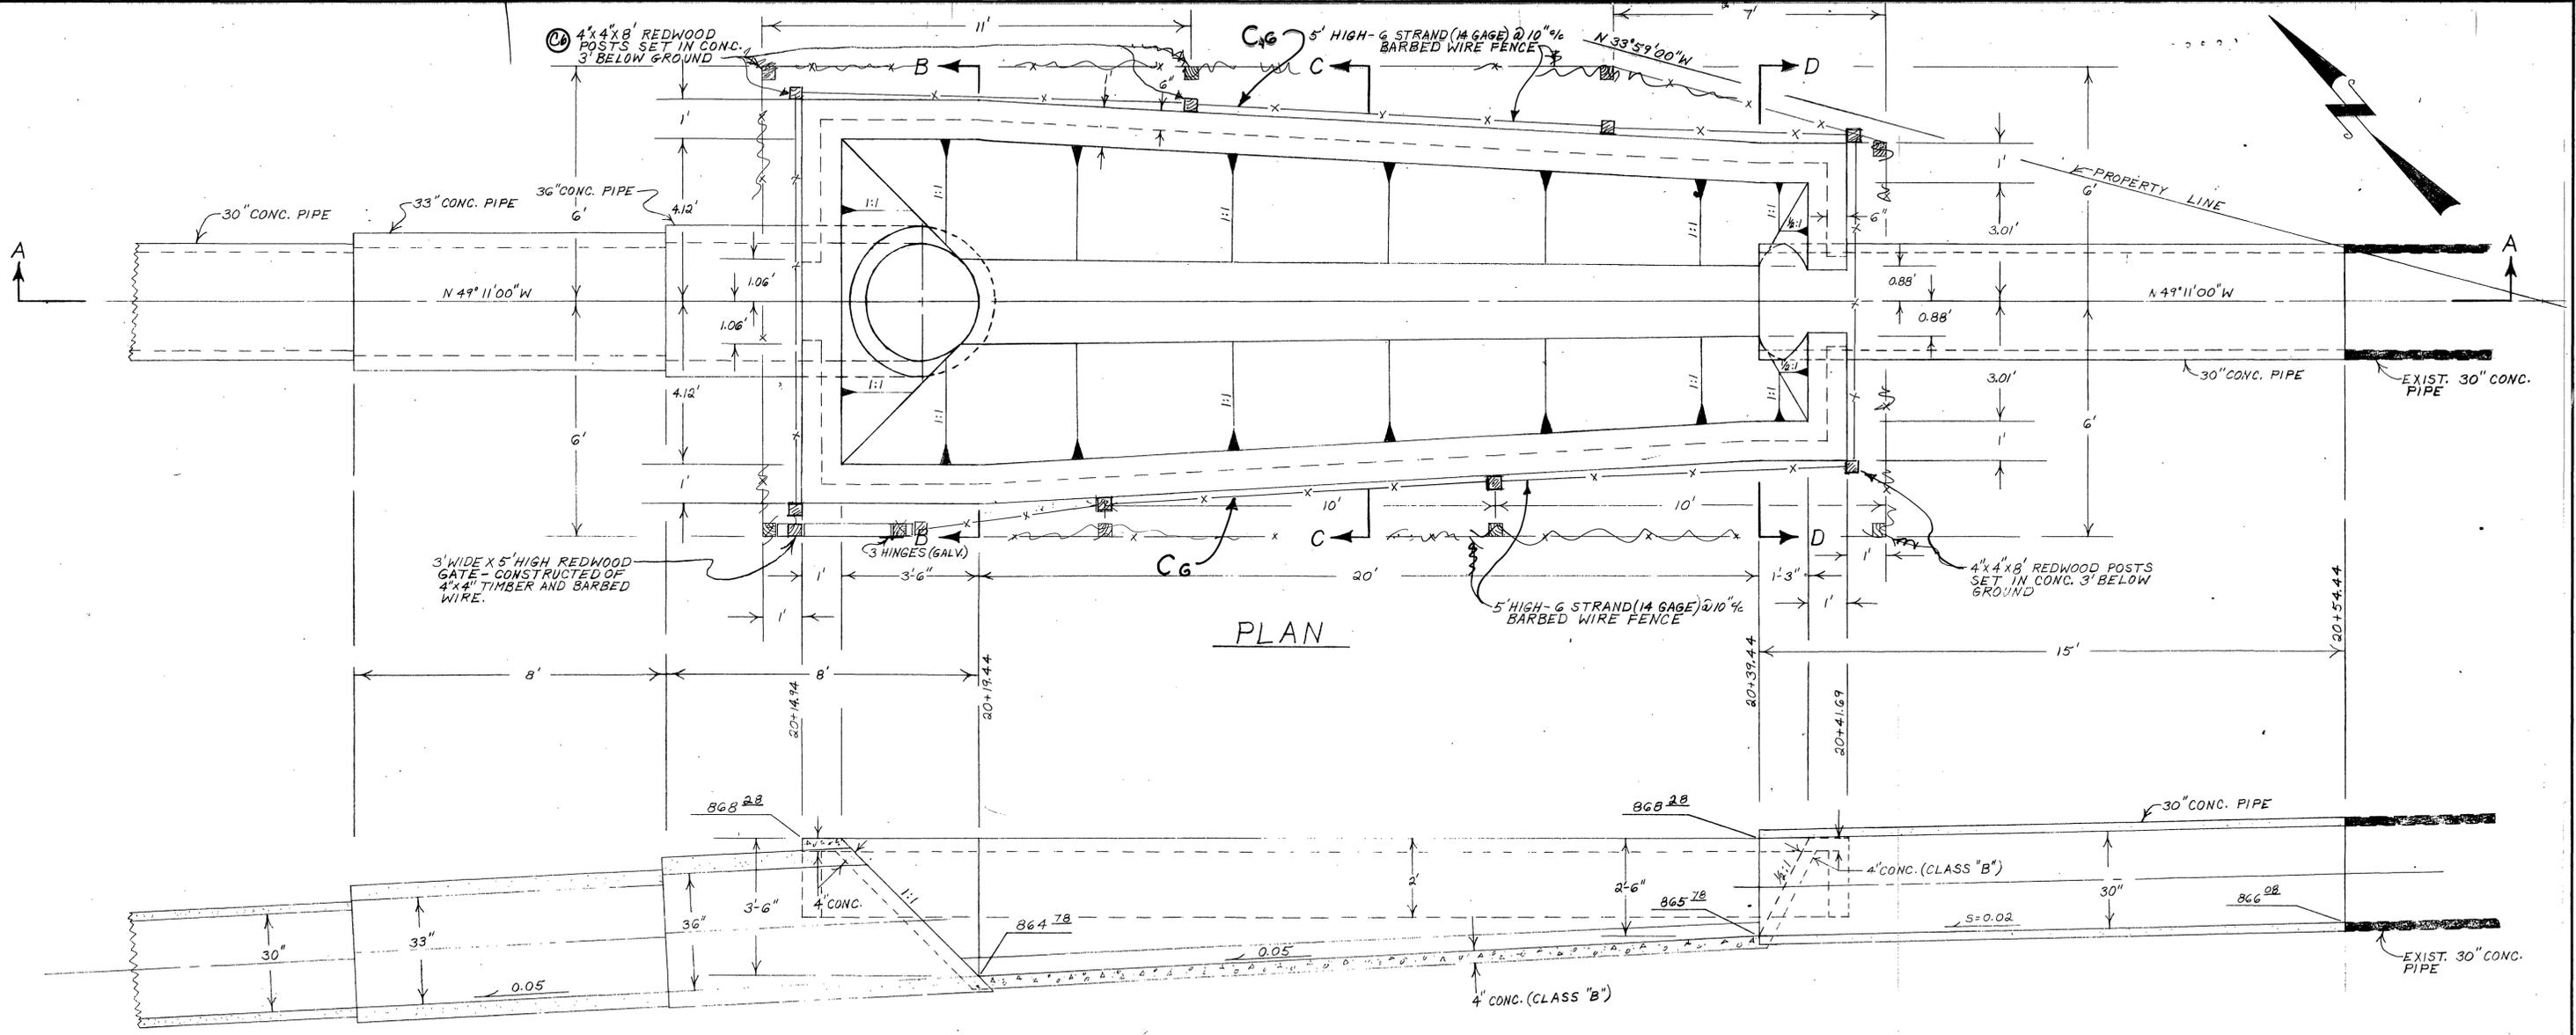


PLAN


SECTION A-A

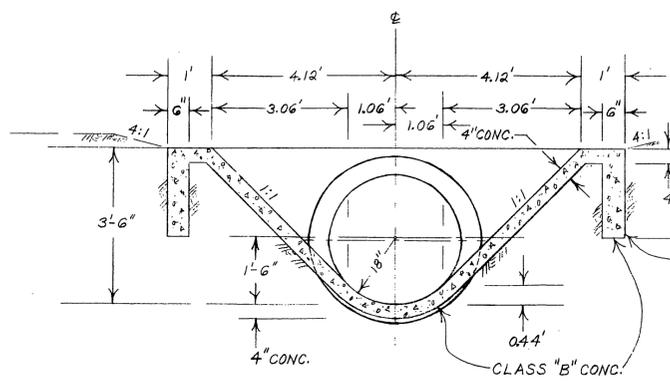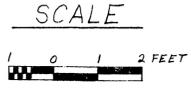

SECTION B-B

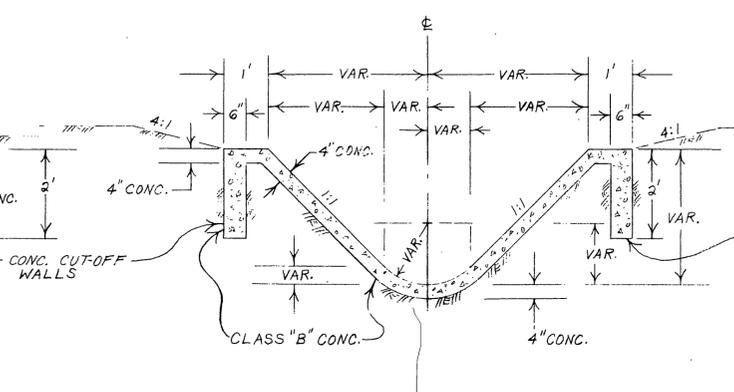

SECTION C-C

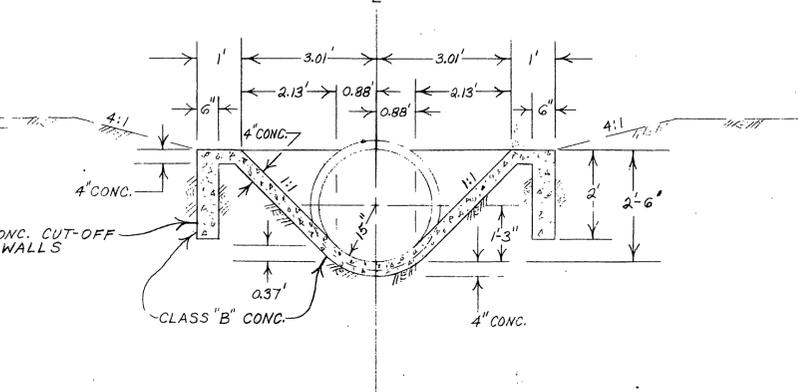

SECTION D-D

C6	Change Location of B.W. Fence	12-17-20
REFERENCE	DESCRIPTION	APPROVED DATE
- REVISIONS -		
REVISED DATE	RIVERSIDE COUNTY FLOOD CONTROL AND WATER CONSERVATION DISTRICT	
	HARRISON DAM OUTLET	
	STAGE I	
	INLET DETAILS	
APPROVED: <i>[Signature]</i>	DRAWN: R. DAVIS	SHEET NO. 8 of 19
DATE: 6-1-66	CHECKED: <i>[Signature]</i>	DWG. NO. 1-211
	DATE DRAWN: Feb. 1966	

PROJECT NO. 1-0-200
AS BUILT