



Plan View
Scale 1" = 10'


Fremont School
(Riverside City School District)

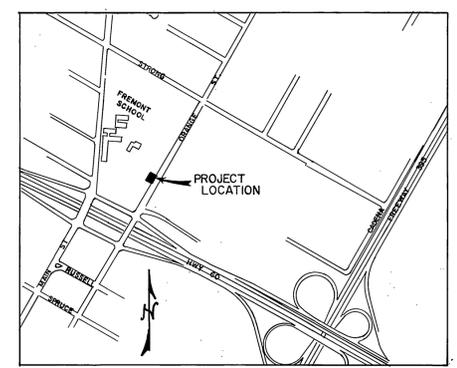


Location Map
Scale 1" = 800'

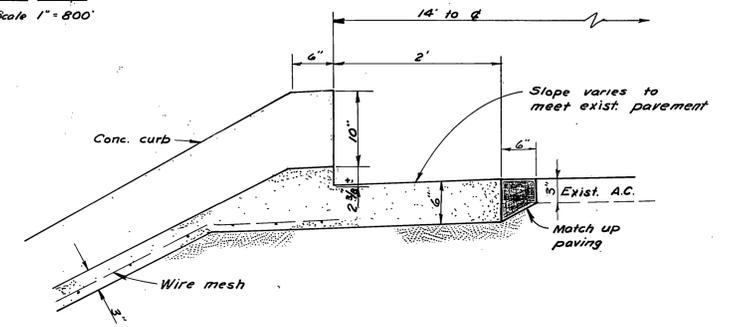


Section B-B Scale 1" = 1'-0"

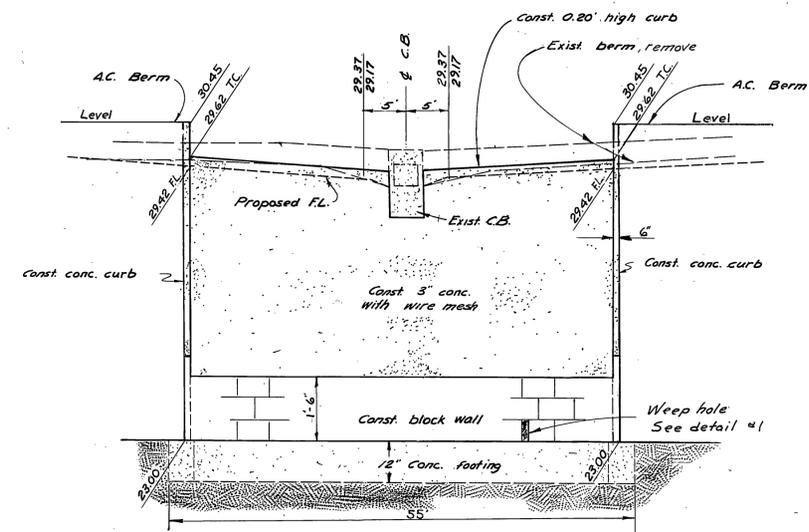


Front View
Scale: horiz. 1" = 10'
vert. 1" = 2'

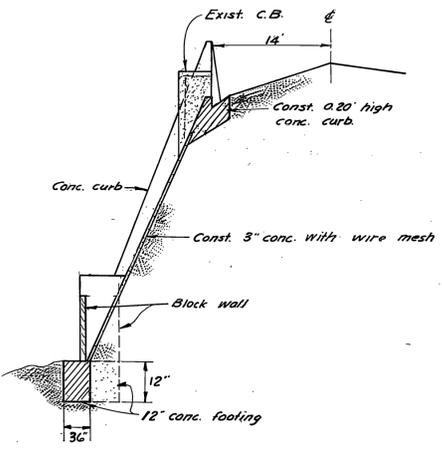


End View
Scale: horiz. 1" = 10'
vert. 1" = 2'

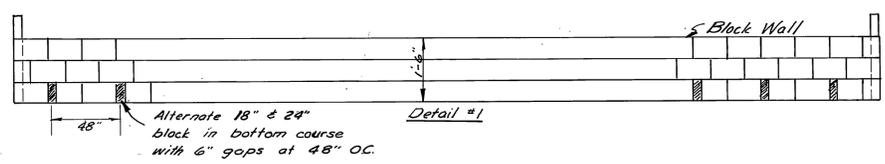

Note: Wall built of 8" x 8" x 16" block with 2 courses of 2" cap, 8" openings in bottom course @ 48" centers.

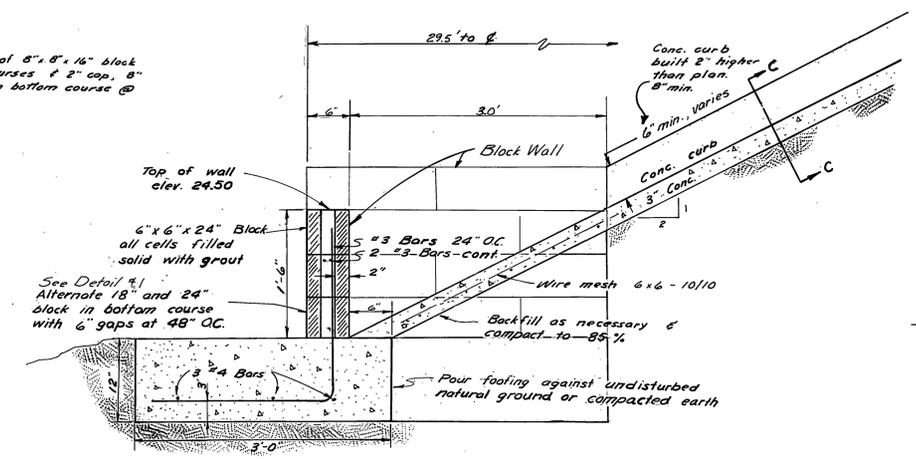

Section A-A Scale 1" = 1'-0"

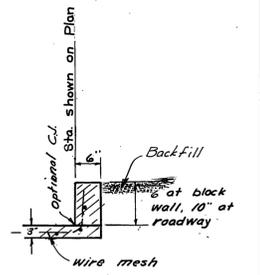

Section C-C

AS BUILT

CITY OF RIVERSIDE, CALIFORNIA DEPARTMENT OF PUBLIC WORKS				Orange Street Spillway		PROJECT NO. 417
APPROVED BY	DATE	APPROVED BY	DATE	D-171		
PARK DEPARTMENT	7/23	DIRECTOR OF PUBLIC WORKS	9-25-68	SHEET 1 OF 1		
TRAFFIC DIVISION		ASSISTANT CITY ENG.	9/25	FILE NO.		
DESIGNED BY J. Cantu	DRAWN BY Loring	CHECKED BY D.C.H.		HORIZ. SCALE: 1" = 10' VERT. SCALE: 1" = 2'		

BM 83811 CHIS. ON BOLT ON F.H.
ON S.W. COR. ORANGE ST. &
STRONG ST. FB 818/47