

LA SIERRA STORM CHANNEL

STAGE "E"


CONSTRUCTION DRAWINGS

BY

RIVERSIDE COUNTY FLOOD CONTROL
AND
WATER CONSERVATION DISTRICT

GENERAL NOTES



1. Reinforced concrete shall be Class A (6 sack) and shall have a minimum of 3,000 p.s.i. 28 day compressive strength.
2. Reinforcing steel shall be deformed, intermediate grade, billet-steel bars conforming to the specifications of A.S.T.M. Designation A-15, latest revised, with deformations conforming to A.S.T.M. Designation A-305.
3. All reinforcing bar bends and hooks shall conform to the American Concrete Institute "MANUAL of STANDARD PRACTICE."
4. Lap all reinforcing steel a minimum of 30 bar diameters at splices. The location of all splices shall be subject to approval of the Engineer.
5. All reinforcing steel shall have a minimum cover of 1 1/2" unless otherwise noted.
6. All exposed edges of concrete structures, shall be chamfered 3/4" or rounded as directed.
7. Unreinforced concrete channel lining shall be Class B (5 sack), unless otherwise specified.
8. All concrete thickness dimensions are the minimum allowable.
9. Provide 1/2" expansion joint material to separate the channel concrete lining from the R.C.B. Culverts.
10. Transverse grooves 1" deep at 10' spacing shall be provided in all unreinforced concrete channel lining and levee lining. Grooves shall be formed using 3/8" x 1" masonite strips.
11. All transverse construction joints in unreinforced concrete channel lining required at the end of a day's placing operation shall be located between the transverse grooves and No. 4 x 30" dowels at 24" spacing embedded 15" shall be provided.
12. Transverse construction joints at 30' spacing, or as directed by the Engineer, shall be provided in the reinforced concrete channel lining.
13. The subdrainage filter material shall be Class I, Type B, as specified in paragraph 68-1.025 of the STANDARD SPECIFICATIONS.
14. The surface finish required for unreinforced concrete channel lining shall be a light wood float finish. See Special Provisions.
15. The channel and levee embankments and the channel structural backfill shall be compacted to not less than 85% maximum density and the structure backfill for the R.C.B. culverts shall be compacted to not less than 90% maximum density as determined by tests conforming to the requirements of Test Method No. Calif. 216-F.
16. For Right of Way Refer to Record of Survey Book 40 page 95 and Book 47 pages 66,67, and 68.
17. Provide 3-2 1/2" (or adequate to receive fencing) Std. pipe sockets 14" deep in each R.C.B. Culvert parapet (centered) for L Posts (9'-6" centers).

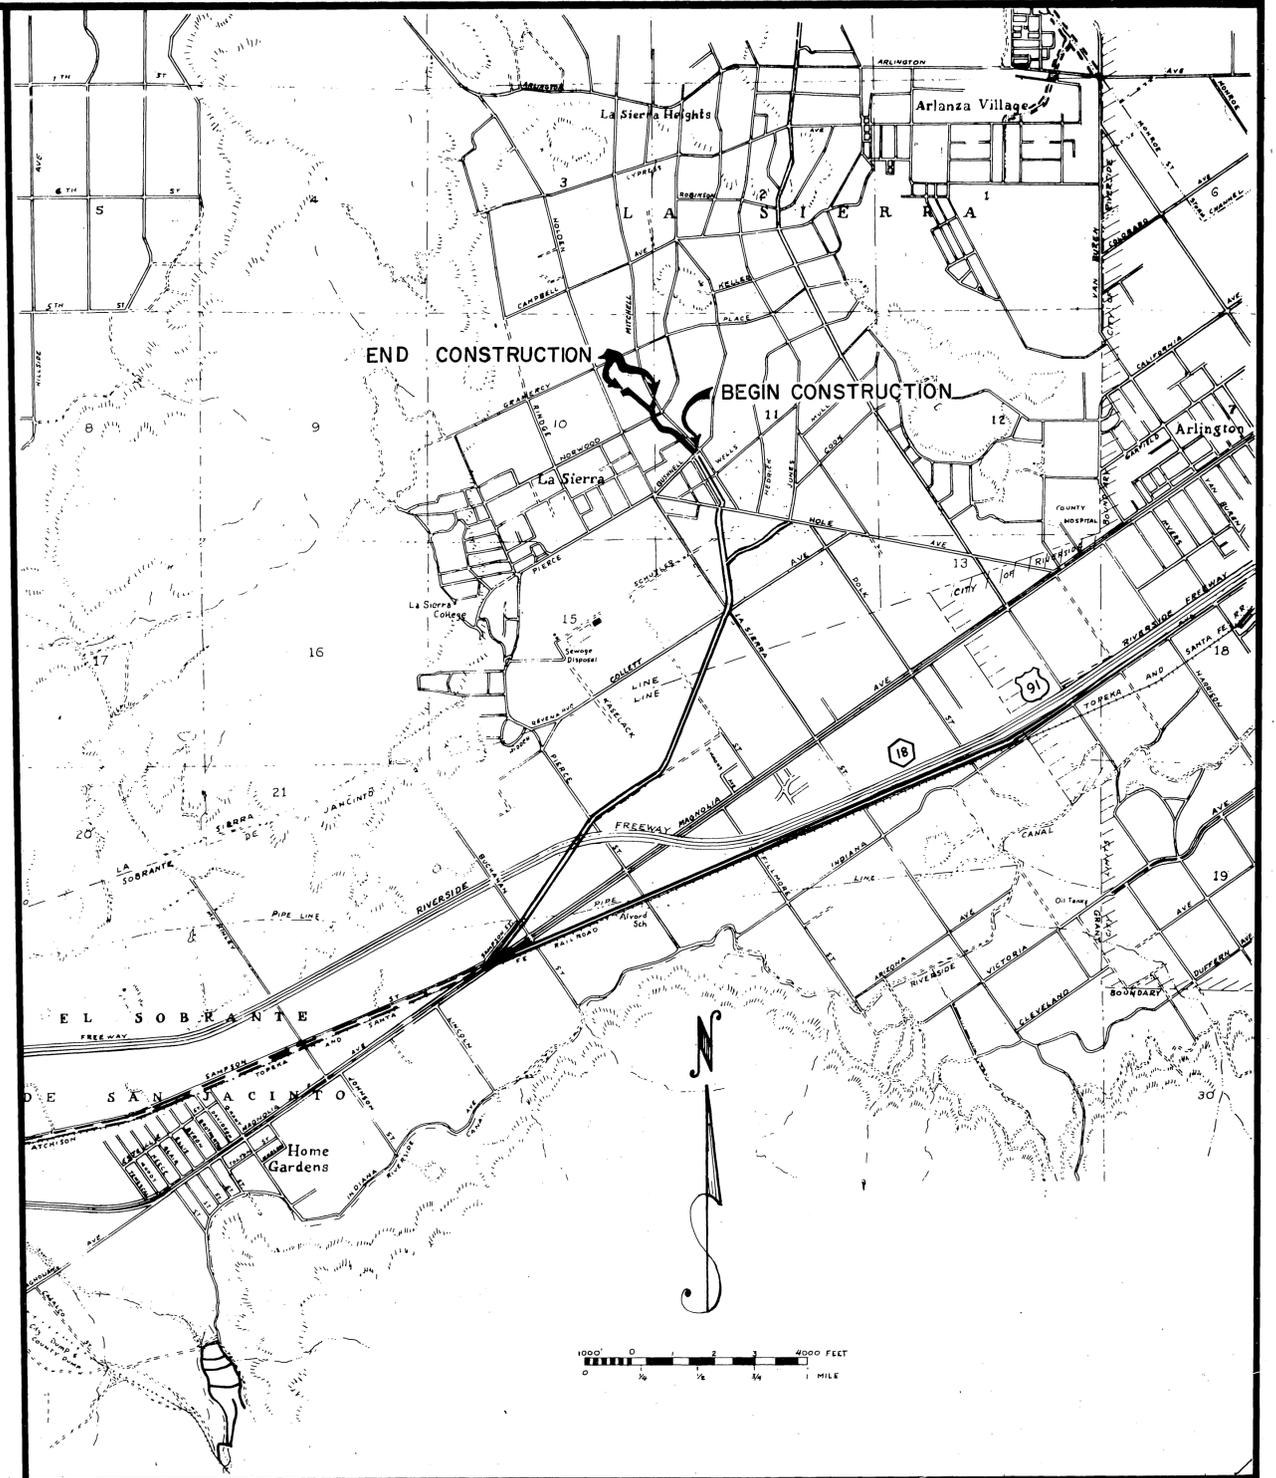

AS BUILT
PROJECT NO. 1-0-060

REVISED DATE	RIVERSIDE COUNTY FLOOD CONTROL AND WATER CONSERVATION DISTRICT		
	LA SIERRA STORM CHANNEL STAGE "E"		
APPROVED: <i>[Signature]</i> CHIEF ENGINEER R.E. NO. 892	DRAWN: Ken Bilodeau	CHECKED:	SHEET No. 1 of 23
DATE: 1-14-66	DATE DRAWN: December, 1964	DWG. No. 1-201	

D-173 E

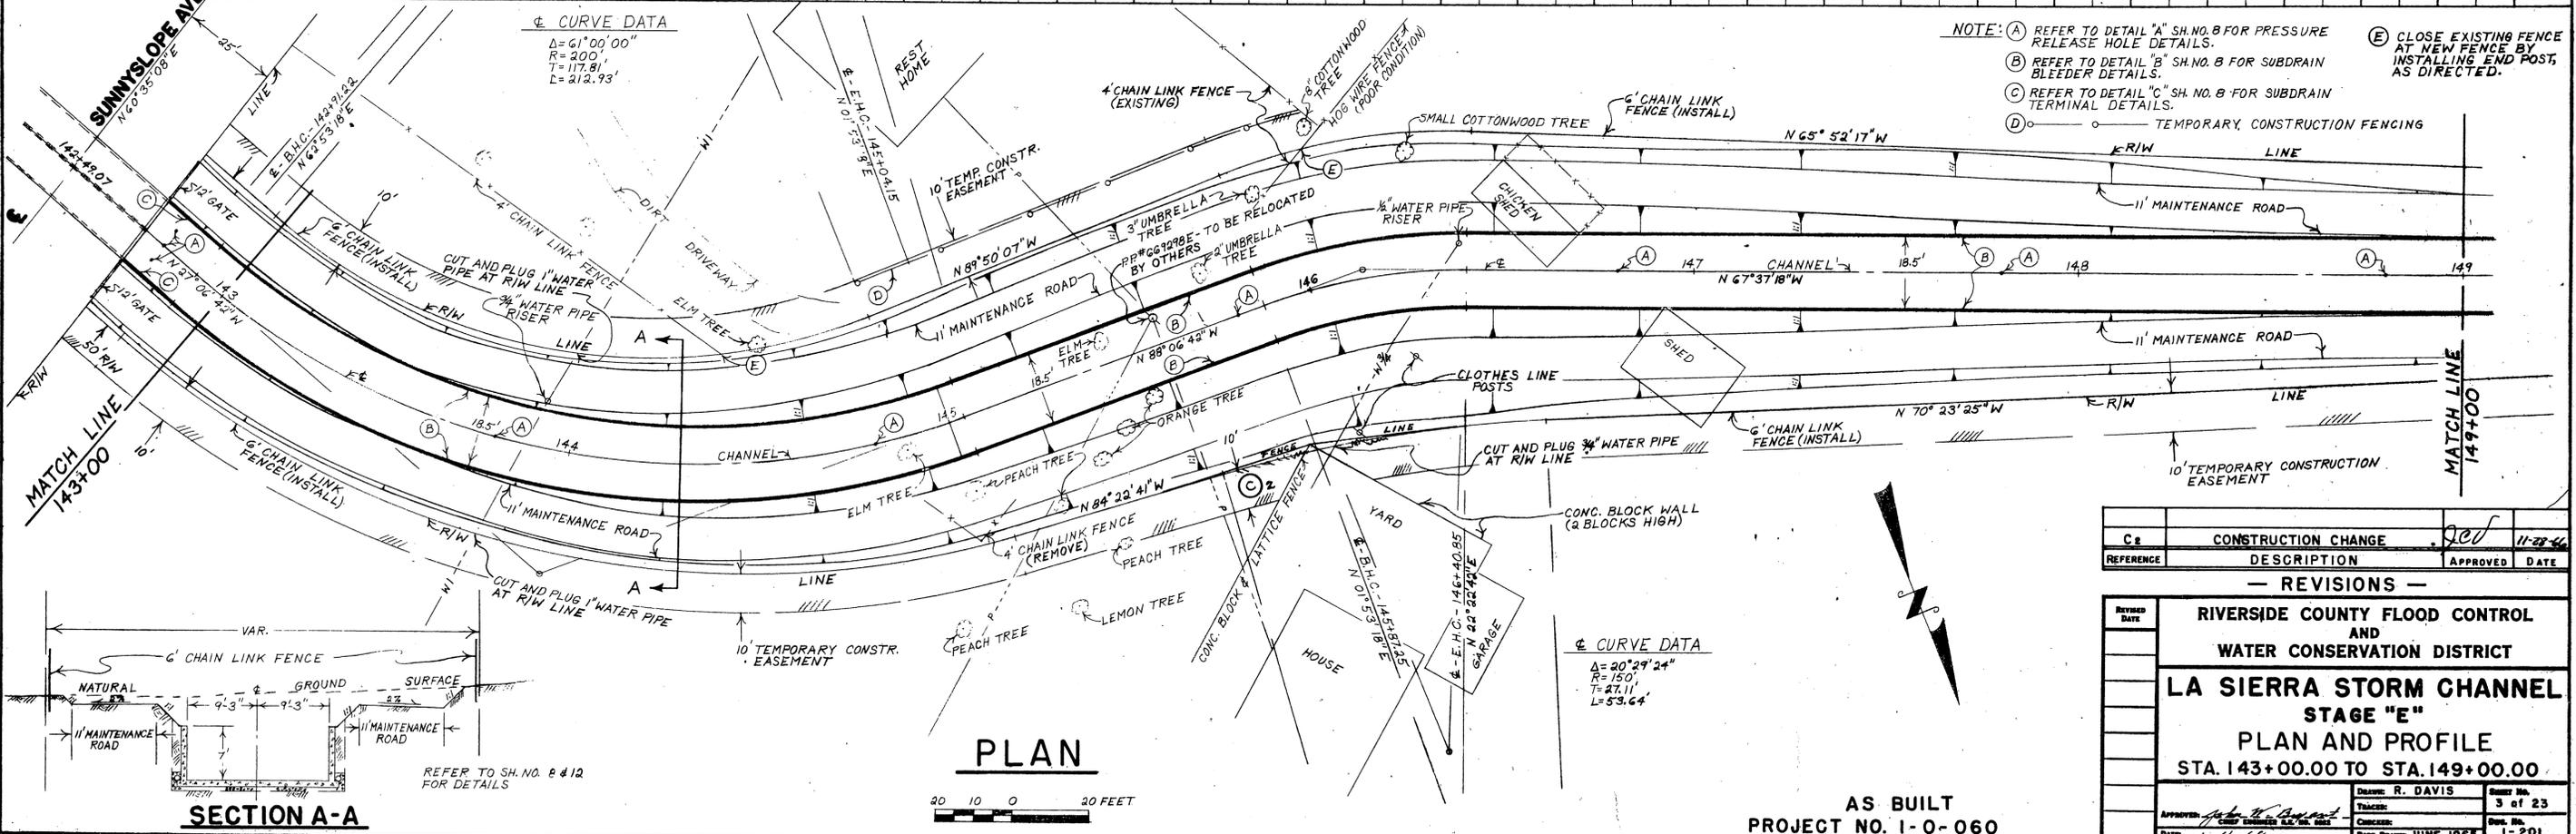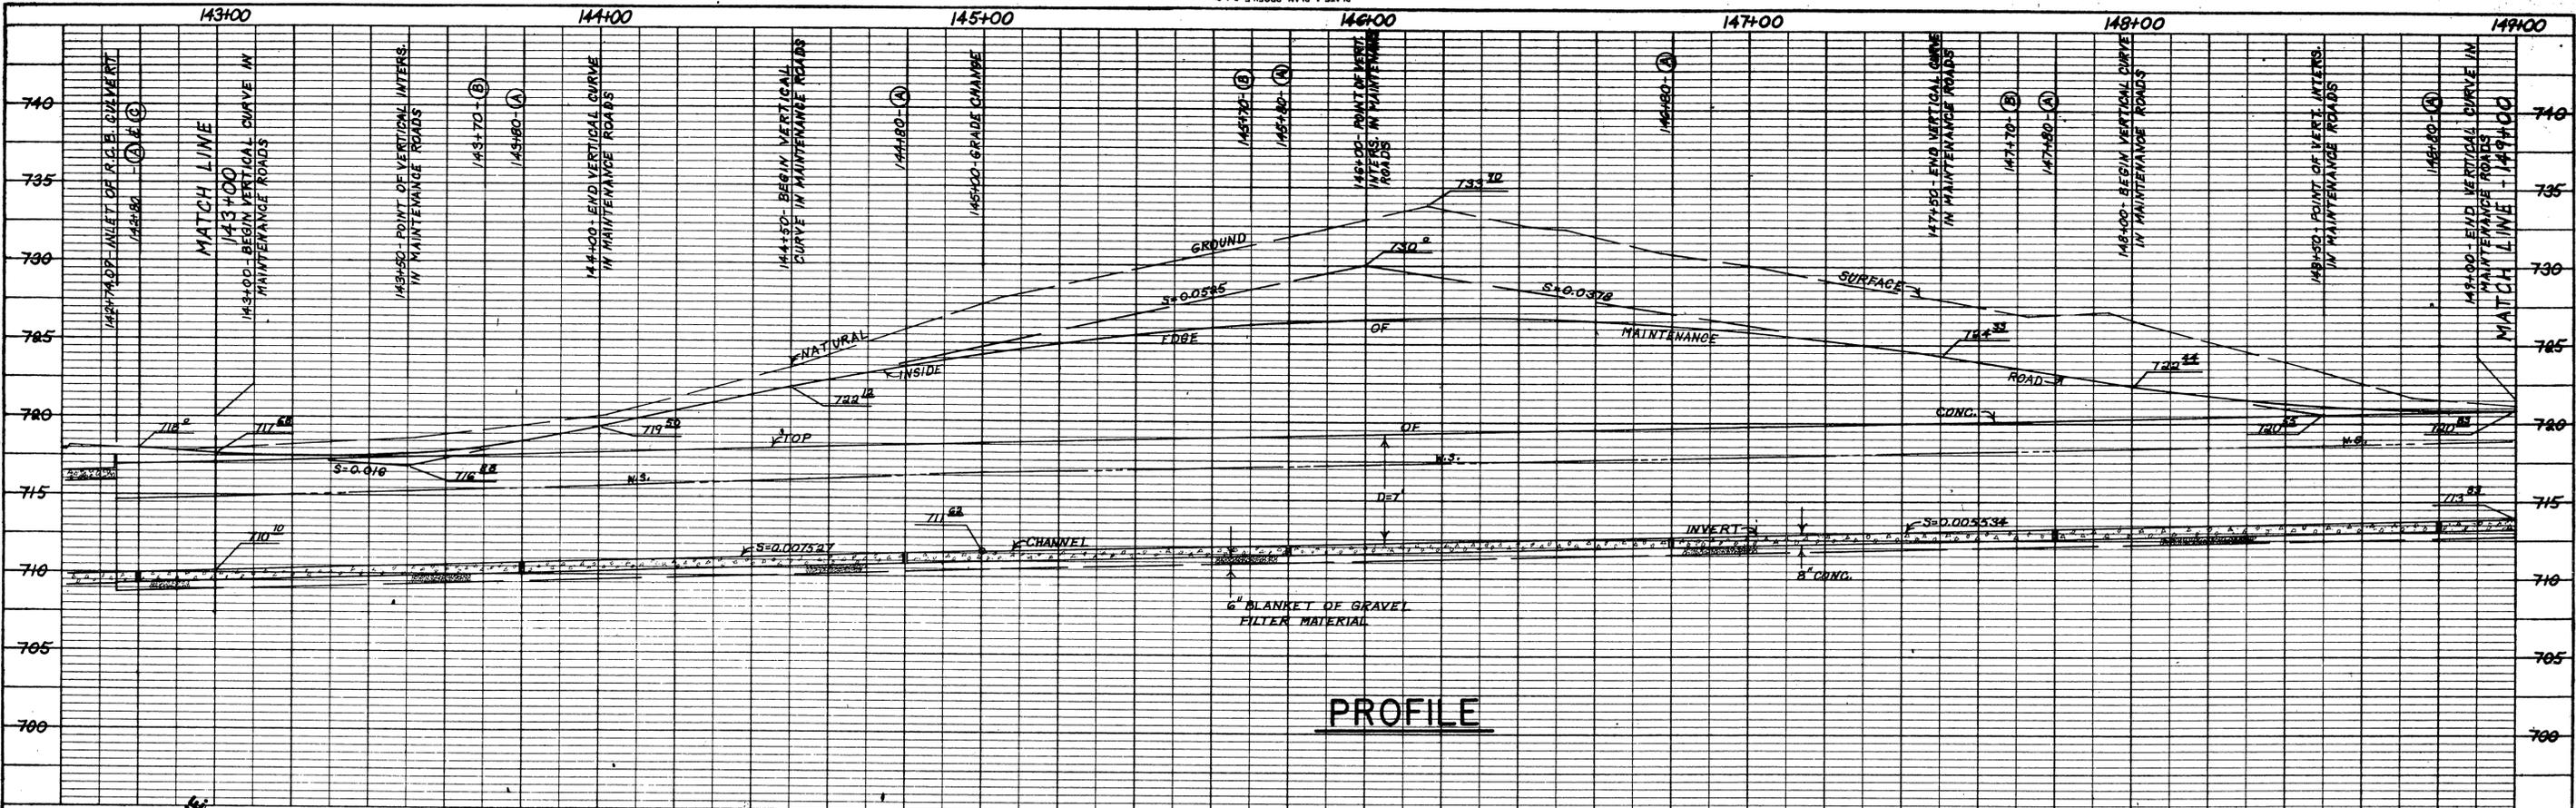

NOTE: (A) REFER TO DETAIL "A" SH. NO. 8 FOR PRESSURE RELEASE HOLE DETAILS.
 (B) REFER TO DETAIL "B" SH. NO. 8 FOR SUBDRAIN BLEEDER DETAILS.
 (C) REFER TO DETAIL "C" SH. NO. 8 FOR SUBDRAIN TERMINAL DETAILS.
 (D) ○ TEMPORARY CONSTRUCTION FENCING
 (E) CLOSE EXISTING FENCE AT NEW FENCE BY INSTALLING END POST, AS DIRECTED.

REVISION	DESCRIPTION	DATE
C-2	CONSTRUCTION CHANGE	11-22-66

RIVERSIDE COUNTY FLOOD CONTROL AND WATER CONSERVATION DISTRICT

LA SIERRA STORM CHANNEL STAGE "E" PLAN AND PROFILE

STA. 143+00.00 TO STA. 149+00.00

DESIGNED BY: R. DAVIS
 DRAWN BY: R. DAVIS
 CHECKED BY: R. DAVIS
 DATE: 1-4-66

DATE: 1-4-66


SECTION A-A

PLAN


PROFILE

20 10 0 20 FEET

AS BUILT
 PROJECT NO. I-O-060

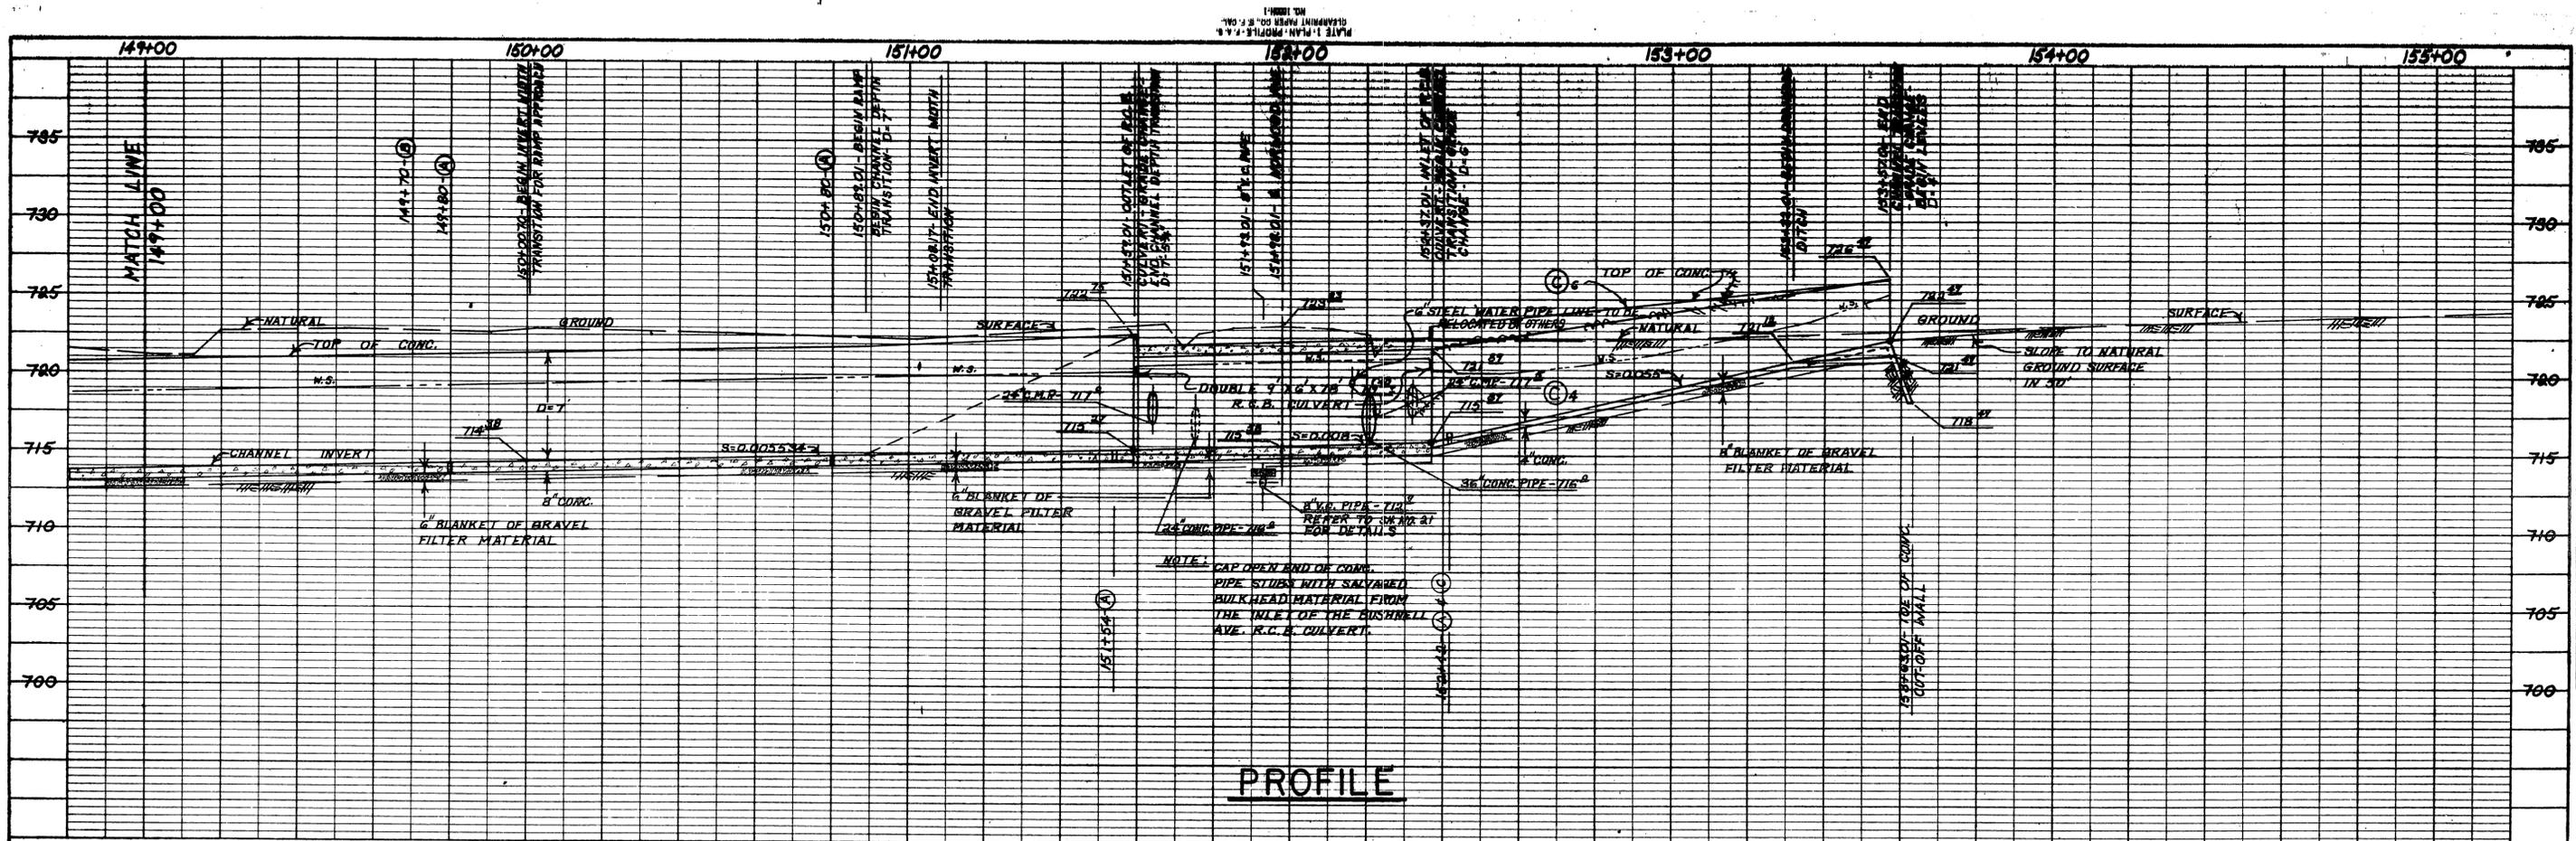

PROFILE

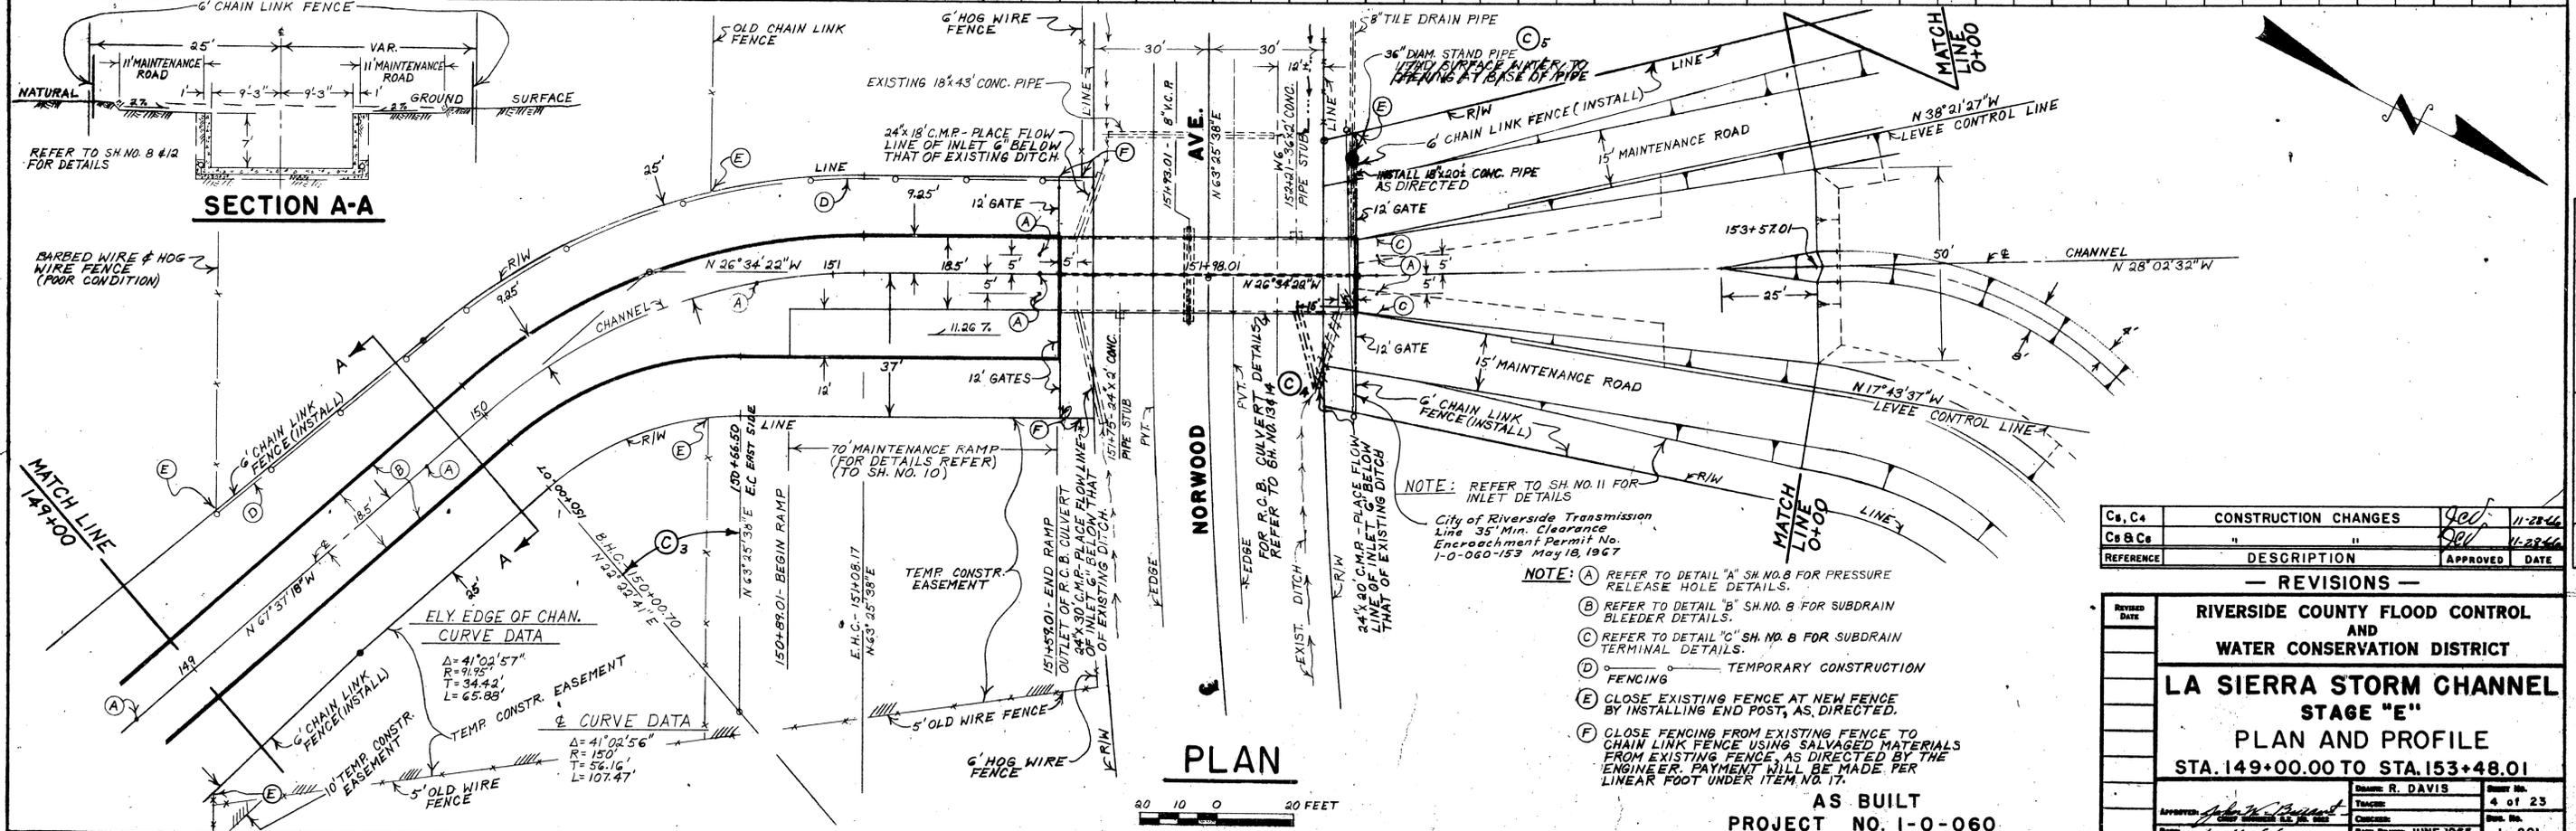

PLAN

NO.	DATE	DESCRIPTION	APPROVED	DATE
Cs, C4		CONSTRUCTION CHANGES	<i>[Signature]</i>	11-28-66
Cs & Cc		"	<i>[Signature]</i>	11-28-66
REFERENCE		DESCRIPTION	APPROVED	DATE

— REVISIONS —

Revised Date: _____
RIVERSIDE COUNTY FLOOD CONTROL AND WATER CONSERVATION DISTRICT
LA SIERRA STORM CHANNEL
STAGE "E"
PLAN AND PROFILE
STA. 149+00.00 TO STA. 153+48.01

Approved: <i>[Signature]</i>	Checked: <i>[Signature]</i>	Drawn: R. DAVIS	Sheet No. 4 of 23
Date: 1-14-66	Date: _____	Date: JUNE 1965	Date: 1-201


AS BUILT
PROJECT NO. I-O-060




PROFILE
 SHEETED
 CHECKED
 NO. 1
 DATE
 PROJECT NO. I-O-060

PLAN
 SHEETED
 CHECKED
 NO. 1
 DATE
 PROJECT NO. I-O-060

1:1000
 CLEARING PLAN, PROFILE, & C&G
 NO. 1000-1

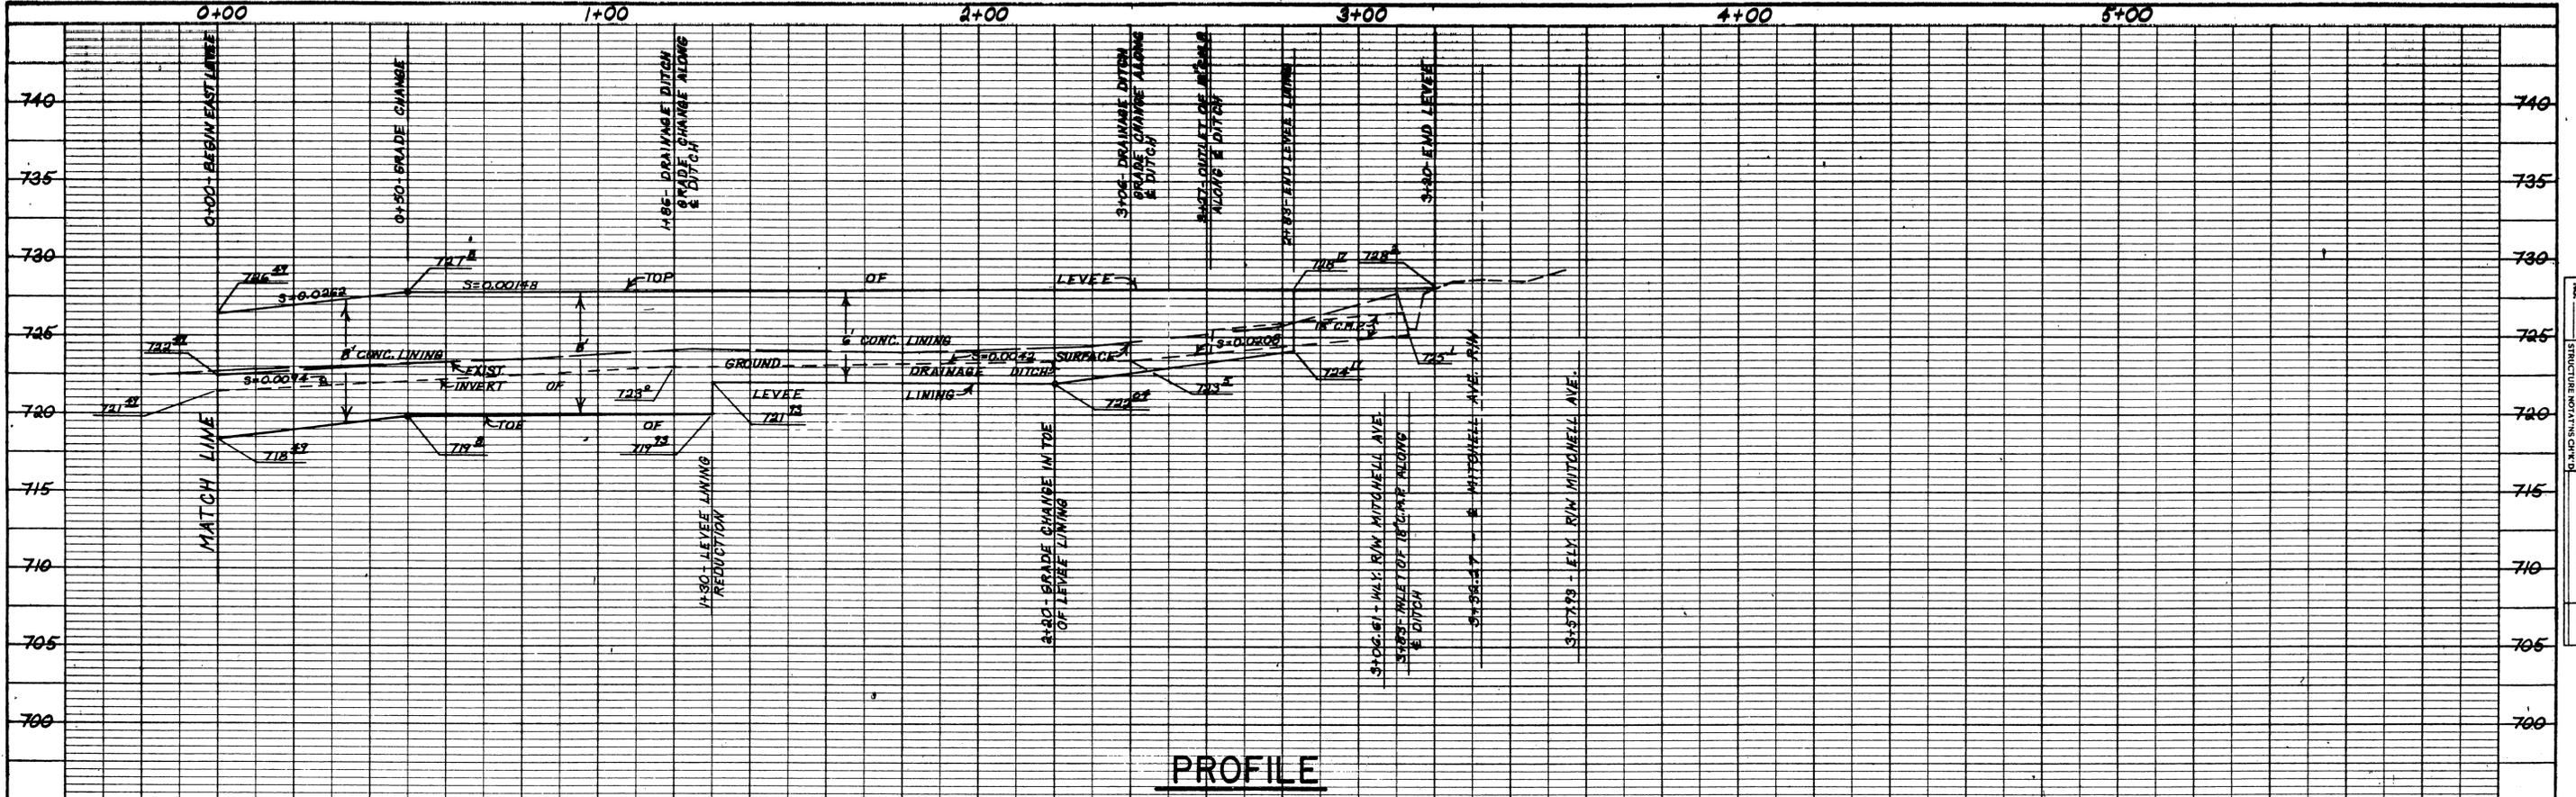


PROFILE

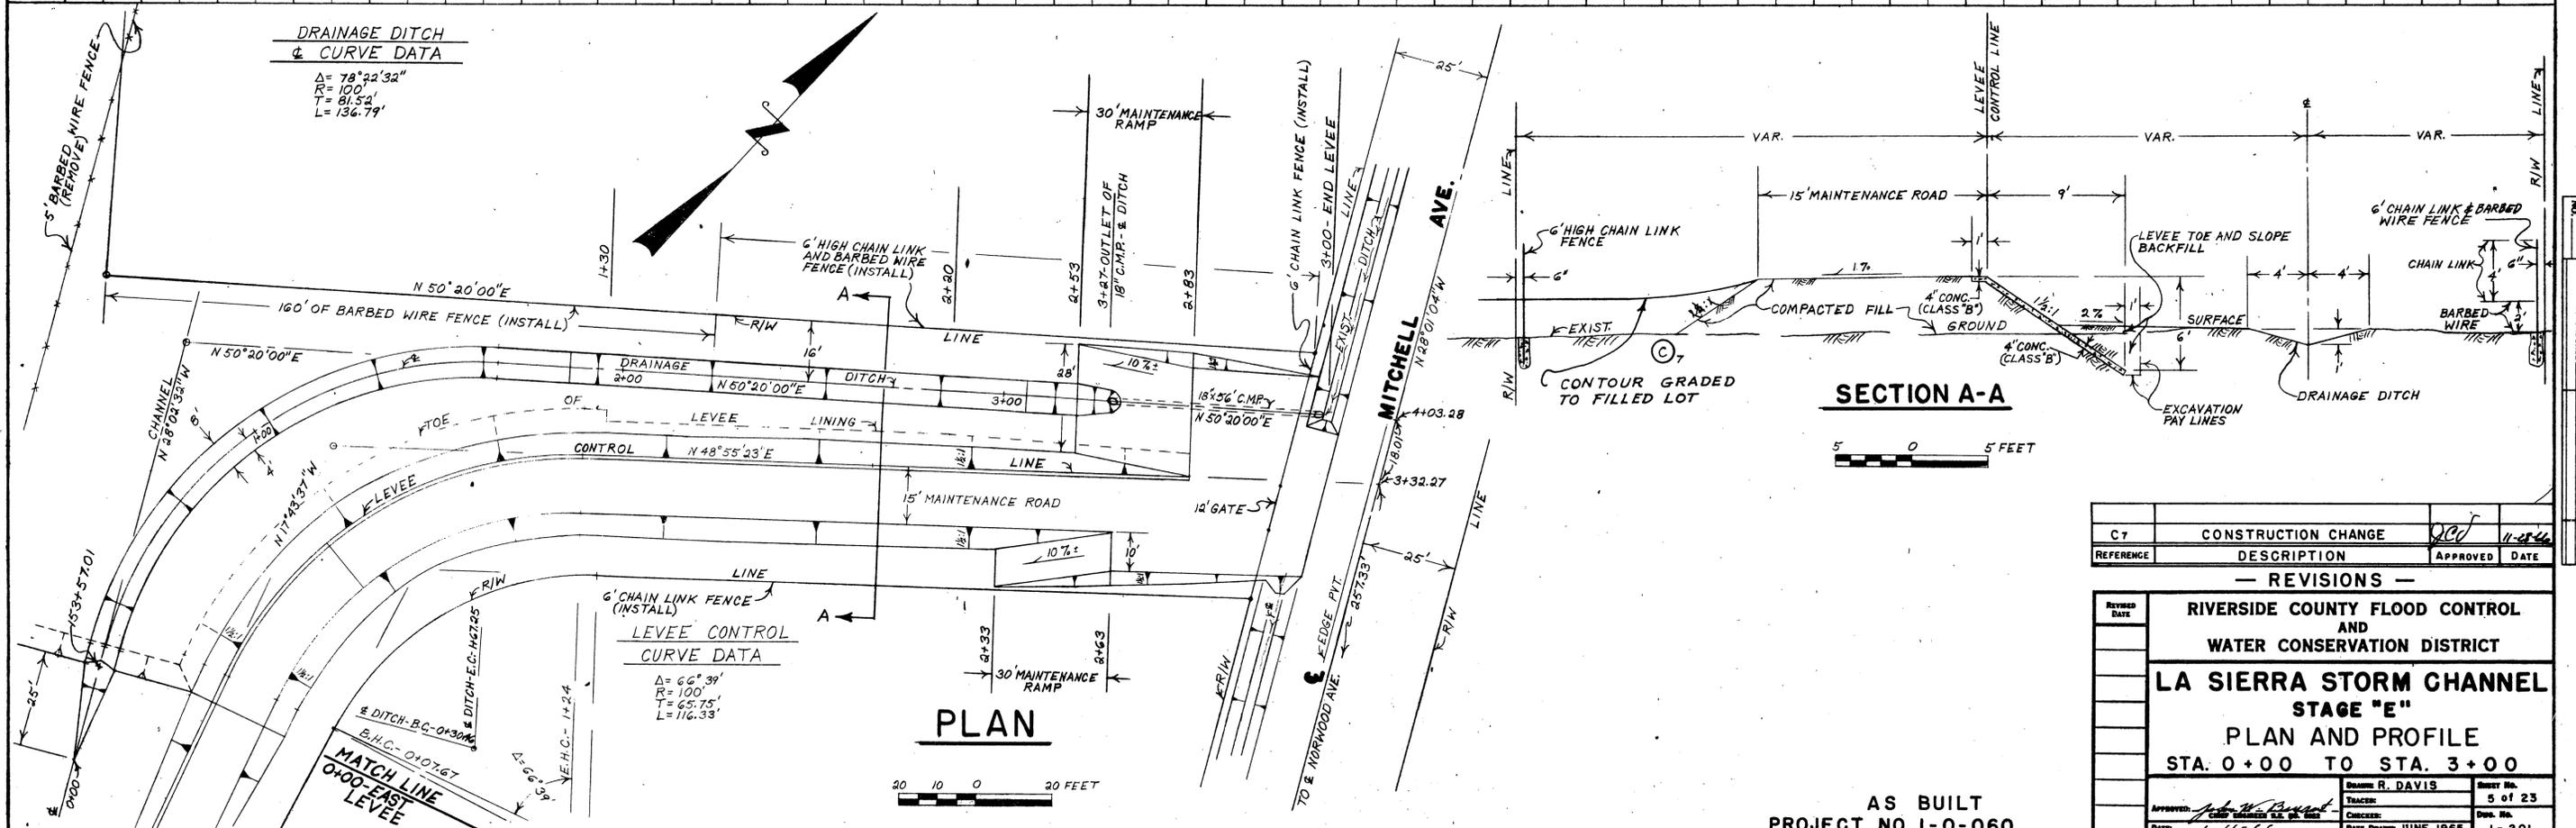

PLAN

SECTION A-A

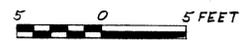

REFERENCE	DESCRIPTION	APPROVED	DATE
C7	CONSTRUCTION CHANGE	<i>[Signature]</i>	11-25-66

— REVISIONS —


<p>RIVERSIDE COUNTY FLOOD CONTROL AND WATER CONSERVATION DISTRICT</p> <p>LA SIERRA STORM CHANNEL</p> <p>STAGE "E"</p> <p>PLAN AND PROFILE</p> <p>STA. 0+00 TO STA. 3+00</p>			
<p>APPROVED: <i>[Signature]</i></p> <p>DATE: 1-11-66</p>	<p>DESIGNED BY: R. DAVIS</p> <p>CHECKED: <i>[Signature]</i></p> <p>DATE DRAWN: JUNE 1965</p>	<p>DRAWN BY: <i>[Signature]</i></p> <p>CHECKED: <i>[Signature]</i></p> <p>DATE: 1-11-66</p>	<p>SHEET NO. 5 of 23</p> <p>PROJ. NO. 1-0-060</p> <p>DATE: 1-11-66</p>

AS BUILT
 PROJECT NO. 1-0-060


PROFILE
 SURVEYED
 NOTES CHECKED
 R. M. WOOD
 STRUCTURE NO. 1000-1

PLAN
 SURVEYED
 NOTES CHECKED
 R. M. WOOD
 STRUCTURE NO. 1000-1

PLATE 1 - PLAN - PROFILE
 CLEARPRINT PAPER CO. S. F. CAL.
 NO. 1000H-1

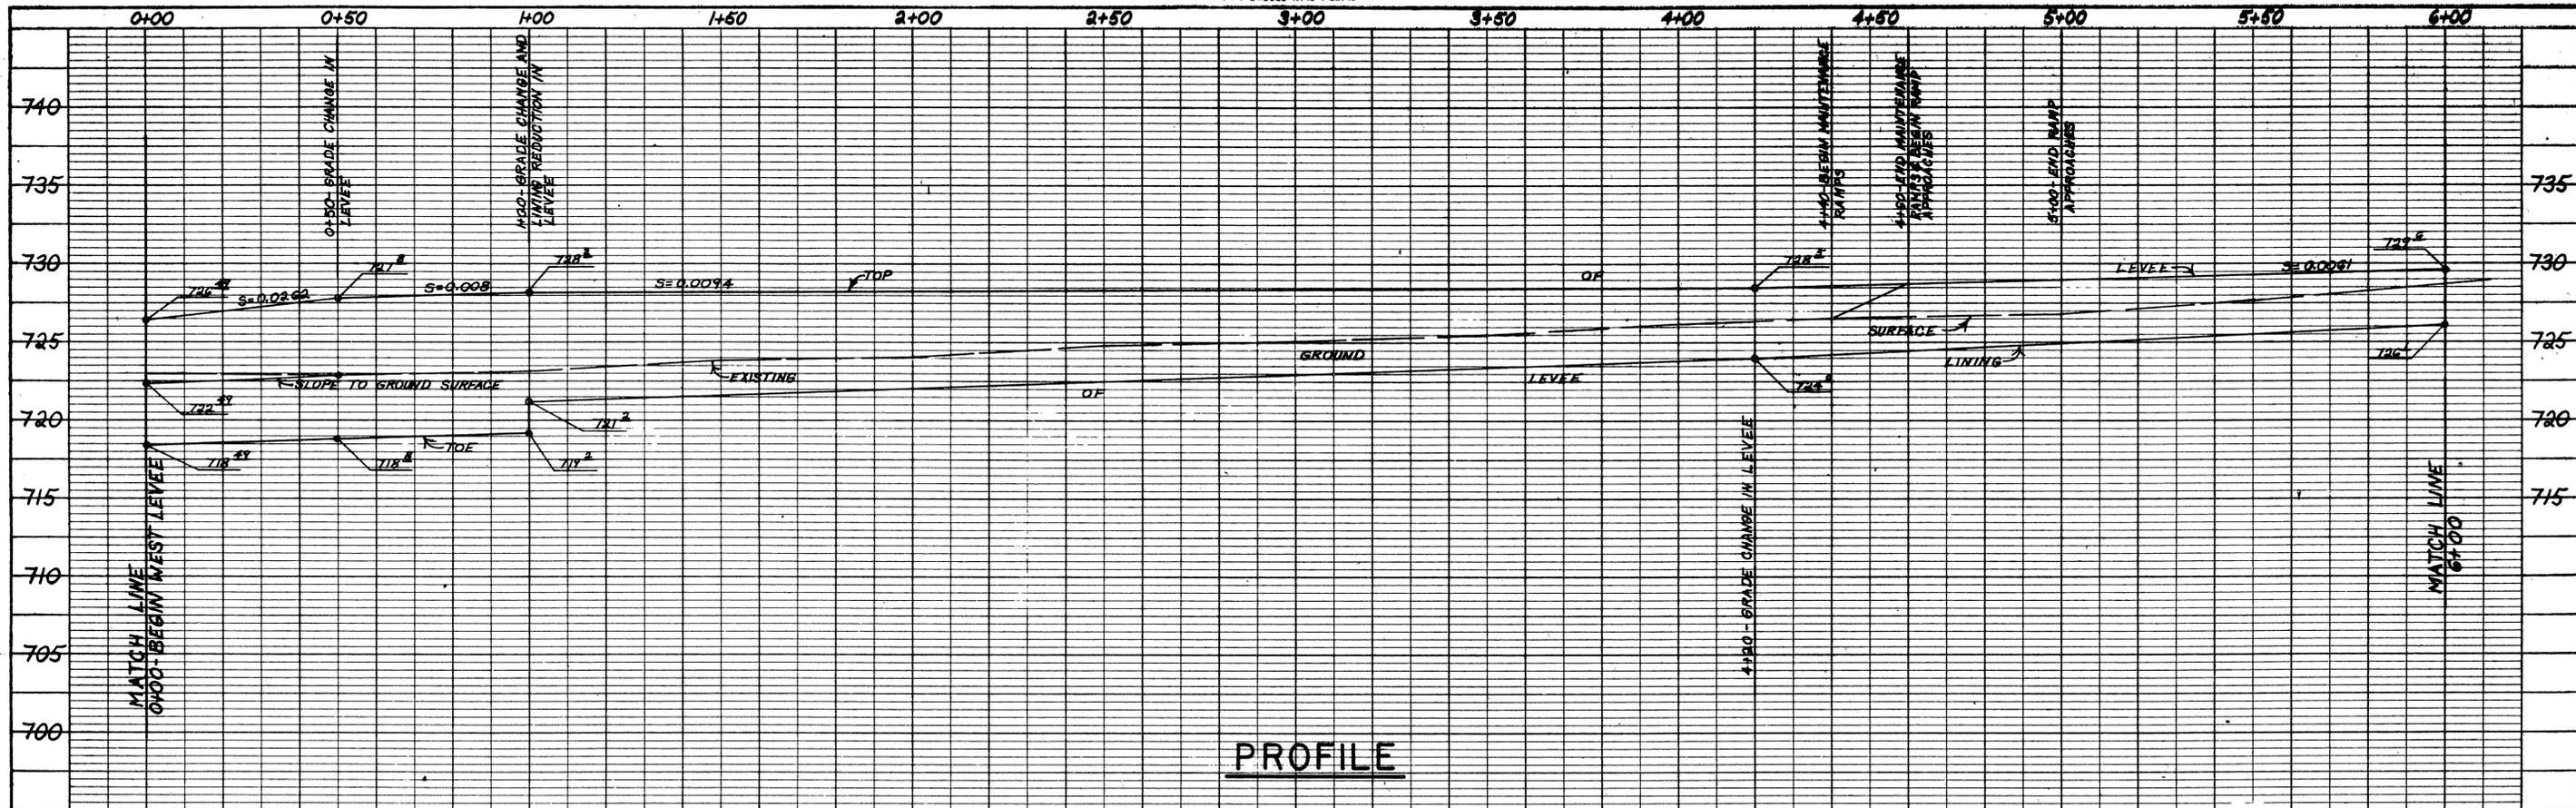


PROFILE

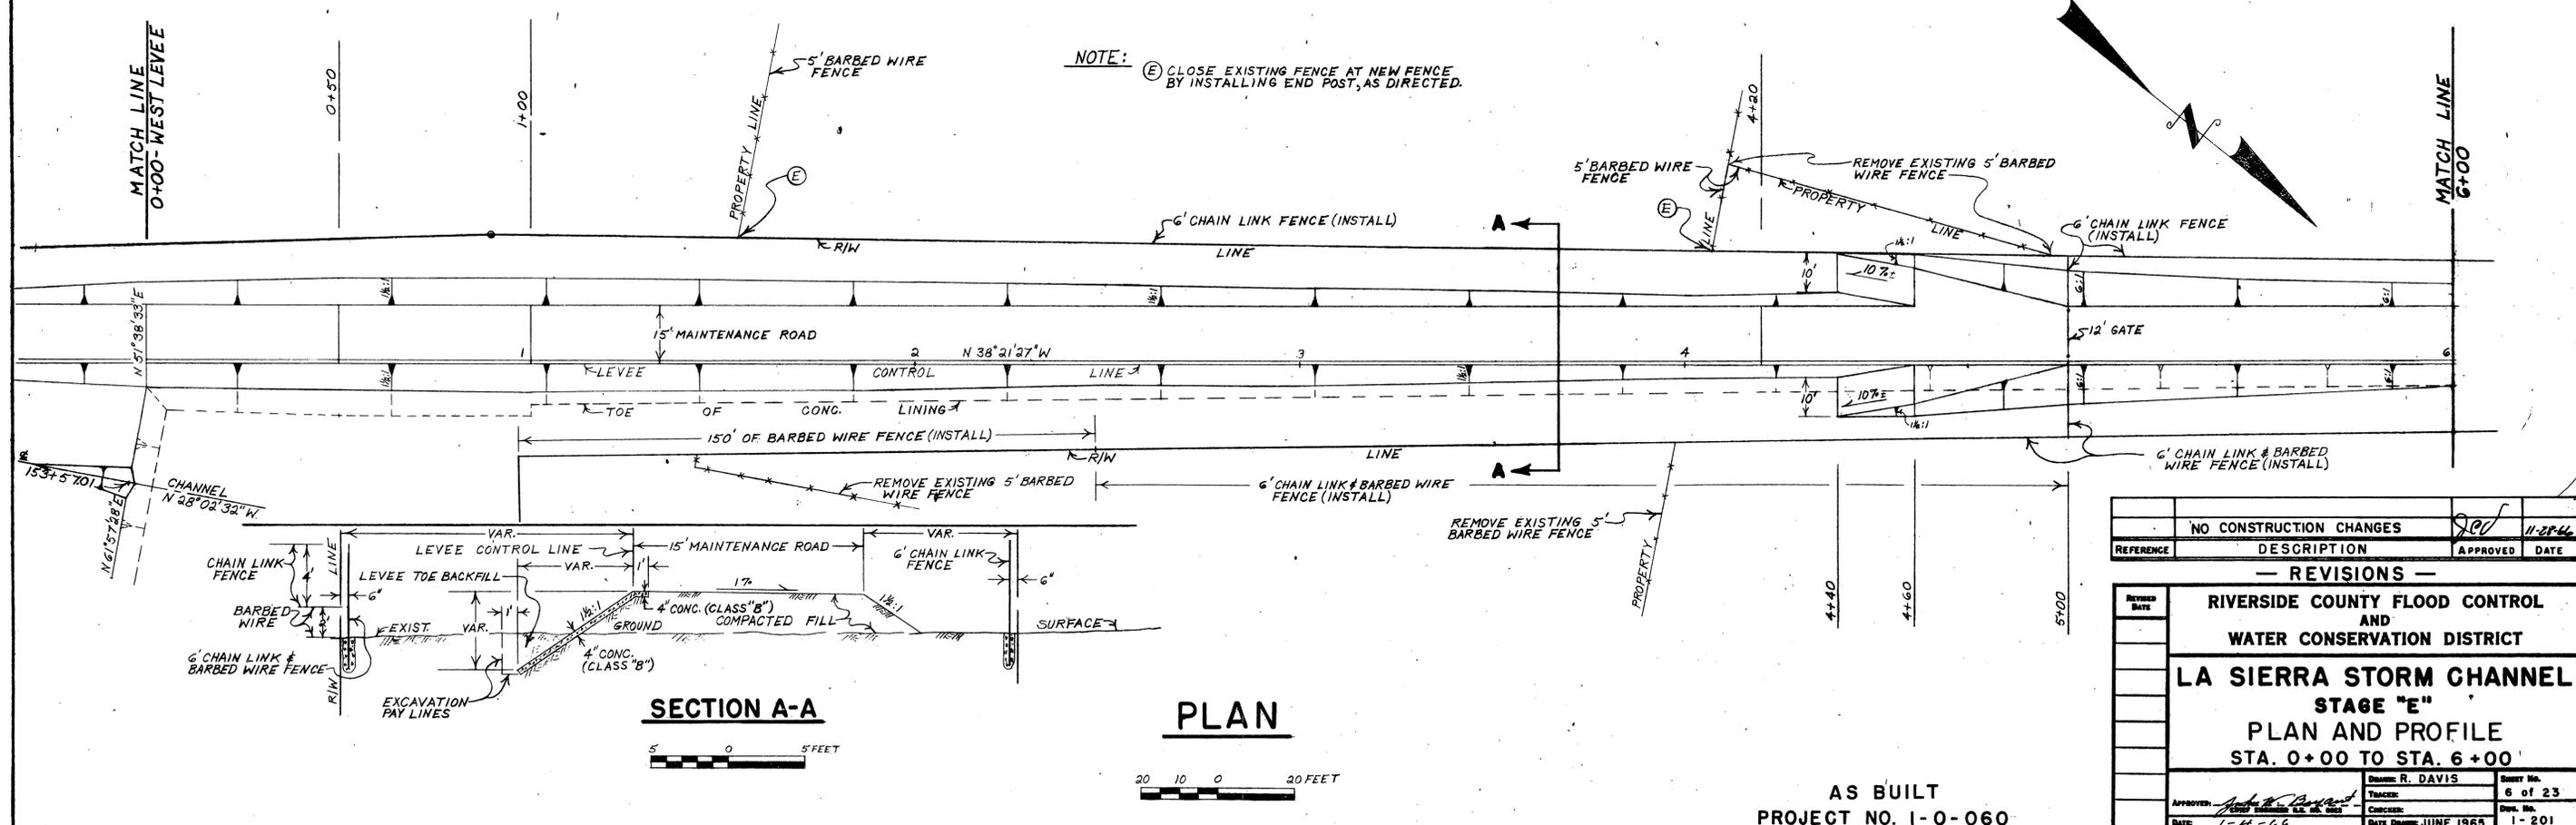

SECTION A-A

PLAN

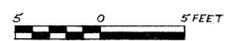

REFERENCE	DESCRIPTION	APPROVED	DATE
	NO CONSTRUCTION CHANGES	<i>[Signature]</i>	11-28-66

— REVISIONS —

RIVERSIDE COUNTY FLOOD CONTROL AND WATER CONSERVATION DISTRICT

LA SIERRA STORM CHANNEL

STAGE "E"

PLAN AND PROFILE

STA. 0+00 TO STA. 6+00


DESIGNED BY DANIEL R. DAVIS	DRAWN BY [Signature]	CHECKED BY [Signature]	DATE 1-4-66
PROJECT NO. 1-0-060	SHEET NO. 6 of 23	DATE DRAWN JUNE 1965	DISTRICT 1-201

AS BUILT
 PROJECT NO. 1-0-060


PROFILE SHEET
 MORE BOOK NO. 11-28-66
 STRUCTURE NO. 11-28-66

PLAN SHEET
 MORE BOOK NO. 11-28-66
 STRUCTURE NO. 11-28-66


PLATE 1 - PLAN PROFILE - F.A.S.
 CLARENCE W. HARRIS, C.E.
 NO. 10000-1

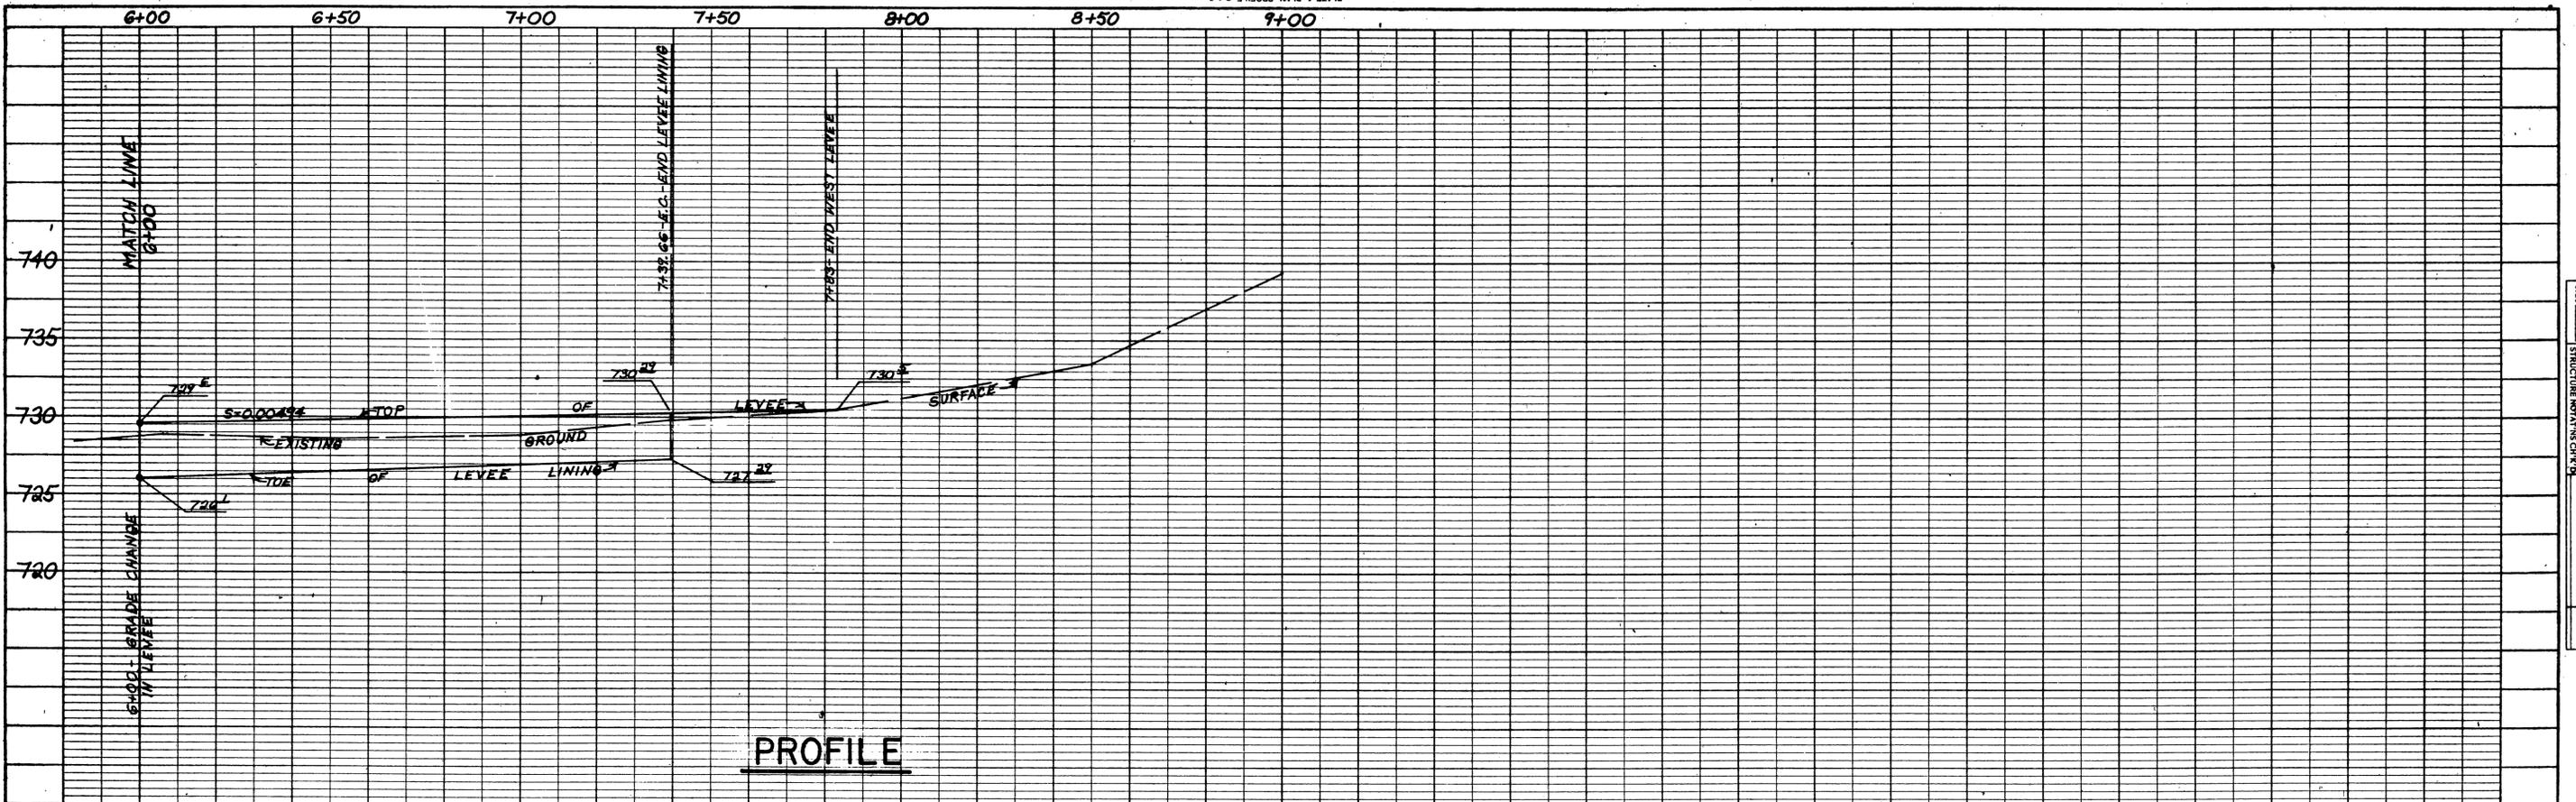

PROFILE

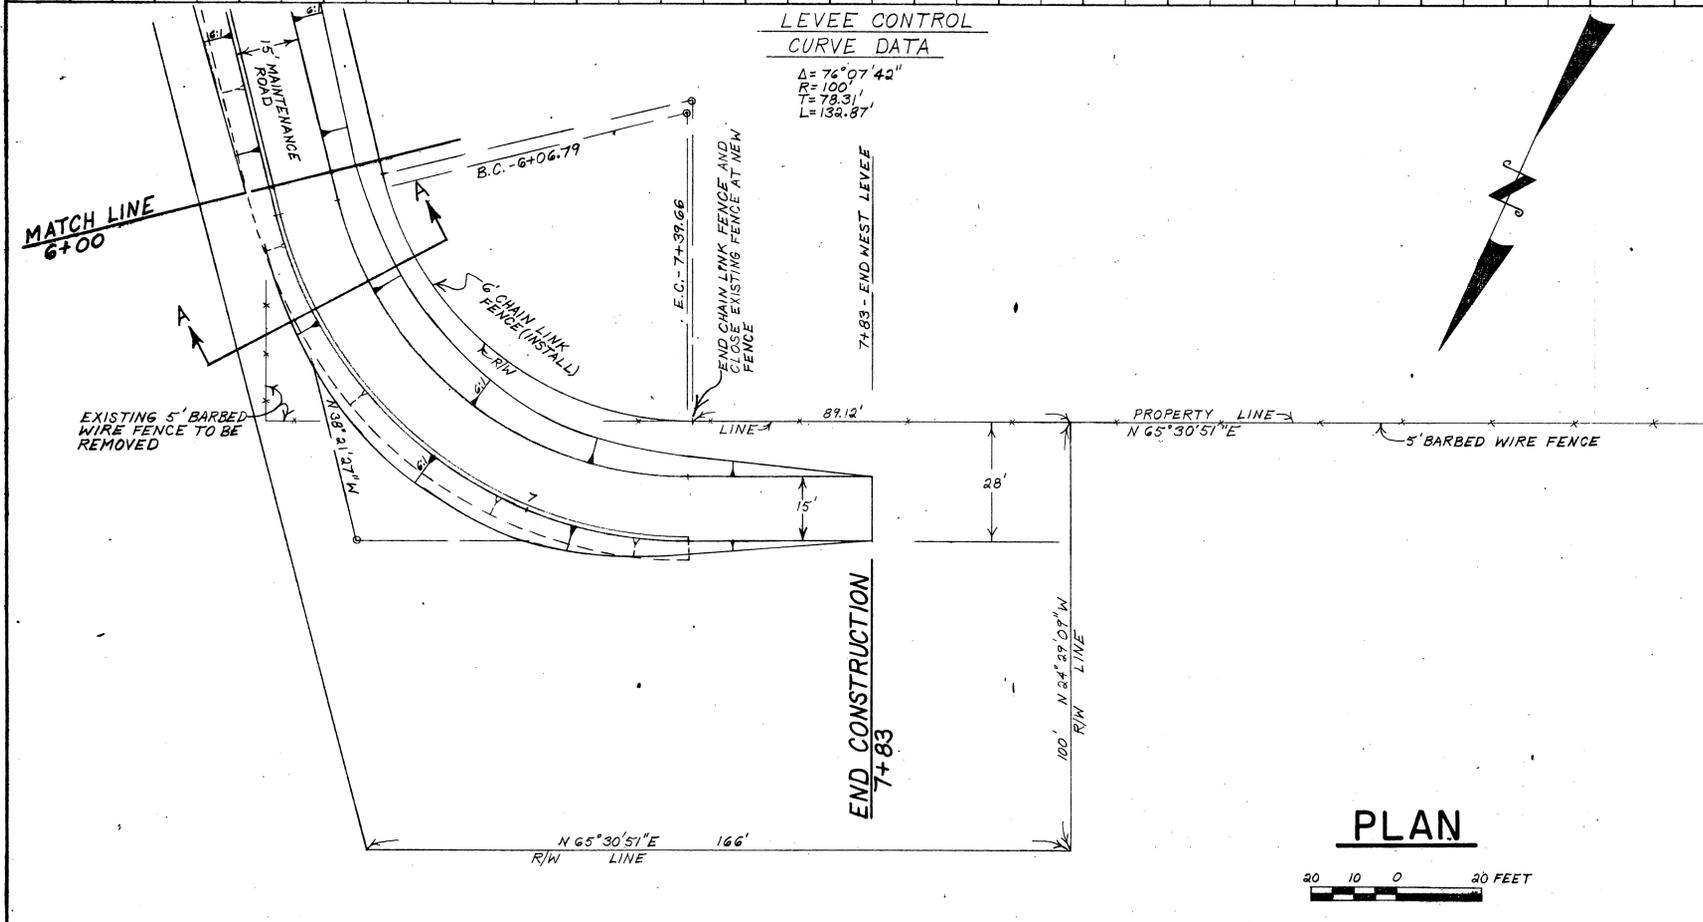


PLAN

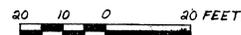


LEVEE CONTROL CURVE DATA

$\Delta = 76^{\circ}07'42''$
 $R = 100'$
 $T = 79.31'$
 $L = 132.87'$

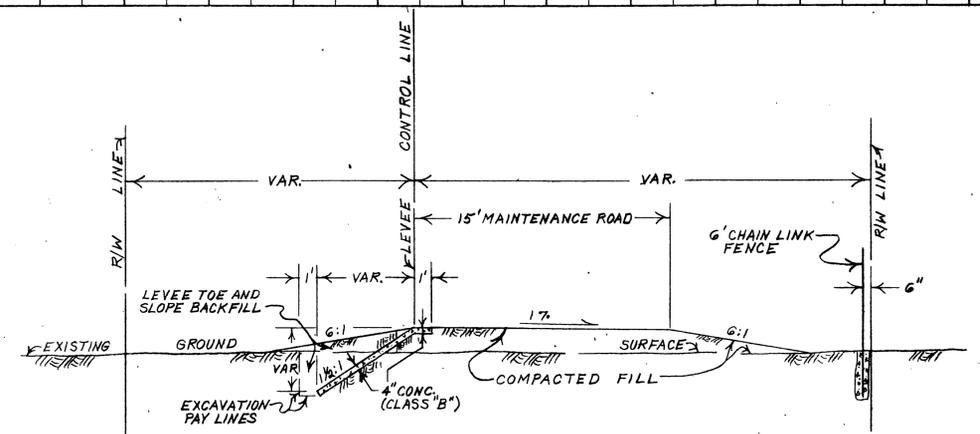

SECTION A-A

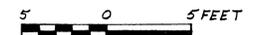


NO CONSTRUCTION CHANGES	11-28-66
DESCRIPTION	A D
— REVISIONS —	
RIVERSIDE COUNTY FLOOD CONTROL AND WATER CONSERVATION DISTRICT	
LA SIERRA STORM CHANNEL	
STAGE "E"	
PLAN AND PROFILE	
STA. 6+00 TO STA. 8+00	
DESIGNER: R. DAVIS	DRAWN: R. DAVIS
TRACER: J. J. [Signature]	CHECKED: J. J. [Signature]
DATE: 1-4-66	DATE DRAWN: JUNE 1965



AS BUILT
 PROJECT NO. I-0-060

PROFILE
 SHEETED
 PLOTTED
 CHECKED
 NO. 11-28-66
 DATE


PLAN
 SHEETED
 PLOTTED
 CHECKED
 NO. 11-28-66
 DATE

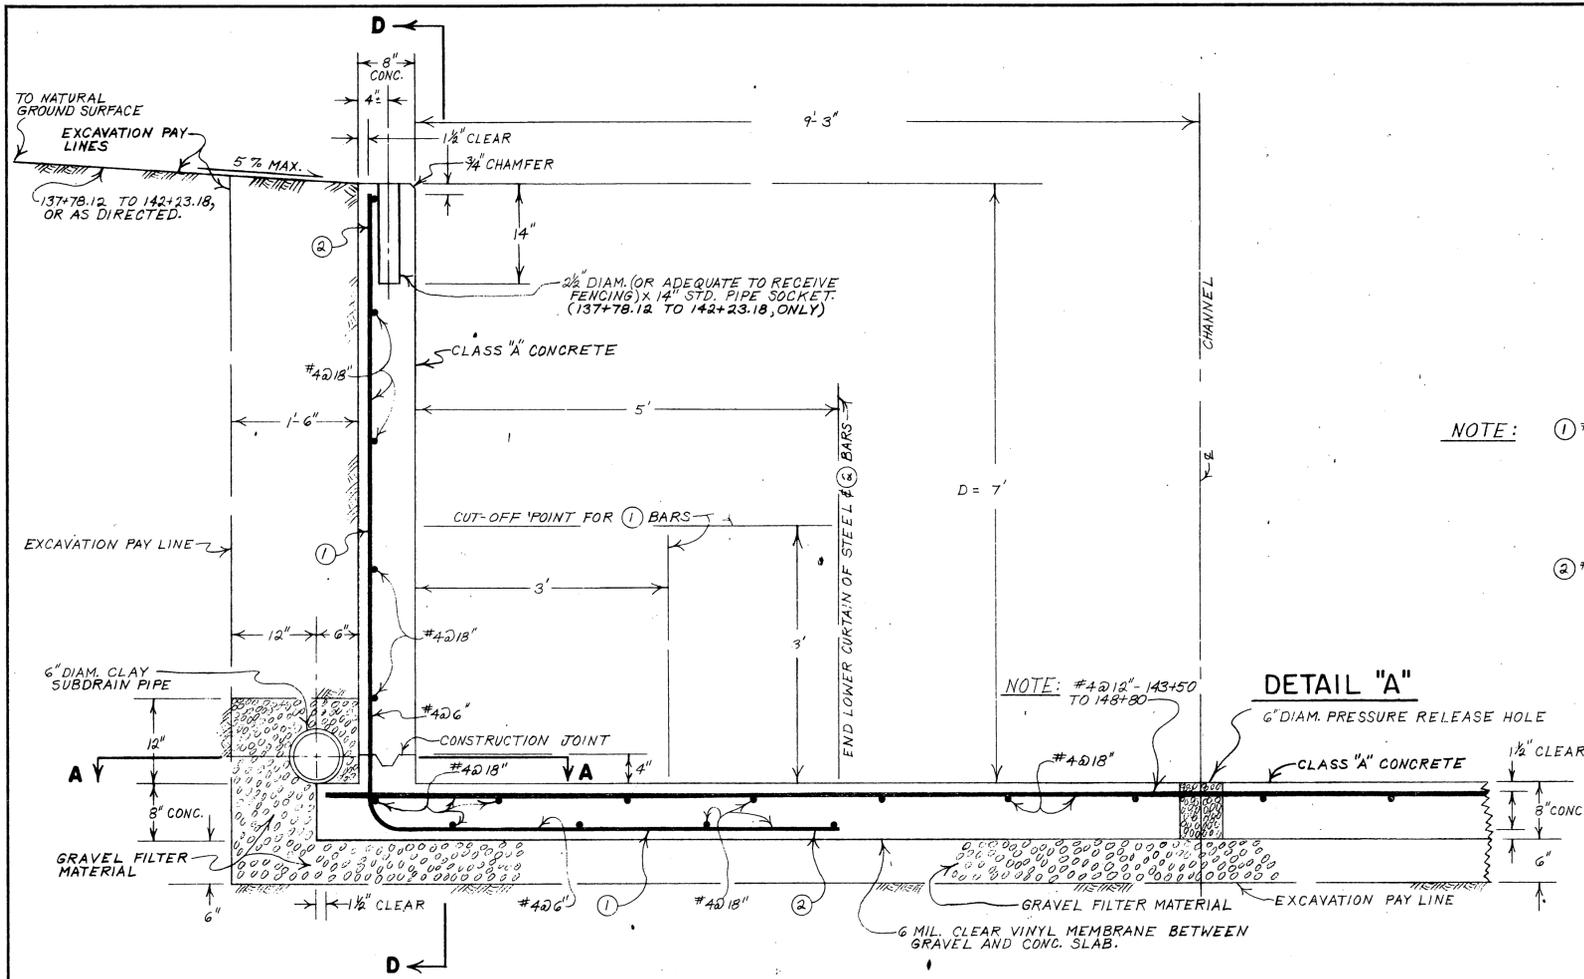


TYPICAL CHANNEL SECTION
 SYMMETRICAL ABOUT C
 137+80.58 TO 140+77.94 & 142+74.09 TO 150+00.70
 EAST OF C - 140+77.94 TO 141+53.18
 WEST OF C - 150+00.70 TO 150+89.01

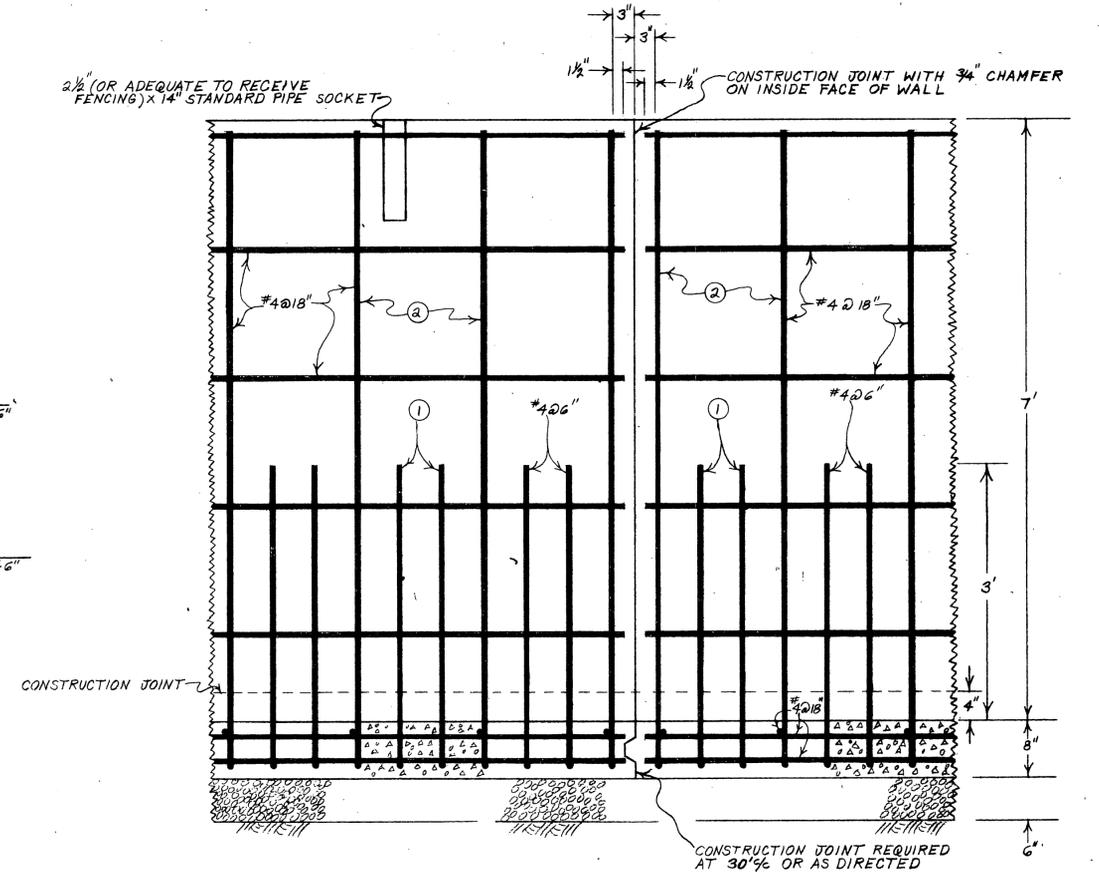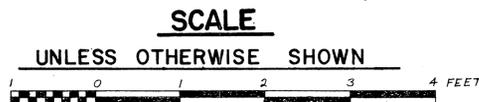

SECTION D-D


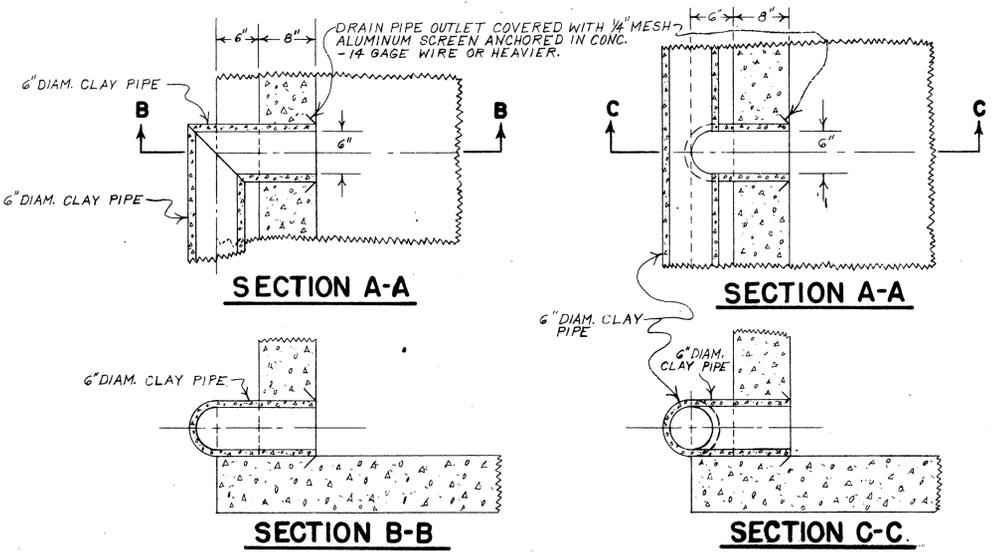


TYPICAL SUBDRAIN TERMINAL DETAILS
 DETAIL "C"
TYPICAL SUBDRAIN BLEEDER DETAILS
 DETAIL "B"
 BOTH WALLS OF CHANNEL 200%

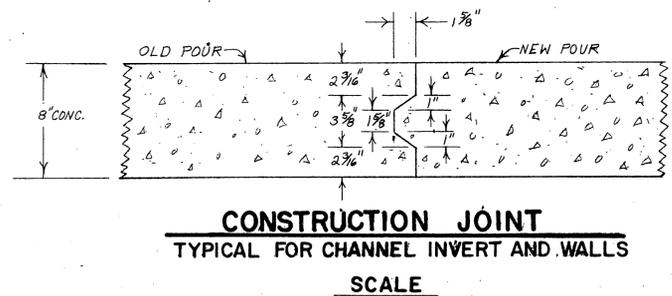


SCALE
 AS BUILT
 PROJECT NO. I-O-060


NO CONSTRUCTION CHANGES	11-21-66
DESCRIPTION	APPROVED DATE
— REVISIONS —	
RIVERSIDE COUNTY FLOOD CONTROL AND WATER CONSERVATION DISTRICT	
LA SIERRA STORM CHANNEL	
STAGE "E"	
CHANNEL DETAILS	
APPROVED: <i>[Signature]</i>	DATE: 1-11-66
CHECKED: <i>[Signature]</i>	DATE DRAWN: JUNE 1965
DRAWN: R. DAVIS	SHEET No. 8 of 23
PROJECT NO. I-O-060	DWG. No. 1-201

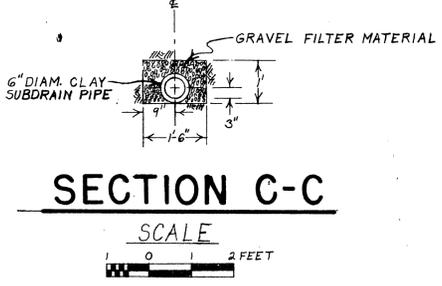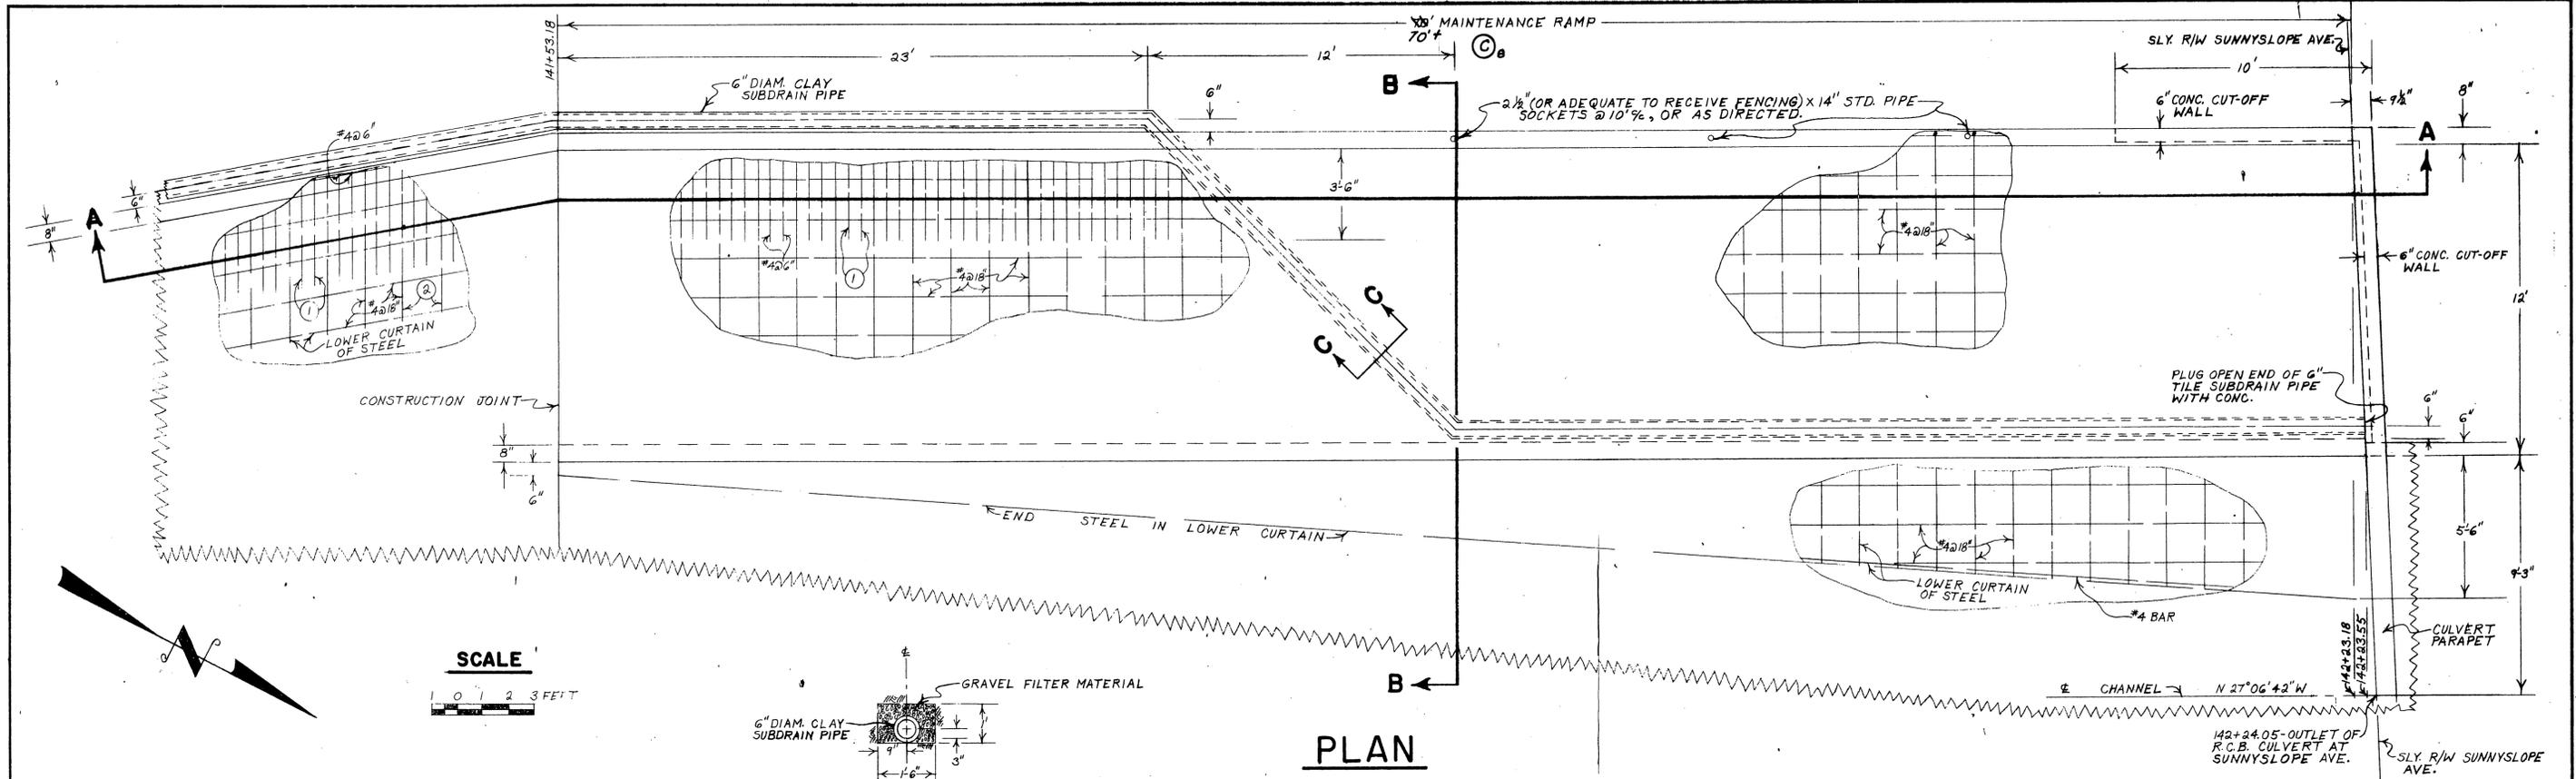

SECTION C-C

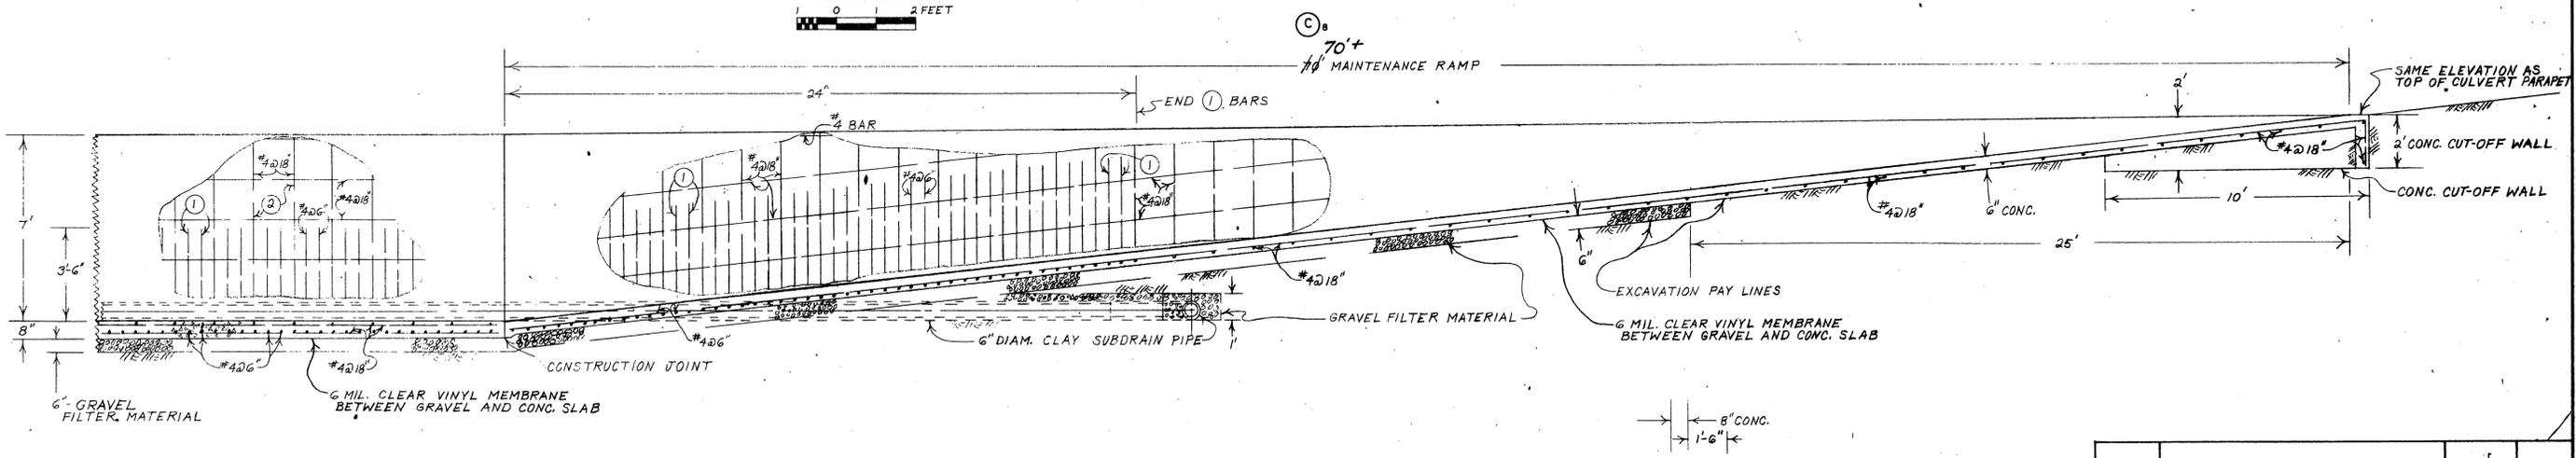

SECTION A-A

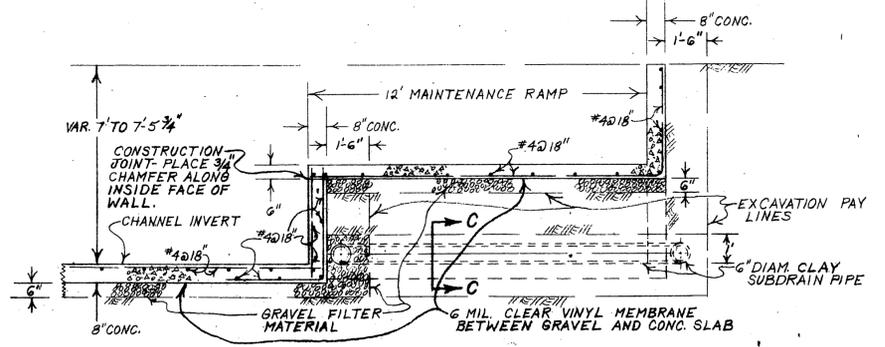


SECTION B-B


- NOTE :
- ① #4 BAR: 4"
 - ② #4 BAR: 7.5"

C 8	CONSTRUCTION CHANGE	APV	11-28-66
REFERENCE	DESCRIPTION	APPROVED	DATE
- REVISIONS -			
REVISED DATE	RIVERSIDE COUNTY FLOOD CONTROL AND WATER CONSERVATION DISTRICT		
	LA SIERRA STORM CHANNEL		
	STAGE "E"		
	SUNNYSLOPE AVE. RAMP DETAILS		
APPROVED:	DATE: 1-24-66	CHECKED:	DATE DRAWN: JUNE 1965
DRAWN: R. DAVIS	TRACED:	SHEET NO. 9 of 23	DWG. NO. 1-201



AS BUILT
PROJECT NO. 1-0-060

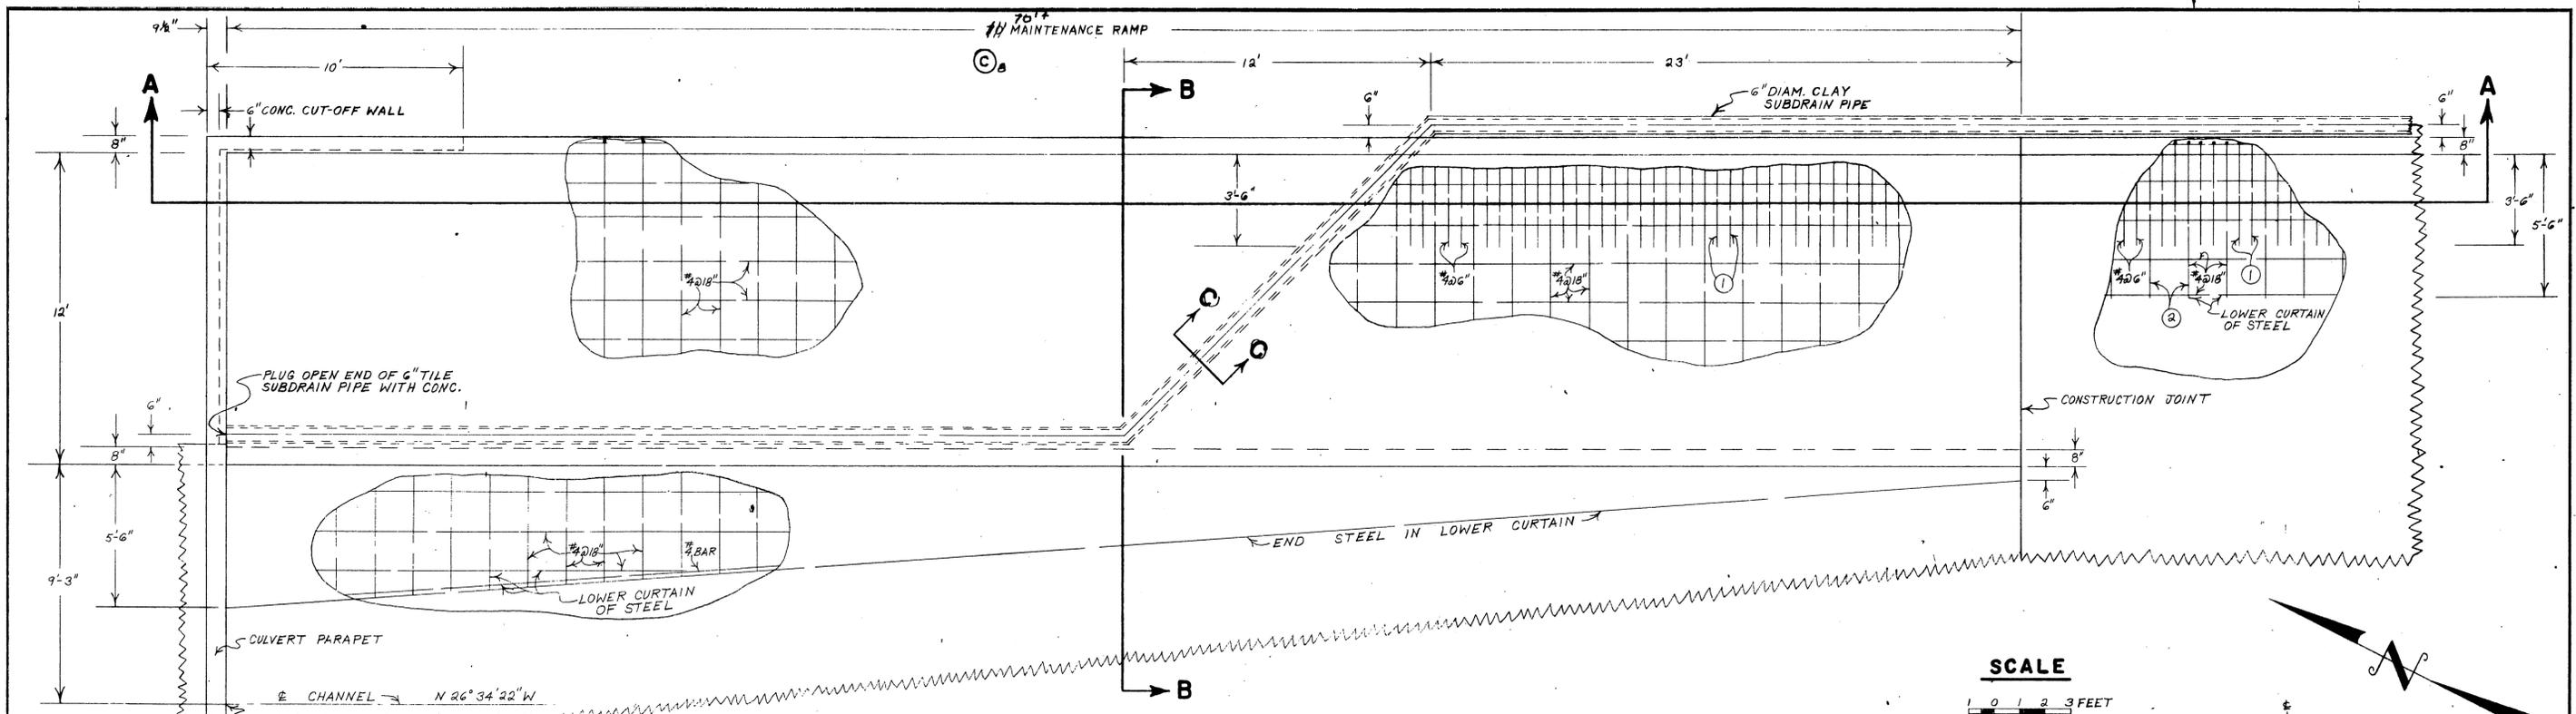



PLAN

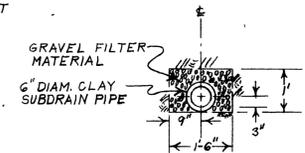


SECTION C-C

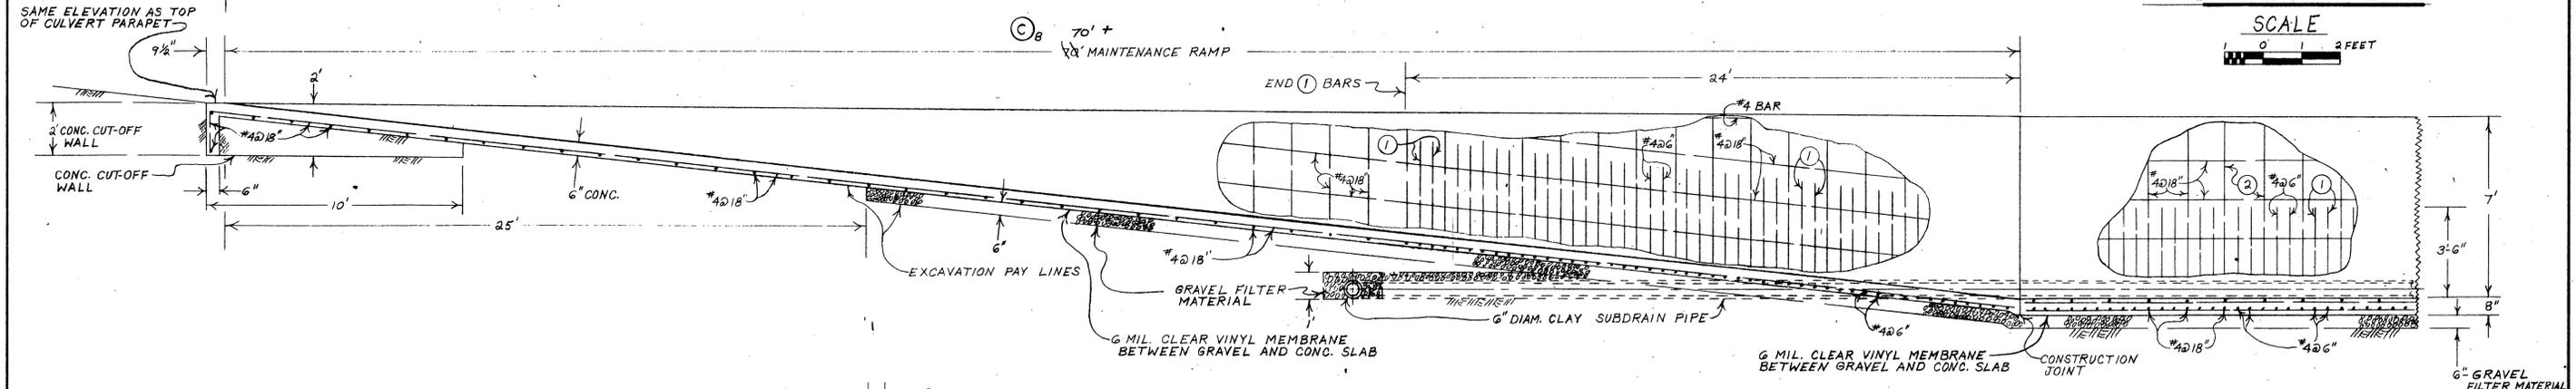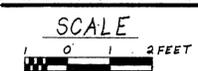

SECTION A-A

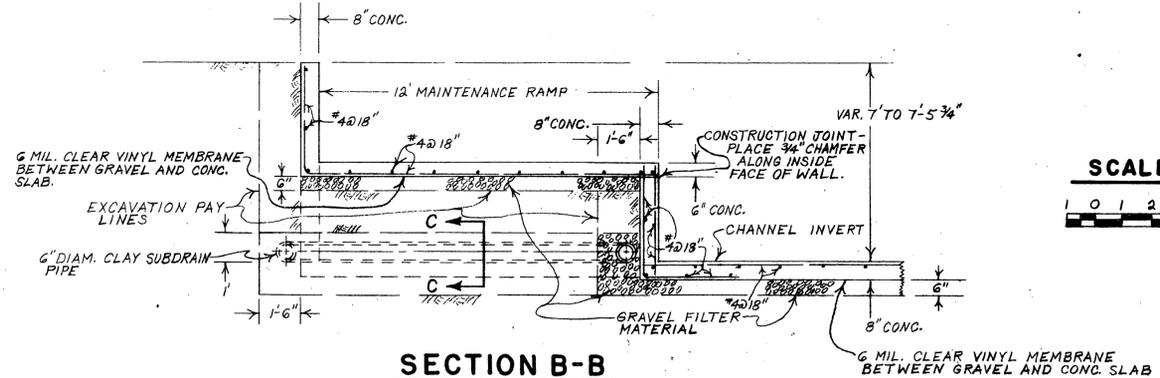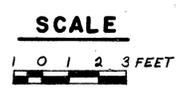


SECTION B-B

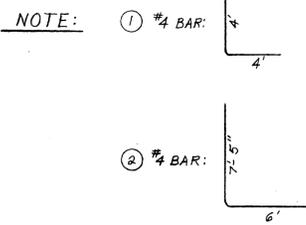


C 6	CONSTRUCTION CHANGE	<i>[Signature]</i>	1/28/66
REFERENCE	DESCRIPTION	APPROVED	DATE
- REVISIONS -			
REVISED DATE	RIVERSIDE COUNTY FLOOD CONTROL AND WATER CONSERVATION DISTRICT		
	LA SIERRA STORM CHANNEL STAGE "E"		
	NORWOOD AVE. RAMP DETAILS		
APPROVED: <i>[Signature]</i>	DRAWN: R. DAVIS	SHEET NO. 10 of 23	
CHECKED: <i>[Signature]</i>	DATE DRAWN: JAN 1965	DATE: 1-21-66	


AS BUILT
PROJECT NO. 1-0-060

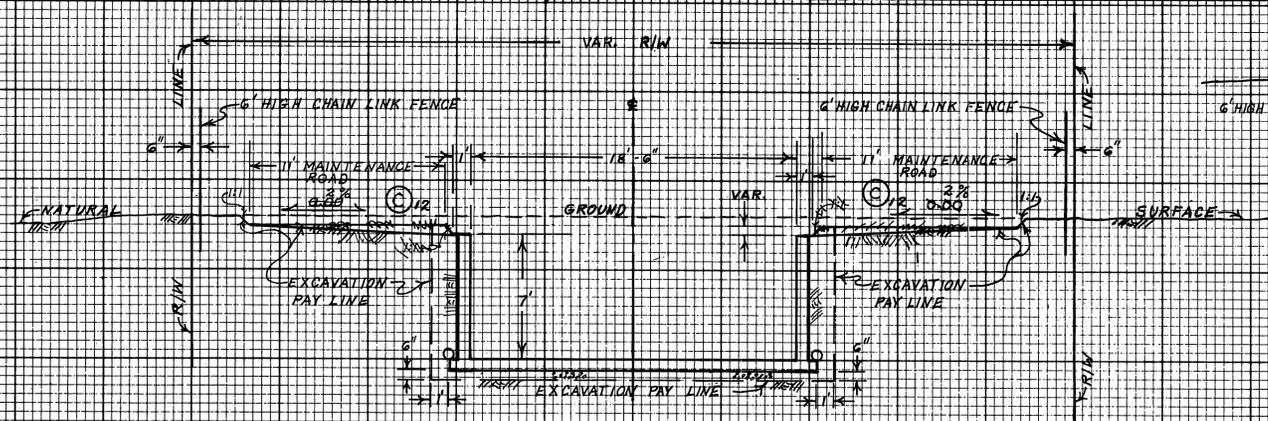


TYPICAL SECTION
142+74.09 TO 143+50

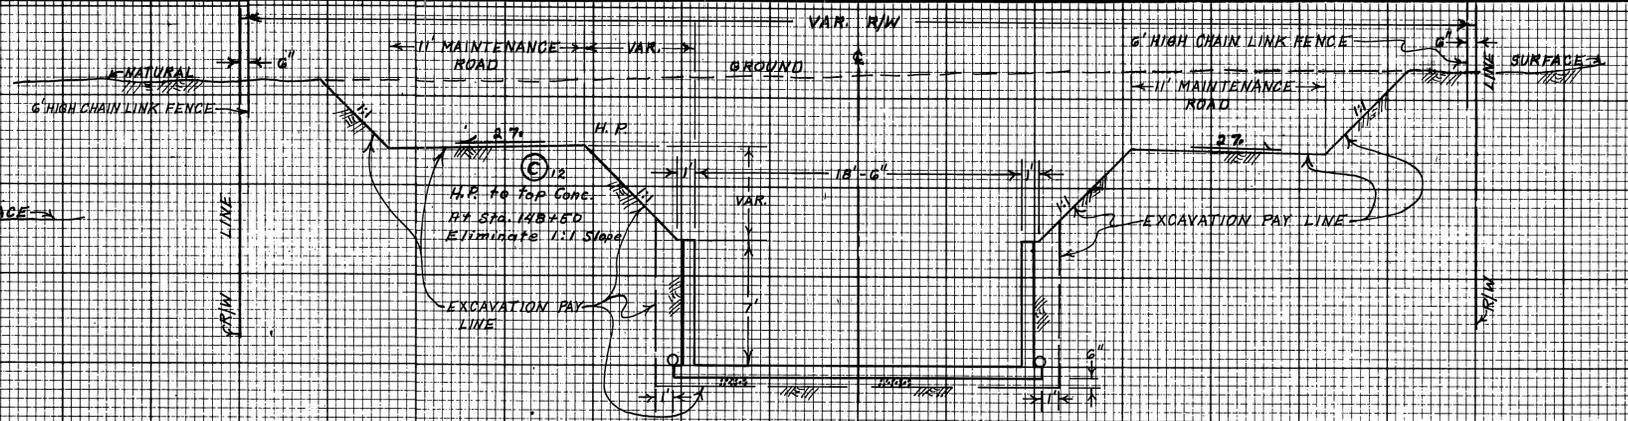

TYPICAL SECTION
144+00 TO 148+50

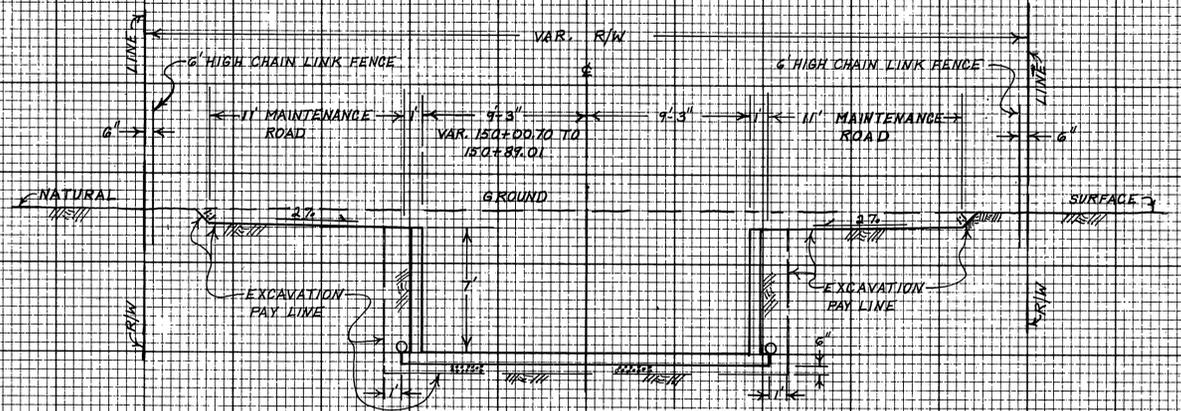

TYPICAL SECTION
149+00 TO 150+89.01

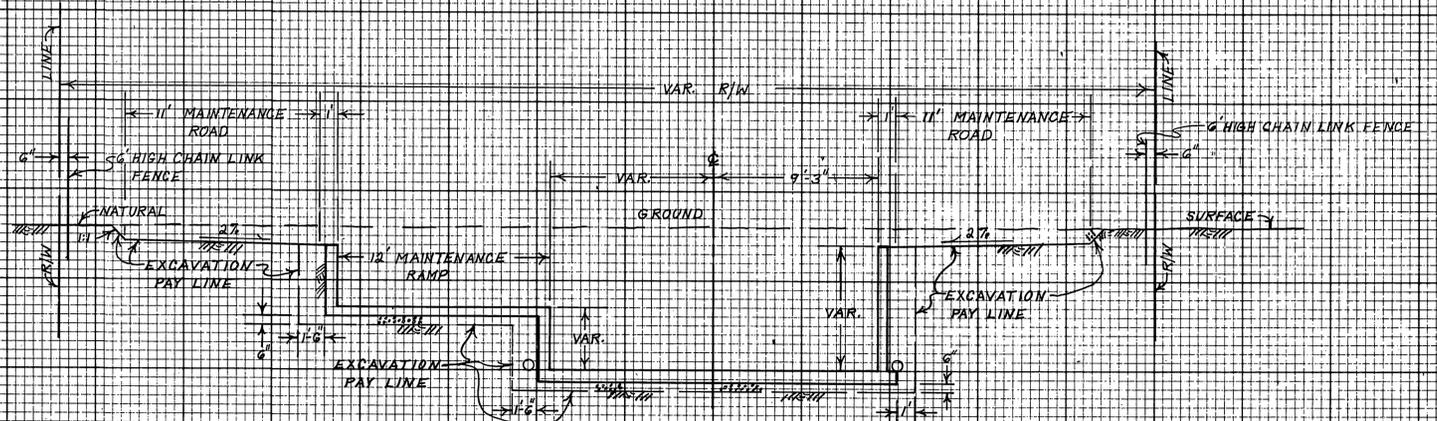

TYPICAL SECTION
150+89.01 TO 151+59.01

NOTE: REFER TO SH. NO. 8 FOR ADDITIONAL DETAILS.



C12	CONSTRUCTION CHANGE	JCD	11/28/66
REFERENCE	DESCRIPTION	APPROVED	DATE

REVISIONS			
REVISED DATE	DESCRIPTION	APPROVED	DATE
RIVERSIDE COUNTY FLOOD CONTROL AND WATER CONSERVATION DISTRICT LA SIERRA STORM CHANNEL STAGE "E" CHANNEL SECTIONS			
APPROVED: <i>[Signature]</i>	DRAWN: R. DAVIS	CHECKED: <i>[Signature]</i>	12 of 23 SHEET NO.
DATE: 1-4-66	DATE DRAWN: OCT. 1965	DWG. NO. 1-201	

MISSING SHEET

DESIGN NOTES

SPECIFICATIONS:

DESIGN: A.A.S.H.O. DATED 1957 WITH REVISIONS AND AS SUPPLEMENTED BY BRIDGE PLANNING AND DESIGN MANUAL.

SECTIONS DESIGNED FOR CULVERT IN A TRENCH ON HARD FOUNDATION, OR CULVERT UNTRENCHED ON YIELDING FOUNDATION. FOR CULVERTS ON PILES OR ROCK FOUNDATIONS SPECIAL DESIGN WILL BE REQUIRED.

LOADING:

LIVE LOAD = H20-S16-44 OR ALTERNATIVE WITH 30% IMPACT FOR ALL COVER DEPTHS. NEGLECT LIVE LOAD WHEN ON SINGLE SPANS, COVER IS MORE THAN 8' AND EXCEEDS SPAN, AND ON MULTIPLE SPANS WHEN COVER EXCEEDS DISTANCE BETWEEN EXTERIOR WALLS.

CULVERTS AT GRADE TREATED AS A BRIDGE, WITH THE WHEEL LOAD ON THE INVERT SLAB DISTRIBUTED OVER 7.5' TRANSVERSELY AND THE BREADTH OF THE CULVERT LONGITUDINALLY.

WHEEL LOADS DISTRIBUTED UNIFORMLY OVER A SQUARE, THE SIDES OF WHICH ARE 1.75 TIMES THE DEPTH OF FILL, BUT NOT LESS TRANSVERSELY THAN THE DIMENSION FOR GRADE TOP ON THE TOP SLAB, AND NOT LESS THAN 7.5' ON THE INVERT SLAB. WHEN SUCH AREAS FROM SEVERAL CONCENTRATIONS OVERLAP, THE TOTAL LOAD SHALL BE CONSIDERED AS UNIFORMLY DISTRIBUTED OVER THE AREA DEFINED BY THE OUTSIDE LIMITS OF THE INDIVIDUAL AREAS, BUT THE TOTAL WIDTH SHALL NOT EXCEED THE TOTAL WIDTH OF THE SUPPORTING SLAB.

DEAD LOAD: EARTH LOAD OF 120 LBS. PER CU. FT. AND AN EQUIVALENT FLUID PRESSURE OF 36 LBS. PER SQ. FT. (BOTH REDUCED 30% FOR BALANCED DESIGN).

DISTRIBUTION OF WHEEL AT GRADE; $E = .175S + 3.2$

UNIT STRESSES: $F_s = 20,000$ P.S.I., $N = 10$

$F_c = 1,200$ P.S.I.

REINFORCEMENT EMBEDMENT IS 1/2 DIA. CLEAR, MIN. 1", EXCEPT AS NOTED.

DISTRIBUTION "d" BARS EXPRESSED AS A % OF MAIN REINFORCEMENT:

CLASSIFICATION "A" TOP SLAB = $\frac{100}{SPAN}$, MAX. 50%

CLASSIFICATION "A" BOTTOM SLAB = MIN. #4 @ 18

CLASSIFICATION "B", OR ABOVE, TOP AND BOTTOM SLABS MIN. #4 @ 18

CONSTRUCTION NOTES

SPECIFICATIONS: STANDARD SPECIFICATIONS, DIVISION OF HIGHWAYS, CURRENT EDITION AND SPECIAL PROVISIONS ACCOMPANYING PLANS.

EXPANSION JOINTS: NONE IN INVERT SLAB. UNDER COVER LESS THAN SPAN LENGTH, PLACE 1/2" EXPANSION JOINT FILLER IN TOP SLAB AND SIDE WALLS IN DIVIDING STRIP OR OUTSIDE SHOULDER. UNDER COVER MORE THAN SPAN LENGTH, PLACE EXPANSION JOINTS IN TOP SLAB AND SIDE WALLS ONLY AT 30' ± CENTERS, AND ADDITIONAL JOINTS AS DIRECTED BY THE ENGINEER AT LOCATIONS OF CHANGE OF FOUNDATION CHARACTER.

CONSTRUCTION LOADS: CONSTRUCTION LOADS HEAVIER THAN LEGAL LOADS NOT PERMITTED UNTIL CONCRETE HAS REACHED A STRENGTH OF 3,000 P.S.I. AND STRUCTURE STRUTTED AND CUSHIONED AS DIRECTED BY THE ENGINEER.

LOCATION NOTES

HYDRAULICS: IF SLOPE OF NATURAL CHANNEL EXCEEDS "NEUTRAL SLOPE" OF CULVERT ENTRANCE, CAPACITY FOR 10 YEAR FLOOD (Q10) WILL USUALLY DETERMINE SIZE. OTHERWISE COMPUTE TOTAL HEAD = $\frac{(Q100)^2}{8A} + \frac{(1.05+KL)}{100}$, WHERE "k" IS HEAD FACTOR "A" IS AREA, "L" IS LENGTH OF CULVERT AND Q100 THE 100 YEAR FLOOD, AND COMPARE WITH ALLOWABLE HEAD. TABULATED ELEMENTS ARE FOR FULL NOMINAL SECTION.

DESIGNATION: SHOW ON PLANS AS SPAN X HEIGHT STRENGTH CLASSIFICATION X LENGTH: THUS 4 x 4 - A x 60', FOLLOWED BY ALTERNATIVES.

ALTERNATIVES: INVERT WILL BE SLOPED UNLESS "TRAPEZOIDAL INVERT", "FLAT INVERT" OR "V INVERT" IS INCLUDED IN DESIGNATION. ENDS OF CULVERT WILL BE ROUNDED UNLESS "SQUARE ENDS" ARE DESIGNATED. PARAPET ON CULVERTS WITH OVER 2' COVER WILL BE 0'-9" UNLESS "___ FT. PARAPET" IS DESIGNATED. SUCH DESIGNATIONS MAY BE DIFFERENT FOR INLET AND OUTLET ENDS.

QUANTITIES: QUANTITIES ARE FOR ESTIMATING ONLY. THEY ARE FOR THE SLOPED INVERT SLAB AND DO NOT INCLUDE SPLICES IN LONGITUDINAL BARS NOR CONCRETE AND REINFORCEMENT FOR SPECIAL COVERAGE, NOR TEMPERATURE REINFORCEMENT FOR GRADE TOP CULVERT.




SPECIAL COVERAGE: WHERE CULVERTS ARE EXPOSED TO ACTION OF SALT WATER THICKNESS OF CONCRETE SHALL BE INCREASED TO PROVIDE 4" COVERAGE BETWEEN STEEL AND EXPOSED SURFACES. WHERE SCOUR IS ANTICIPATED, THICKNESS OF BOTTOM SLAB SHALL BE INCREASED TO PROVIDE 2" MINIMUM COVERAGE BETWEEN STEEL AND EXPOSED SURFACE.

USE OF STANDARD PLAN



"STRENGTH CLASSIFICATION", SYMBOLIZED BY THE LETTERS "A", "B", "C" ETC., AT THE TOP OF THE DATA TABLE IS MERELY A CONVENIENT DESIGNATION FOR A PARTICULAR STRUCTURAL SECTION FOR A CULVERT OF ANY GIVEN OPENING. IT IS DICTATED BY THE COVER OR DEPTH OF FILL OVER THE TOP SLAB.

REDUCED PLAN


USE SCALE BELOW

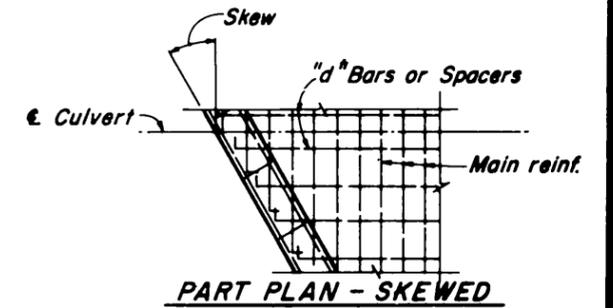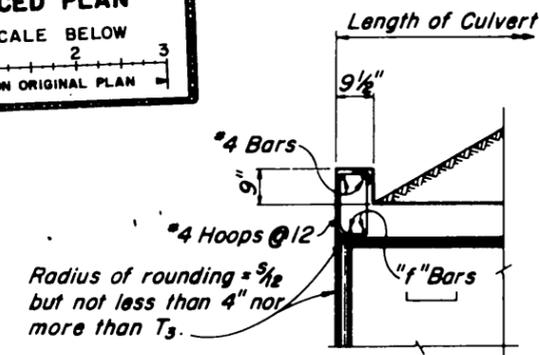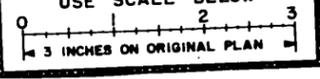

PARAPET DETAILS FOR SINGLE SPAN CULVERTS

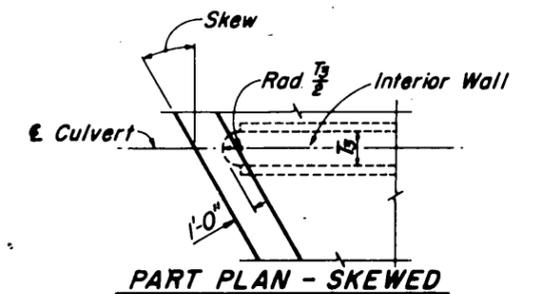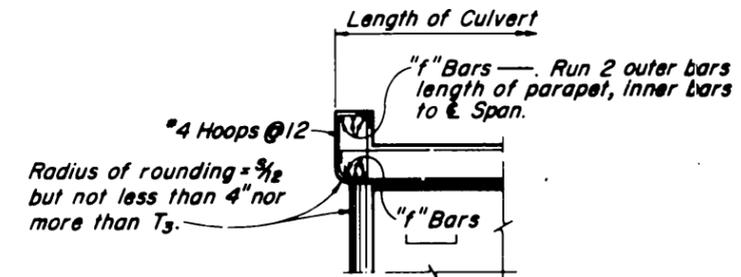


PARAPET DETAILS FOR MULTIPLE SPAN CULVERTS

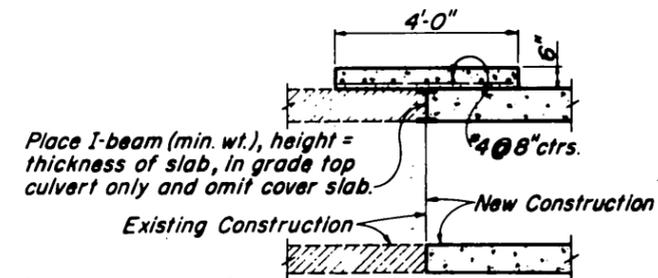

CULVERT EXTENSION

SKEWED PARAPETS								
Skew Angle	Span	3	4	5	6	8	10	12
0°-15°	Bar No.	4	4	5	6	6	7	8
	No. of bars	2	2	2	2	3	3	3
16°-30°	Bar No.	4	4	5	6	7	8	8
	No. of bars	2	3	3	3	3	3	3
31°-45°	Bar No.	4	4	6	6	7	8	8
	No. of bars	3	3	3	3	3	3	3
0°-45°	#4 Hoops	12" ctrs.						

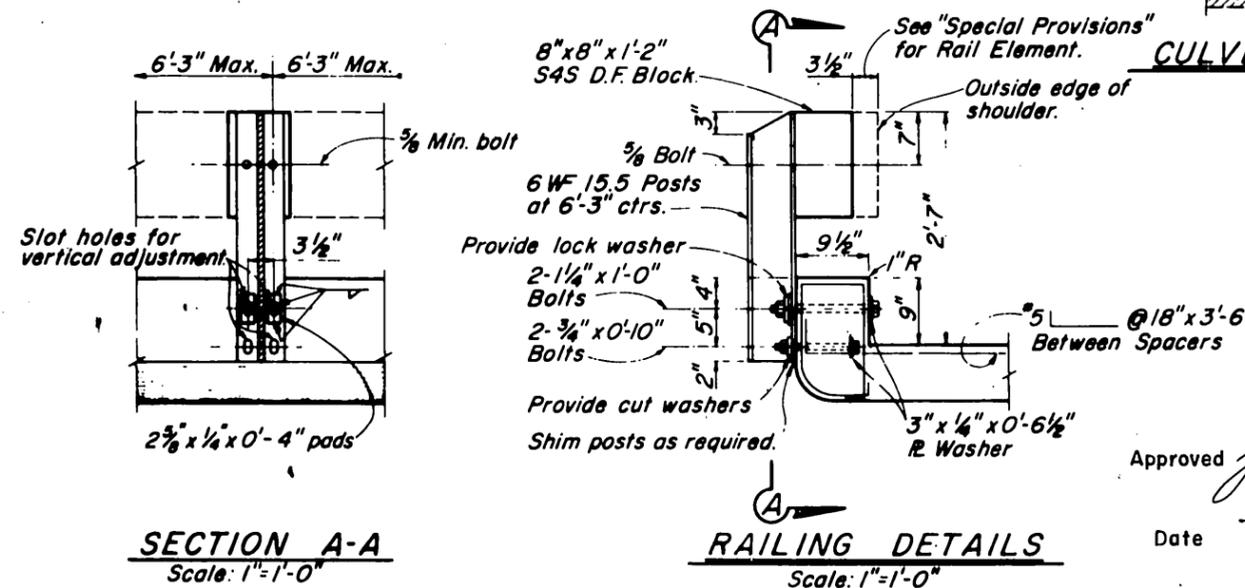

RAILING DETAILS

SECTION A-A

Scale: 1"=1'-0"




Approved *John W. Bryant*
CHIEF ENGINEER R.E. 8822

Date 7-24-66


PROJECT NO. I-0-060

STANDARD BOX CULVERT			
MISCELLANEOUS DETAILS			
SCALE	BRIDGE	FILE	Sh. 14 of 23


For Gate Width up to 6' - 2.846" O.D. Std. Pipe
 Over 6' to 13' - 3.960" O.D. Std. Pipe.
 Over 13' to 18' - 6.599" O.D. Std. Pipe.

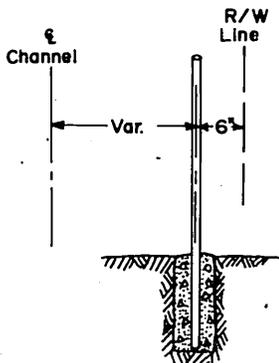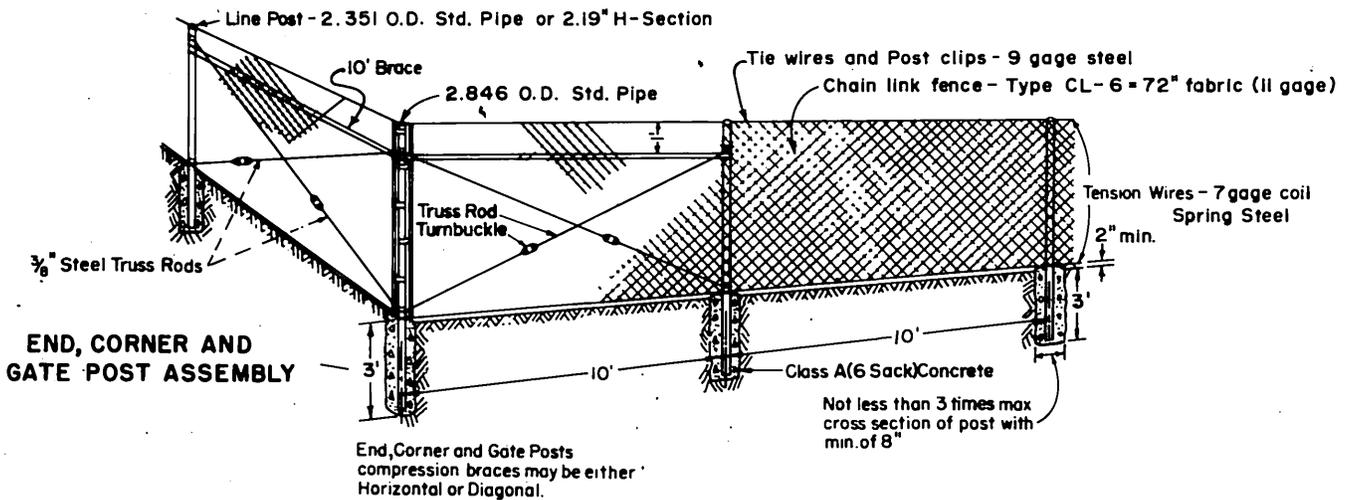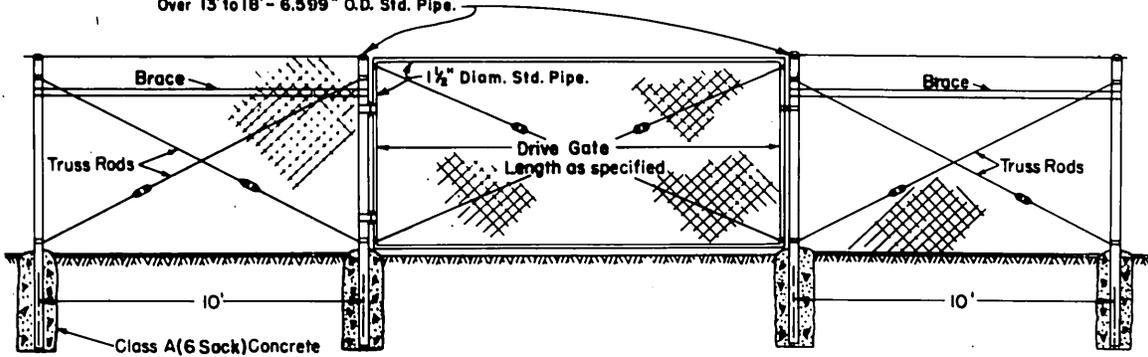

TYPICAL FOR FENCE
 ALONG R/W LINE

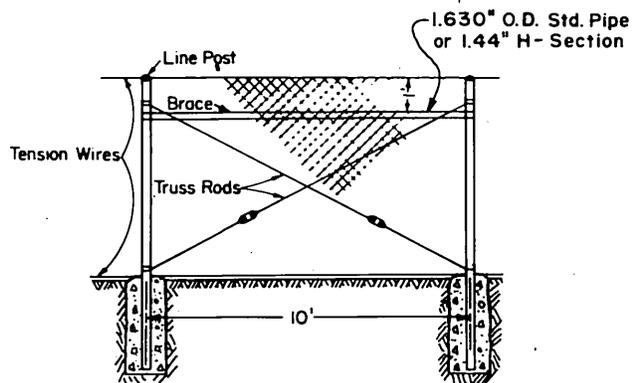


Line post at 1,000' maximum intervals
 braced and trussed in both directions.

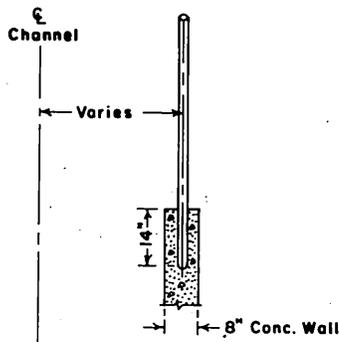

TYPICAL FOR FENCE
 IN CHANNEL WALL

PROJECT NO.
 1-0-060

REVISIONS	RIVERSIDE COUNTY FLOOD CONTROL AND WATER CONSERVATION DISTRICT		
	LA SIERRA STORM CHANNEL STAGE "E"		
	CHAIN LINK FENCE		
	DATE: 1-4-66	DRONE: R. DAVIS	15 of 23
APPROVED: <i>[Signature]</i>	TRACER:	SHEET NO.	
CHECKED: <i>[Signature]</i>	CHECKER:	DATE DRAWN: OCT. 1965	
DATE: 1-4-66	DATE DRAWN: OCT. 1965	Dist. No. 1-201	

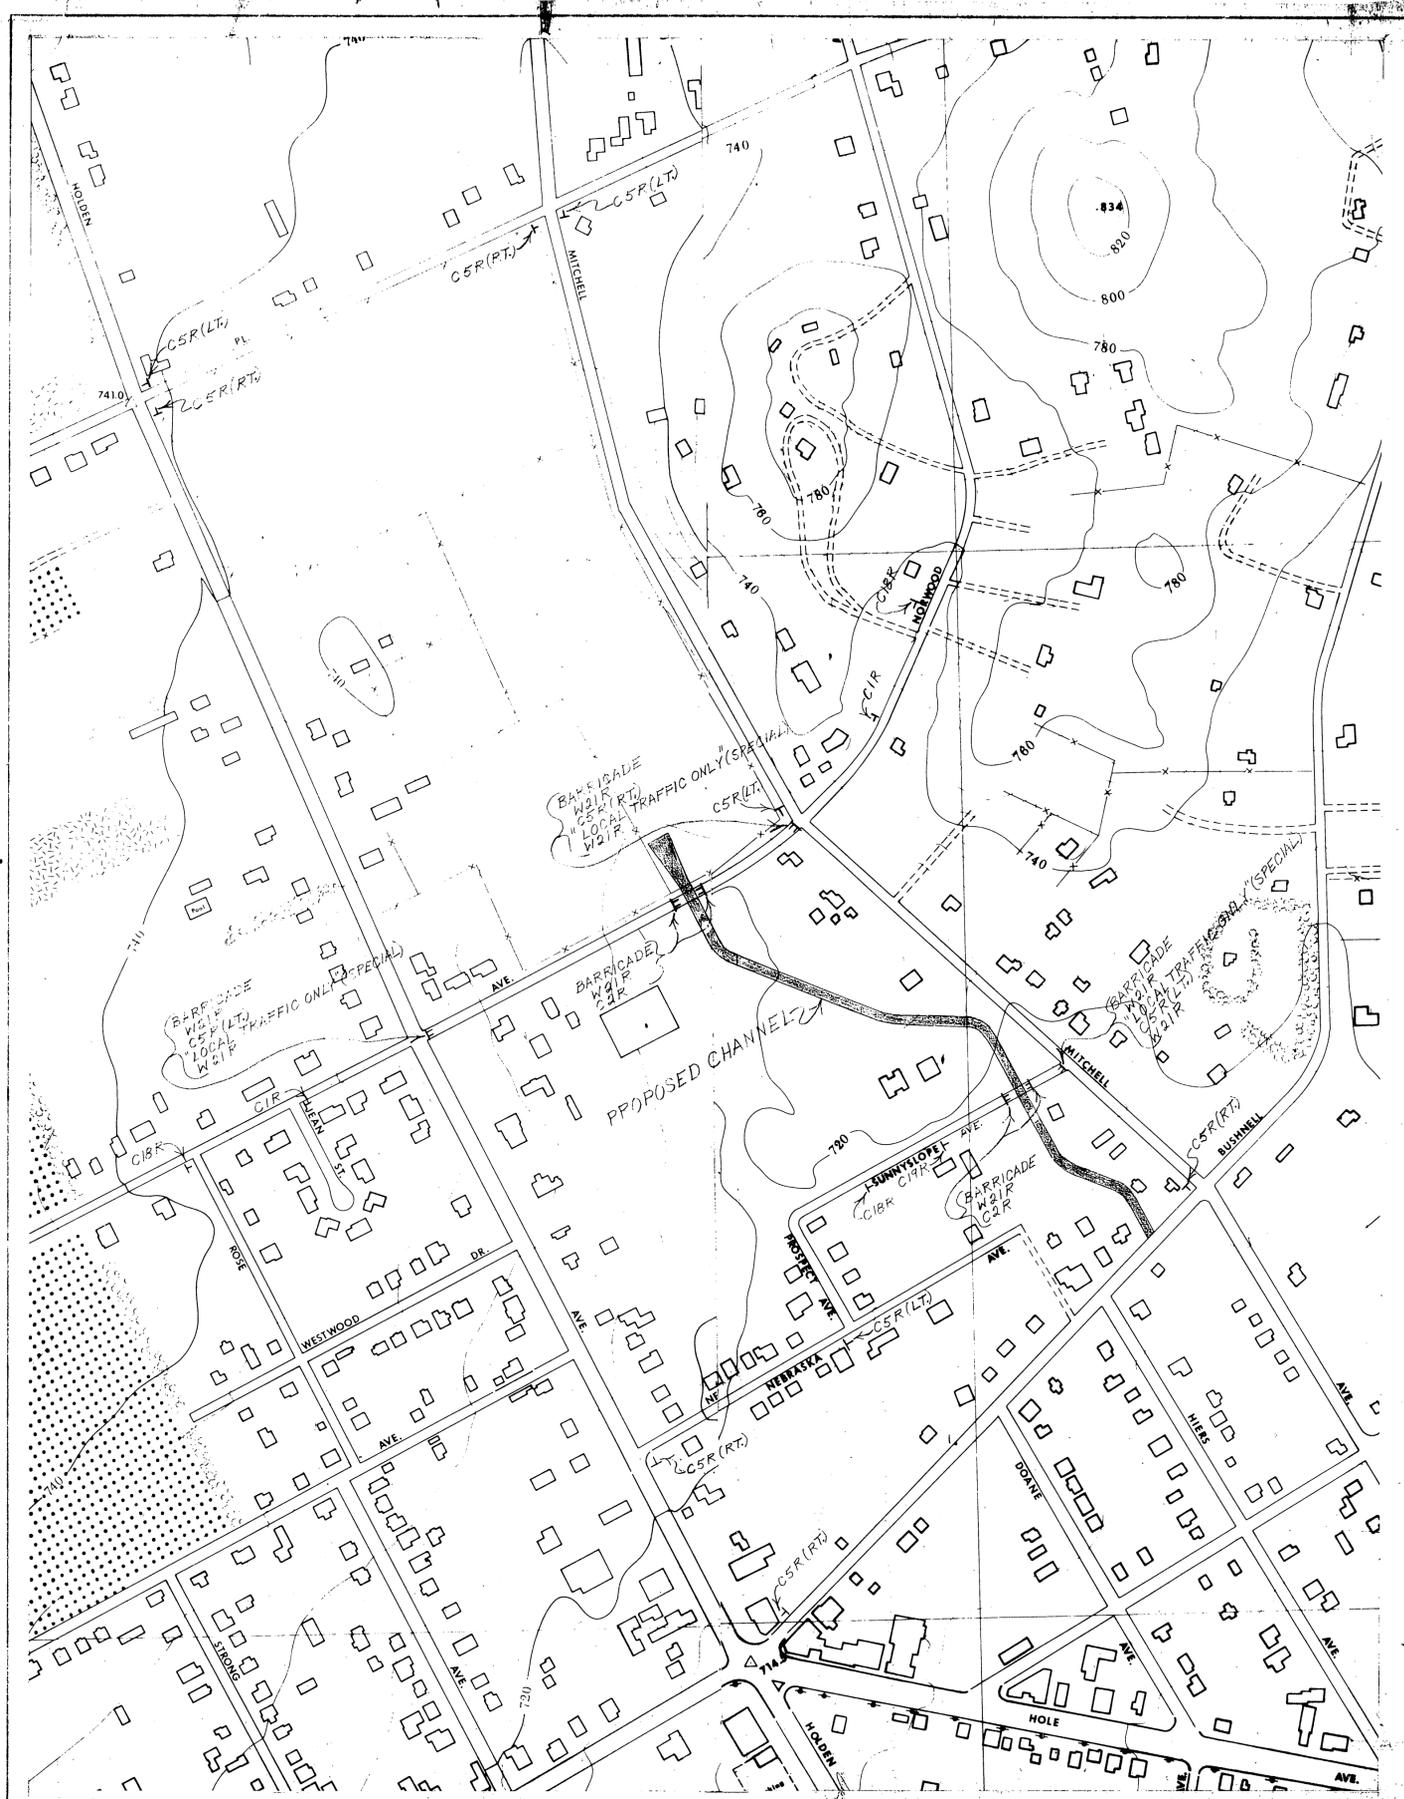


GENERAL NOTES

1. THIS DRAWING SHOWS THE TRAFFIC CONTROL PLAN.
2. ACCESS TO PRIVATE PROPERTY SHALL BE MAINTAINED AT ALL TIMES.
3. SUNNYLOVE AVE. AND NORWICH AVE. WILL BE CLOSED SIMULTANEOUSLY.
4. THE CONTRACTOR SHALL NOTIFY THE FOLLOWING AGENCIES AT LEAST FORTY EIGHT (48) HOURS PRIOR TO CLOSING ANY STREET.


	<u>TEL. NO.</u>
A. RESIDENT ENGINEER	
B. RIVERSIDE FIRE DEPARTMENT	787-7323
C. RIVERSIDE POLICE DEPARTMENT	787-7011
D. RIVERSIDE TRAFFIC DIVISION	787-7366
E. PROPERTY OWNERS ON THE BLOCKS TO BE CLOSED.	
5. BARRICADES AND SIGNS SHALL CONFORM TO THE STANDARDS SHOWN IN THE SPECIAL PROVISIONS.
6. LOCAL TRAFFIC ONLY - SPECIAL SIGN
7. THE LIMITS OF THE DESIGNATED DISPOSAL AREAS WILL BE FLAGGED DURING CONSTRUCTION.

APPROVED _____ DATE _____	
RIVERSIDE COUNTY FLOOD CONTROL AND WATER CONSERVATION DISTRICT	
LA SIERRA STORM CHANNEL STAGE "E"	
BASIC DETOUR PLAN	
DRAWN: R. DAVIS	SHEET NO. 17 of 23
APPROVED: <i>[Signature]</i>	CHECKED: _____
DATE: 1-11-66	DATE DRAWN: OCT. 1965


D-173E
PROJECT NO. I-O-060

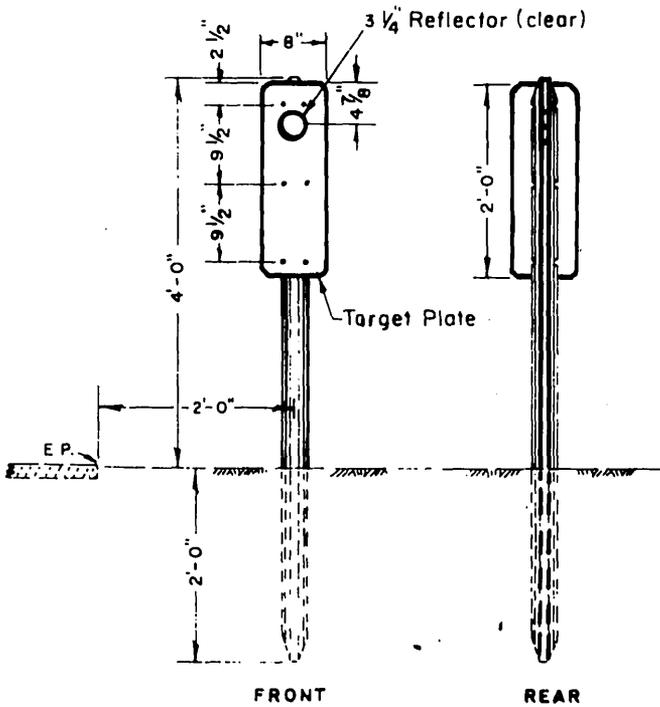


GUIDE MARKER

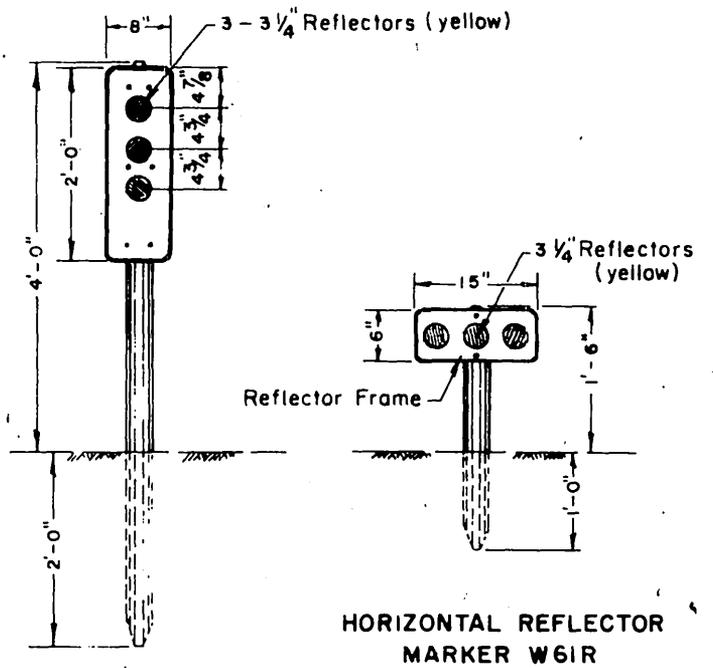

HORIZONTAL REFLECTOR MARKER W61R

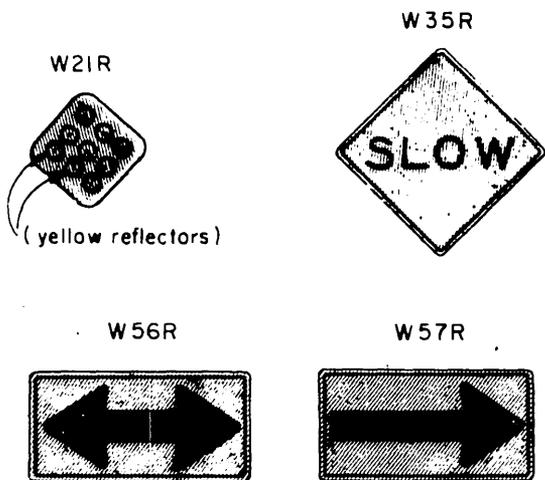

CLEARANCE MARKER

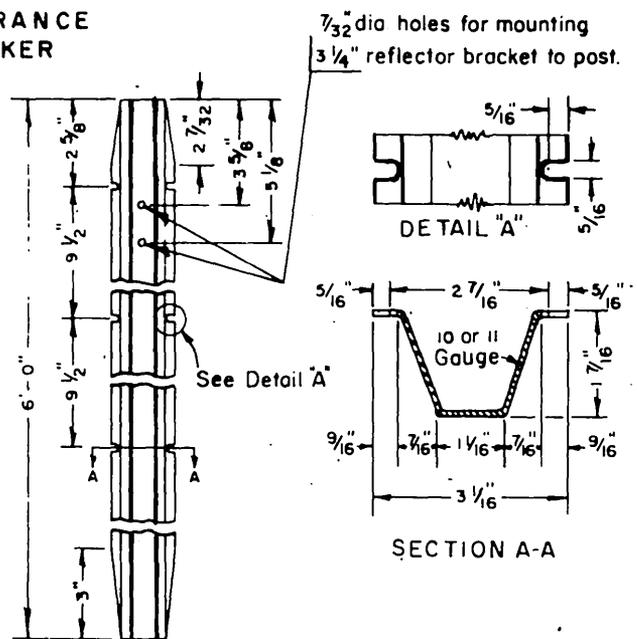

METAL MARKER POST








COLOR LEGEND

- White
- Yellow
- Black

ADAPTED FROM STATE OF CALIFORNIA, DEPT. OF PUBLIC WORKS, DIV. OF HIGHWAYS, STD. DWG. NO. A74-6 & UNIFORM SIGN CHART

PROJECT NO. I - 0 - 060


REVISED DATE	RIVERSIDE COUNTY FLOOD CONTROL AND WATER CONSERVATION DISTRICT		
	SIGNS & MARKERS		
APPROVED <i>J.W. Boyer</i>	DR.	DATE 11/1/65	
CHIEF ENG. R.E. NO. 8822	TRAC.	SM 18 of 23	
DATE: 7-11-66	CHECKED	DWB 1-201	

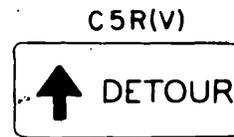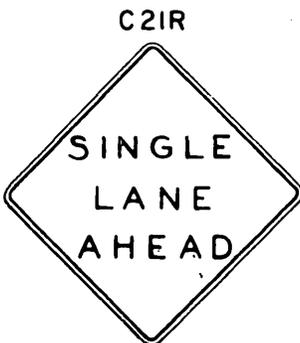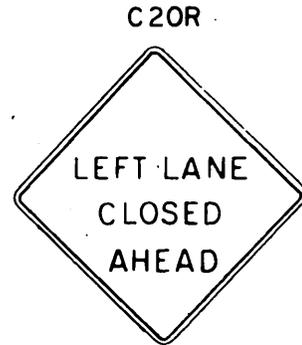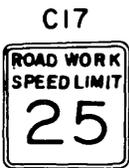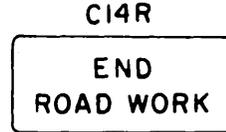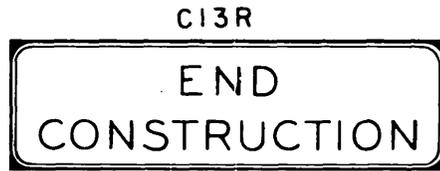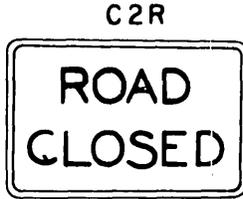


Note: Refer to State of California, Dept. of Public Works, Div. of Highways, Uniform Sign Chart Dated January 1962, for the Color and Dimensions of the above signs.

REVISED DATE	RIVERSIDE COUNTY FLOOD CONTROL AND WATER CONSERVATION DISTRICT		
	CONSTRUCTION SIGNS		
APPROVED <i>J. W. [Signature]</i>	DR.	DATE 11/1/65	
CHEF ENG. R.E. NO. 8822	TRAC.	SH. 19 of 25	
DATE: 11-4-65	CHECKED	DWA 1-201	

PROJECT NO. I-O-060

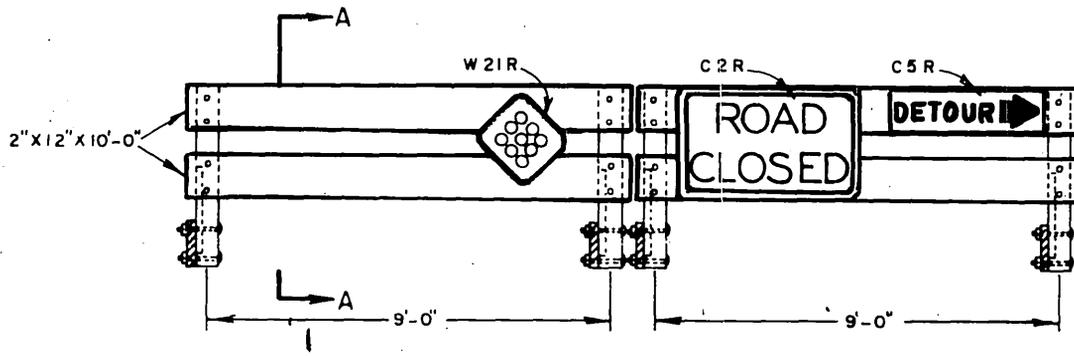

STANDARD BARRICADE WITH TYPICAL DETOUR SIGNS

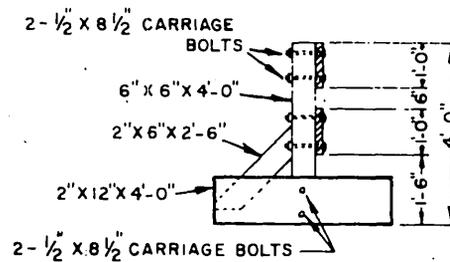


SECTION A-A

NOTE:

- 1.- ALL LUMBER TO BE SELECT STRUCTURAL D.F. S4S .
- 2.- Barricades to be given two coats of signal yellow paint after assembly.
- 3.- Signs, reflectors, and barricades to be furnished and installed by the contractor as directed by the engineer.

PROJECT NO. 1-0-060


REVISED DATE	RIVERSIDE COUNTY FLOOD CONTROL AND WATER CONSERVATION DISTRICT	
	CONSTRUCTION BARRICADES	
APPROVED <i>A. W. Boston</i>	DR.	DATE 11/1/65
CHEF ENG. R.E. NO. 6022	TRAC.	SH# 20 of 23
DATE: 1-4-66	CHECKED	DWG 1-201

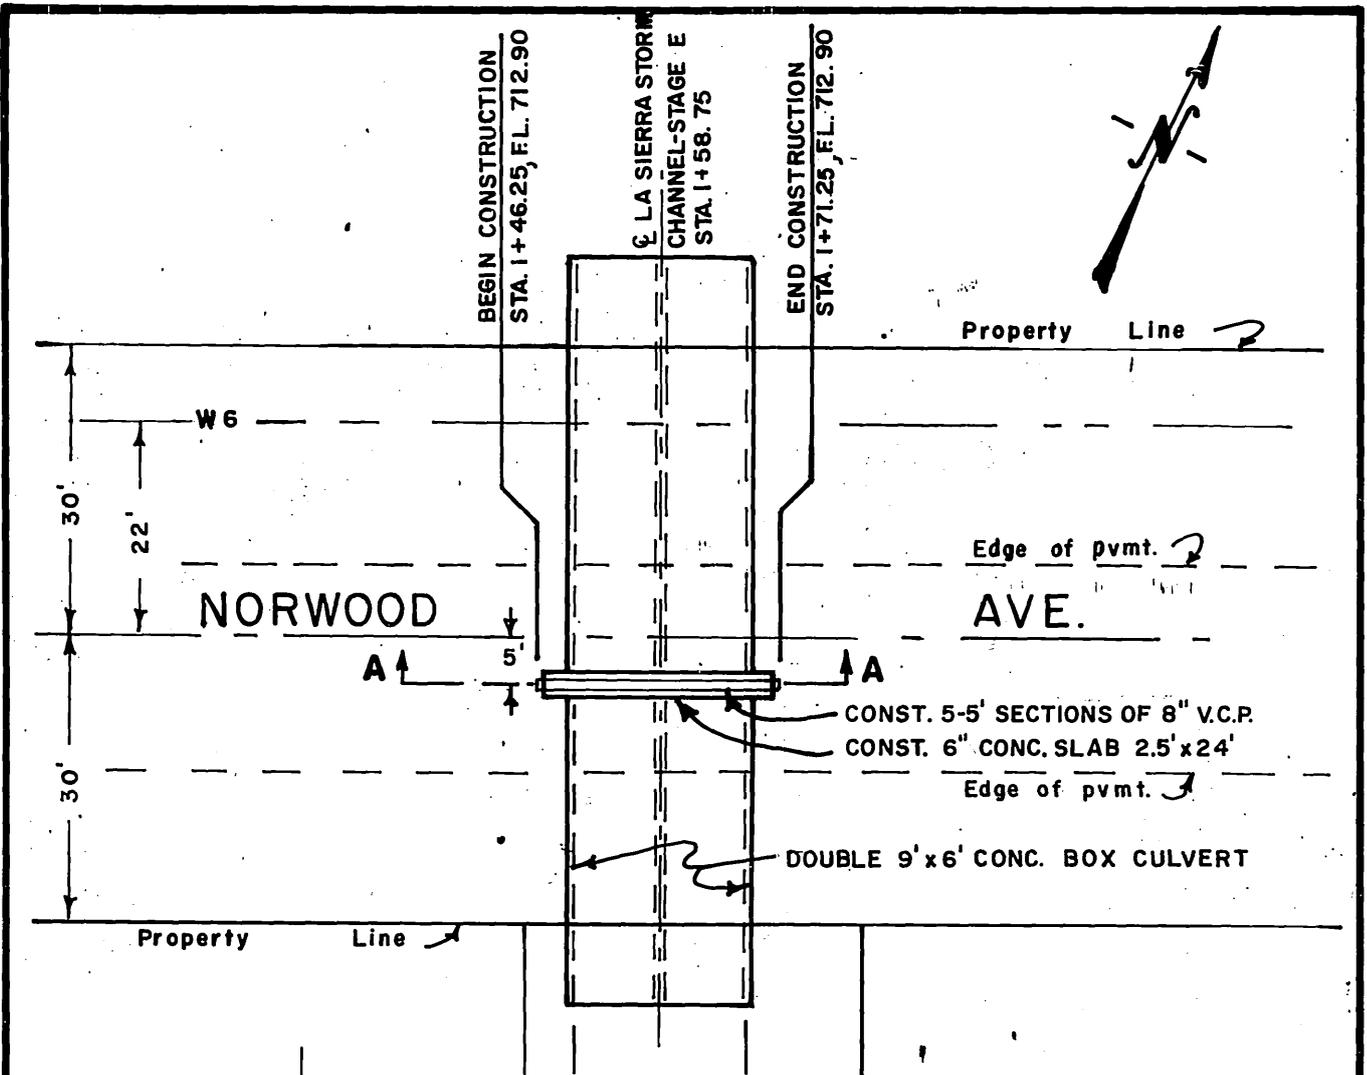

PLAN
SCALE 1"=20'

GENERAL NOTES

1. Construction shall be in accordance with the pipe Bedding Details shown on SH.NO. 22
2. Pipe shall be bedded per Case II, of the pipe Bedding Details shown on SH.NO. 22, Unless otherwise Specified on Plan.
3. Joints in vitrified clay pipe sewers shall conform to A.S.T.M. Standard C-425-60T, or the latest revision thereof.
4. The Contractor shall take out a permit from the Dept. of Public Works, City of Riverside, 3870 Mulberry St., for inspection by the City. There will be no fee charged for the City Permit.
5. The County Flood Control will set construction stakes. The Contractor shall obtain cut sheets from the County Flood Control District office.

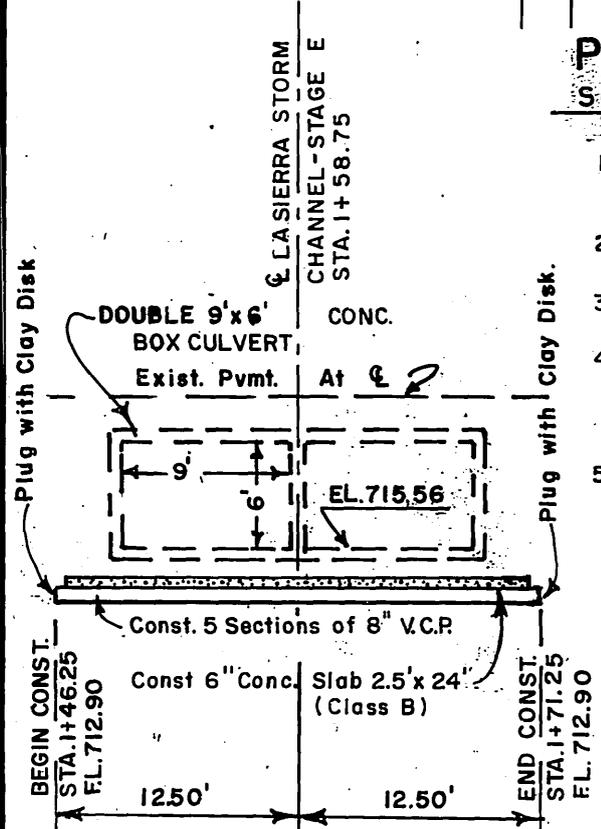


SECT. A-A
SCALE 1"=10"

PROJECT NO. I-O-060


REVISED DATE	RIVERSIDE COUNTY FLOOD CONTROL AND WATER CONSERVATION DISTRICT	
	LA SIERRA STORM CHANNEL STAGE "E"	
	DRY SEWER INSTALLATION	
APPROVED	DR. K. R. B. DATE 12/7/65	
DATE	TRAC.	SH# 21023
ENG. R.E. NO. 8822	CHECKED	DWG. I-201

CASE I

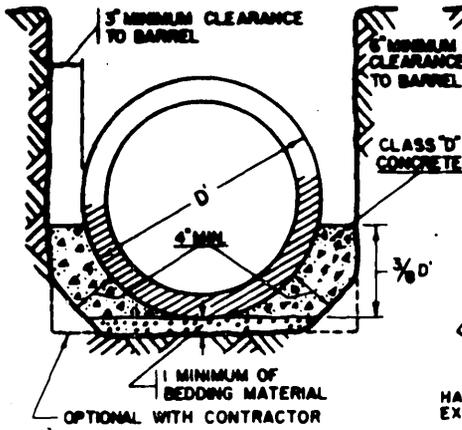

1. CASE I BEDDING (LOAD FACTOR 2.1) SHALL BE USED WHERE SPECIFIED ON THE PLANS OR WHERE REQUIRED AS AN ALTERNATIVE TO CASE II OR CASE III BEDDING AS PROVIDED HEREON. CASE II BEDDING SHALL BE USED INSTEAD OF CASE I AGAINST SHEETING OR UNSTABLE TRENCH SIDES IF SO REQUIRED BY THE ENGINEER.


CASE II

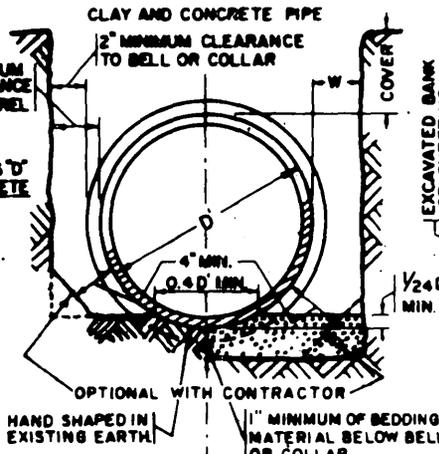

CASE II CASE II MOD


- 2. CASE II BEDDING** (LOAD FACTOR 1.4)
- (a) "W" AT THE SPRINGING LINE SHALL NOT BE LESS THAN 6 INCHES FOR ANY DEPTH OF TRENCH.
 - (b) WHERE THE COVER IS LESS THAN 8 FEET, "W" MEASURED AT THE TOP OF THE PIPE MAY BE ANY DIMENSION GREATER THAN 6 INCHES.
 - (c) WHERE THE COVER IS GREATER THAN 8 FEET, "W" MEASURED AT THE TOP OF THE PIPE SHALL NOT BE GREATER THAN 8 INCHES UNLESS THE CONTRACTOR AT HIS OWN EXPENSE PROVIDES CASE I BEDDING. THE STATED 8 INCHES INCLUDES THE THICKNESS OF ANY SHEETING.
 - (d) USE CASE II BEDDING FOR CLAY OR CONCRETE PIPE UNLESS OTHERWISE SPECIFIED.

CASE III

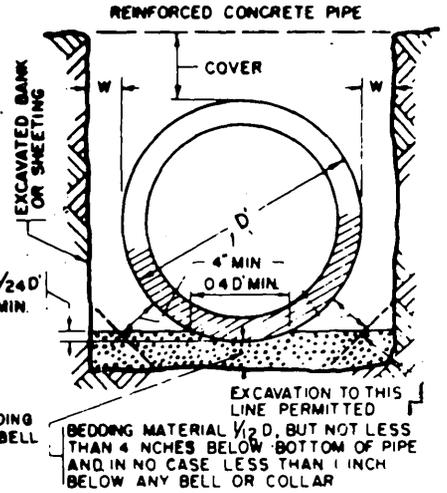

- 3. CASE III BEDDING** (LOAD FACTOR 1.4)
- (a) "W" AT THE SPRINGING LINE SHALL NOT BE LESS THAN 3 INCHES FOR ANY DEPTH OF TRENCH.
 - (b) WHERE THE COVER IS LESS THAN 8 FEET, "W" MEASURED AT THE TOP OF THE PIPE MAY BE ANY DIMENSION GREATER THAN 3 INCHES.
 - (c) WHERE THE COVER IS GREATER THAN 8 FEET, "W" MEASURED AT THE TOP OF THE PIPE SHALL NOT BE GREATER THAN 10 INCHES UNLESS THE CONTRACTOR AT HIS OWN EXPENSE PROVIDES CASE I BEDDING. THE STATED 10 INCHES INCLUDES THE THICKNESS OF ANY SHEETING.


CASE IV

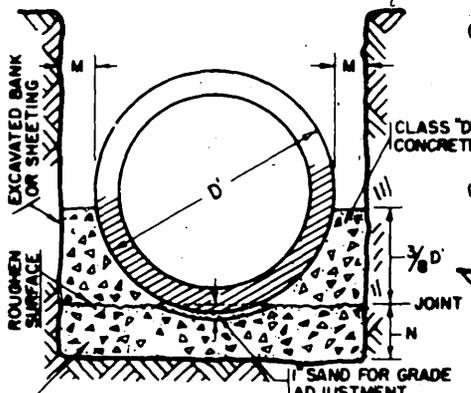

CLASS "A" CON. RETE MIX D AS FOR CLASS "C" RESURFACING AND WITH INCH SLUMP OR LESS IT SHALL BE 12 HOURS OLD BEFORE PIPE IS LAID. "M" AND "N" SHALL BE AS SPECIFIED ON THE PLANS OR BY THE ENGINEER.

4. CASE IV BEDDING (LOAD FACTOR 3.0) WHERE REQUIRED BY THE ENGINEER AS AN ALTERNATIVE TO CASE I OR CASE II TO MEET CONDITIONS ARISING DURING CONSTRUCTION, THE EXCESS CONCRETE AND EXCAVATION WILL BE PAID FOR AT THE UNIT PRICES IN THE CONTRACT.

CASE V

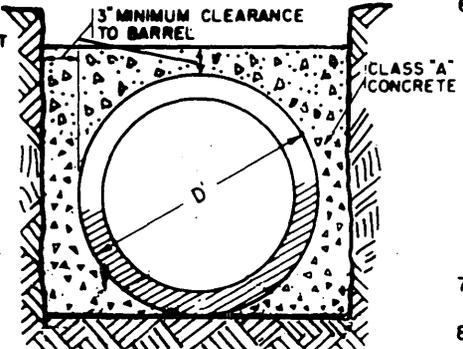

5. CASE V BEDDING (LOAD FACTOR 2.7) SHALL BE USED WHERE SPECIFIED ON THE PLANS.


GENERAL NOTES

- 6. BEDDING MATERIAL** (USED IN ALL CASES EXCEPT CASE III) SHALL BE SAND, GRAVEL, GRANULAR DECOMPOSED GRANITE, NO 3 ROCK, OR NO 4 ROCK. FOR PIPE SMALLER THAN 27 INCHES IN DIAMETER, THE PARTICLES OF BEDDING MATERIAL SHALL NOT BE LARGER THAN FOR NO 4 ROCK, AND FOR PIPE LARGER THAN 24 INCHES IN DIAMETER, THE PARTICLES SHALL NOT BE LARGER THAN FOR NO 3 ROCK. THE COST OF BEDDING MATERIAL SHALL BE INCLUDED IN THE PRICE BID FOR PIPE IN PLACE.
- 7. CLASS "A" CONCRETE**- 6 Sack
- 8. CLASS "D" CONCRETE**- 4.5 Sack

9. TABLE OF ROCK SIZES

PASSING SCREEN	NO 3		NO 4	
	MIN	MAX PERCENT	MIN	MAX PERCENT
1/2 INCH	100			
1 INCH	90	95 100		
3/4 INCH	60	70 80	100	
3/8 INCH	0	75 15	90	95 100
NO 4	0	25 5	0	75 15
NO 8			0	25 5


3-EDGE BEARING TEST
LOAD FACTOR 1.0

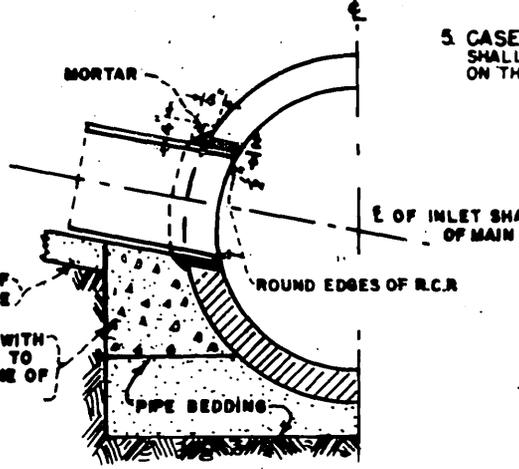

TYPICAL LATERAL CONNECTION

PROJECT NO. 1-0-060

REVISED DATE	RIVERSIDE COUNTY FLOOD CONTROL AND WATER CONSERVATION DISTRICT
	LA SIERRA STORM CHANNEL STAGE "E"
	PIPE BEDDING DETAILS
APPROVED <i>J.W. Bryant</i> CHIEF ENG. R.E. NO. 8822	DR DATE 12/27/65
DATE 1-4-66	TRAC 3422 of 23
	CHECKED DWG 1-201

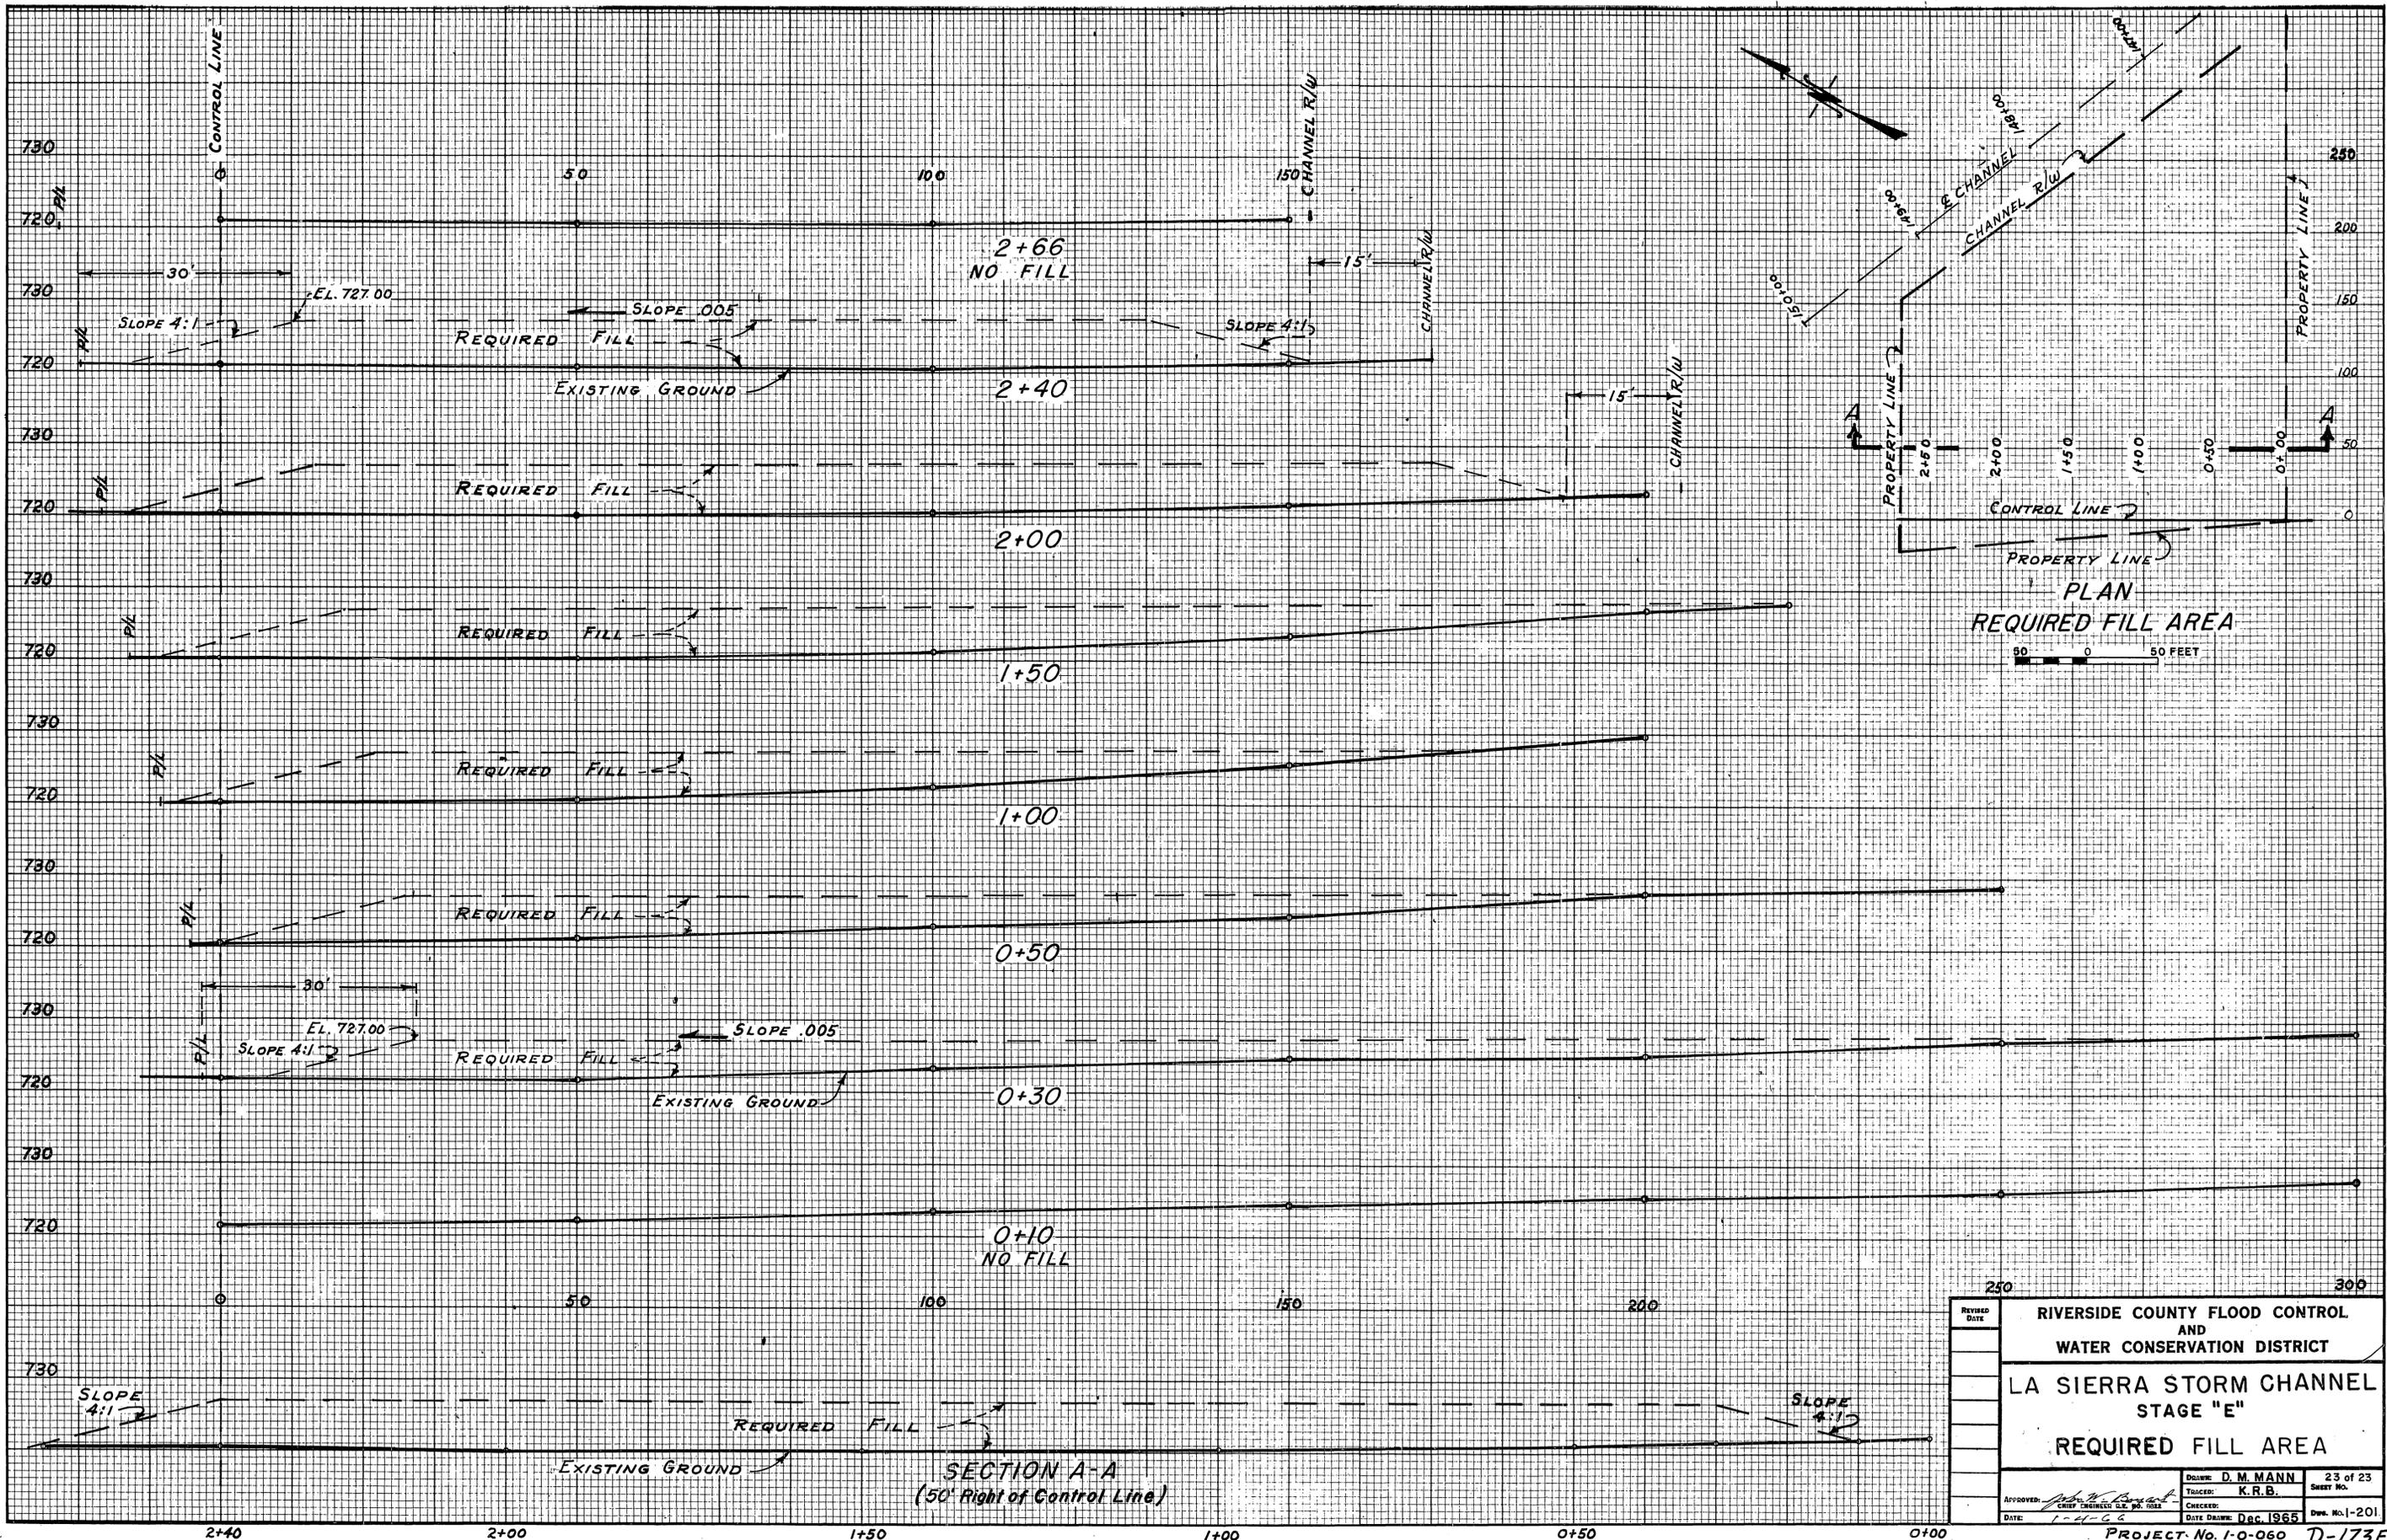

REVISED DATE	RIVERSIDE COUNTY FLOOD CONTROL AND WATER CONSERVATION DISTRICT		23 of 23
	LA SIERRA STORM CHANNEL STAGE "E"		
	REQUIRED FILL AREA		
APPROVED: <i>[Signature]</i>	DESIGNED: D. M. MANN	CHECKED: K. R. B.	SHEET NO.
DATE: 1-4-66	DATE DRAWN: Dec 1965		DWG. NO. 1-201

PROJECT No. 1-0-060 D-173E