




PROFILE SCALE
HORIZ. 1" = 40'
VERT. 1" = 8'

OFF-SITE STORM DRAIN
PROFILE MONROE STREET

JACKING NOTE:
START JACKING OF 57" R.C.P. FROM UPSTREAM.
CONTRACTOR TO TAKE PRECAUTIONARY MEASURES
WHEN CROSSING UNDER EXIST. IRRIGATION
CANAL. NOTIFY IRRIGATION SECTION 48 HRS
PRIOR TO THE START OF WORK PHONE 787-7442

NOTE:
FOR SEWER DESIGN (12" W.C.P.) SEE PLAN S-9/B
FOR WATER DESIGN (48" LINE) SEE PLAN D5-28/D

BENCH MARK: F5-E
SET P.K. NAIL AND TAG IN CULVERT HEADWALL AT
E'LY. CORNER OF VICTORIA AVE. AND MONROE ST.
F.B. 739/78
ELEV. 873.374

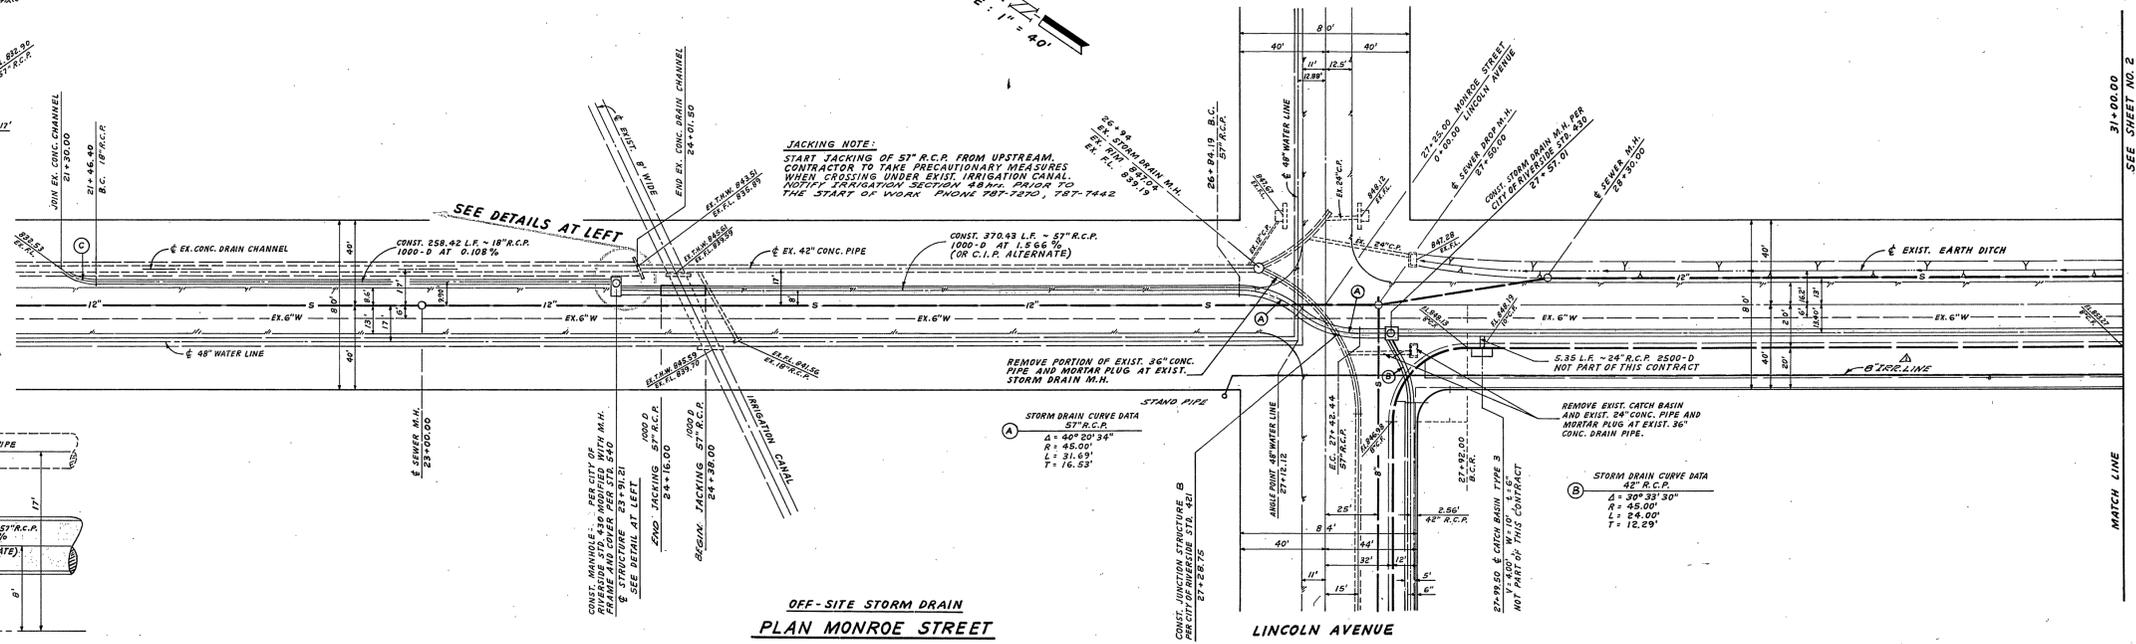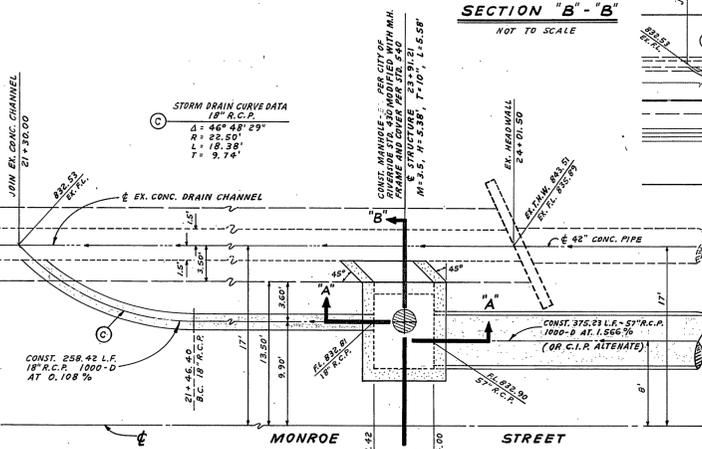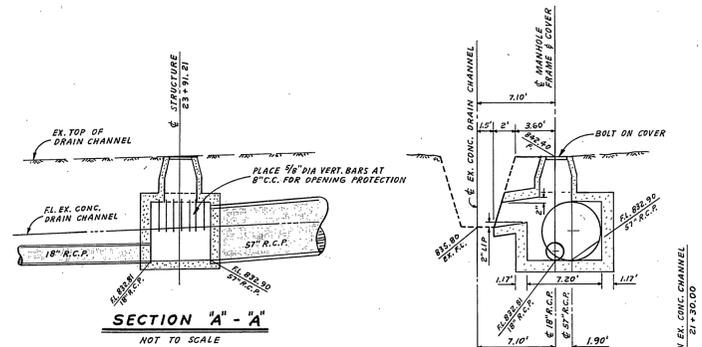


OFF-SITE STORM DRAIN
PLAN MONROE STREET

LINCOLN AVENUE

"AS BUILT" RAB - 4-74

APPROVED: GENERAL SUPERINTENDENT AND CHIEF ENGINEER WATER DEPARTMENT DATE: 12/18/72	ANACAL ENGINEERING CO. P.O. BOX 3668 222 EAST LINCOLN AVENUE ANAHEIM, CALIFORNIA 92803 PHONE NO. (714) 714-1763 PREPARED UNDER THE SUPERVISION OF CARL CZAPINSKI, R.C.E. 8427 DATE: 3-28-72	CITY OF RIVERSIDE, CALIFORNIA DEPARTMENT OF PUBLIC WORKS APPROVED BY: OFFICE ENGINEER PARK DEPARTMENT TRAFFIC DIVISION ASSISTANT CITY ENG.	MONROE ST. STORM DRAIN EXTENSION FOR TR. 4356 BETWEEN RIVERSIDE WATER CO. CANAL AND VICTORIA AVENUE HORIZ. SCALE: 1" = 40' VERT. SCALE: 1" = 8' FILE NO.	PROJECT NO. D-249
				SHEET 1 OF 2

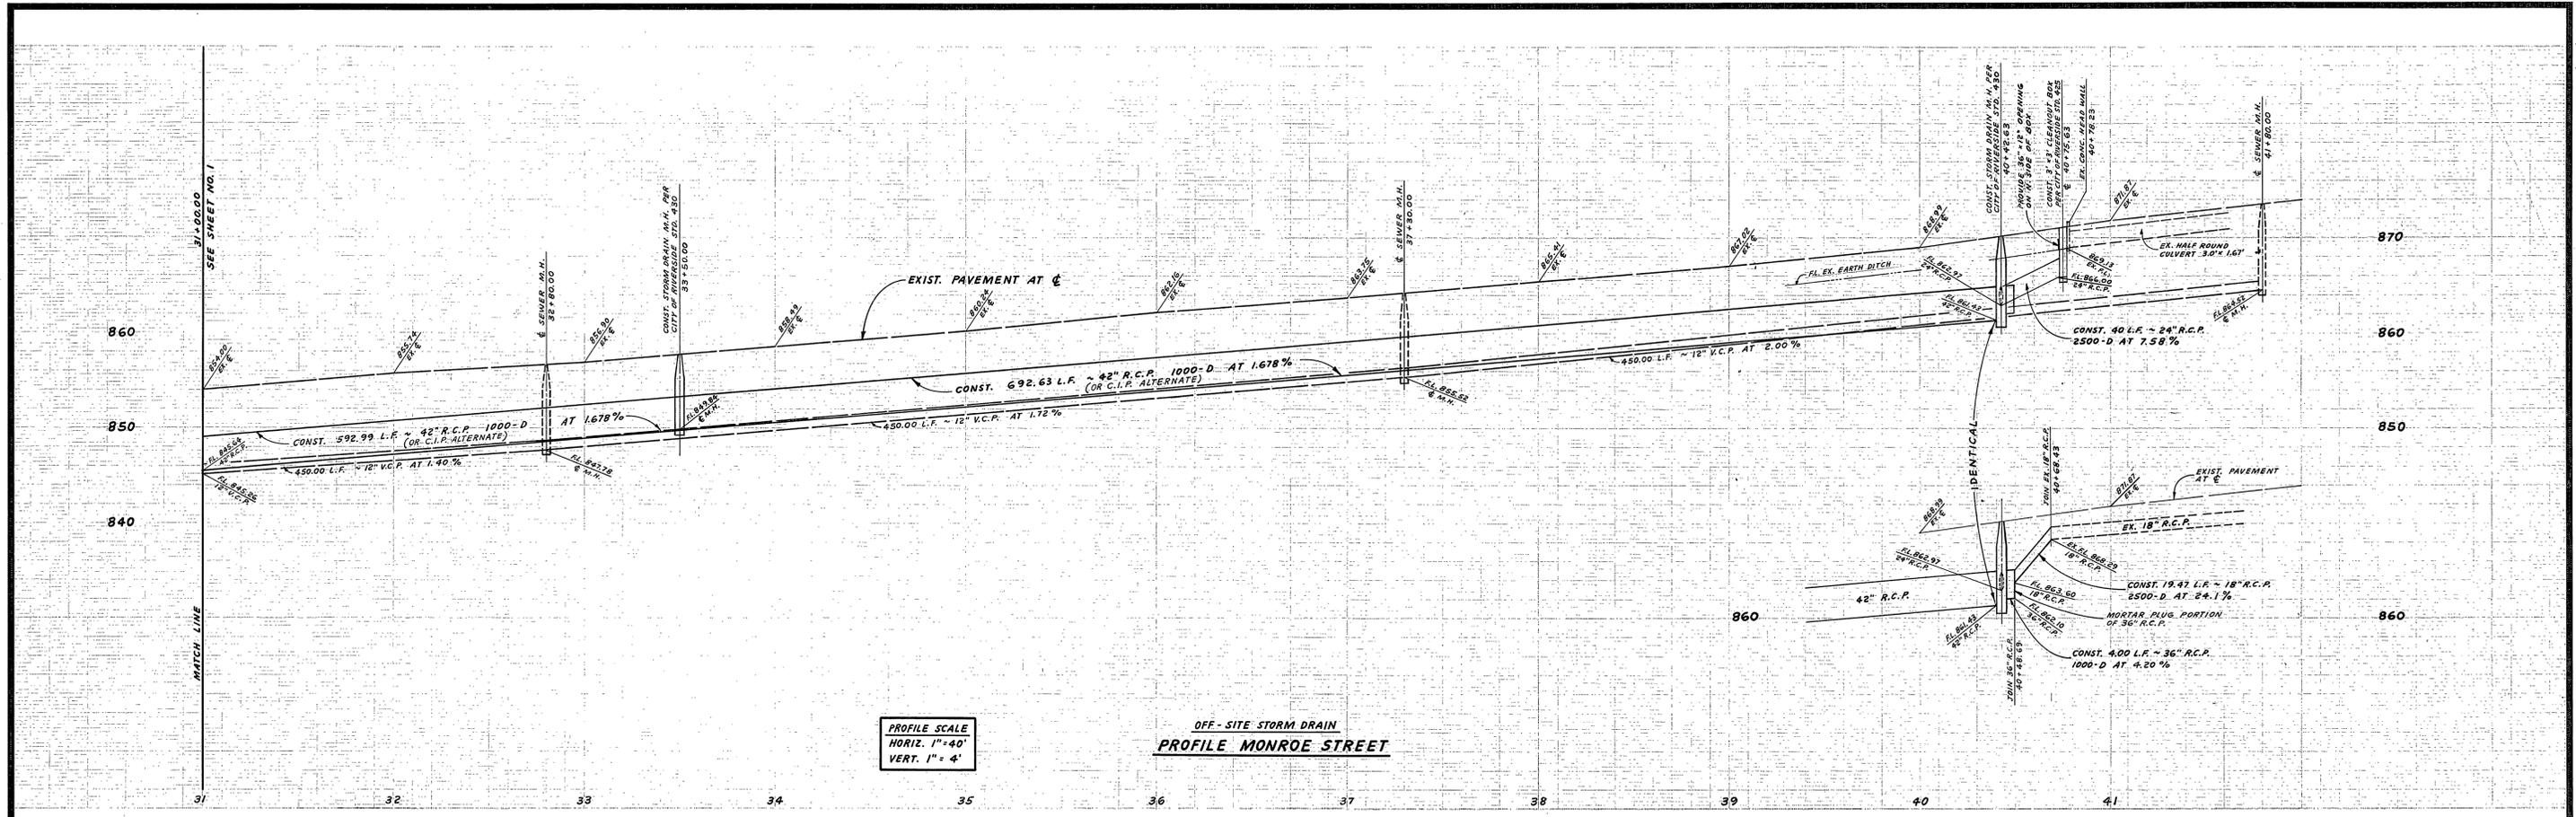


PROFILE SCALE
HORIZ. 1" = 40'
VERT. 1" = 4'

OFF-SITE STORM DRAIN
PROFILE MONROE STREET

NOTE:
FOR SEWER DESIGN (12" V.C.P.) SEE PLAN 5-9/8

BENCH MARK: FS-E
SET P.K. NAIL AND TAG IN CULVERT HEADWALL AT
E'LY. CORNER OF VICTORIA AVE. AND MONROE ST.
F.B. 739/78
ELEV. 873.374

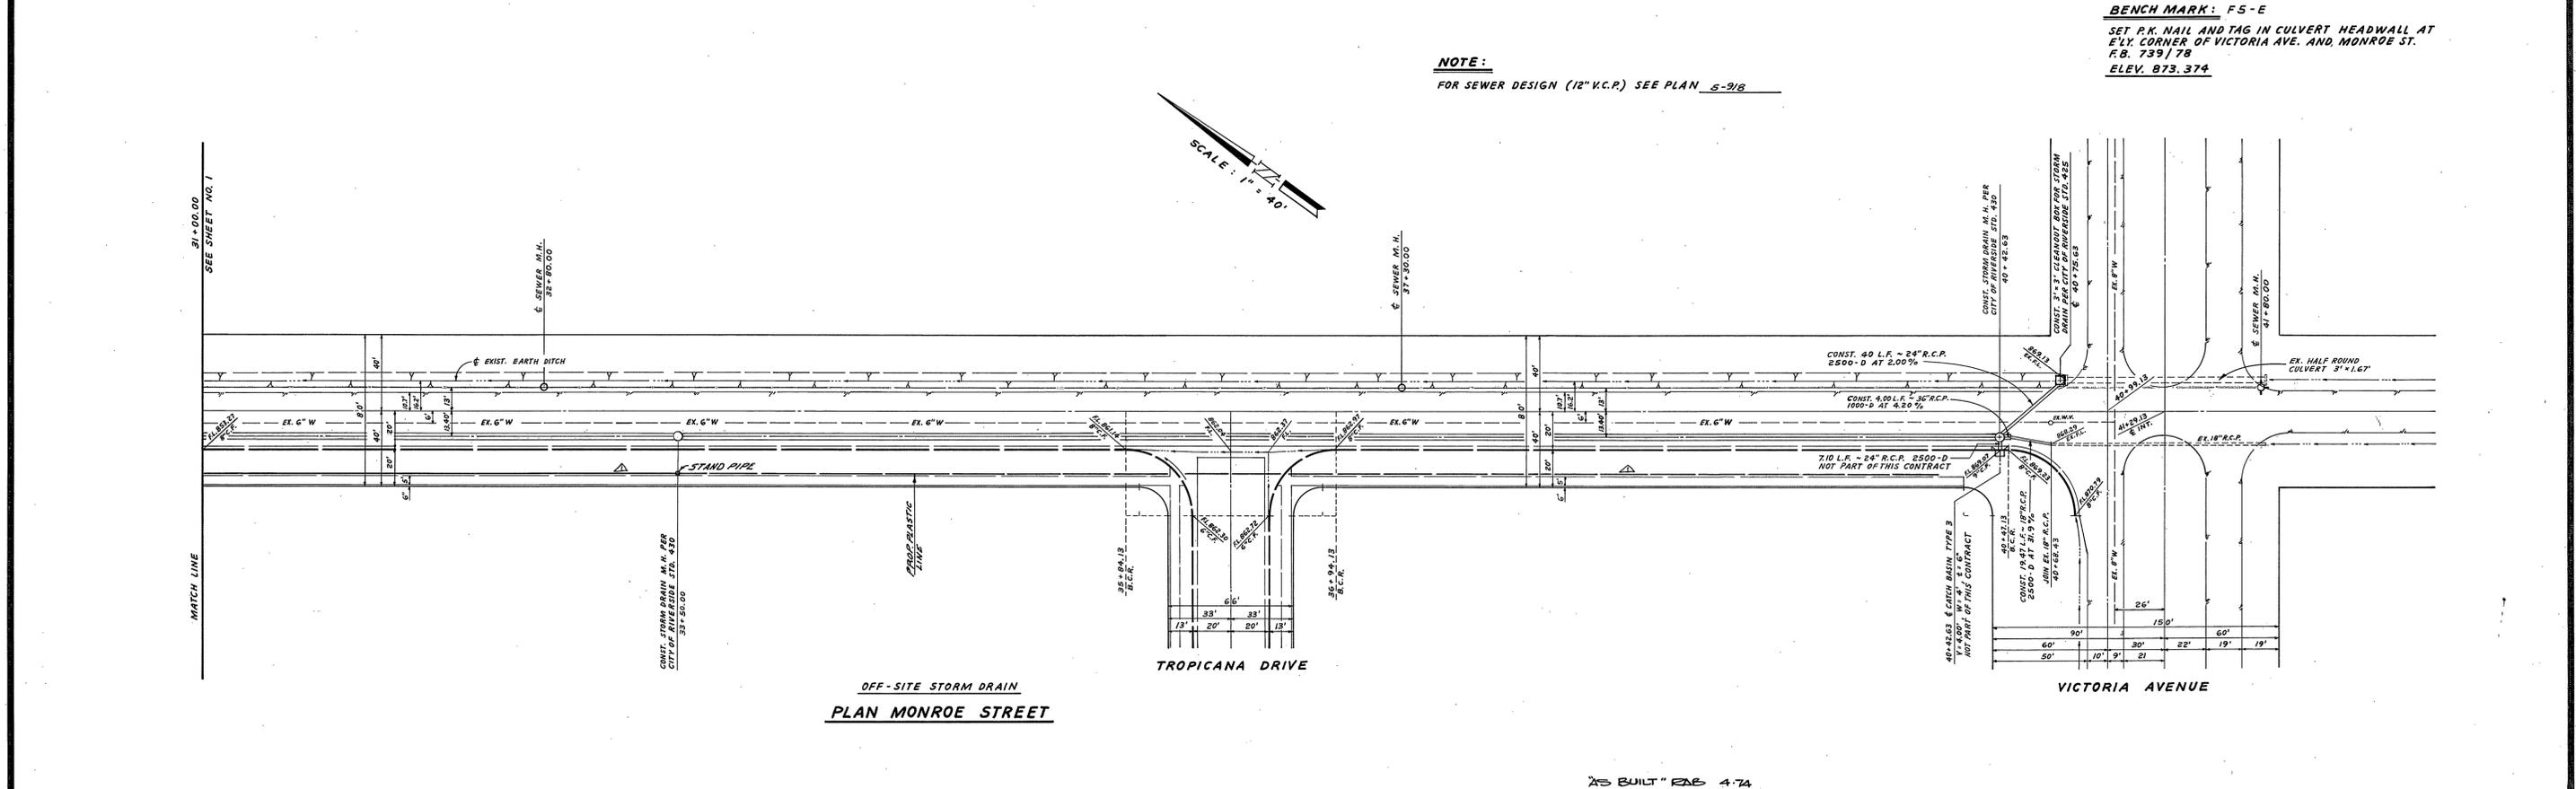

OFF-SITE STORM DRAIN
PLAN MONROE STREET

AS BUILT "EAB 4-74

ANACAL ENGINEERING CO. P.O. BOX 3668 222 EAST LINCOLN AVENUE ANAHEIM, CALIFORNIA 92803 PHONE N2 (714) 774-1763	CITY OF RIVERSIDE, CALIFORNIA DEPARTMENT OF PUBLIC WORKS		MONROE ST. STORM DRAIN EXTENSION FOR TR. 4356		PROJECT NO. D-249
	PREPARED UNDER THE SUPERVISION OF <i>Carl Czaplinski</i> CARL CZAPLINSKI, R.C.E. B427	DESIGNED BY H.K.S. DRAWN BY J.M.S. CHECKED BY H.K.S.	APPROVED BY OFFICE ENGINEER PARK DEPARTMENT TRAFFIC DIVISION ASSISTANT CITY ENG.	APPROVED BY DIRECTOR OF PUBLIC WORKS	BETWEEN RIVERSIDE WATER CO. CANAL AND VICTORIA AVENUE
3-28-72 DATE	3/27/73 DATE	3/27/73 DATE	3/27/73 DATE	SHEET 2 OF 2 FILE NO.	