

91
86
81

EXIST. T.C. (PLAN 8-1899)

MEET EXIST. C & G @ POINT

1405 C.B. M.H.P.

UPPER END C.B.

4118-50-LEND-18" RCP

83.50 FL

2.47%

4" GAS LINE

85.55

4150 C.B.

82.50 FL

6134 38" R.C.

CONST. 393.5' OF 18" RCP 1500-D
0.65%

EXIST. FL. ELY GUTTER

ABANDONED 6" CULVERT (DEPTH NOT VERIFIED)

4" W (18" COVER)

14" VCP SEWER (FL 882.331 @ M.H.)

21" G. (DEPTH NOT VERIFIED)

TELE. CO. (DEPTH NOT VERIFIED)

RCC G. DUCT STRUCTURE 4.75 TO BOTTOM

3405 M.H.

0.73%

80.47 FL

T.B.M. SE'LY CORNER OF PARK AVE AND PLEASANT ST. THE T.C. LOCATED AT THE B.C.R. 46.01' E'LY FROM PLEASANT ALONG PARK AVE PER C.R.F.B. 1028/1 ELEV. 88.16



7

6

5

4

3

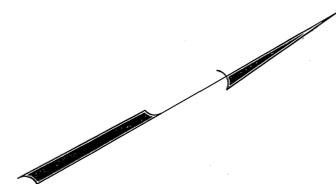
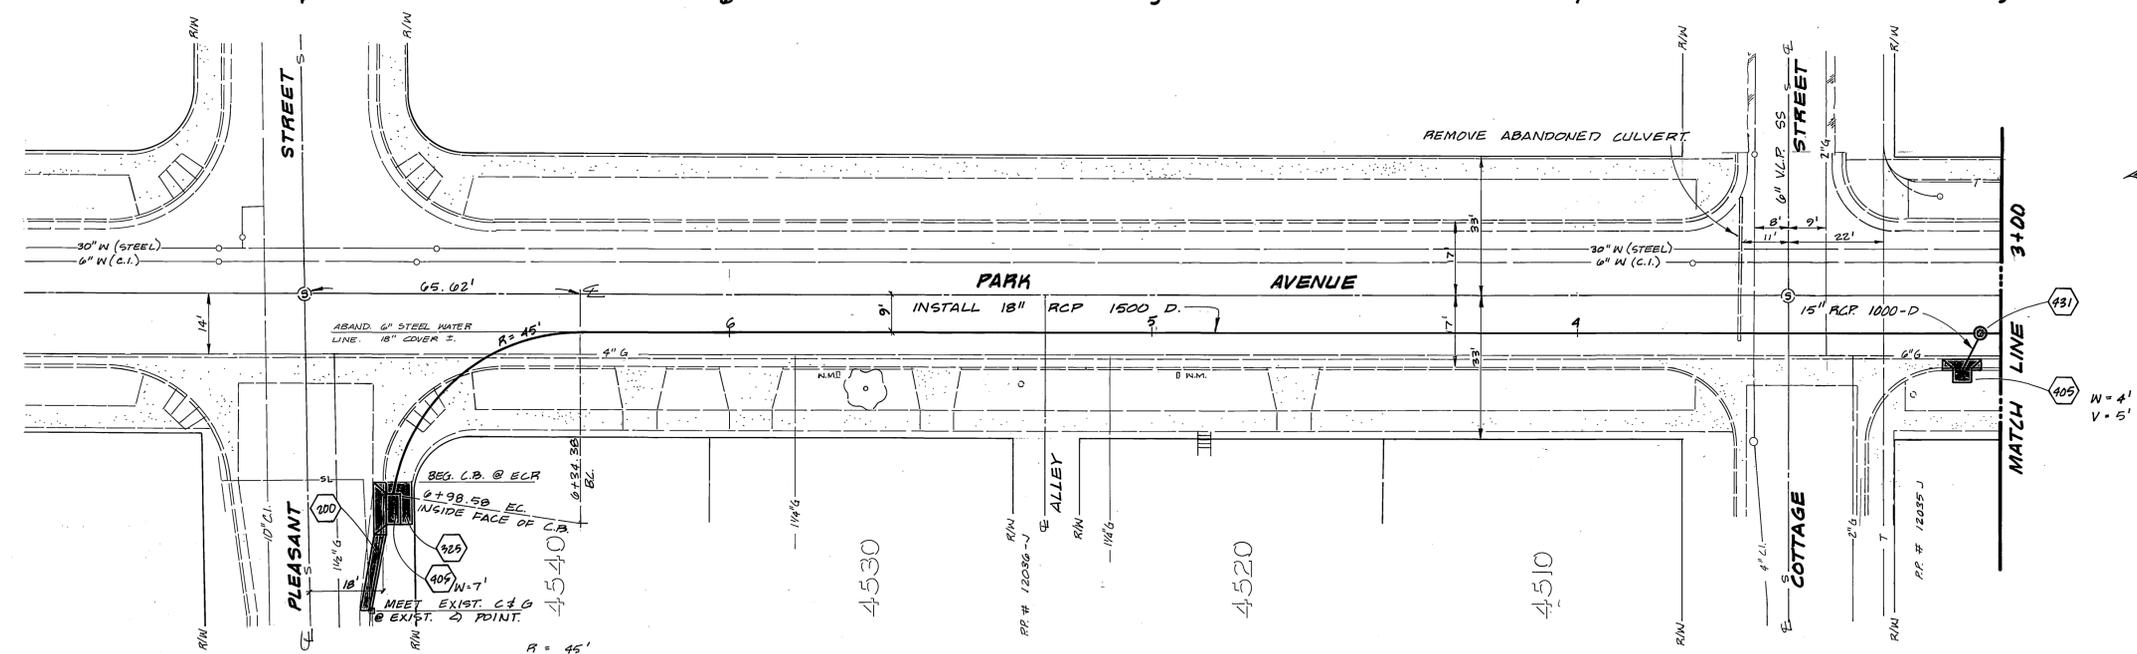


CONSTRUCTION NOTES:


- CONSTRUCTION TO BE IN ACCORDANCE WITH THE CITY OF RIVERSIDE, DEPARTMENT OF PUBLIC WORKS, STD. DRAWINGS AND THE STD. SPECIFICATIONS FOR PUBLIC WORKS CONST. 1973 EDITION.
 - (200) CONSTRUCT CURB & GUTTER AS PER STD. DWG. NO. 200. CURB FACE TO MATCH EXIST. PLACE A.C. ALONG GUTTER AS NECESSARY.
 - (325) CONSTRUCT S/W. AROUND CATCH BASIN AS SHOWN TO MATCH STD. DWG. NO. 325.
 - (405) CONSTRUCT CATCH BASIN AS PER STD. DWG. NO. 405, WITH W AS SHOWN.
- PRIOR TO ANY TRENCHING THE CONTRACTOR SHALL EXPOSE SEWER LINE AT STA. 3+50 BEFORE A CUT SHEET WILL BE PREPARED.
 - (431) CONSTRUCT M.H. PER STD. DWG. 431.

R = 45'
Δ = 81° 44' 24"
T = 38.94'
L = 64.20'

CITY OF RIVERSIDE PUBLIC WORKS DEPARTMENT		HCD EASTSIDE PARK AVENUE DRAIN		INDEXED BLD ACCOUNT NO. 15-550-548
APPROVED BY PRINCIPAL ENGINEER PARK DEPARTMENT TRAFFIC DIVISION CHIEF P.W. ENGINEER	DATE 7/20/80	APPROVED BY PUBLIC WORKS DIRECTOR	DATE 7/20/80	D-400 BETWEEN PLEASANT STREET & 235' SOUTH OF 14TH STREET. SHEET 1 OF 2
DESIGNED BY: [Signature] DRAWN BY: [Signature] CHECKED BY: [Signature]		HORIZ. SCALE: 1" = 20' VERT. SCALE: 1" = 2'		

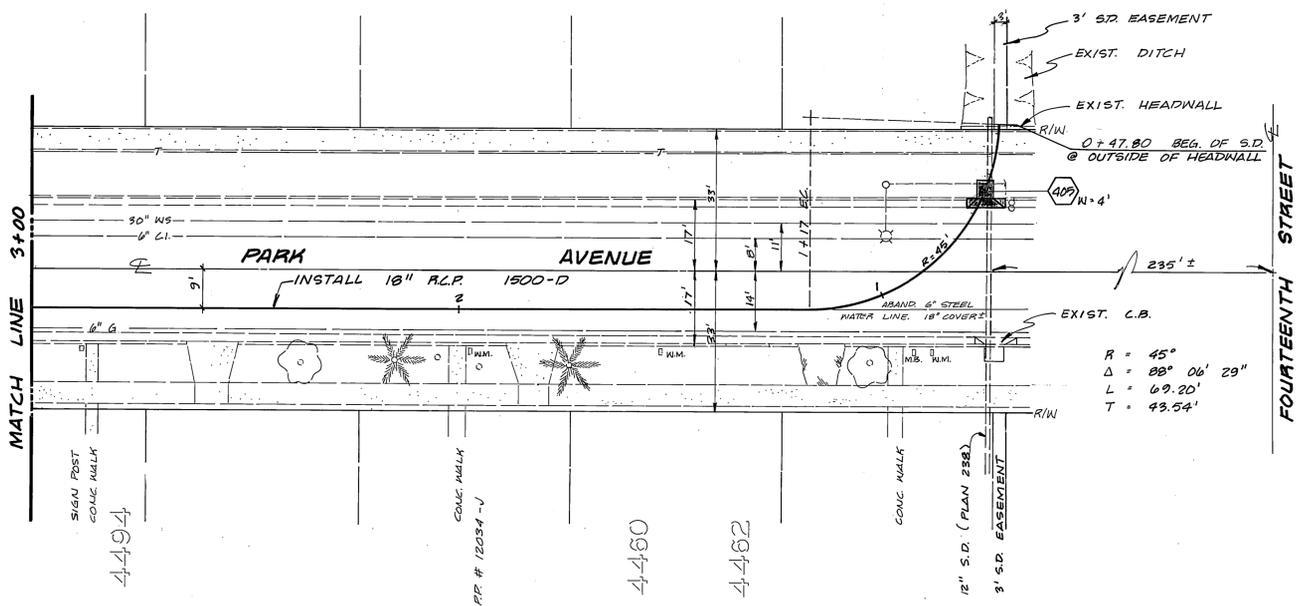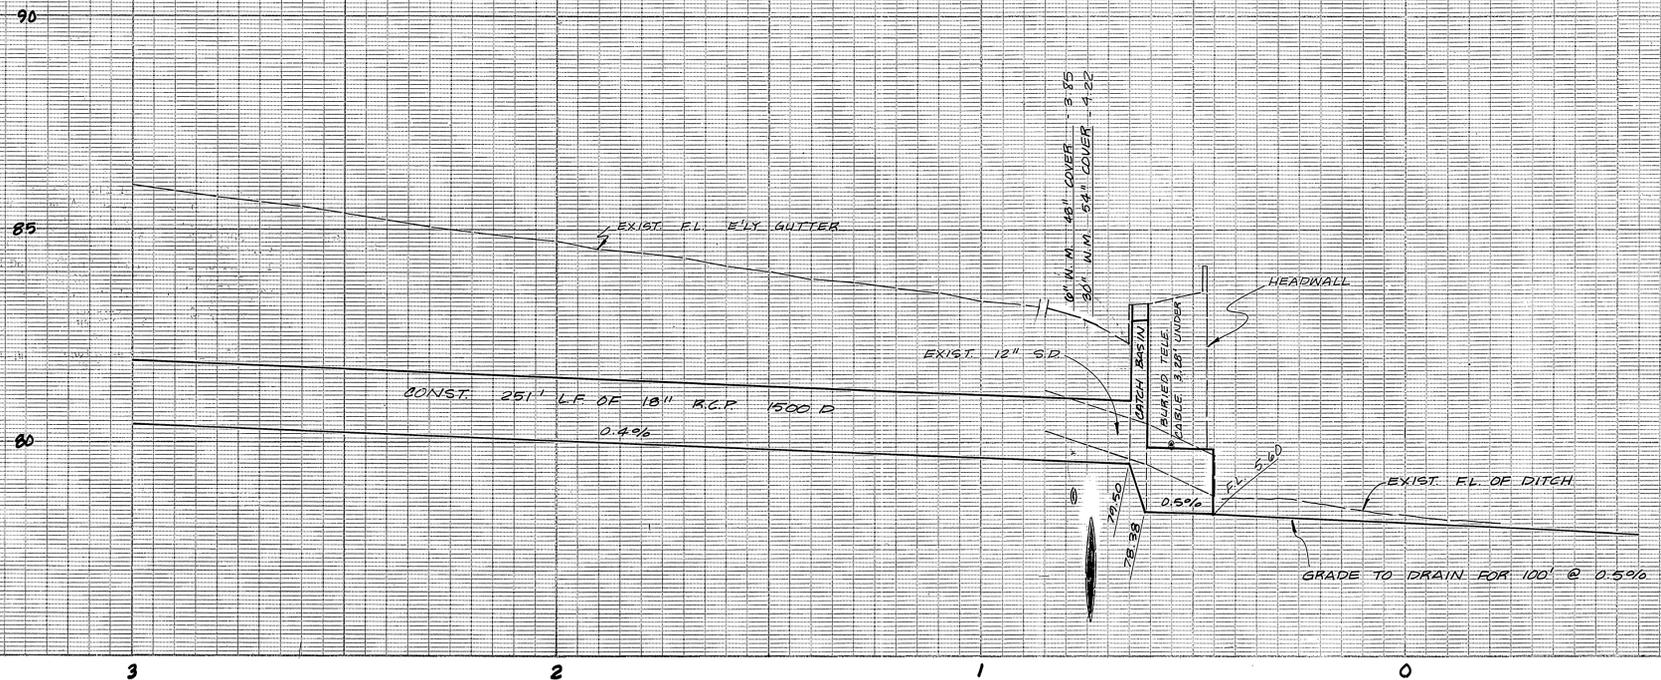

NOTE:
 AT STATION 0+40± REMOVE EXIST. C.B.
 AND CONST. NEW C.B. INTERCEPT EXIST.
 12" S.D. FROM ACROSS THE STREET. EXIST.
 S.D. BETWEEN C.B. AND HEADWALL TO BE
 ABANDONED OR REMOVED.

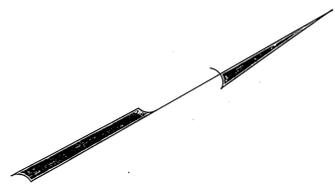

CITY OF RIVERSIDE PUBLIC WORKS DEPARTMENT		HCD EASTSIDE PARK AVENUE DRAIN		INDEXED B.L.D. ACCOUNT NO. 15-990-548
APPROVED BY PRINCIPAL ENGINEER PARK DEPARTMENT TRAFFIC DIVISION CHIEF P. W. ENGINEER	DATE _____ _____ _____ _____	APPROVED BY PUBLIC WORKS DIRECTOR	DATE 7/29/81	BETWEEN PLEASANT STREET AND 235' SOUTH OF 14TH STREET
DESIGNED BY: <i>WALL</i> DRAWN BY: <i>SM</i> CHECKED BY: _____	REVISIONS _____ _____ _____	APPR. DATE _____ _____	DATE 7/29/81	SHEET 2 OF 2
* AS BUILT 10/21/81 BRET			HORIZ. SCALE: 1" = 20' VERT. SCALE: 1" = 2'	