



LAT. "A-1"
 SEE PLAN VIEW BELOW
CAUTION !! PROFILE SCALE
 HORIZ: 1"=20' VERT: 1"=4'

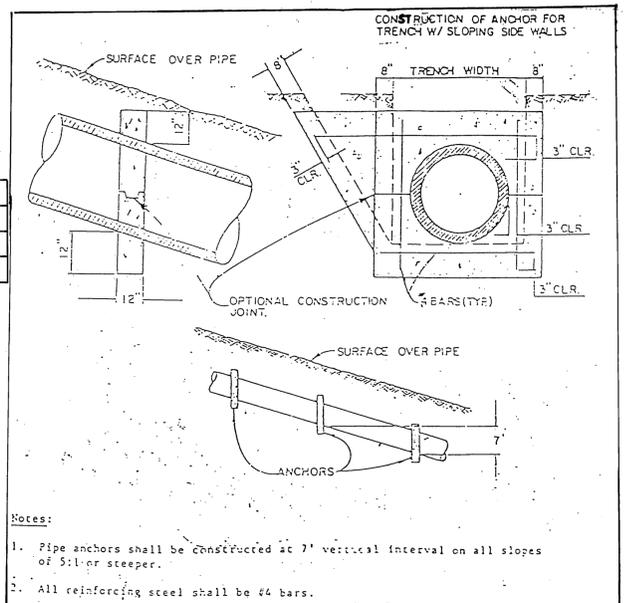

CONCRETE PIPE SLOPE ANCHOR DETAIL

NO.	R	L	T
1	50.00'	54.54'	30.34'
2	45.00'	60.66'	35.95'
3	60.00'	32.95'	16.90'


C/L 2+24.93	
J.S. "B"	
A	30' 00" 00"
B	18"
C	5.9'
D	30"
E	5.3'
L	4.5'
EL. "R"	1128.49
EL. "S"	1126.11

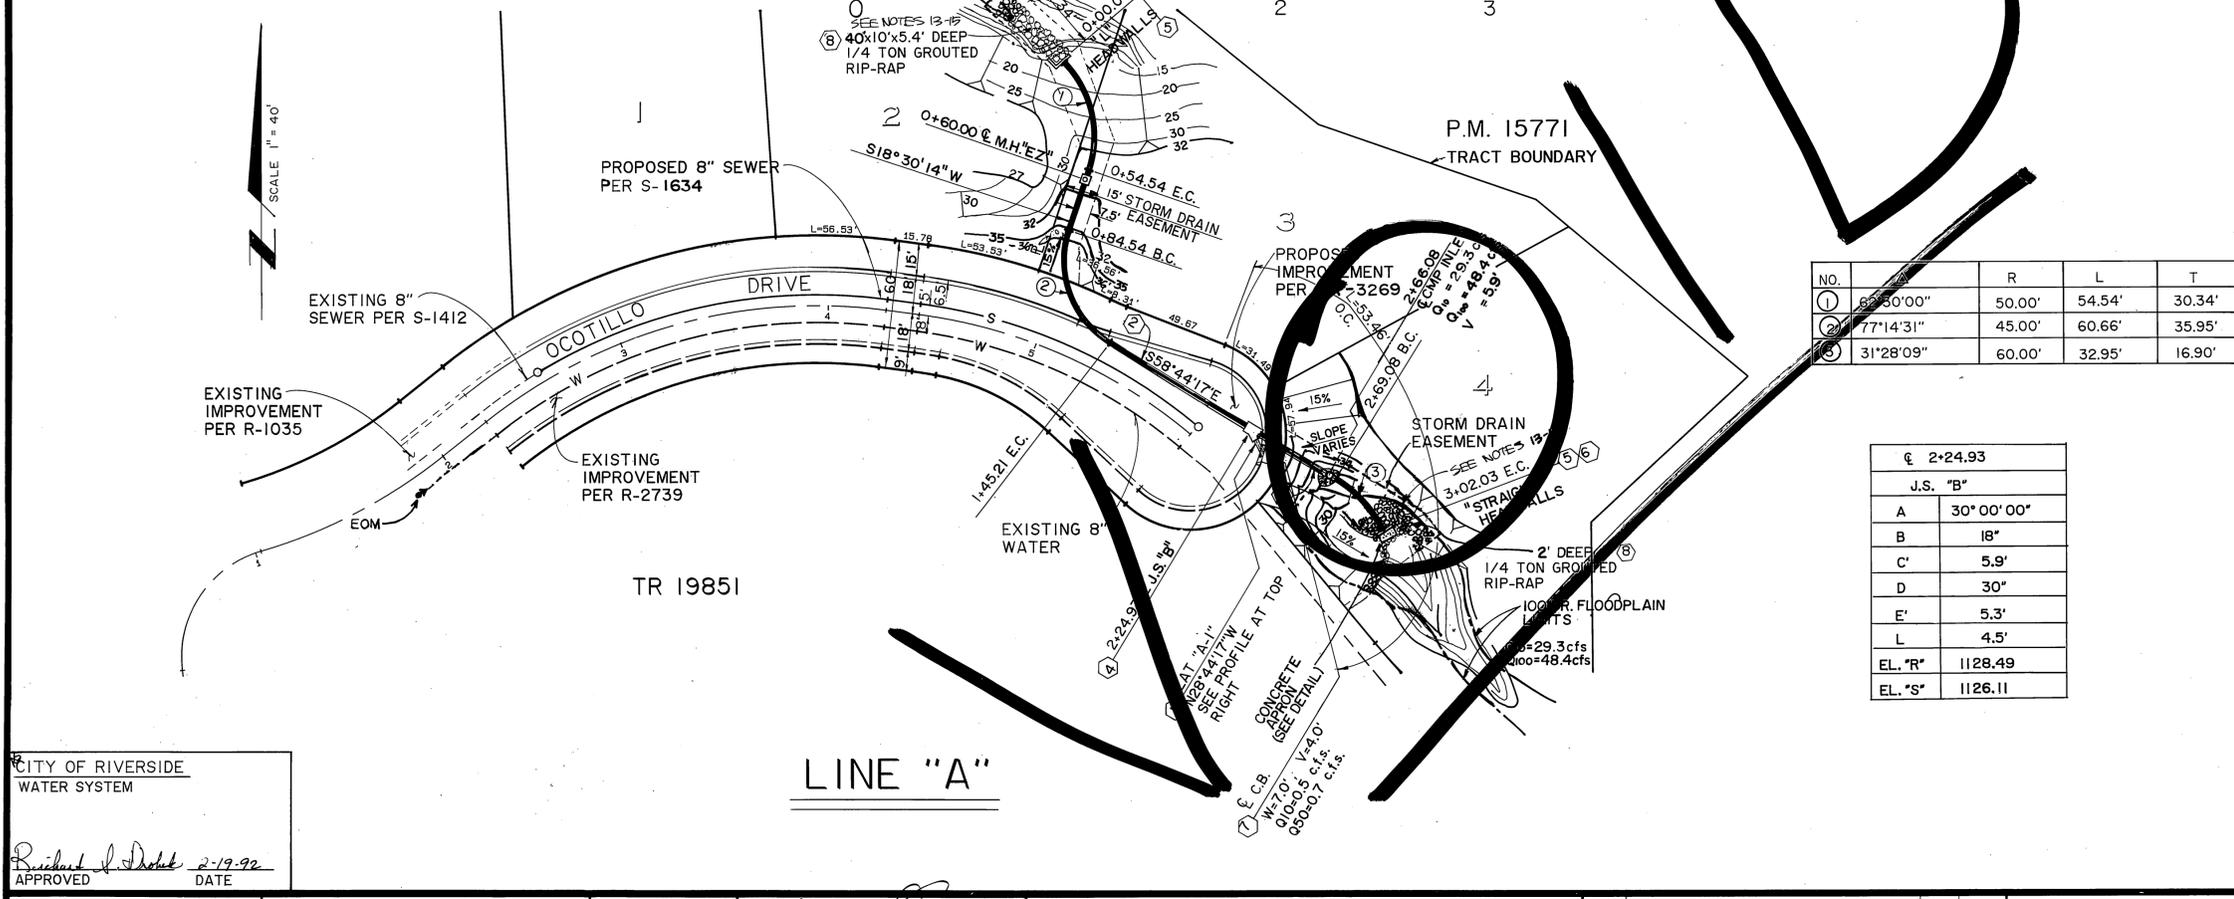

CITY OF RIVERSIDE
 WATER SYSTEM
 APPROVED: *Richard J. Deibel* 2-19-92
 DATE

Underground Service Alert
 Call: TOLL FREE
 1-800
 422-4133
 TWO WORKING DAYS BEFORE YOU DIG

PRIVATE ENGINEERING NOTE
 CONSTRUCTION CONTRACTOR AGREES THAT IN ACCORDANCE WITH GENERALLY ACCEPTED CONSTRUCTION PRACTICES, CONSTRUCTION CONTRACTOR WILL BE REQUIRED TO ASSUME SOLE AND COMPLETE RESPONSIBILITY FOR JOB SITE CONDITIONS DURING THE COURSE OF CONSTRUCTION OF THE PROJECT, INCLUDING SAFETY OF ALL PERSONS AND PROPERTY. THAT THIS REQUIREMENT SHALL BE MADE TO APPLY CONTINUOUSLY AND NOT BE LIMITED TO NORMAL WORKING HOURS, AND CONSTRUCTION CONTRACTOR FURTHER AGREES TO DEFEND, INDEMNIFY AND HOLD DESIGN PROFESSIONAL HARMLESS FROM ANY AND ALL LIABILITY REAL OR ALLEGED, IN CONNECTION WITH THE PERFORMANCE OF WORK ON THIS PROJECT, EXCEPTING LIABILITY ARISING FROM THE SOLE NEGLIGENCE OF DESIGN PROFESSIONAL.

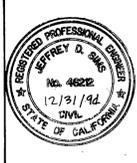

PREPARED UNDER THE DIRECTION OF:
 REGISTERED CIVIL ENGINEER NO. 46212
 EXPIRATION DATE: 12/31/94 DATE: 10/11/91

J.F. Davidson Associates, Inc.
 ENGINEERING PLANNING SURVEYING ARCHITECTURE LANDSCAPE ARCHITECTURE
 3880 Lemon Street, Suite 300 11200 S. Mt. Vernon Ave., Suite "D" 73-080 El Paseo, Suite 106
 P.O. Box 493 Riverside, CA 92502 Colton, CA 92324 Palm Desert, CA 92260
 (714) 686-0844 (714) 825-1082 (818) 346-9991
 FAX 714-686-9554 FAX 619-340-0529

SCALE: AS SHOWN BENCH MARK: CITY OF RIVERSIDE BENCH MARK F-6-0.
 DATE: AUGUST, 1991 P.K. NAIL & TAG IN TOP OF CONCRETE VAULT ON THE WEST SIDE OF WASHINGTON ST. 15' N'LY OF THE CENTERLINE OF MURFIELD ROAD PRODUCED PER THE CITY OF RIVERSIDE

CITY OF RIVERSIDE, CALIFORNIA
 DEPARTMENT OF PUBLIC WORKS
 APPROVED BY: *[Signature]* BY: *[Signature]* DATE: 7/21/92
 PRINCIPAL ENGINEER PARK DEPARTMENT TRAFFIC DIVISION CHIEF P.W. ENGR
 DESIGNED BY: T.C.L. DRAWN BY: A.S. CHECKED BY: J.D.S.

PM 23424
 STORM DRAIN IMPROVEMENT PLANS
 OCOTILLO DRIVE
 FOR: WAYNE FROST

PROJECT NO. 9112583
 D-611
 2 OF 2
 SHEET
 FILE NO. 9112583

INDEXED 8-13-92 LHM