

**GENERAL CONSTRUCTION NOTES**

- EXISTING UTILITIES, SHOWN ON THIS PLAN, ARE PLOTTED FROM UTILITY RECORDS. THE CONTRACTOR IS REQUIRED TO TAKE DUE PRECAUTIONARY MEASURES TO LOCATE AND PROTECT ALL UTILITIES WHETHER OR NOT SHOWN ON THIS PLAN. THE UTILITY IS NOT EXPECTED TO CONFLICT WITH THE PROPOSED IMPROVEMENTS.
- PRIME CONTRACTORS BIDDING THIS WORK SHALL HAVE A CLASS A OR C-8 LICENSE.
- CONFLICTING UTILITIES, IF ANY, WITHIN CONSTRUCTION AREA, SHALL BE RELOCATED PRIOR TO CONSTRUCTION.
- TREES AND SHRUBS, AFFECTED BY THE PROPOSED SIDEWALK CONSTRUCTION, SHALL BE TRIMMED TO AT LEAST 8' VERTICALLY ABOVE THE SIDEWALK SURFACE AND TO AT LEAST 3' LATERALLY OF THE SIDEWALK, WHERE RIGHT-OF-WAY PERMITS.
- MAIL BOXES, INTERFERING WITH PROPOSED SIDEWALK CONSTRUCTION, SHALL BE TEMPORARILY RELOCATED TO ENABLE PROPERTY OWNERS TO RECEIVE THEIR MAIL AND BE REINSTALLED IN FINAL POSITION BY THE CONTRACTOR.
- WATER METERS, GAS METERS AND ALL STREET PULL BOXES AFFECTED BY CONSTRUCTION, SHALL BE ADJUSTED TO THE PROPOSED SIDEWALK GRADE.
- EXISTING SPRINKLERS AND IRRIGATION LINES, AFFECTED BY THE CONSTRUCTION OF THE PROPOSED SIDEWALK, SHALL BE RELOCATED TO THE BACK OF THE SIDEWALK OR MODIFIED TO COVER EXISTING IRRIGATION AREA EXCEPT THE NEW PAVED AREA.
- PROPOSED PCC SIDEWALK SHALL BE CONSTRUCTED AT EXISTING DRIVEWAYS PER THE DETAIL SHOWN ON THIS PLAN.

**SPECIFIC CONSTRUCTION NOTES**


NUMBERS, ABOVE 100 IN A HEXAGON ON THE PLAN, REFER TO THE RESPECTIVE STANDARD DRAWING AND SHALL BE CONSTRUCTED ACCORDINGLY, UNLESS MODIFICATIONS ARE NOTED ON THE PLAN OR COVER SHEET. ANY NUMBER SHOWN BELOW THE STANDARD DRAWING NUMBER INDICATES THE SPECIFIC ALTERNATE TO BE CONSTRUCTED.

- RELOCATE EXISTING CHAIN LINK FENCE (H=4') TO R/W LINE.
- RELOCATE EXISTING TREE BEHIND THE NEW SIDEWALK.
- CONSTRUCT WHEELCHAIR RAMP PER STD. DWG. 304 TYPE I.
- CONSTRUCT DRIVEWAY APPROACH PER STD. DWG. 302 TYPE CURB-I.
- REMOVE AND REPLACE CROSS GUTTER AS SHOWN ON PLAN.
- ADJUST EXISTING SEWER MANHOLES AND WATER METERS TO GRADE.
- PROTECT IN PLACE.
- REMOVE & REPLACE EXISTING CURB & GUTTER, CURB HEIGHT AS SHOWN ON PLAN.
- CONSTRUCT RETAINING CURB, HEIGHT AS SHOWN ON PLAN.
- REMOVE & DISPOSE OF EXISTING BUSHES TO ALLOW FOR NEW SIDEWALK CONSTRUCTION.
- REMOVE & DISPOSE OF EXISTING IMPROVEMENTS AS SHOWN ON PLAN.
- CONSTRUCT DRIVEWAY AS SHOWN ON PLAN (THICKNESS = 6")
- REMOVE 6' OF EXISTING RETAINING CURB (H=VARIES).
- REMOVE AND DISPOSE OF EXISTING CLASS I MAGNOLIA TREE, PLANT (2) NEW 15 GALLON MAGNOLIA TREES BEHIND PROPOSED SIDEWALK AT LOCATIONS DETERMINED AT TIME OF CONSTRUCTION.





**RIVERSIDE CALIFORNIA**



**PUBLIC WORKS DEPARTMENT  
ORANGE STREET SIDEWALK  
(CDBG 2002-2003)**

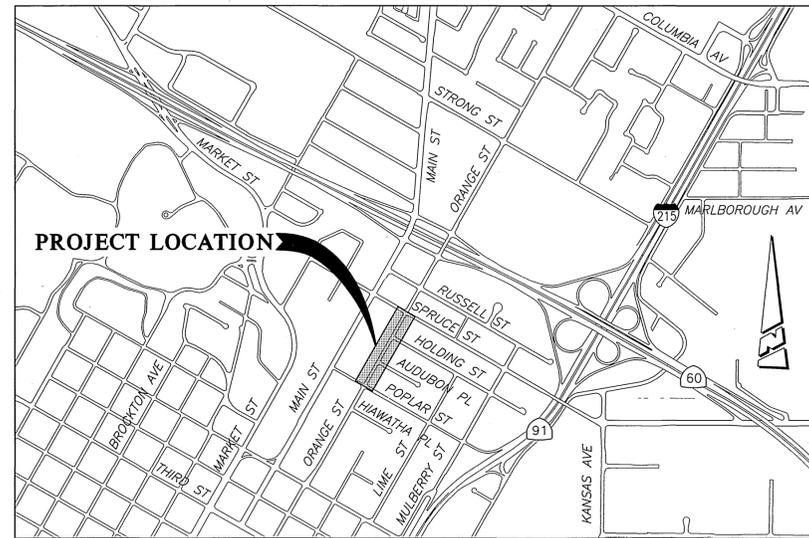

**PROJECT LOCATION MAP**

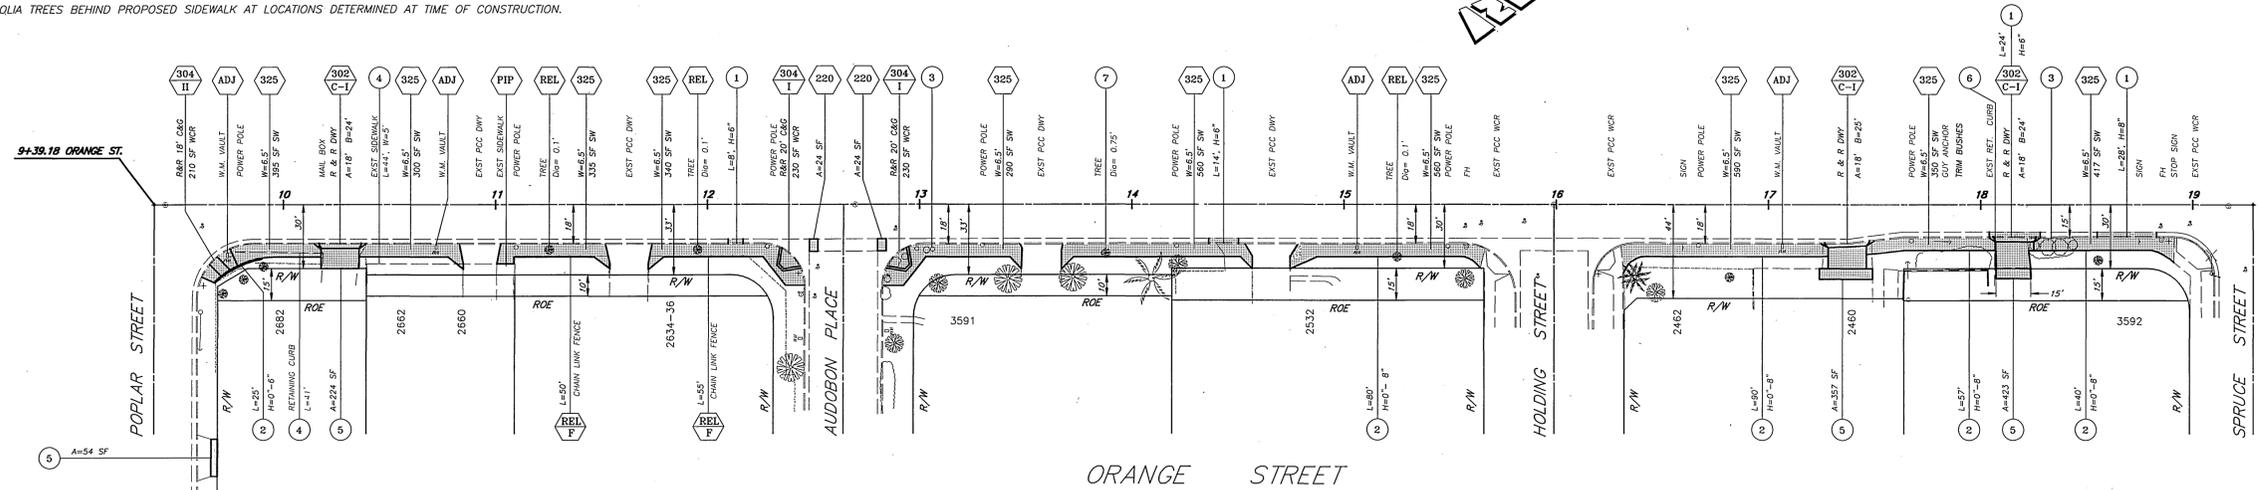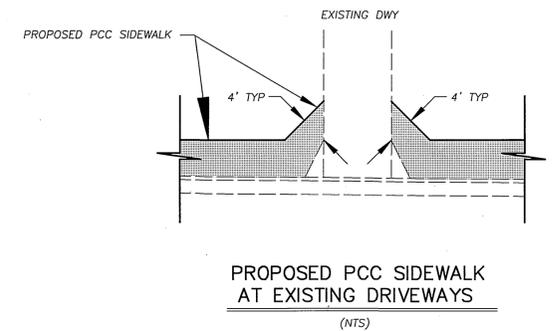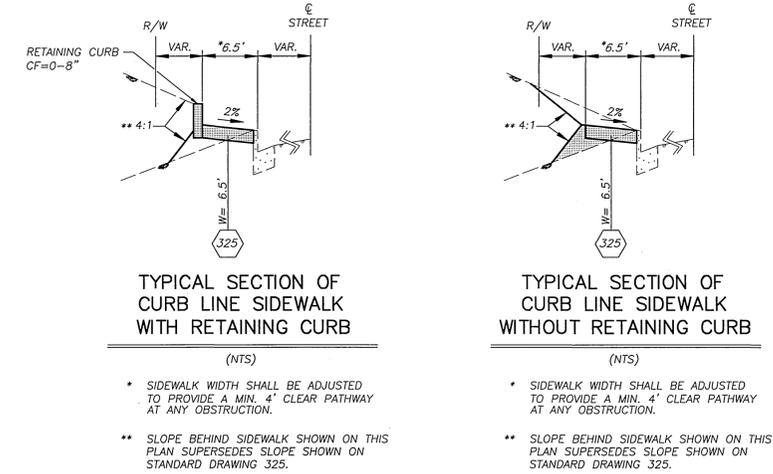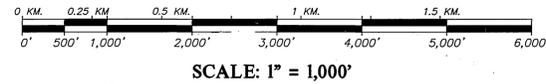

\*AS-BUILT PER PLAN 2-04-04 LPH

**IMPORTANT NOTICE**  
Section 4216/4217 of the Government Code requires a Dig Alert Identification Number to be issued before a Permit to Excavate will be valid. For your Dig Alert ID, Number call CALL TOLL FREE 48 HOURS BEFORE YOU DIG UNDERGROUND SERVICE ALERT 1-800-227-2600

**ENGINEER IN RESPONSIBLE CHARGE**  
PHILIP L. HANNAWI  
R.C.E. No. 44747 Expires 3/31/2006  
DATE 7/18/03



DESIGNED BY	ABE	DRAWN BY	SMA	CHECKED BY	
APPROVED BY		DATE			
PRINCIPAL ENGINEER		DATE			
INSPECTION		DATE			
STREET SERVICES					
TRAFFIC ENGINEER					

**CITY OF RIVERSIDE, CALIFORNIA  
PUBLIC WORKS DEPARTMENT**

APPROVED BY: *[Signature]* DATE: 7/18/03  
INSPECTION: *[Signature]* DATE: 6/12/03  
DATE: 7/14/03

**ORANGE STREET  
SIDEWALK CONSTRUCTION  
AT EASTERLY SIDE BETWEEN  
POPLAR ST. AND SPRUCE ST.  
(CDBG 2002-2003)**

HORIZ. SCALE: 1" = 40'

ACCT. NO.: 9221300611-4401200X  
R-3717  
SHEET 1 OF 1

INDEXED 7-28-03 LPH