


TRANSIT AND SWING TIES

14068.TIF

REF: 6328.TIF
 CRFB 1005/38
 CRFB 703/51

STREET: THIRD STREET

OFFICIAL USE ONLY
 X-STREET: PARK AVENUE

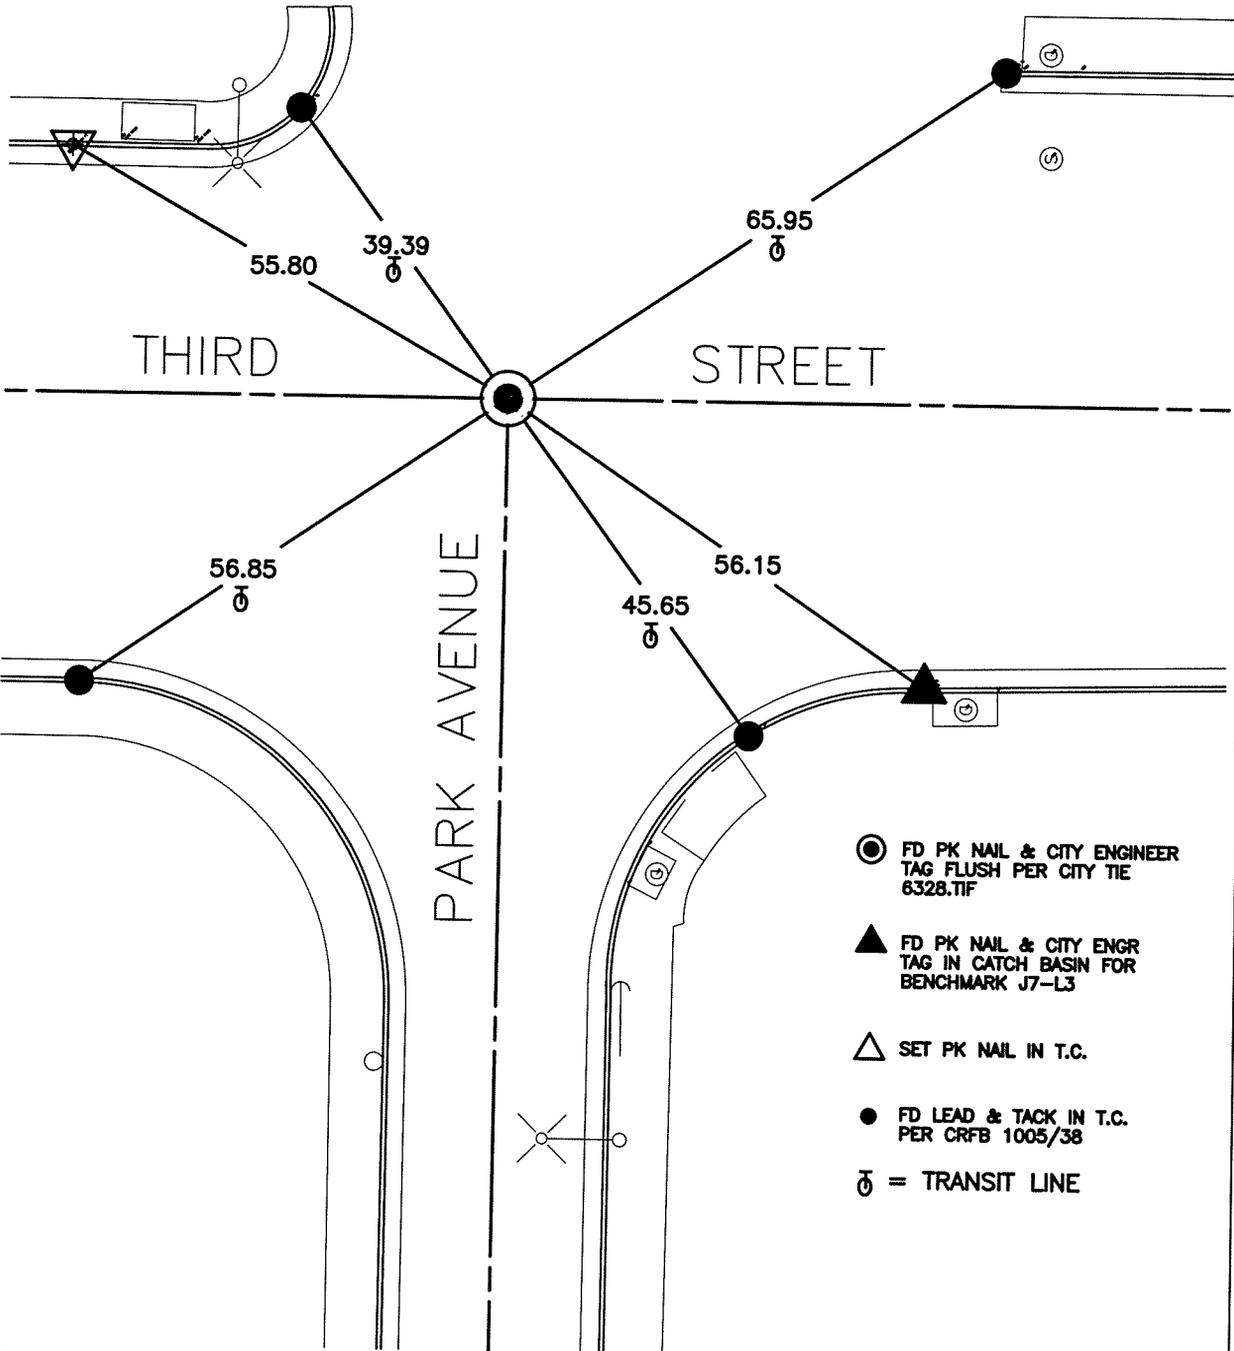


- FD PK NAIL & CITY ENGINEER TAG FLUSH PER CITY TIE 6328.TIF
- ▲ FD PK NAIL & CITY ENGR TAG IN CATCH BASIN FOR BENCHMARK J7-L3
- △ SET PK NAIL IN T.C.
- FD LEAD & TACK IN T.C. PER CRFB 1005/38
- ⊕ = TRANSIT LINE

SCALE: 1"=20'
 DATE: 7/06/12
 DRAWN BY: CURT
 F.B.:
 SEC. 24 T.2S.,R.5W

OFFICIAL TIE PLAT CITY OF RIVERSIDE

THESE TIES ARE FOR THE PURPOSE OF PERPETUATING THE FOUND MONUMENTATION. NO CLAIM IS MADE AS THE RELATIONSHIP OF THE POINTS OR LINES SHOWN HEREON TO TRUE BOUNDARY LOCATIONS

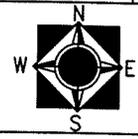

SHEET 1 OF 1