


SWING TIES

X-STREET 1ST BK S^{1/2}Y OF CASTLE WAY.
OFFICE USE ONLY

STREET CYNDAQUEST DR

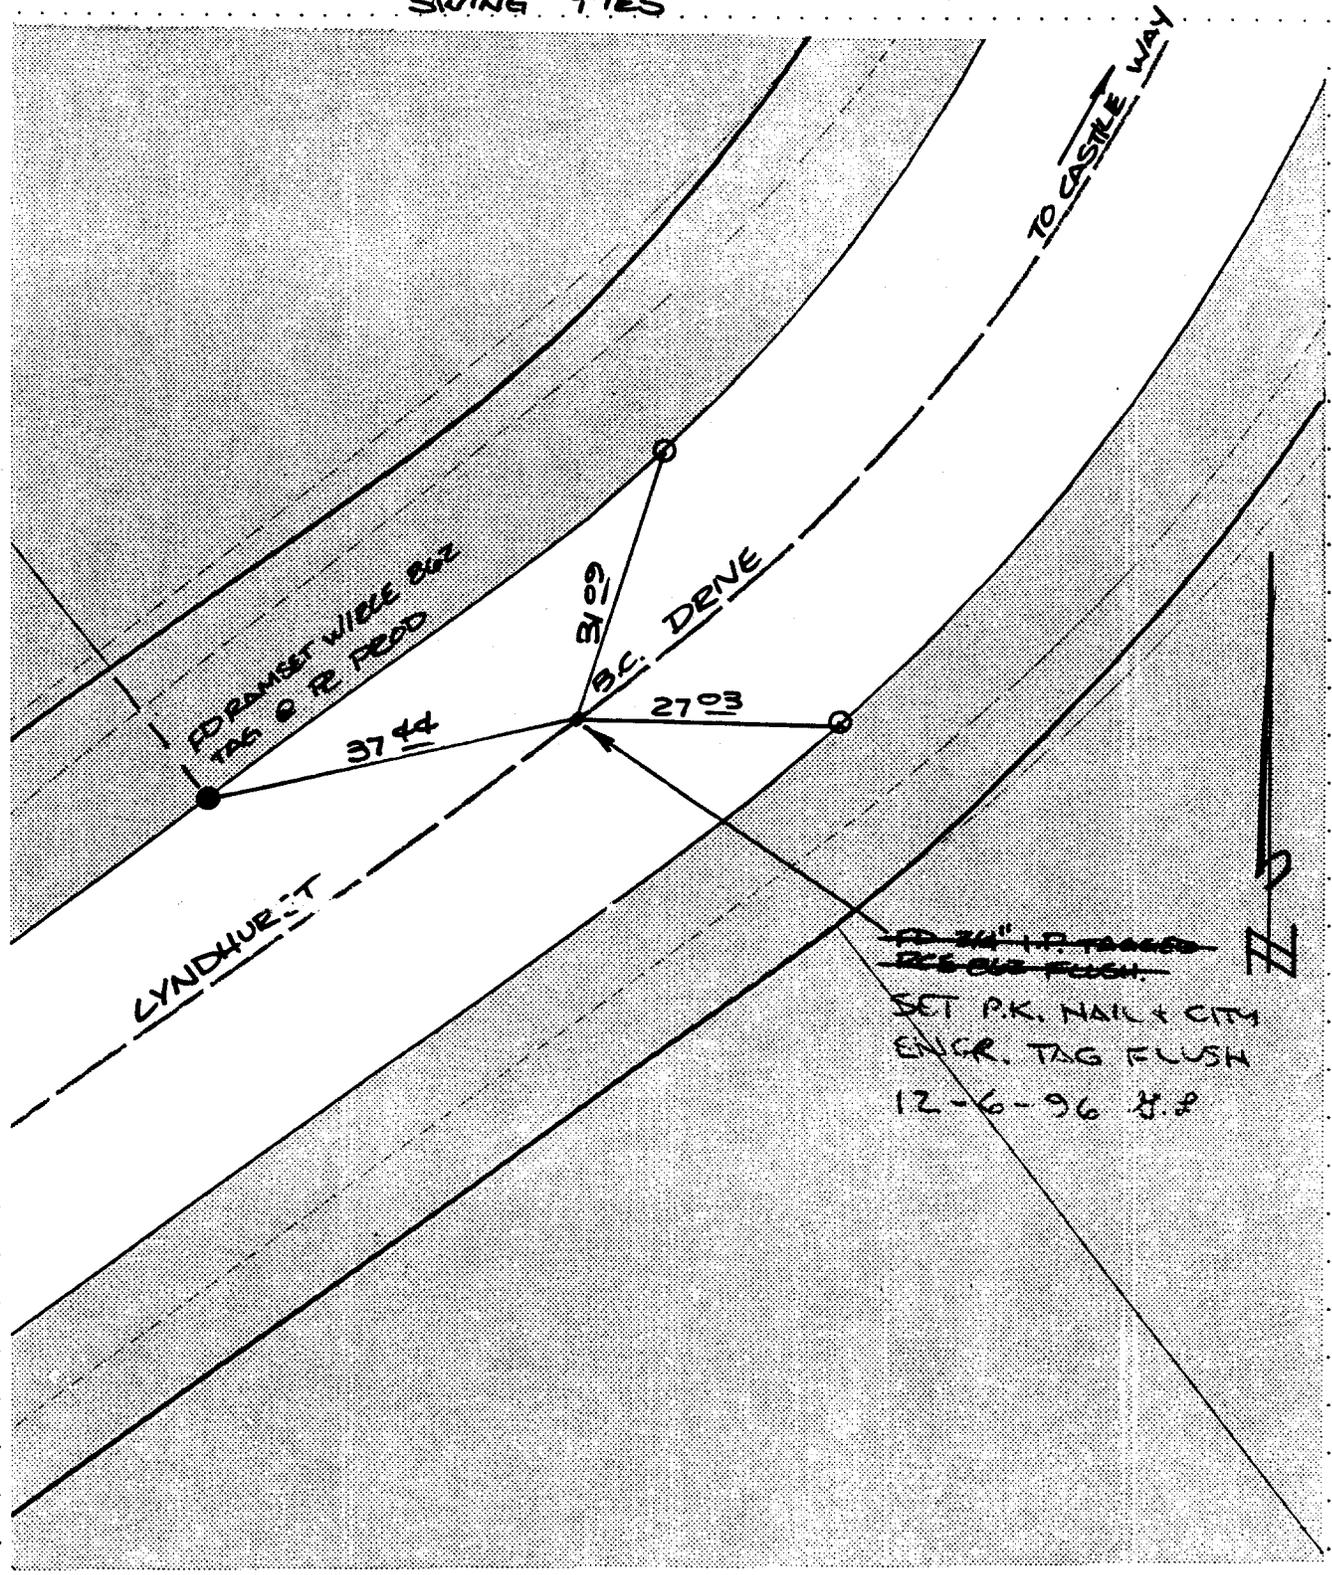

- ✕ FD. Ramset Nail on T/C
- FD. LD. & TK. on T/C
- FD. "C" Nail on T/C
- SET LD. & TK. On T/C

~~FD 2 1/2" I.P. TAGS~~
~~RES OLD FLUSH~~
SET P.K. NAIL + CITY
ENGR. TAG FLUSH
12-6-96 J.P.

SCALE: 1" = 20'
DATE: 7/11/96
DR. BY: Cvet
W.O.:
F.B.:

OFFICIAL TIE PLAT
CITY OF RIVERSIDE

These ties are for the purpose of perpetuating the found monumentation. No claim is made as to the relationship of the points or lines shown hereon to true boundary locations.

SHEET	1
OF	1
SHEETS	
FILE NO.:	