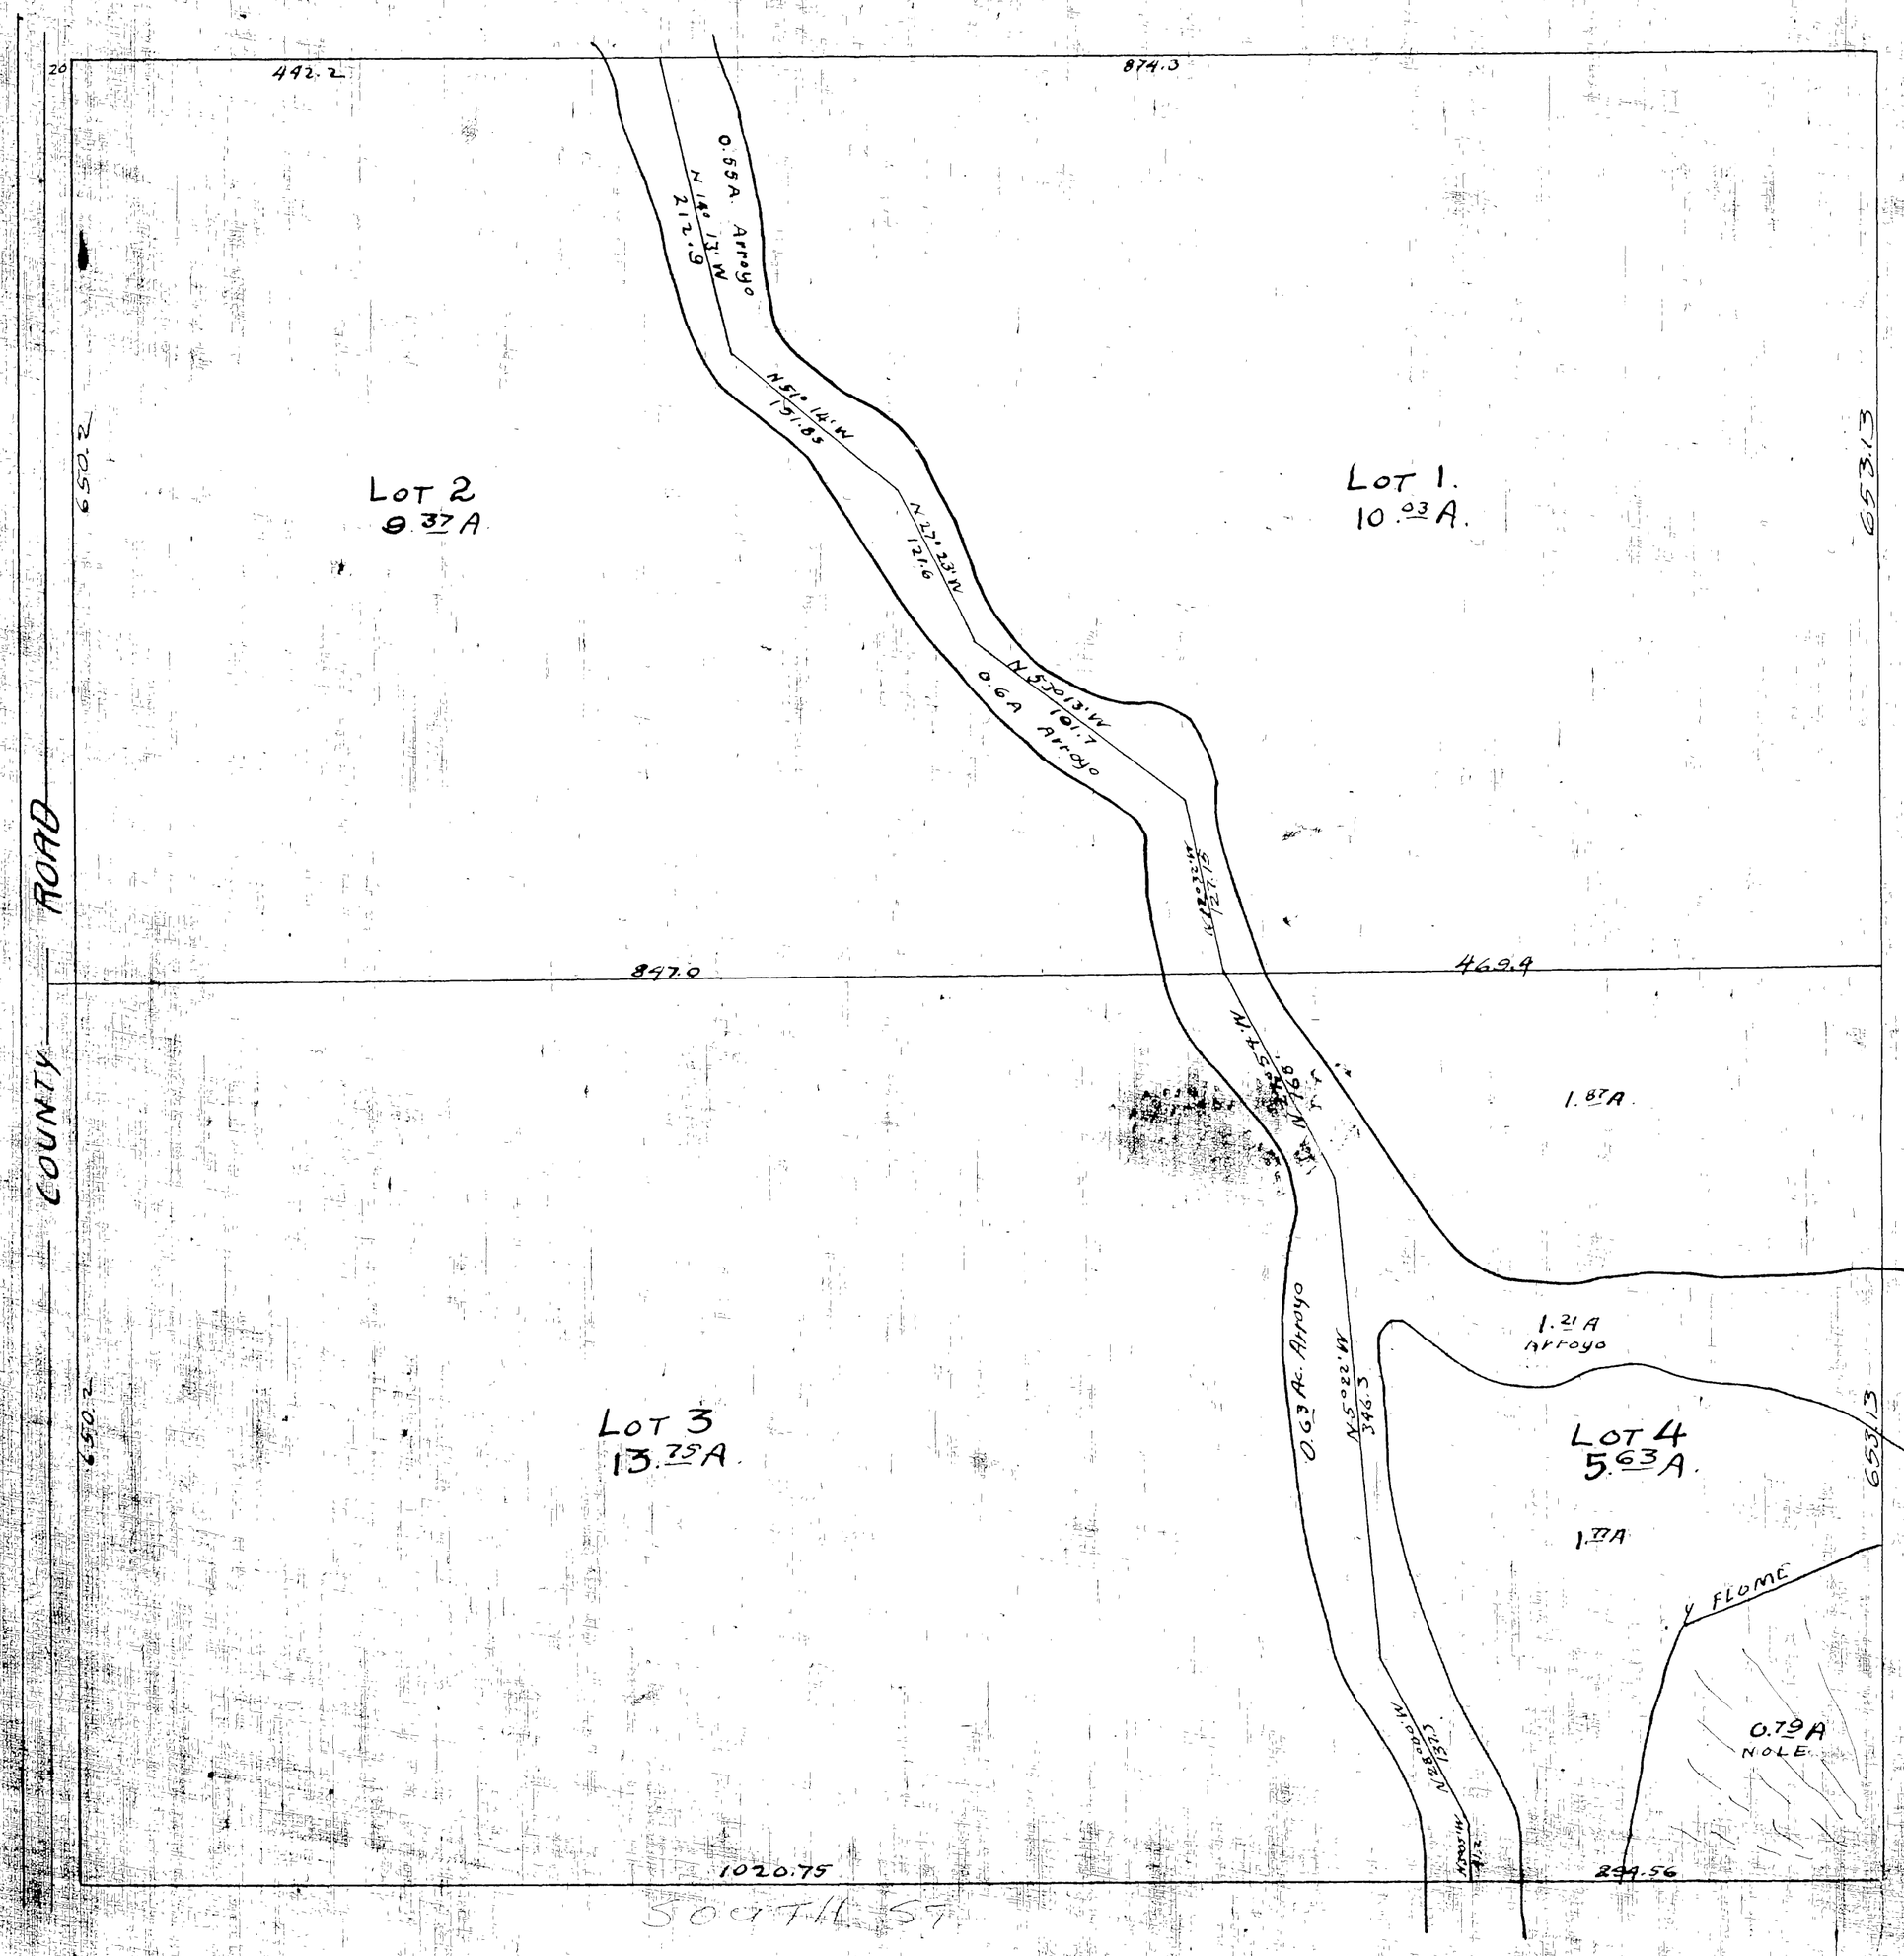

Filed Oct 14 1899

Bk. 1. pg. 33.

Record Survey

N

Map of

PRENDA SUBDIVISION

of the

S.W 1/4 of S.W 1/4 of SEC. 11 T. 3 S. R 5 W S.B.B.M.

AS SURVEYED BY

K Sanborn C.E.

Oct. 1899

Scale in = 100 ft.