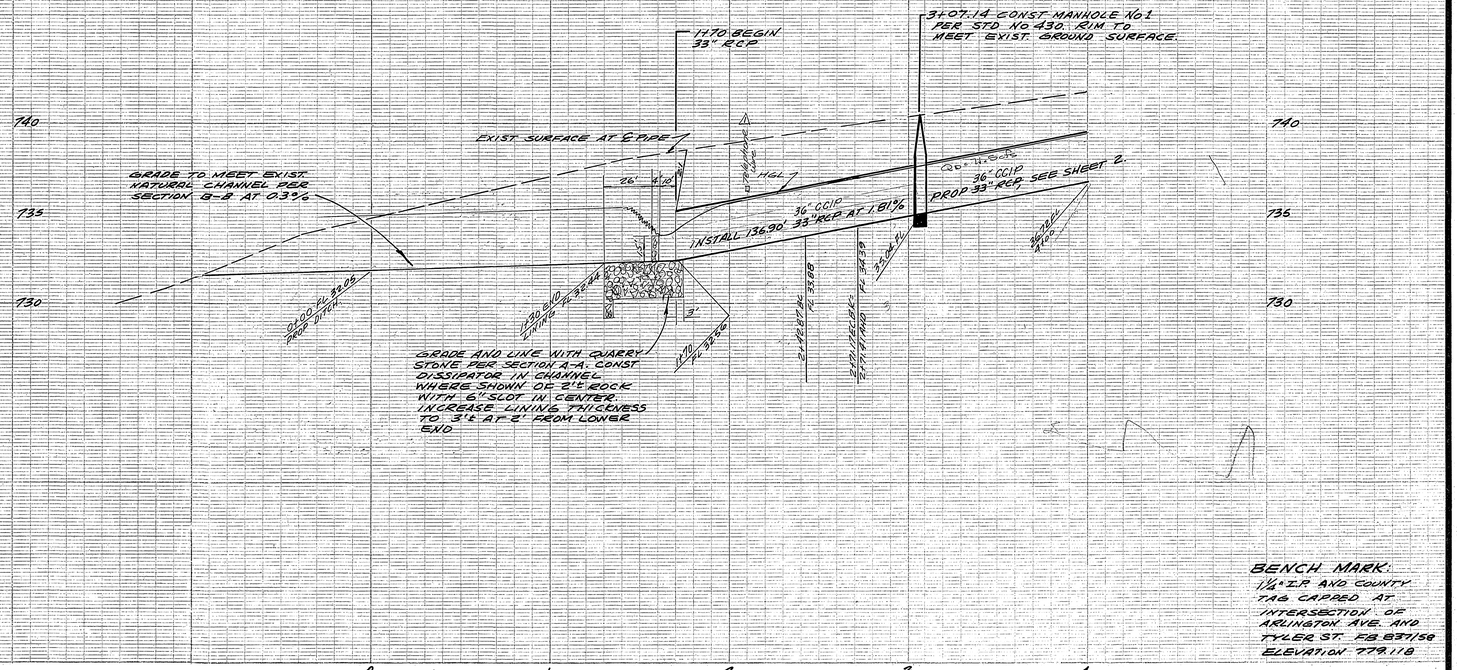

BENCH MARK:
1/4" I.P. AND COUNTY TAG CAPPED AT INTERSECTION OF ARLINGTON AVE. AND TYLER ST. FB 837/58
ELEVATION 779.118

CITY OF RIVERSIDE PROPERTY

GENERAL NOTES

1. CONSTRUCTION SHALL BE IN ACCORDANCE WITH CITY OF RIVERSIDE DEPARTMENT OF PUBLIC WORKS STANDARD DRAWINGS AND THE STANDARD SPECIFICATIONS FOR PUBLIC WORKS CONSTRUCTION, 1973 EDITION.
2. PIPE SHALL BE BEDDED PER STANDARD DRAWING No. 452, CASE 2.
3. PIPE ALTERNATE— THE CONTRACTOR MAY AT, AT HIS OPTION, SUBSTITUTE CONCRETE CAST IN PLACE PIPE ON THE FOLLOWING BASIS:
   36" CCIP FOR 33" RCP
   42" CCIP FOR 39" RCP

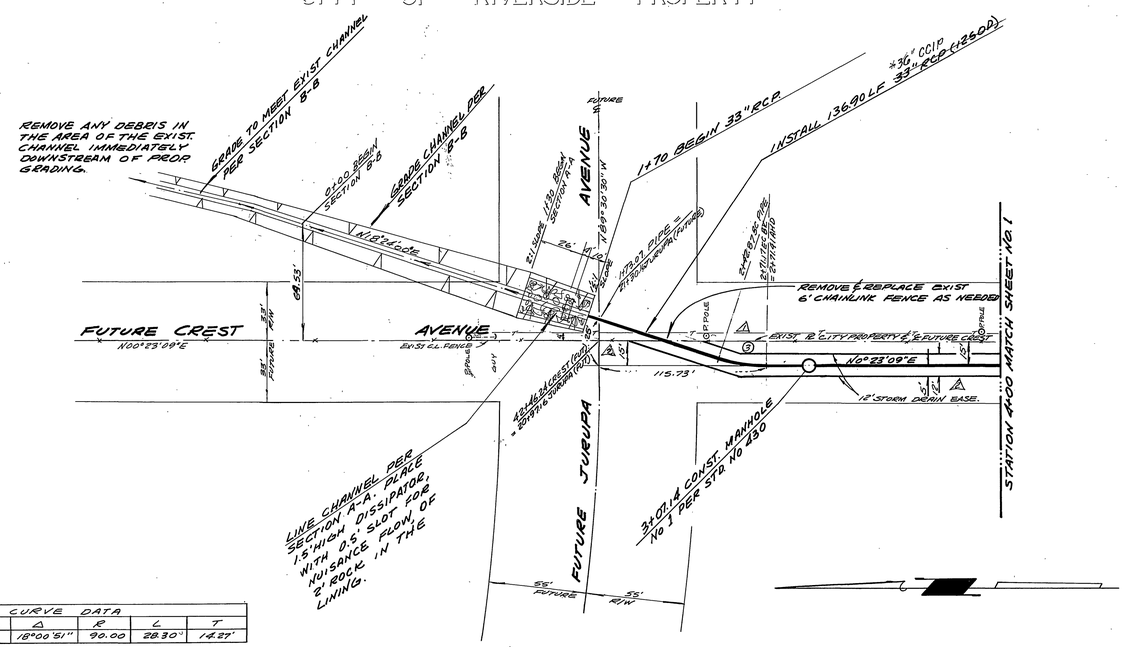

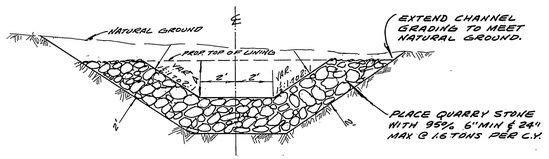

SECTION A-A
NO SCALE

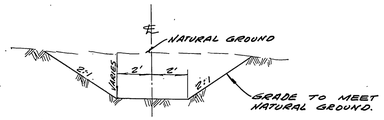

SECTION B-B
NO SCALE

CURVE DATA				
No	Δ	R	L	T
⑤	18°00'51"	90.00	28.30'	14.27'

*AS BUILT 8-76 KPT

MARK	REVISIONS	APPR.	DATE
D	ADDED TELEPHONE LINE BE 2-13-75	RPW	2/14/75
D	MOVED PIPE 1' WEST AT REQUEST OF THE CONTRACTOR BE 3/1	RPW	3/24/75

ALBERT A. WEBB ASSOCIATES
CIVIL ENGINEERS
RIVERSIDE, CALIFORNIA
APPROVED BY [signature] DATE 9-4-74
R.E. No. 21884
W.O. 74-233 FOR: CITY OF RIVERSIDE F.B. 1031
DESIGNED BY BE DRAWN BY BE CHECKED BY [illegible]

CITY OF RIVERSIDE, CALIFORNIA
PUBLIC WORKS DEPARTMENT

APPROVED BY	BY	DATE
PRINCIPAL ENGINEER	RPW	1/8
PARK DEPARTMENT		
TRAFFIC DIVISION		
CHIEF PUB. WKS. ENGR.	[illegible]	[illegible]

APPROVED BY [signature]
DIRECTOR OF PUBLIC WORKS
DATE 1-23-75

STORM DRAIN PLAN AND PROFILE
CREST AVENUE STORM DRAIN
SCALE: HORZ 1"=40' VERT 1"=4'

ACCOUNT No. 495
DRAWING NUMBER D-274
SHEET 1 OF 2
74-233

T-5522

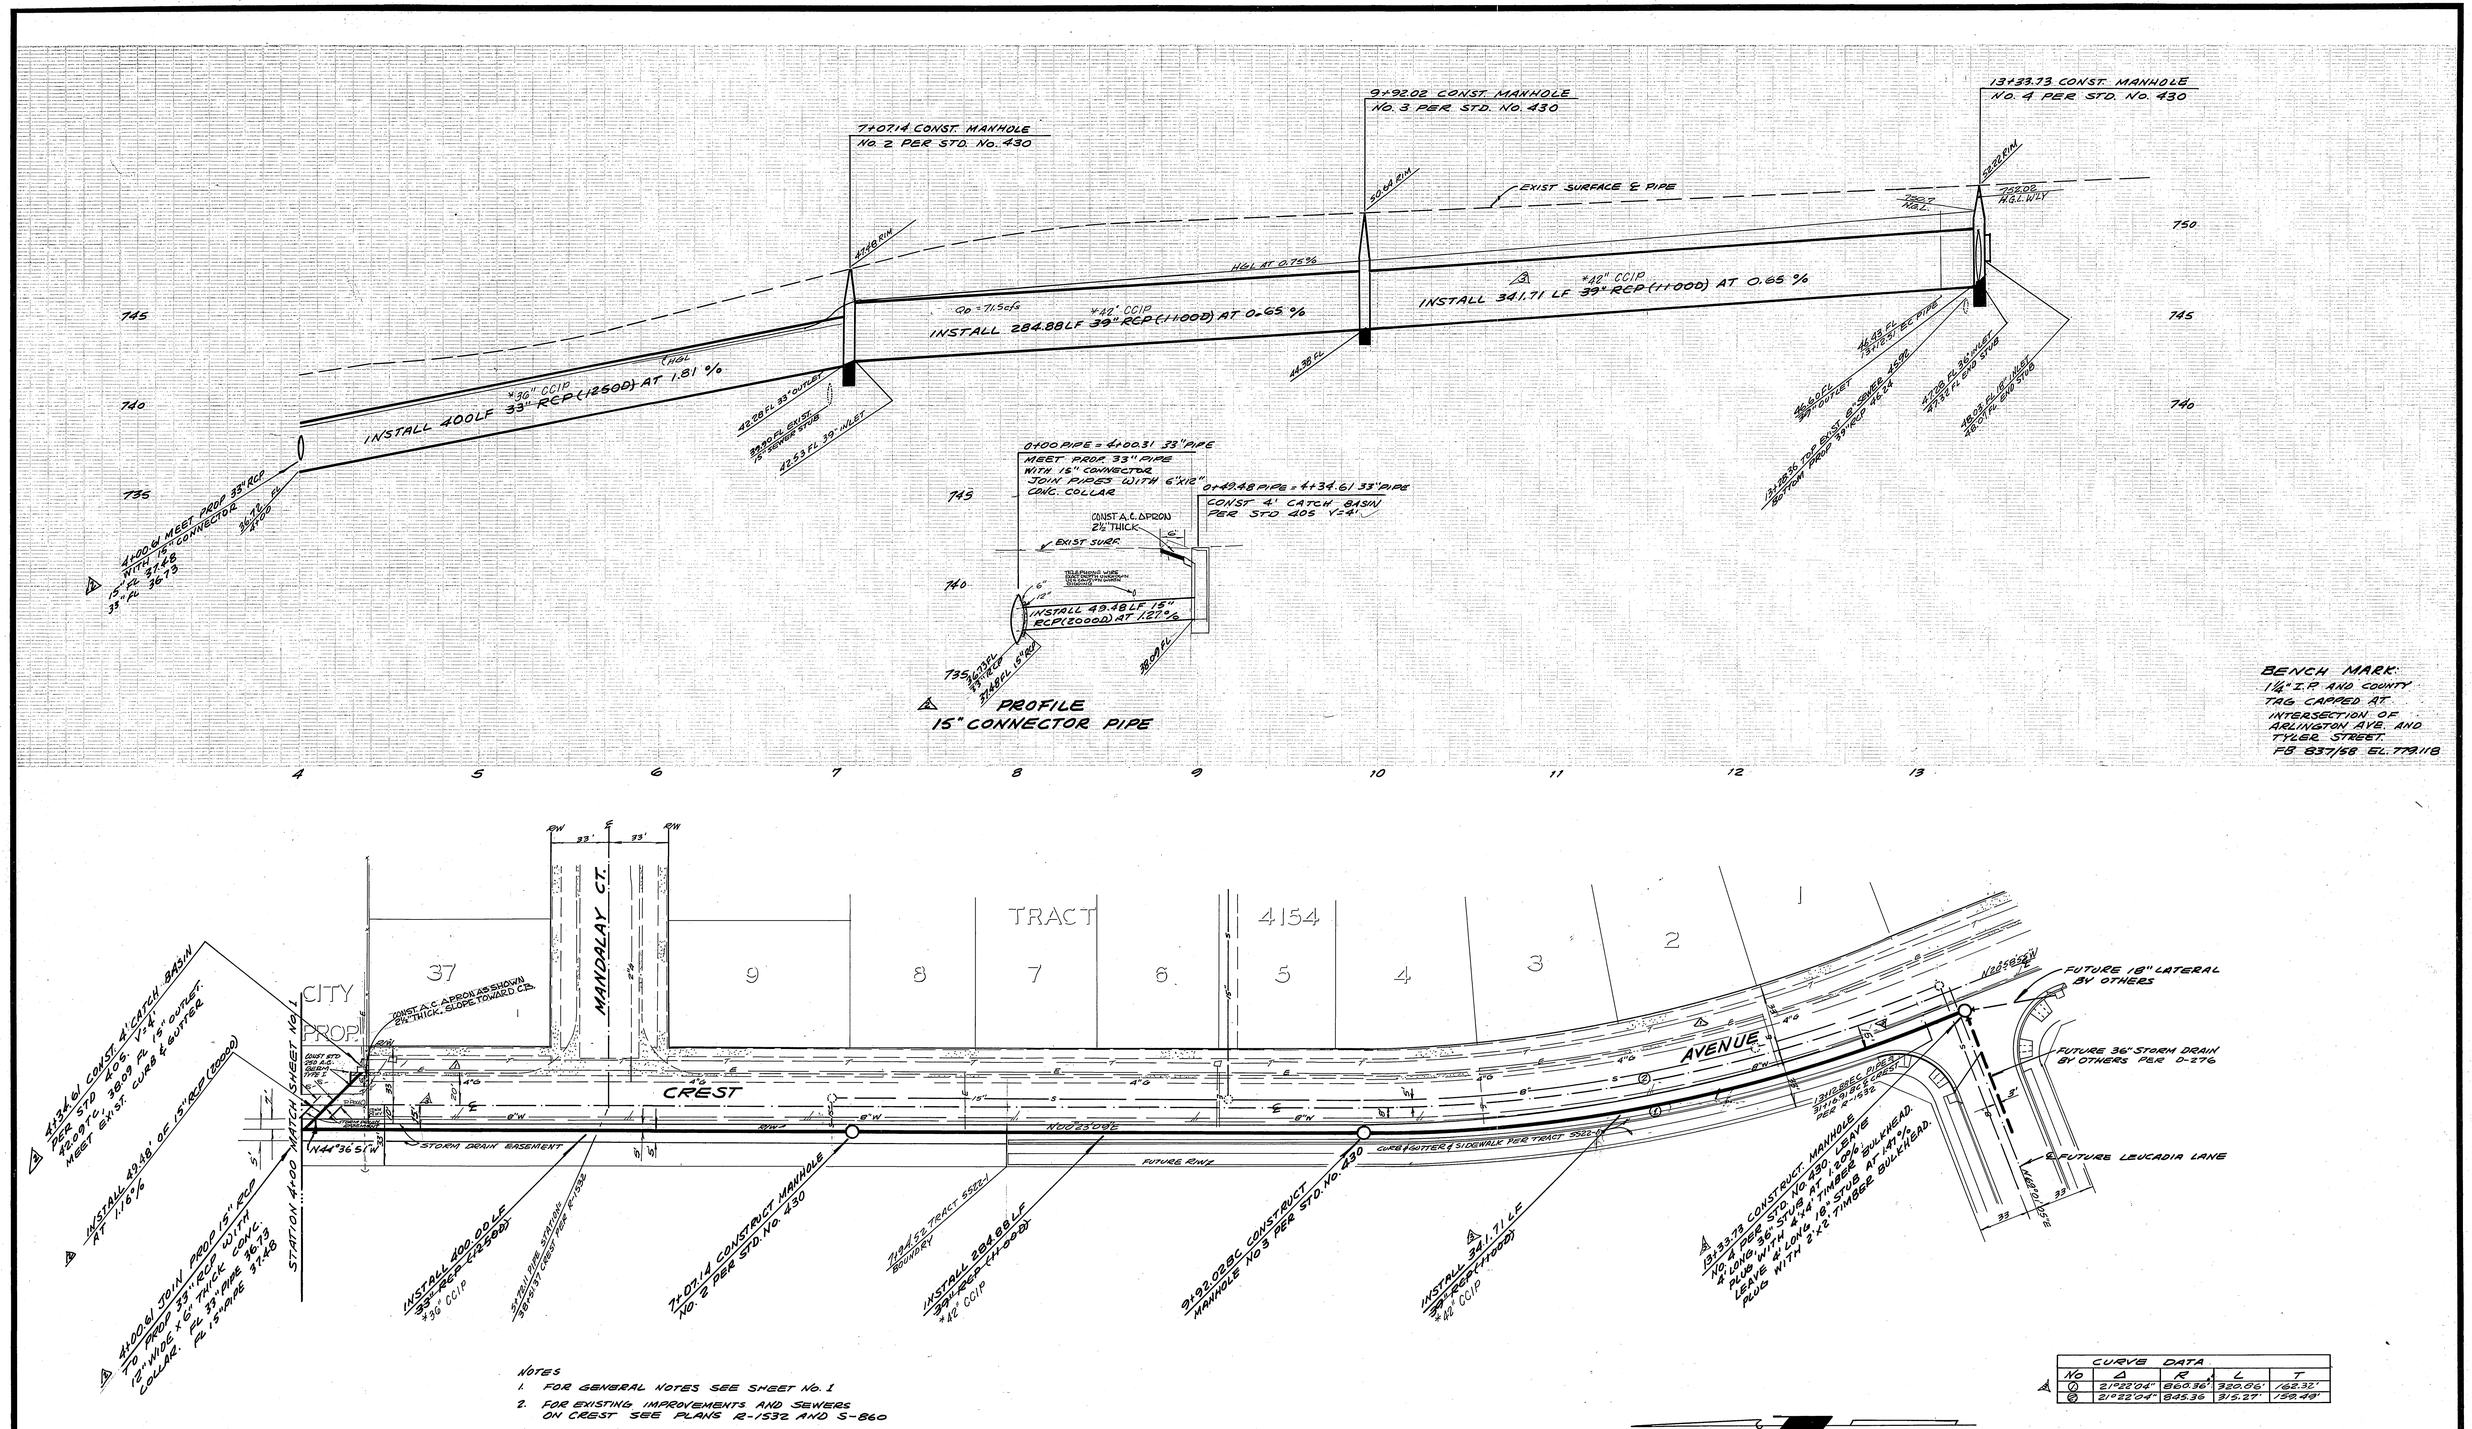

*AS BUILT 8-76 KPT

ALBERT A. WEBB ASSOCIATES CIVIL ENGINEERS RIVERSIDE, CALIFORNIA APPROVED BY [signature] DATE 8-4-74 R.E. No. 21884	4 ADDED TELEPHONE LINE TBG 2-13-75	TTW	2/14/75	CITY OF RIVERSIDE, CALIFORNIA PUBLIC WORKS DEPARTMENT
	3 ADDED CATCH BASIN & 18"	TTW	9/16/75	
	CONNECTOR PIPE PER			
	2-174 RESOURSY.			
	2 MOVED PIPE 1' WEST AT REQUEST OF W/R CONTRACTOR.	TTW	4/14/76	
MARK	REVISIONS	APPR.	DATE	
W.O. 74-233 FOR: CITY OF RIVERSIDE F.B. 1031	DESIGNED BY RE DRAWN BY RE CHECKED BY			

APPROVED BY	BY	DATE
PRINCIPAL ENGINEER	TTW	1/13
PARK DEPARTMENT		
TRAFFIC DIVISION		
CHIEF PUB. WKS. ENGR.		1-23

APPROVED BY [signature]
DIRECTOR OF PUBLIC WORKS
DATE 1-23-75

STORM DRAIN PLAN AND PROFILE

CREST AVENUE STORM DRAIN

SCALE: HORZ 1" = 40' VERT 1" = 4'

ACCOUNT No. 495
DRAWING NUMBER D-274
SHEET 2 OF 2
74-233

T-5522