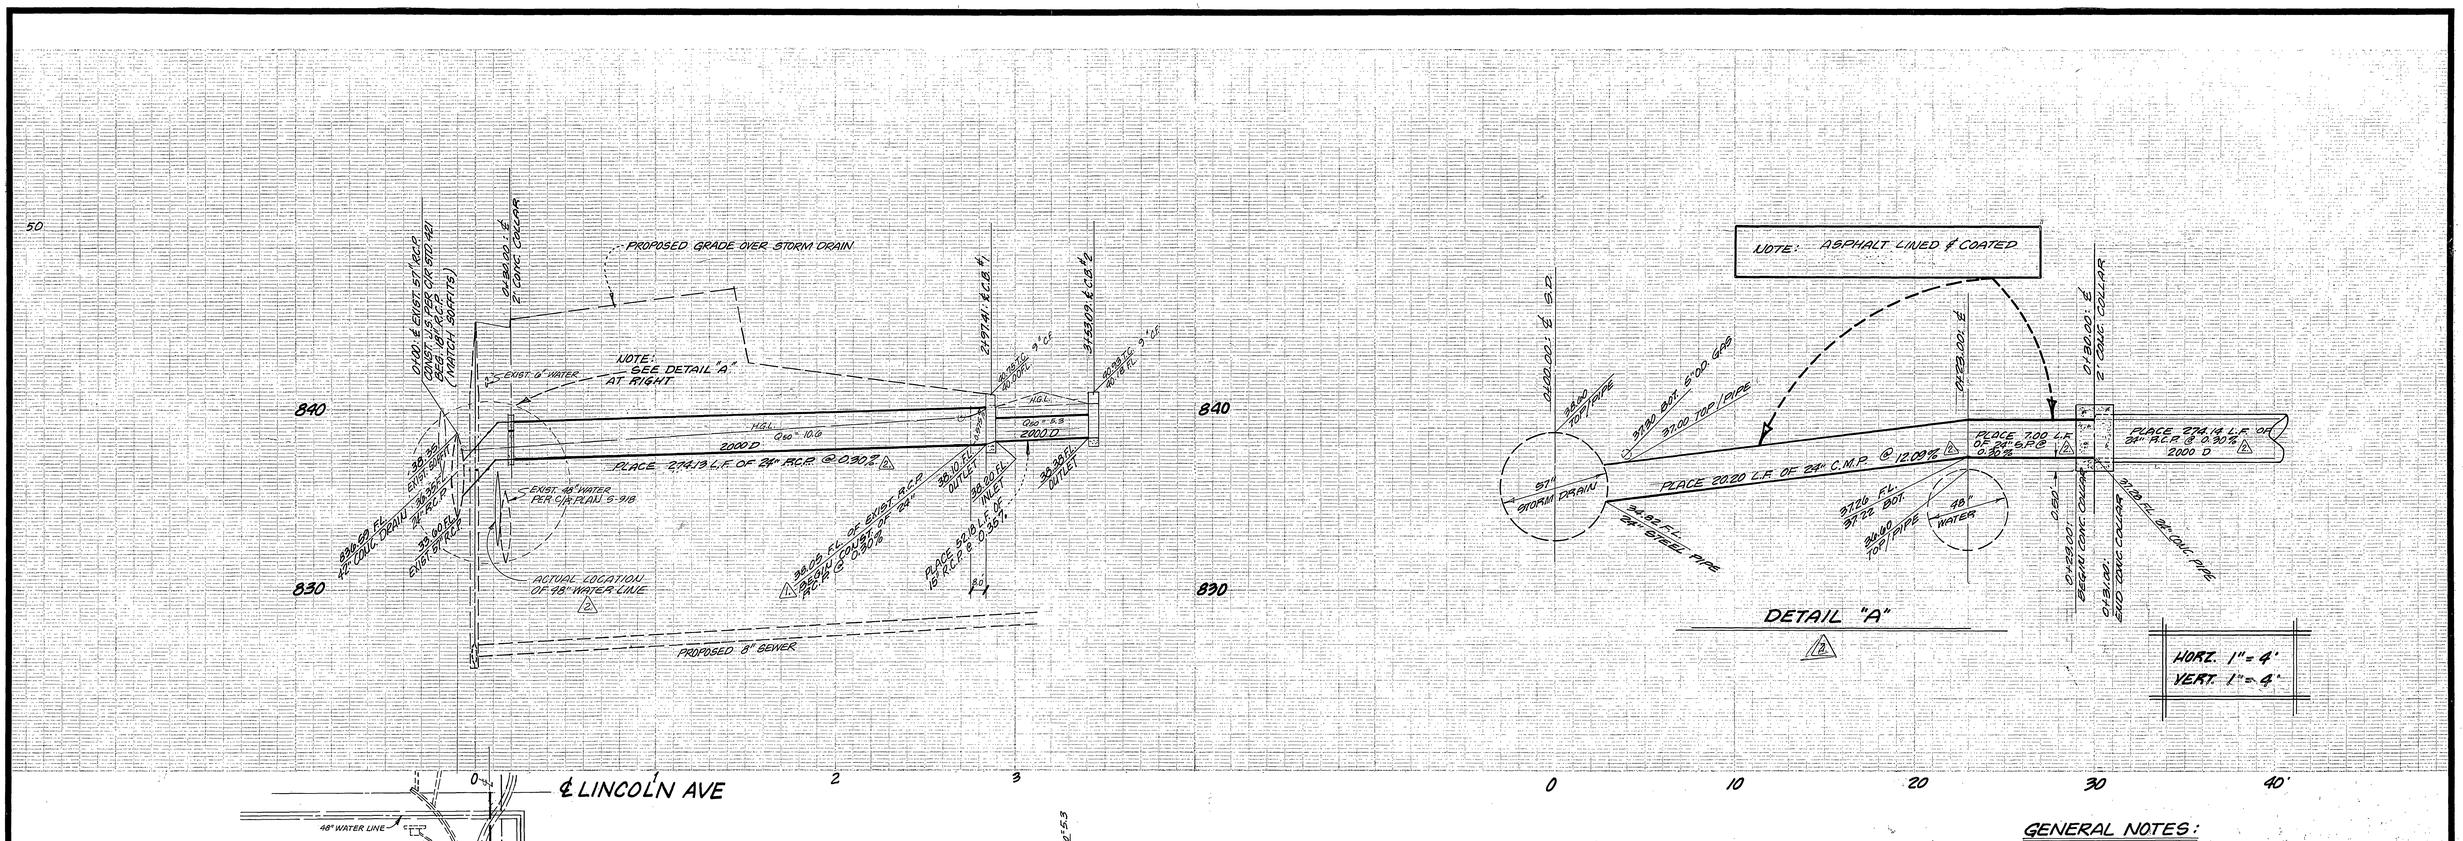

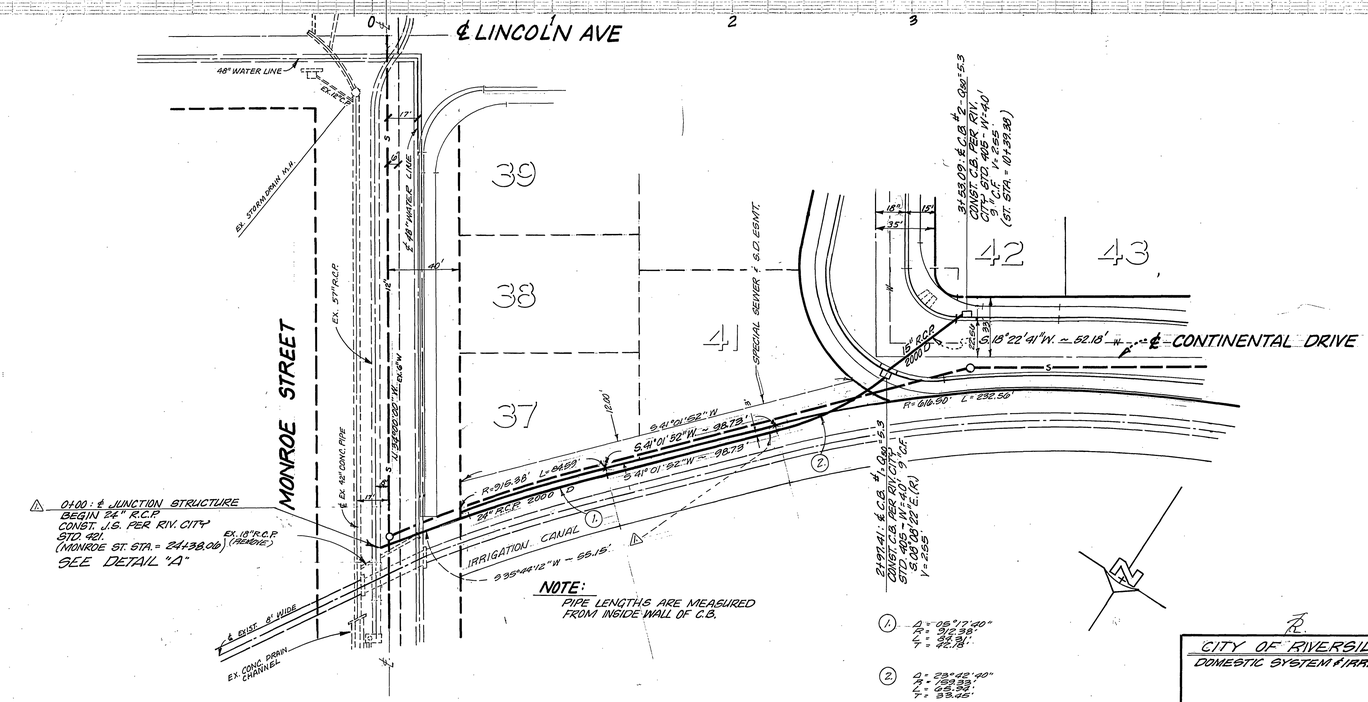

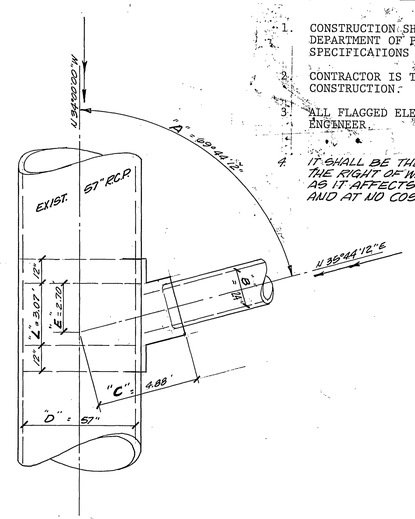

GENERAL NOTES:

1. CONSTRUCTION SHALL BE IN ACCORDANCE WITH THE CITY OF RIVERSIDE DEPARTMENT OF PUBLIC WORKS, STANDARD DRAWINGS, AND THE STANDARD SPECIFICATIONS FOR PUBLIC WORKS CONSTRUCTION, 1976 EDITION.
2. CONTRACTOR IS TO VERIFY EXISTING STORM DRAIN ELEVATION PRIOR TO CONSTRUCTION.
3. ALL FLAGGED ELEVATIONS SHALL BE STAKED IN THE FIELD BY THE PRIVATE ENGINEER.
4. IT SHALL BE THE RESPONSIBILITY OF THE CONTRACTOR TO CLEAR THE RIGHT OF WAY IN ACCORDANCE WITH THE PROVISIONS OF LAW AS IT AFFECTS EACH UTILITY INCLUDING IRRIGATION LINES, AND AT NO COST TO THE CITY.

CITY OF RIVERSIDE
DOMESTIC SYSTEM & IRRIGATION SYSTEM
Wesley Hylen 8-10-77
CHIEF UTILITIES ENGINEER, WATER — DATE

BENCH MARK:

CITY OF RIVERSIDE BENCH MARK NO. P-6-H FOUND P.K. NAIL AND TAG IN RIVERSIDE WATER COMPANY CANAL HEAD WALL ON WEST SIDE MONROE STREET. C/R R.B. 839/33 ELEV. = 845.60

J. F. DAVIDSON ASSOCIATES
CIVIL ENGINEERS - SURVEYORS - PLANNERS
RIVERSIDE, CALIFORNIA
APPROVED BY [signature] DATE 11/9/76
R.E. No. 17880
W.O. 4918 FOR: WOODHAVEN DEV. CO. F.B. 1100

MARK	REVISIONS	APPR.	DATE
1	REVISED SPOON DRAIN LOCATION & ADD CURB AND GUTTER TO EXISTING	RW	8/11/77
2	REVISED SPOON DRAIN PROFILE & ADD CURB AND GUTTER TO EXISTING	RW	8/17/77

DESIGNED BY ____ DRAWN BY ____ CHECKED BY ____

CITY OF RIVERSIDE, CALIFORNIA
DEPARTMENT OF PUBLIC WORKS

APPROVED BY	BY	DATE
PRINCIPAL ENGINEER	[signature]	4/86
PARK DEPARTMENT	[signature]	3-21
TRAFFIC DIVISION		
CHIEF P. W. ENGR.		

APPROVED BY [signature] DIRECTOR OF PUBLIC WORKS
DATE 5-2-77

*AS BUILT 8-78 KET

S.D. PLAN & PROFILE
TRACT NO. 8266
CONTINENTAL DRIVE & EASEMENT TO MONROE STREET

HORIZ. SCALE: 1" = 40' VERT. SCALE: 1" = 4'

INDEXED E.T.
PROJECT NO. D-310
SHEET 1 OF 1
FILE NO. 5510