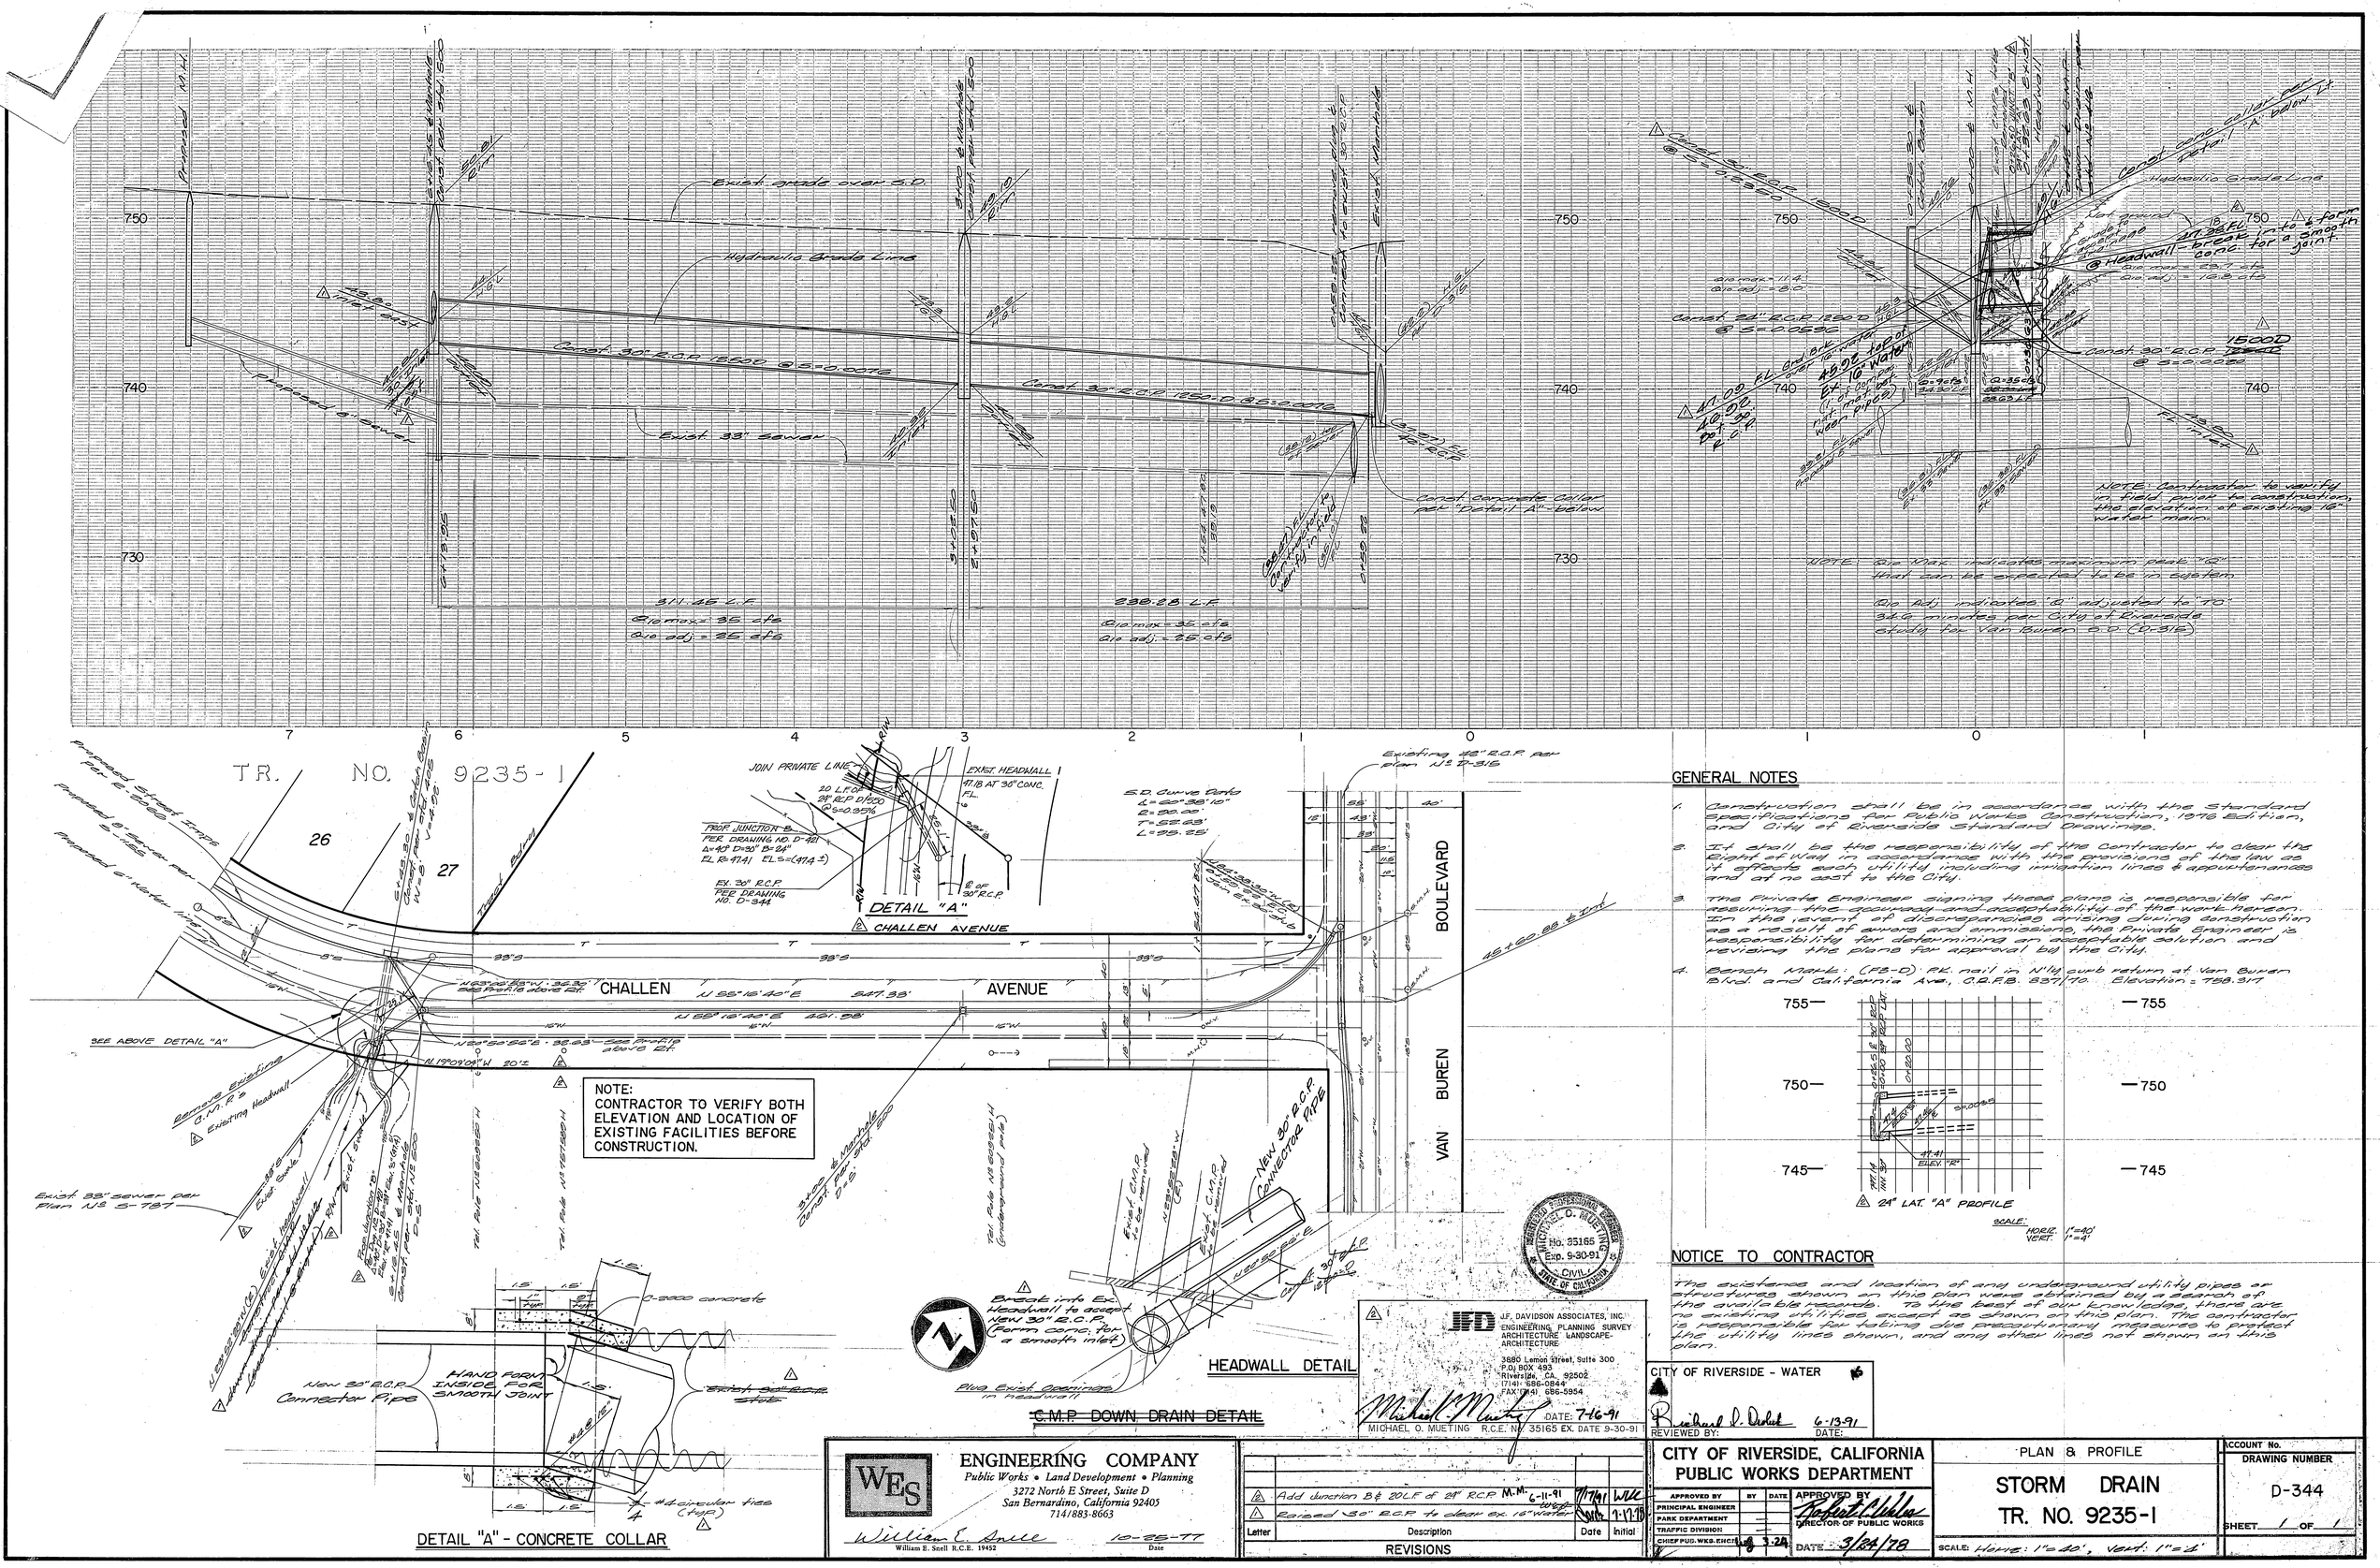

GENERAL NOTES

1. Construction shall be in accordance with the Standard Specifications for Public Works Construction, 1976 Edition, and City of Riverside Standard Drawings.
2. It shall be the responsibility of the Contractor to clear the Right of Way in accordance with the provisions of the law as it effects each utility including irrigation lines & appurtenances and at no cost to the City.
3. The Private Engineer signing these plans is responsible for assuring the accuracy and acceptability of the work hereon. In the event of discrepancies arising during construction as a result of errors and ommissions, the Private Engineer is responsibility for determining an acceptable solution and revising the plans for approval by the City.
4. Bench Mark: (F3-D) P.K. nail in N'ly curb return at Van Buren Blvd. and California Ave., C.R.F.B. 837/70. Elevation = 758.317

NOTICE TO CONTRACTOR

The existence and location of any underground utility pipes or structures shown on this plan were obtained by a search of the available records. To the best of our knowledge, there are no existing utilities except as shown on this plan. The contractor is responsible for taking due precautionary measures to protect the utility lines shown, and any other lines not shown on this plan.

REGISTERED PROFESSIONAL ENGINEER MICHAEL O. MUETING No. 35165 Exp. 9-30-91 CIVIL STATE OF CALIFORNIA

J.F. DAVIDSON ASSOCIATES, INC.
ENGINEERING PLANNING SURVEY
ARCHITECTURE LANDSCAPE-ARCHITECTURE
3880 Lemon Street, Suite 300
P.O. BOX 493
Riverside, CA. 92502
(714) 686-0844
FAX (714) 686-5954
Michael O. Mueting DATE: 7-16-91
MICHAEL O. MUETING R.C.E. No. 35165 EX. DATE 9-30-91

CITY OF RIVERSIDE - WATER
Richard D. Drolet 6-13-91
REVIEWED BY: DATE:

WES ENGINEERING COMPANY
Public Works • Land Development • Planning
3272 North E Street, Suite D
San Bernardino, California 92405
714/883-8663
William E. Snell 10-25-77
William E. Snell R.C.E. 19452 Date

Letter	Description	Date	Initial
2	Add Junction B & 20 L.F. of 24" R.C.P. M.M. 6-11-91	7/17/91	WLL
1	Raised 30" R.C.P. to clear ex. 16" water	7-17-78	

REVISIONS

CITY OF RIVERSIDE, CALIFORNIA
PUBLIC WORKS DEPARTMENT

APPROVED BY	BY	DATE
PRINCIPAL ENGINEER		
PARK DEPARTMENT		
TRAFFIC DIVISION		
CHIEF PUB. WKS. ENGR.		3-24

APPROVED BY Robert C. Wales
DIRECTOR OF PUBLIC WORKS
DATE 3/24/78

PLAN & PROFILE
STORM DRAIN
TR. NO. 9235-1
SCALE: Horiz: 1"=40', Vert: 1"=4'

ACCOUNT No.
DRAWING NUMBER D-344
SHEET 1 OF 1