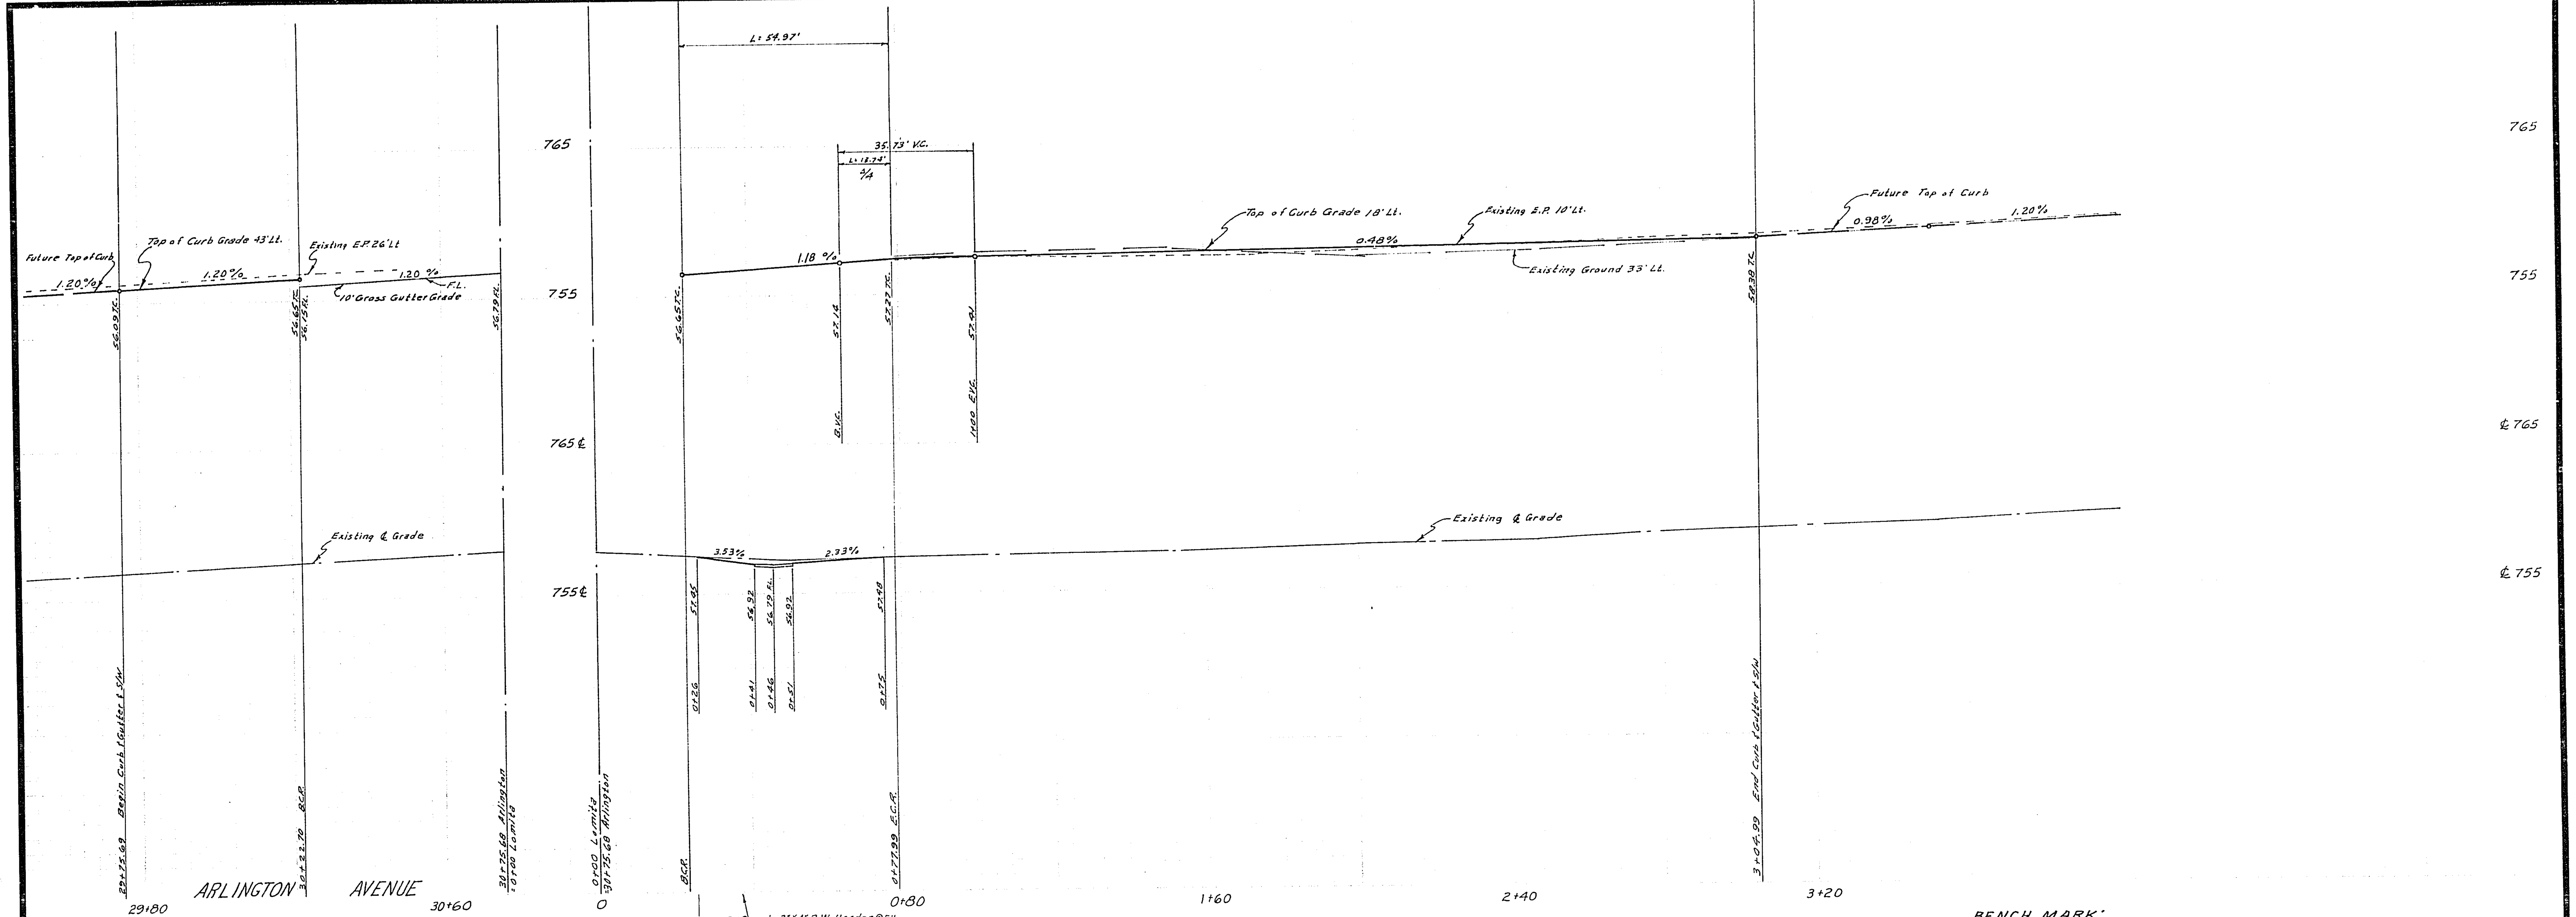

BENCH MARK:
C/R F.B. R-5110, Elev. 751.66 "PK" nail in lead in nose of center curb at Airport Drive

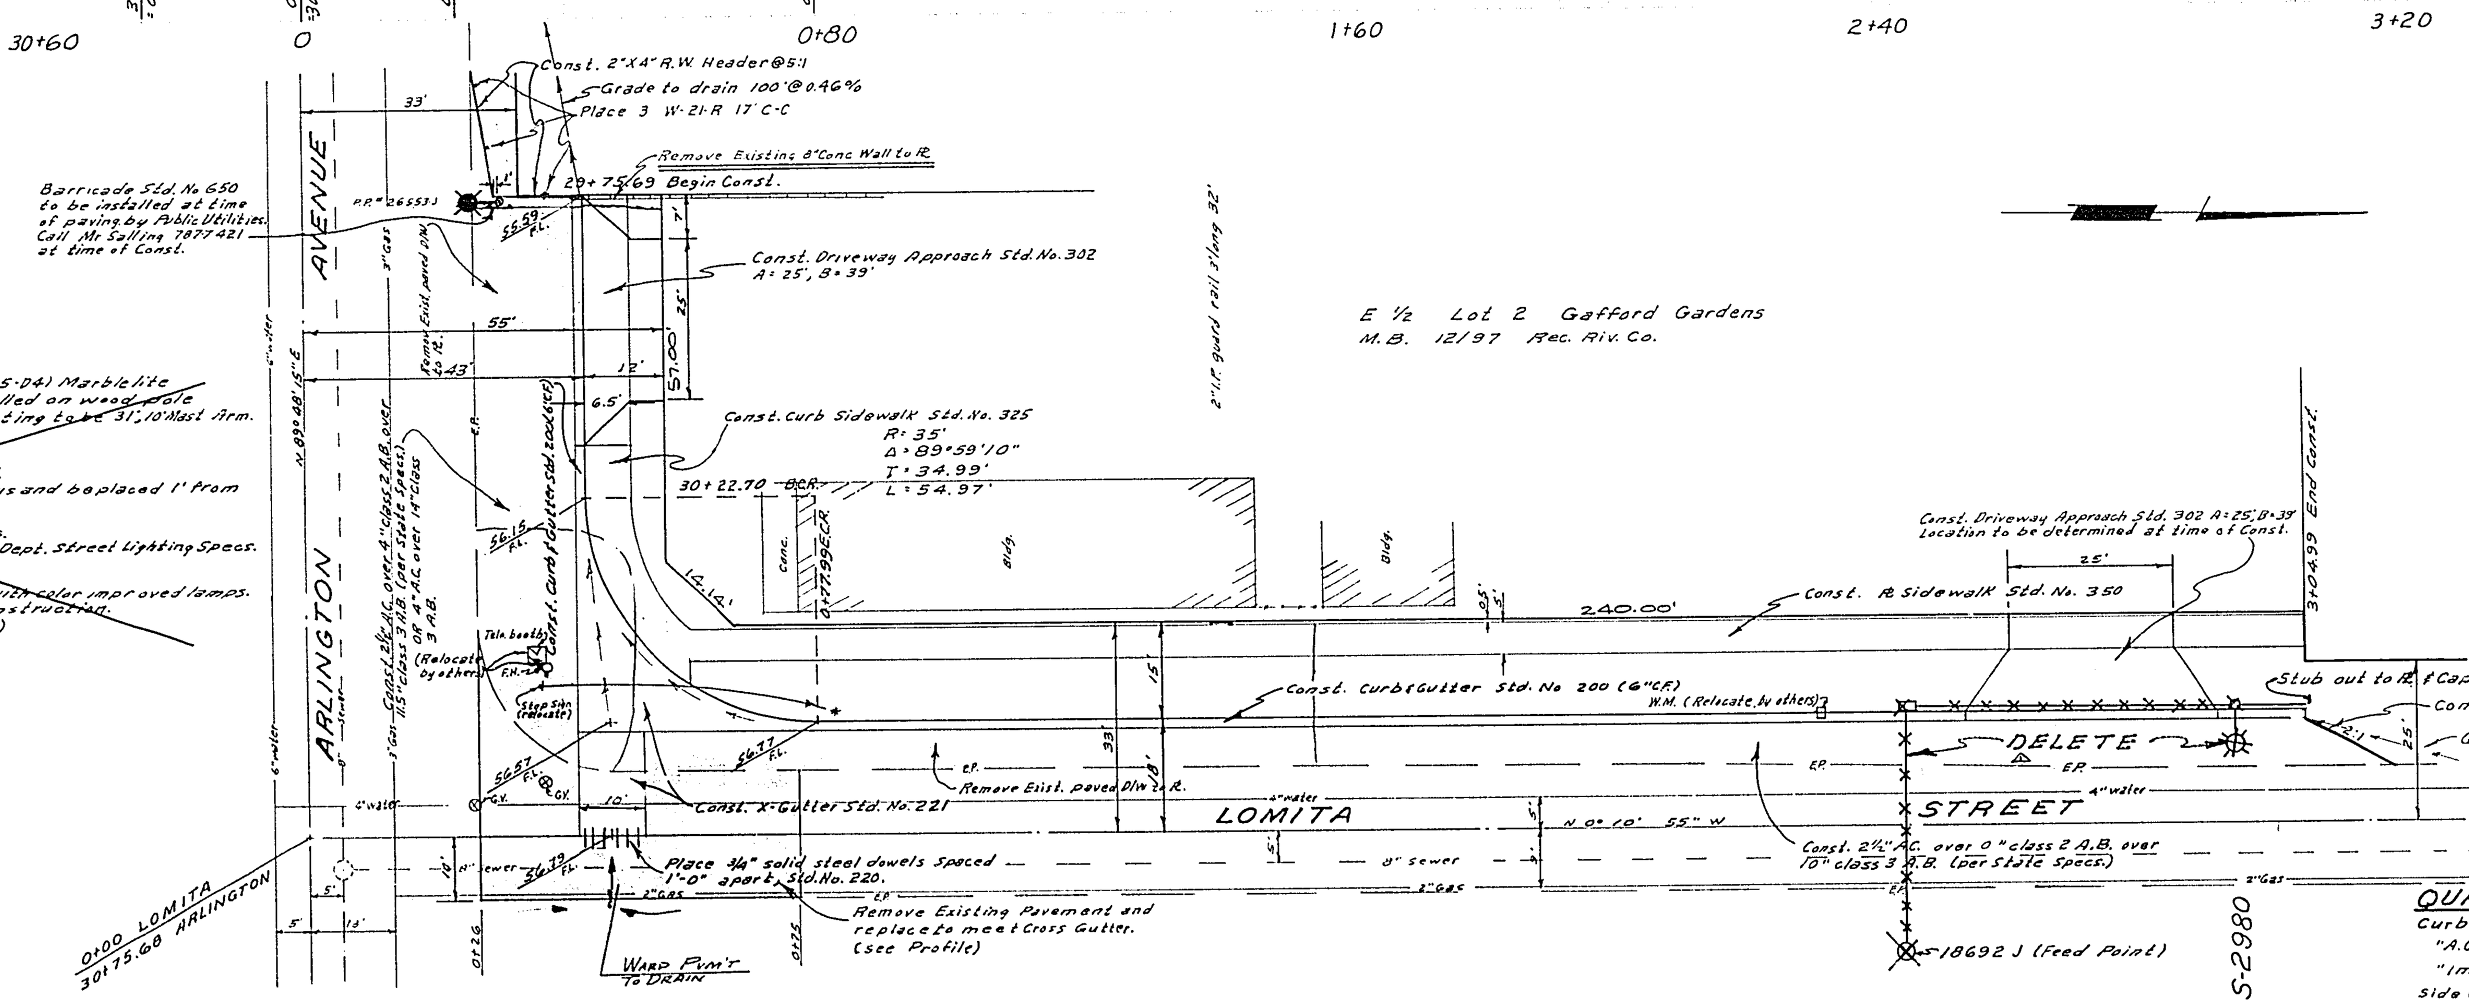

△ LIGHTING NOTES

~~Indicates Feed Point~~
~~Indicates Light Standard (City of Riverside Std. No. 45-D4) Marblelite~~
~~Indicates 20,000 LU. 4000 W. M.V. Luminaire to be installed on wood pole by Utilities Dept. upon receipt of $250.00, Mounting to be 31', 10' Mast Arm.~~
~~Indicates Pull Box (City of Riverside Std. No. L1-13001)~~
~~Indicates 1" conduit (Rigid Galvanized)~~

~~1. Light Standards and Pull Boxes to be located in the Field.~~
~~2. Light Standards shall be checked for clearance of driveways and be placed 1' from end of curb returns.~~
~~3. Spacing of Standards shall be as shown on plan.~~
~~4. Inspection shall be called for as outlined in Specifications.~~
~~5. All construction to comply with City of Riverside Light Dept. Street Lighting Specs.~~
~~6. All cable to be American Wire Gage #8~~
~~7. This system to be 2W, 240V Multiple.~~
~~8. Luminaires to be 7000 LU. M.V., LM Cat #LM44A1 or equal, with color improved lamps.~~
~~9. Feed points to be confirmed with Utilities at time of Construction.~~
~~10. Light Standard foundation details (Drawing No. L1-13008)~~

$75.00 - Connect Fee Paid 3-31-65

$250.00 - M.V. on Wood Pole Paid 3-31-65

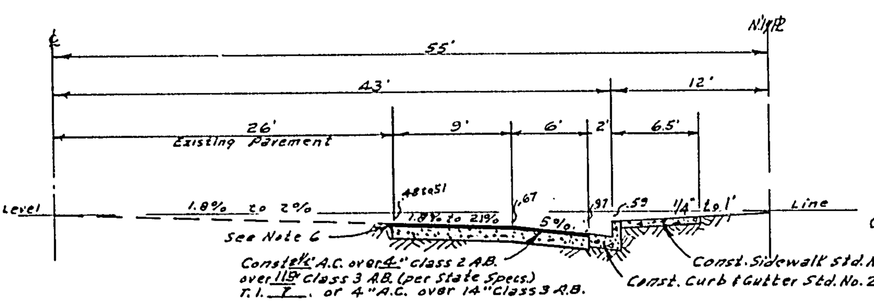

TYPICAL SECTION
ARLINGTON AVENUE
NO SCALE

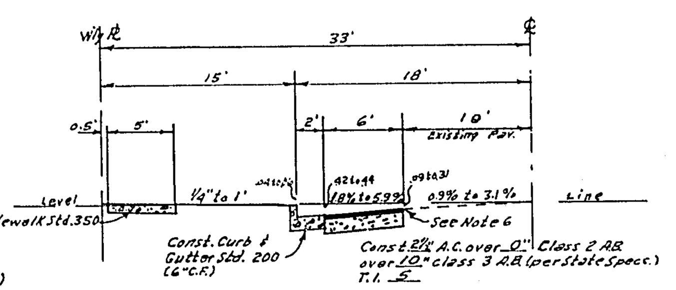

TYPICAL SECTION
LOMITA STREET
NO SCALE

(7) The finished sub grade shall have a compaction of not less than 90% for a depth of 0.5 foot as determined by test method No. "Calif. 216F" immediately prior to placement of the cover.

△ ~~(8) Check with street lighting engineer for street light requirements, Ph. 787-7421. Prior to S/W Const.~~

QUANTITY ESTIMATE

Curb & Gutter Std. No. 200 (6" C.F.)	251	L.F.
"A.C. & seal coat	4,112	S.F.
"Imported Base Material		C.Y.
Sidewalk Std. No. 325	210	S.F.
Sidewalk Std. No. 350	1,105	S.F.
2"X4" Redwood Header	60	L.F.
Cross Gutter Std. No. 221	454	S.F.
W-21-R	3	Ea.
Pavement Removal	4,600	S.F.
Driveway Approach Std. 302	898	S.F.

S.R. 405 R-20

~~APPROVED BY Don Campbell DATE 3-31-65~~
~~GEN. SUPT. & CHIEF ENGR.~~

ALBERT A. WEBB ASSOCIATES
CIVIL ENGINEERS
RIVERSIDE, CALIFORNIA
APPROVED BY [signature] DATE 2/6/65
R.E. No. 9676
W.O. 65-22 FOR: BERNARD W. BECKER F.B. 554

MARK	REVISIONS	APPR.	DATE
△	Deleted St. Lights per Memo from Light Dept. to Public Works dated 11-28-72		12-18-72

DESIGNED BY B.E.L. DRAWN BY B.E.L. CHECKED BY A.W.

CITY OF RIVERSIDE, CALIFORNIA
DEPARTMENT OF PUBLIC WORKS

APPROVED BY	BY	DATE
OFFICE ENGINEER		4.2
PARK DEPARTMENT		
TRAFFIC DIVISION		3/31/65
ASSISTANT CITY ENG.		4.2
~~PUBLIC UTILITIES ENG.~~		4.1

APPROVED BY [signature]
DIRECTOR OF PUBLIC WORKS
DATE 4-2-65

STREET PLAN & PROFILE
ARLINGTON AVENUE
AND
LOMITA STREET
ZONING CASE NO. R-49-645

HORIZ. SCALE: 1" = 20' VERT. SCALE: 1" = 5'

PROJECT NO. 247
R-1019
~~L5-13032~~
SHEET 1 OF 1
FILE NO. 65-22-A

72-457

72-457A