
PROFILE
CANYON CREST DR
Top of Future Curb
LIMIT OF CITY PROJECT
LIMIT OF CITY PROJECT
LIMIT OF CITY PROJECT
CANYON
CREST
DRIVE
42+00
END TAPER
41+60
39+10
35+95
22+31.94
29+78
TRACT
3081
TRACT
2693
PEARBLOSSOM DR
NAVAJO DRIVE
Remove 2" layer of A.C. & place 4" A.C. over 10.5' A.B.
Remove strip of pavement
Exist 18" C.M.P.
Exist N.C. Swale
SHADING LEGEND
INDICATES PAVING TO BE CONST. UNDER THIS CONTRACT.
PROFILE
NOTE BOOK NO.
SURVEYED
PLOTTED
GRADES CALCULED
STRUCTURE NOTATIONS CHKD
BY
DATE
PLAN
NOTE BOOK NO.
SURVEYED
PLOTTED
ROW CALCULED
PL OF ROW CHECKED
BY
DATE
Const. 3" A.C. over compacted subgrade from sta. 35+45 to 42+30.
Const. 4" A.C. over 10.5' Cl. 3 A.B. from sta. 29+90 to 37+25.
TYPICAL SECTION
CANYON CREST DRIVE
Scale: Hor. 1"=10'
Vert. 1"=5'
SHEET INDEX
No Scale
BENCH MARK: CHISELED "X" IN N.W. COR. OF CONC. WEIR BOX AT S.W. COR. CANYON CREST & MONTE VISTA
ELEV. 1086.08
REVISIONS
MARK
DATE
DESCRIPTION
5/18/66
Plan adapted from R-1031
DESIGNED BY
DRAWN BY
CHECKED BY
RECOMMENDED BY
ASSISTANT CITY ENGINEER
HUGH M. GALLAHER
Civil Engineer
Riverside, California
Approved by
Date 3-22-66
CITY OF RIVERSIDE CALIFORNIA
DEPARTMENT OF PUBLIC WORKS
CANYON CREST DRIVE
E'LY SIDE
400' S/O PEARBLOSSOM DRIVE
TO 300' N/O NAVAJO DRIVE
SS-255
APPROVED BY
DIRECTOR OF PUBLIC WORKS
DATE 6-29-65
R-1031-A
SHEET 1 OF 2

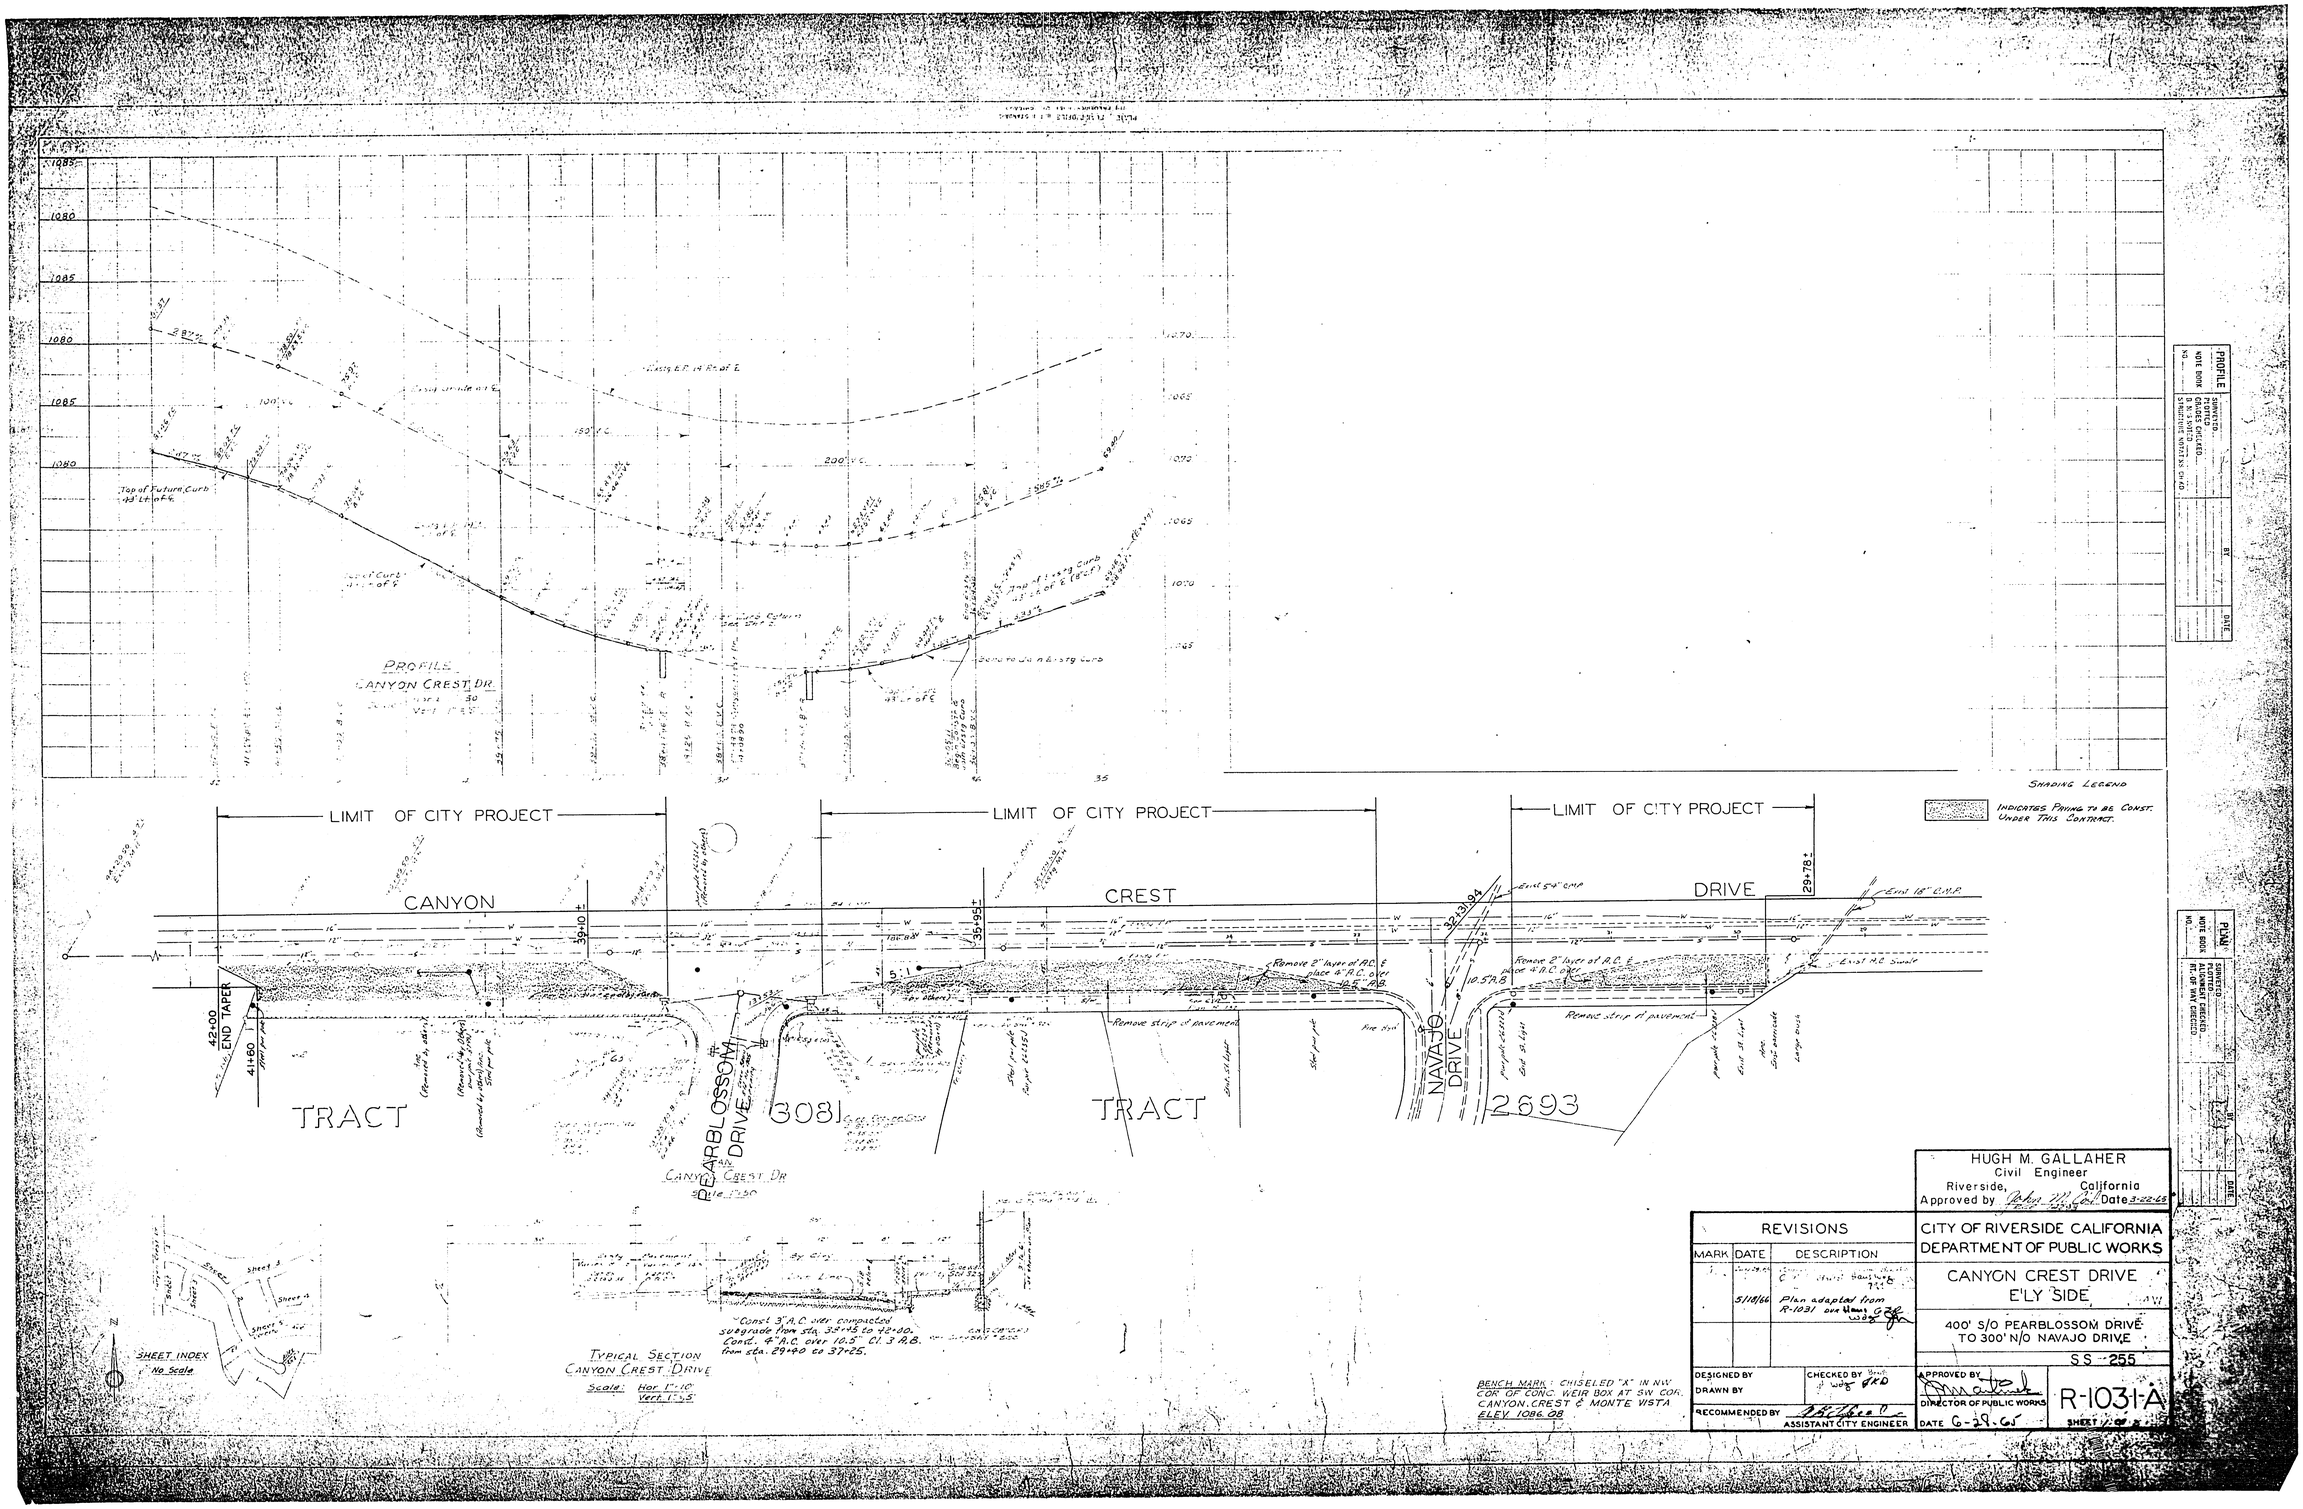


HUGH M. GALLAHER
Civil Engineer
Riverside, California
Approved by Date

CITY OF RIVERSIDE CALIFORNIA
DEPARTMENT OF PUBLIC WORKS

EL CERRITO DRIVE

N'LY SIDE E'LY OF PEARBLOSSOM DRIVE
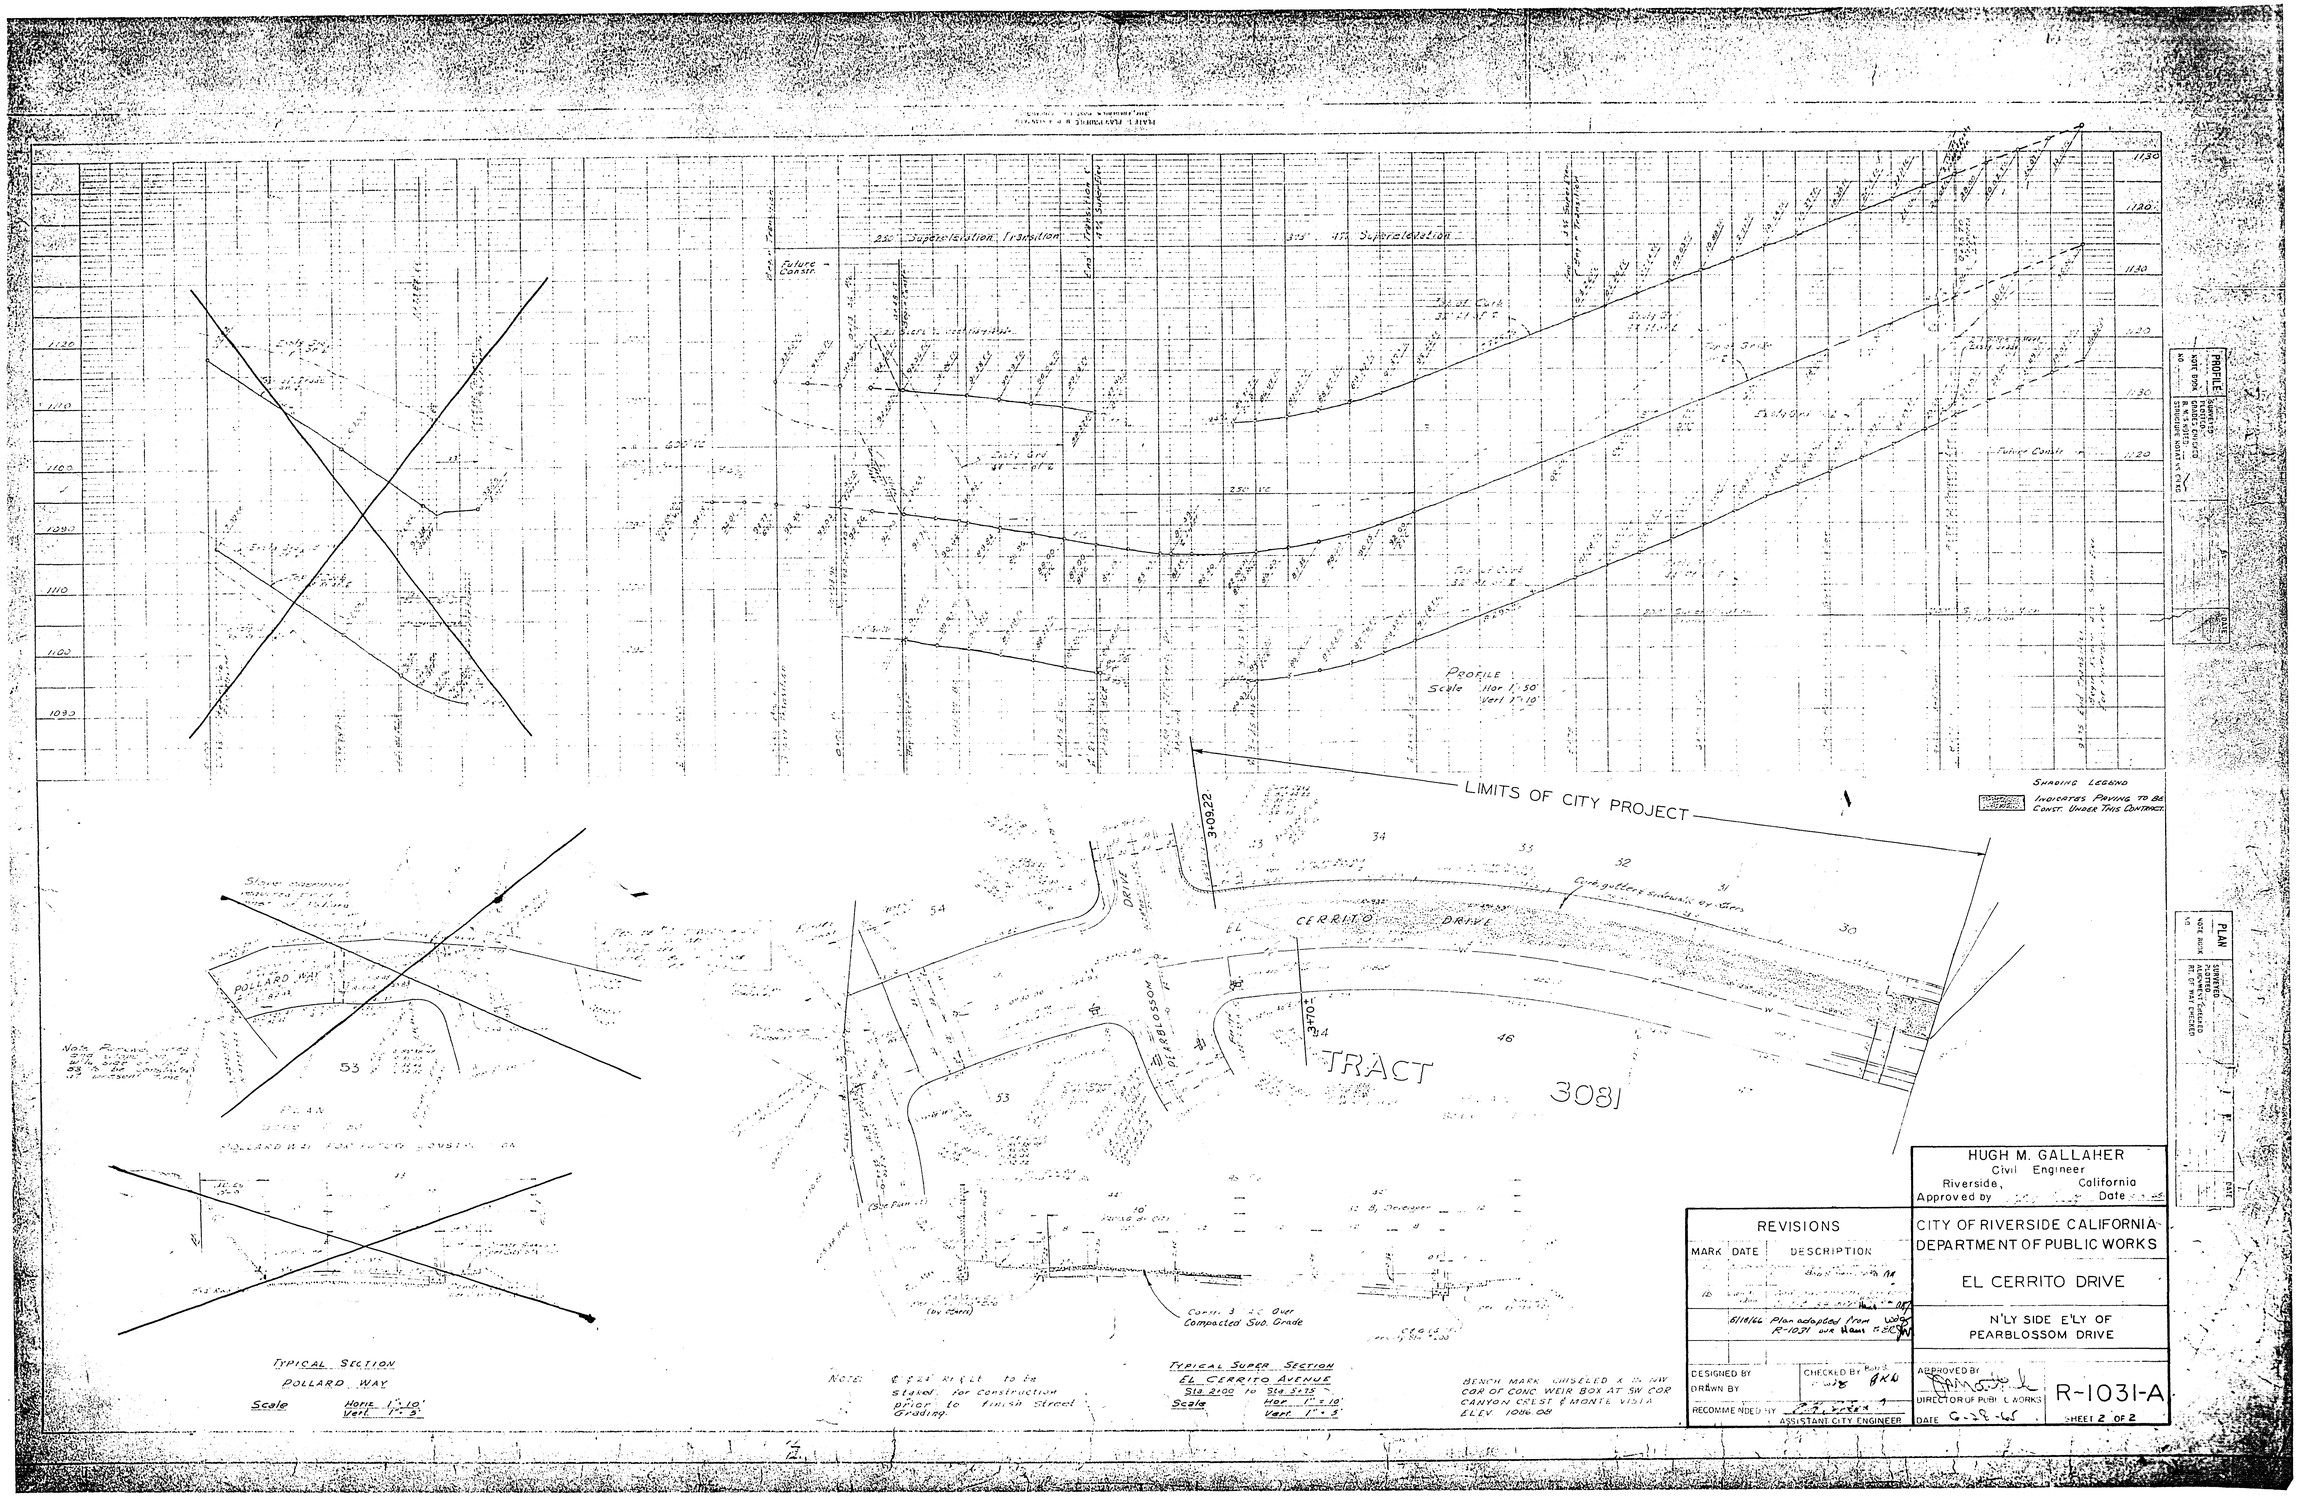
| REVISIONS | | |
|---|---|---|
| MARK | DATE | DESCRIPTION |
| | 5/18/66 | Plan adopted from R-1031 |

DESIGNED BY
DRAWN BY
CHECKED BY
RECOMMENDED BY
ASSISTANT CITY ENGINEER

APPROVED BY
DIRECTOR OF PUBLIC WORKS
DATE 6-28-65

R-1031-A
SHEET 2 OF 2