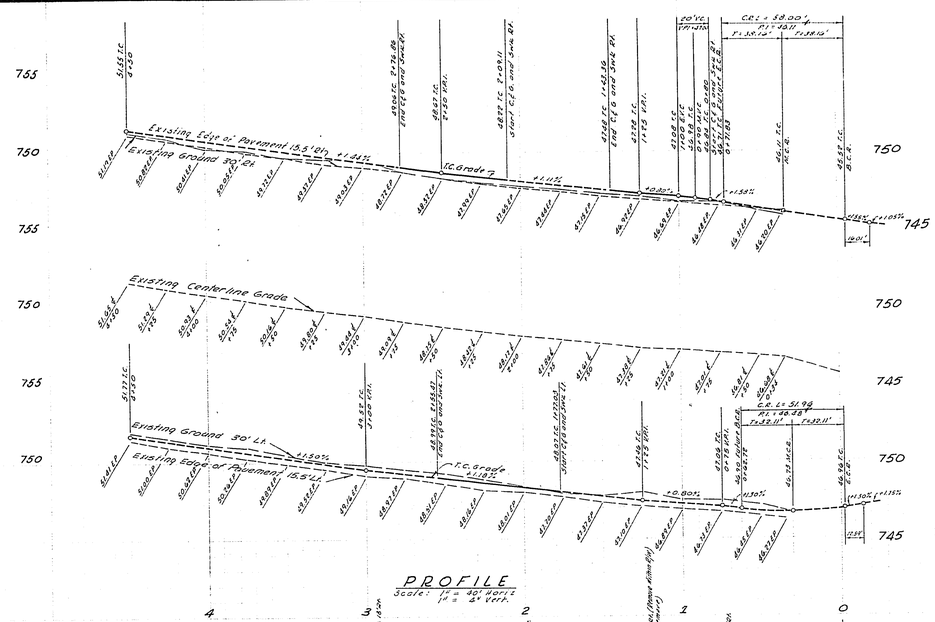

PROFILE


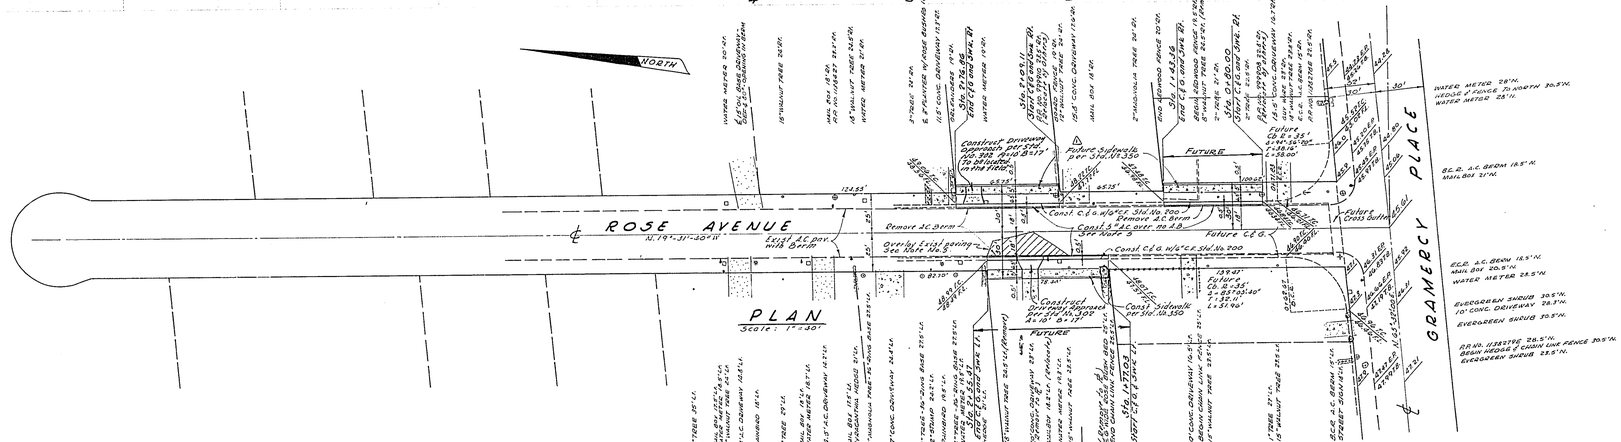

PLAN

Scale: 1" = 30'

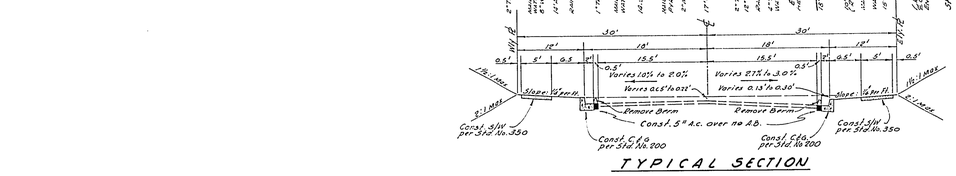

TYPICAL SECTION

ROSE AVENUE

Scale: 1" = 10' Horiz.
1" = 5' Vert.

T.I. 5

GENERAL NOTES:

1. It shall be the responsibility of the contractor to clear the right of way in accordance with the provisions of law as it affects each utility including irrigation lines and appurtenance and at no cost to the City.
2. Construction shall be in accordance with the City of Riverside, Department of Public Works, Specifications No. 461 and Standard Drawings.
3. Prime coat, seal coat and paint binder are required.
4. Grading will require a permit under Ordinance 3093 for a cut or fill exceeding 100 cubic yards, or a fill over one foot in depth.
5. Trim edge of existing pavement, where new paving joins existing pavement, to a clean straight line. Construct match-up paving as shown and overlay as directed in the field to produce a smooth crown section.
6. ~~Contact Public Utilities Engineering @ 787-7421 for Street Light Requirements prior to sidewalk construction.~~
7. ~~The finished subgrade shall have a compaction of not less than 90% for a depth of 0.5 foot as determined by test method No. "California 216" immediately prior to placement of the cover.~~

B.M. El. 746.77 R.R. Spike in P.P. Nr. Cor. Rose and Gramercy Pl. City I.D. 725, Hy 85

CRAWLEY & HAWKINS SURVEYORS AND ENGINEERS Riverside, California Approved George O. Crawley R.E. No. 9455 Field Bk. 77/10-16 Date 4-1-65 J.O. No. 379	MARK	REVISIONS	APPR.	DATE	CITY OF RIVERSIDE, CALIFORNIA DEPARTMENT OF PUBLIC WORKS
	1	Change "Const." to "Future" Sidewalk	J.C. Allen	4-1-65	
		DESIGNED BY Sam DRAWN BY L.H. CHECKED BY Tom			

APPROVED BY	BY	DATE
OFFICE ENGINEER	[illegible]	[illegible]
PARK DEPARTMENT	BD	4-23
TRAFFIC DIVISION	GD	5-7-65
ASSISTANT CITY ENG.	[illegible]	5-14

APPROVED BY [illegible]
DIRECTOR OF PUBLIC WORKS
DATE 5-14-65

STREET PLAN & PROFILE
ROSE AVENUE
NORTH OF GRAMERCY PLACE
STA. 0+80.00 RT. TO STA. 1+43.36 RT.
STA. 2+09.11 RT. TO STA. 2+76.86 RT.
STA. 1+77.03 LT TO STA. 2+53.47 LT.

HORIZ. SCALE: 1" = 40' VERT. SCALE: 1" = 4'

PROJECT NO. R-1041
SHEET 1 OF 1
FILE NO.

4070