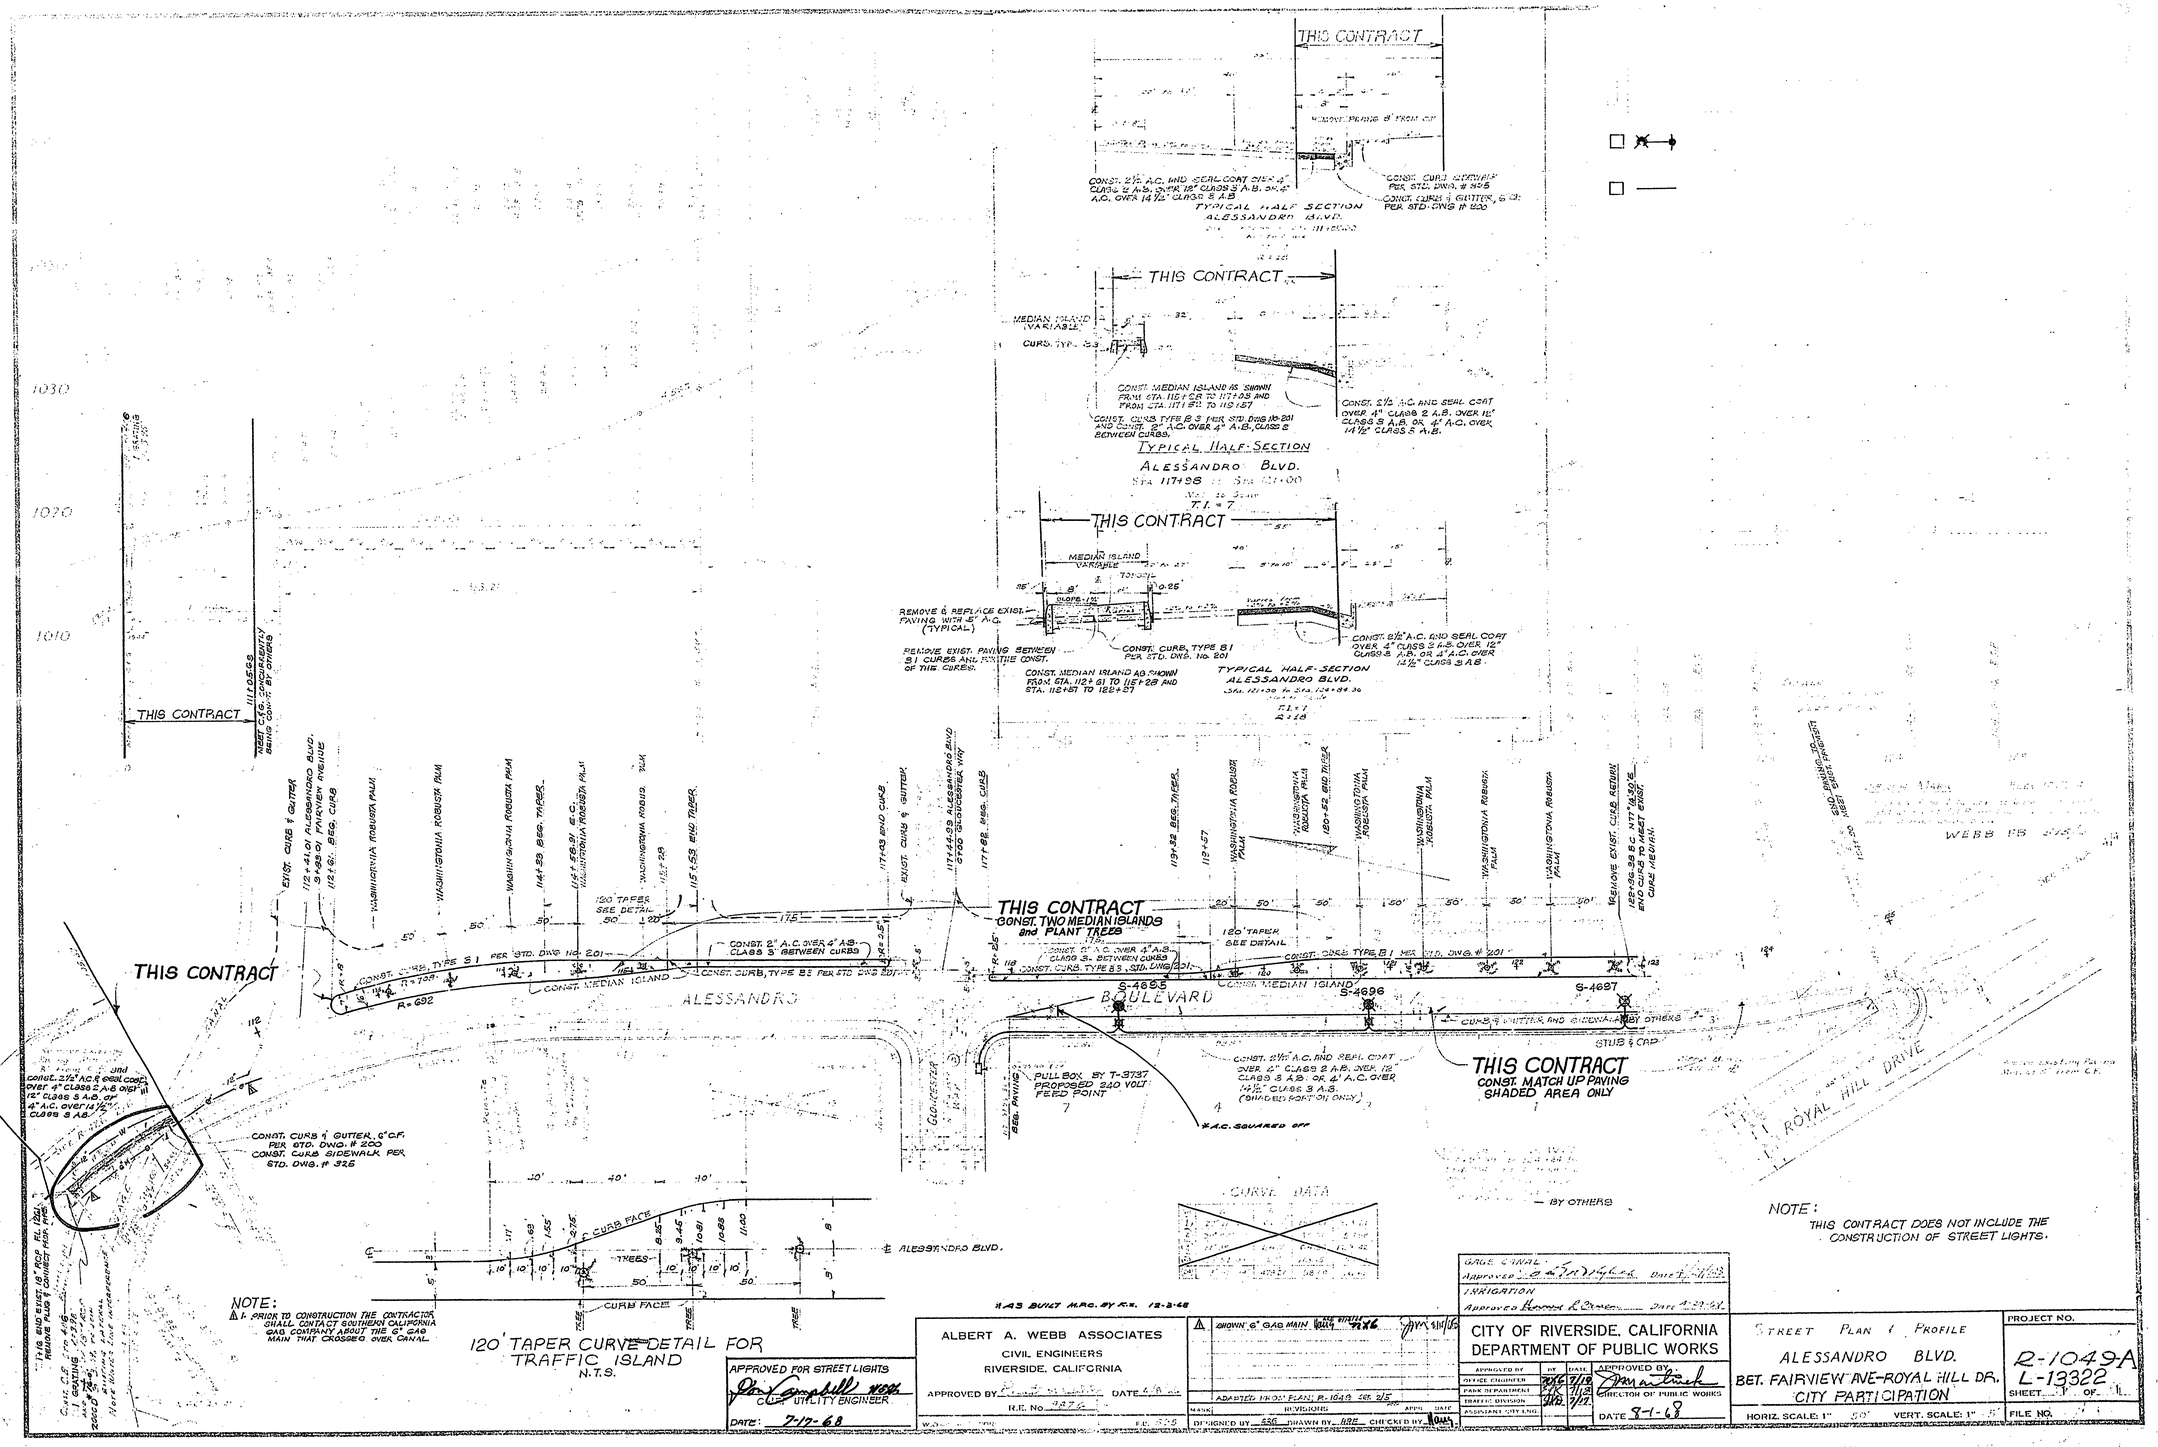
THIS CONTRACT
CONST. 2½" A.C. AND SEAL COAT OVER 4" CLASS 2 A.B. OVER 12" CLASS 3 A.B. OR 4" A.C. OVER 14½" CLASS 3 A.B.
CONST. CURB, SIDEWALK PER STD. DWG. # 325
CONST. CURB & GUTTER, 6" C.F. PER STD. DWG. # 200
TYPICAL HALF SECTION
ALESSANDRO BLVD.
MEDIAN ISLAND VARIABLE
CURB, TYP. S3
CONST. MEDIAN ISLAND AS SHOWN FROM STA. 116+58 TO 117+03 AND FROM STA. 117+81 TO 118+57
CONST. CURB TYPE B 2 PER STD. DWG. 18-201 AND CONST. 2" A.C. OVER 4" A.B. CLASS 2 BETWEEN CURBS.
CONST. 2½" A.C. AND SEAL COAT OVER 4" CLASS 2 A.B. OVER 12" CLASS 3 A.B. OR 4" A.C. OVER 14½" CLASS 3 A.B.
TYPICAL HALF SECTION
ALESSANDRO BLVD.
STA. 117+98 TO STA. 121+00
T.I. = 7
MEDIAN ISLAND VARIABLE
REMOVE & REPLACE EXIST. PAVING WITH 5" A.C. (TYPICAL)
REMOVE EXIST. PAVING BETWEEN S1 CURBS AND FOR THE CONST. OF THIS CURBS.
CONST. CURB, TYPE S1 PER STD. DWG. No. 201
CONST. MEDIAN ISLAND AS SHOWN FROM STA. 112+61 TO 112+28 AND STA. 112+57 TO 122+57
CONST. 2½" A.C. AND SEAL COAT OVER 4" CLASS 2 A.B. OVER 12" CLASS 3 A.B. OR 4" A.C. OVER 14½" CLASS 3 A.B.
TYPICAL HALF SECTION
ALESSANDRO BLVD.
STA. 121+00 TO STA. 124+84.36
T.I. = 7
R = 18
1030
1020
1010
THIS CONTRACT
NEET CITY, CONCURRENTLY BEING CONST. BY OTHERS
EXIST. CURB & GUTTER
WASHINGTONIA ROBUSTA PALM
WASHINGTONIA ROBUSTA PALM
WASHINGTONIA ROBUSTA PALM
WASHINGTONIA ROBUSTA PALM
WASHINGTONIA ROBUSTA PALM
WASHINGTONIA ROBUSTA PALM
WASHINGTONIA ROBUSTA PALM
WASHINGTONIA ROBUSTA PALM
WASHINGTONIA ROBUSTA PALM
WASHINGTONIA ROBUSTA PALM
WASHINGTONIA ROBUSTA PALM
EXIST. CURB & GUTTER
EXIST. CURB & GUTTER
EXIST. CURB, RETURN
120' TAPER SEE DETAIL
THIS CONTRACT
CONST. TWO MEDIAN ISLANDS and PLANT TREES
120' TAPER SEE DETAIL
CONST. 2" A.C. OVER 4" A.B. CLASS 3 BETWEEN CURBS
CONST. CURB, TYPE S1 PER STD. DWG. NO. 201
CONST. CURB, TYPE S3 PER STD. DWG. 201
CONST. MEDIAN ISLAND
ALESSANDRO
BOULEVARD
S-4695
S-4696
S-4697
CURB & GUTTER AND SIDEWALK BY OTHERS
STUB & CAP
THIS CONTRACT
CONST. MATCH UP PAVING SHADED AREA ONLY
PULL BOX BY T-3737 PROPOSED 240 VOLT FEED POINT
CONST. 2½" A.C. AND SEAL COAT OVER 4" CLASS 2 A.B. OVER 12" CLASS 3 A.B. OR 4" A.C. OVER 14½" CLASS 3 A.B. (SHADED PORTION ONLY)
A.C. SQUARED OFF
THIS CONTRACT
CONST. 2½" A.C. AND SEAL COAT OVER 4" CLASS 2 A.B. OVER 12" CLASS 3 A.B. OR 4" A.C. OVER 14½" CLASS 3 A.B.
CONST. CURB & GUTTER, 6" C.F. PER STD. DWG. # 200
CONST. CURB SIDEWALK PER STD. DWG. # 325
R = 692
CURB FACE
TREES
ALESSANDRO BLVD.
CURB FACE
120' TAPER CURVE DETAIL FOR TRAFFIC ISLAND
N.T.S.
CURVE DATA
BY OTHERS
ROYAL HILL DRIVE
NOTE:
1. PRIOR TO CONSTRUCTION THE CONTRACTOR SHALL CONTACT SOUTHERN CALIFORNIA GAS COMPANY ABOUT THE 6" GAS MAIN THAT CROSSED OVER CANAL.
AS BUILT MRG. BY R.R. 12-2-68
NOTE:
THIS CONTRACT DOES NOT INCLUDE THE CONSTRUCTION OF STREET LIGHTS.
APPROVED FOR STREET LIGHTS
CITY UTILITY ENGINEER
DATE: 7-12-68
ALBERT A. WEBB ASSOCIATES
CIVIL ENGINEERS
RIVERSIDE, CALIFORNIA
APPROVED BY
DATE
R.E. No.
W.O.
F.B.
SHOWN 6" GAS MAIN
ADAPTED FROM PLAN R-1049 SHT. 2/5
MARK REVISIONS BY APPD DATE
DESIGNED BY DRAWN BY CHECKED BY
GAGE CANAL
Approved
Date
IRRIGATION
Approved
Date
CITY OF RIVERSIDE, CALIFORNIA
DEPARTMENT OF PUBLIC WORKS
APPROVED BY
OFFICE ENGINEER
PARK DEPARTMENT
TRAFFIC DIVISION
ASSISTANT CITY ENG.
DIRECTOR OF PUBLIC WORKS
DATE 8-1-68
STREET PLAN & PROFILE
ALESSANDRO BLVD.
BET. FAIRVIEW AVE-ROYAL HILL DR.
CITY PARTICIPATION
HORIZ. SCALE: 1" = 50'
VERT. SCALE: 1" = 5'
PROJECT NO.
R-1049A
L-13322
SHEET
OF
FILE NO.